


63+25

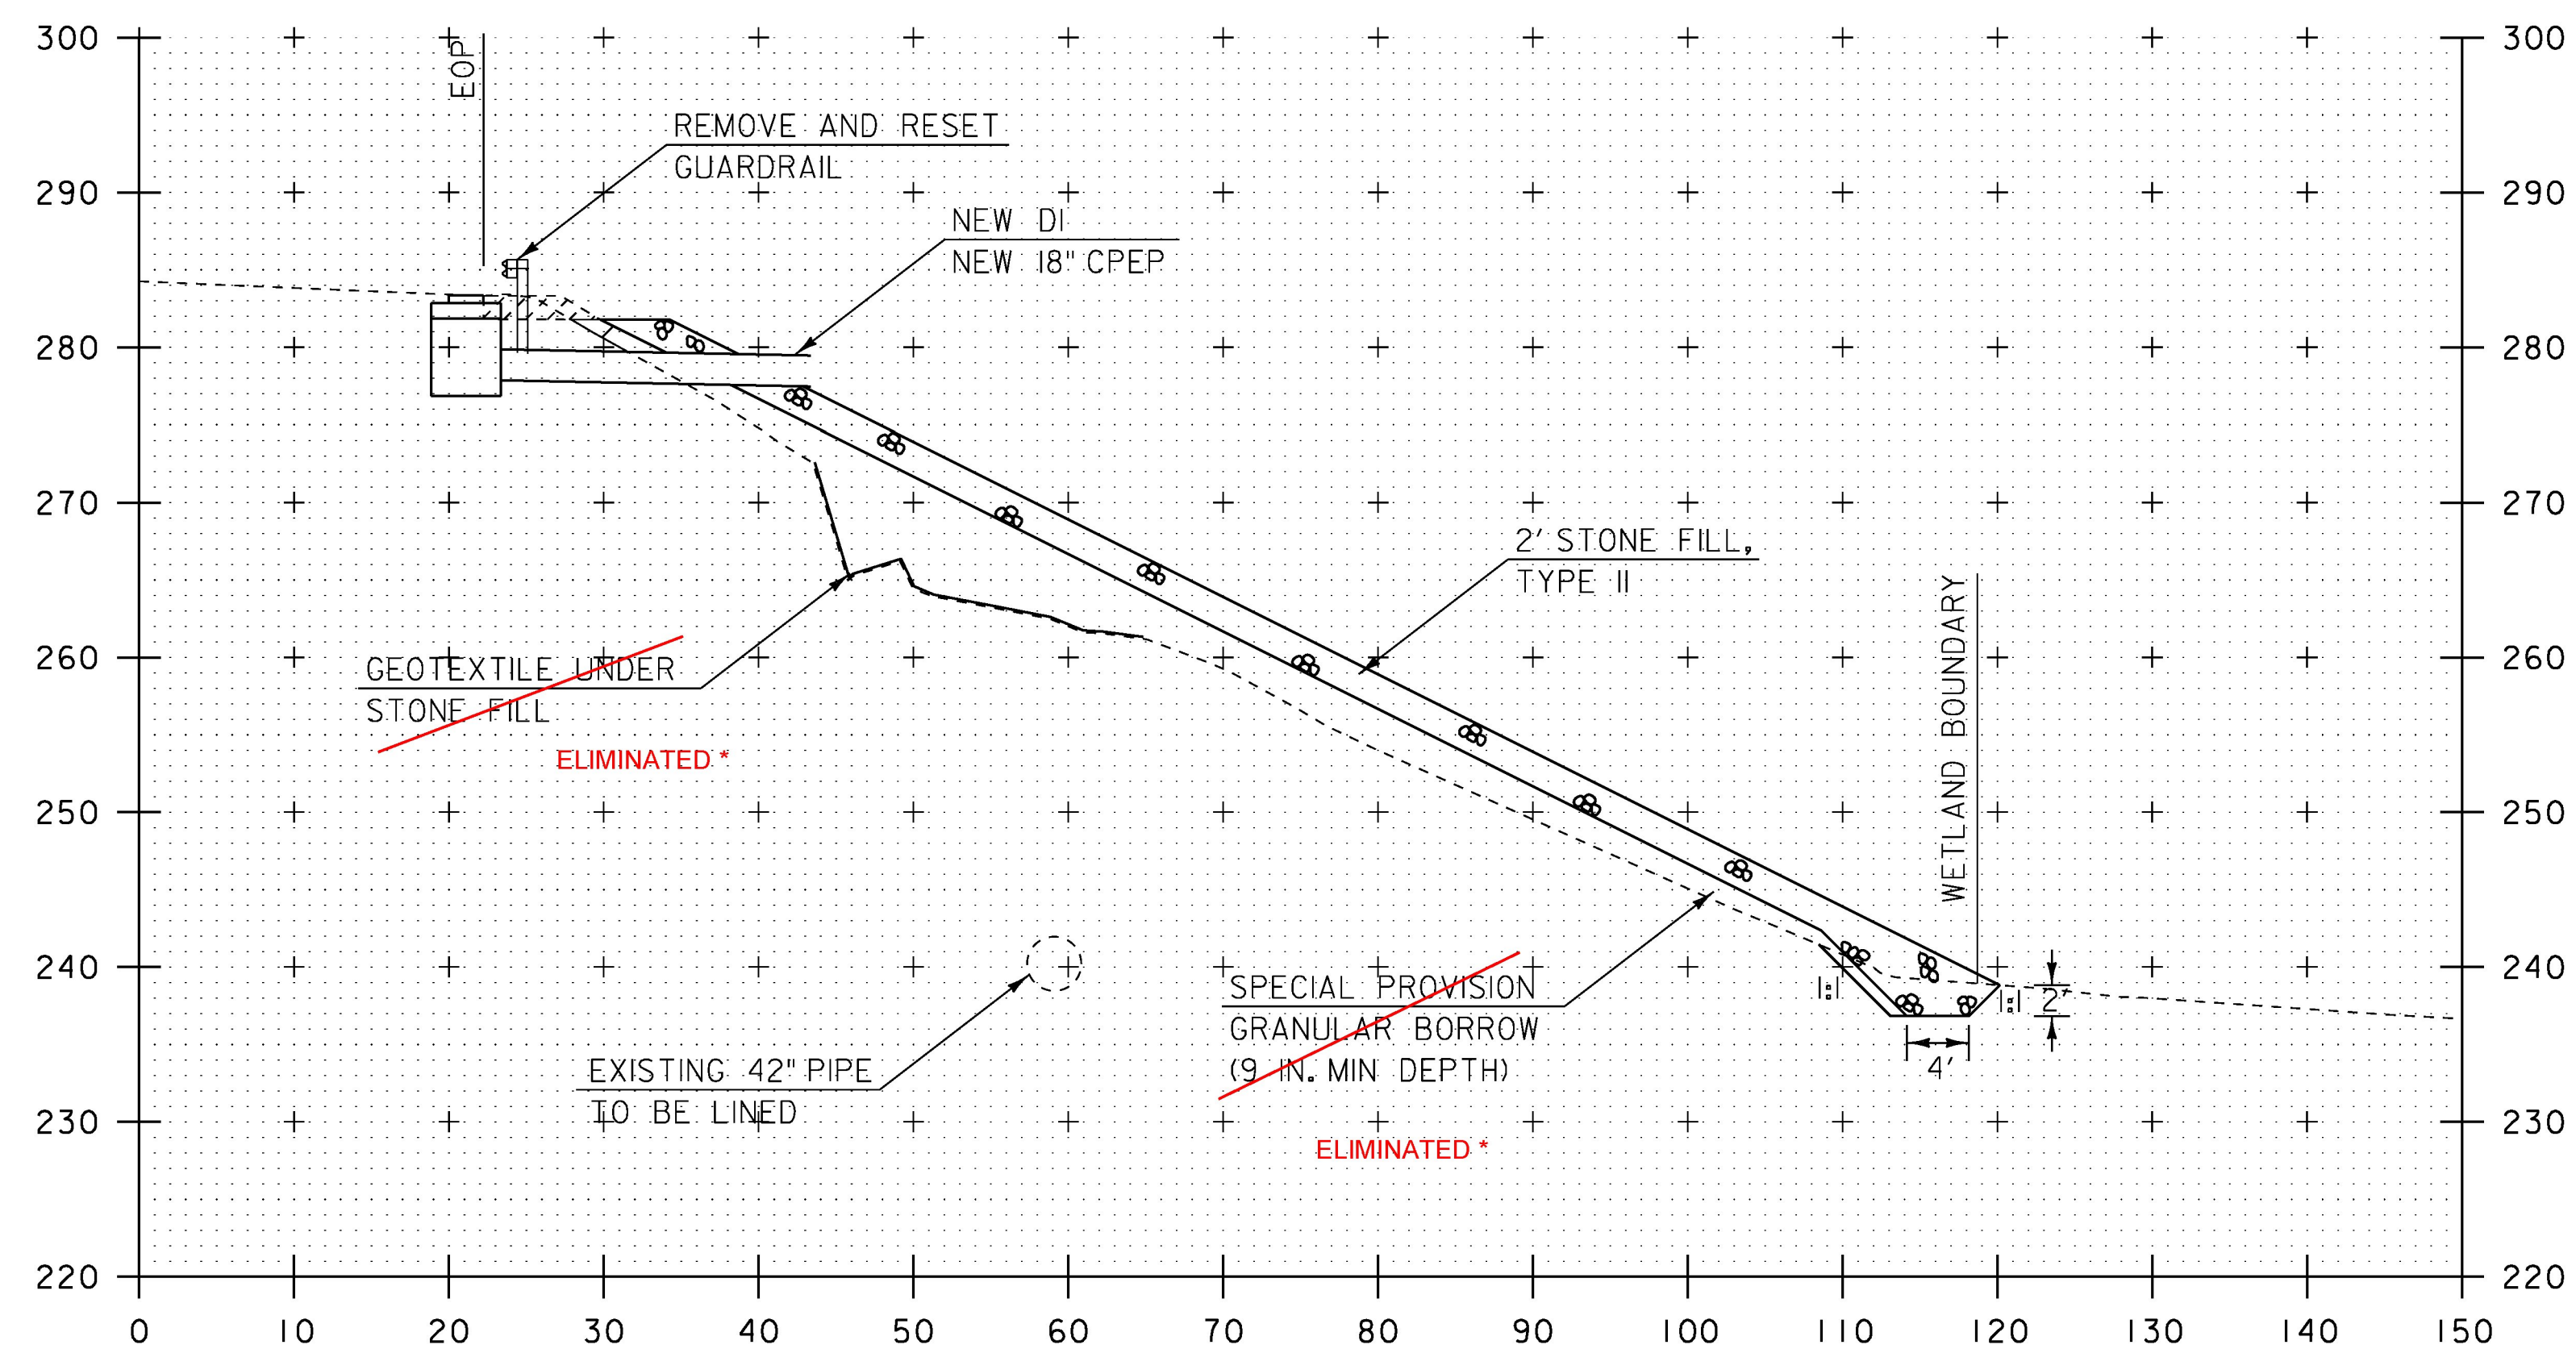

63+10

\* SEE NOTE ON PAGE 27

SCALE IN FEET STA. 63+10 TO STA. 63+25

PROJECT NAME:	SOUTH BURLINGTON	PLOT DATE:	27-APR-2017
PROJECT NUMBER:	IM SCRP(21)	DRAWN BY:	C. LEACH
FILE NAME:	I6d064/Design/xs.dgn	CHECKED BY:	M. BOOKER
PROJECT LEADER:	K. UPMAL	SLOPE CROSS SECTION SHEET	28 OF 30
DESIGNED BY:	C. LEACH		