


# STATE OF VERMONT AGENCY OF TRANSPORTATION

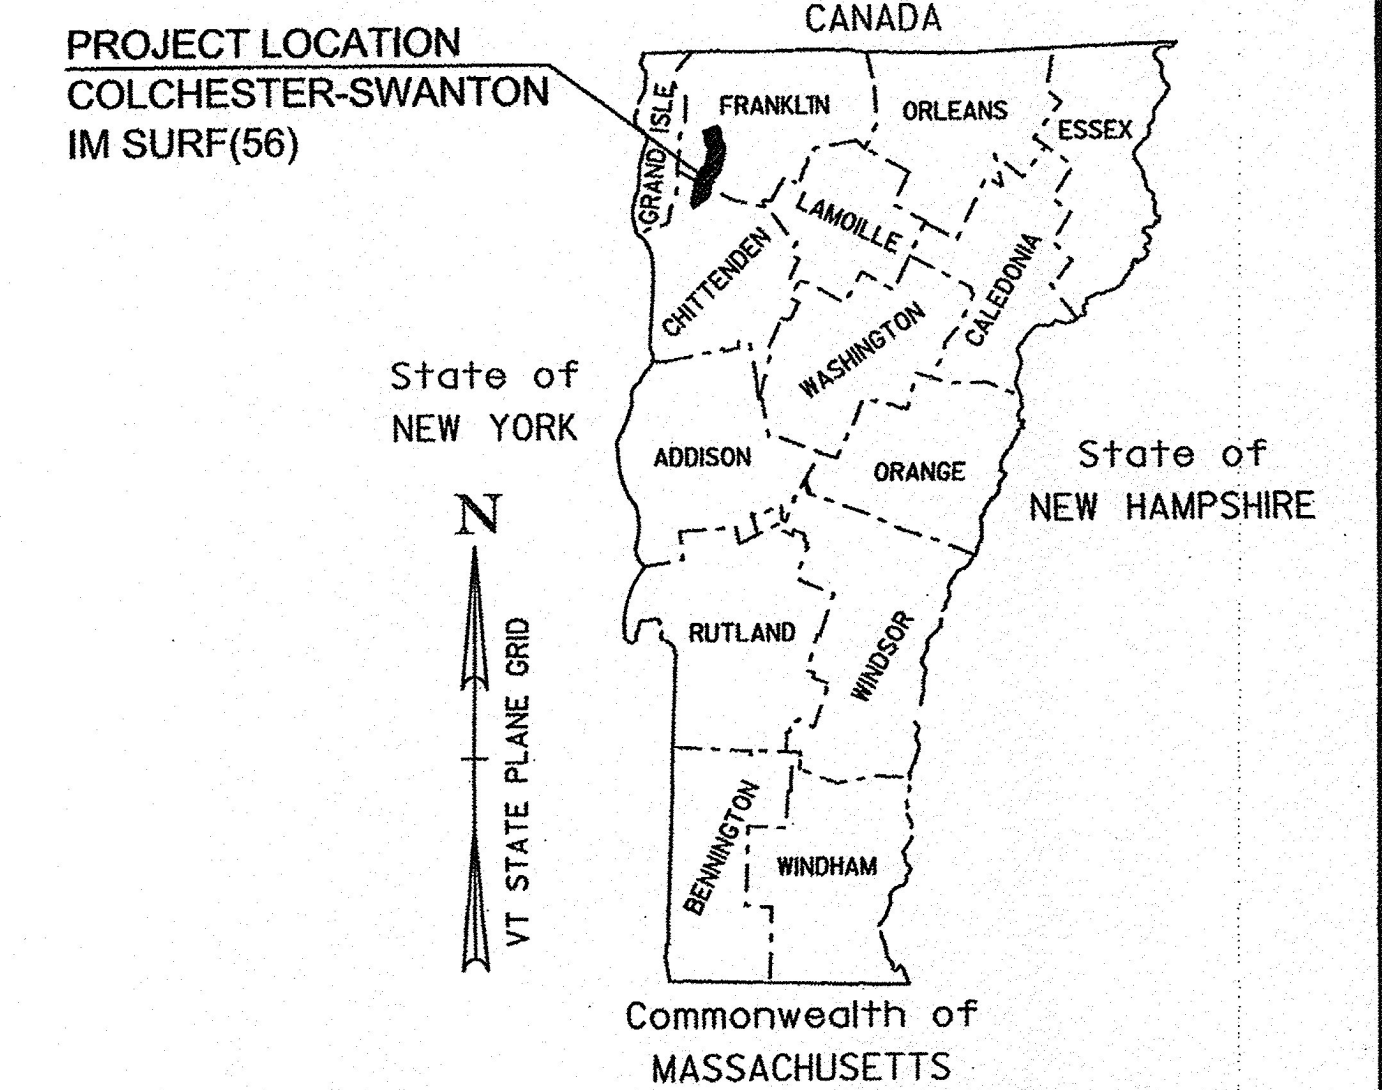

RECORD PLANS	
CONTRACTOR:	THE GORMAN GROUP, LLC - ALBANY, NY
RESIDENT ENGINEER:	CHRIS LAVALETTE
CONSTRUCTION BEGAN:	APRIL 19, 2017
CONSTRUCTION COMPLETE:	SEPTEMBER 29, 2017
RECORD PLANS BY:	CHRIS LAVALETTE & JESSE IVES
I HEREBY CERTIFY THAT ALL THE CONSTRUCTION REQUIRED BY THIS SET OF DRAWINGS HAS BEEN ACCOMPLISHED AS INDICATED HEREIN.	
BY <i>Chris Lavolette</i>	RESIDENT ENGINEER
DATE <i>9/10/18</i>	
NOTE: Any further information concerning final quantities, amounts or other details relative to this project may be found at Central Files in the electronic archives.	


## PROPOSED IMPROVEMENT TOWNS OF COLCHESTER, MILTON, GEORGIA, FAIRFAX, FAIRFIELD, ST. ALBANS & SWANTON COUNTIES OF CHITTENDEN & FRANKLIN INTERSTATE ROUTE 89 (PRINCIPAL ARTERIAL - NHS)

BEGINNING IN THE TOWN OF COLCHESTER AT MM 91.880 AND EXTENDING NORTHERLY ALONG INTERSTATE ROUTE 89 (NORTHBOUND LANE) FOR A DISTANCE OF APPROXIMATELY 138,969.60 FEET (26.320 MILES) TO MM 118.200 IN THE TOWN OF SWANTON.

BEGINNING IN THE TOWN OF COLCHESTER AT MM 91.880 AND EXTENDING NORTHERLY ALONG INTERSTATE ROUTE 89 (SOUTHBOUND LANE) FOR A DISTANCE OF APPROXIMATELY 138,969.60 FEET (26.320 MILES) TO MM 118.200 IN THE TOWN SWANTON.

LENGTH OF ROADWAY = 277,939.20 FEET (52.640 MILES)  
LENGTH OF PROJECT = 138,969.60 FEET (26.320 MILES)

WORK TO BE PERFORMED UNDER THIS PROJECT INCLUDES MICRO-MILLING, SURFACE PREPARATION INVOLVING PATCHING, POT HOLE REPAIR, CRACK SEALING, OVERLAYING WITH A THIN BITUMINOUS SURFACE TREATMENT, TRAFFIC SIGNAL UPGRADES, TRAFFIC MARKINGS AND OTHER HIGHWAY RELATED ITEMS.

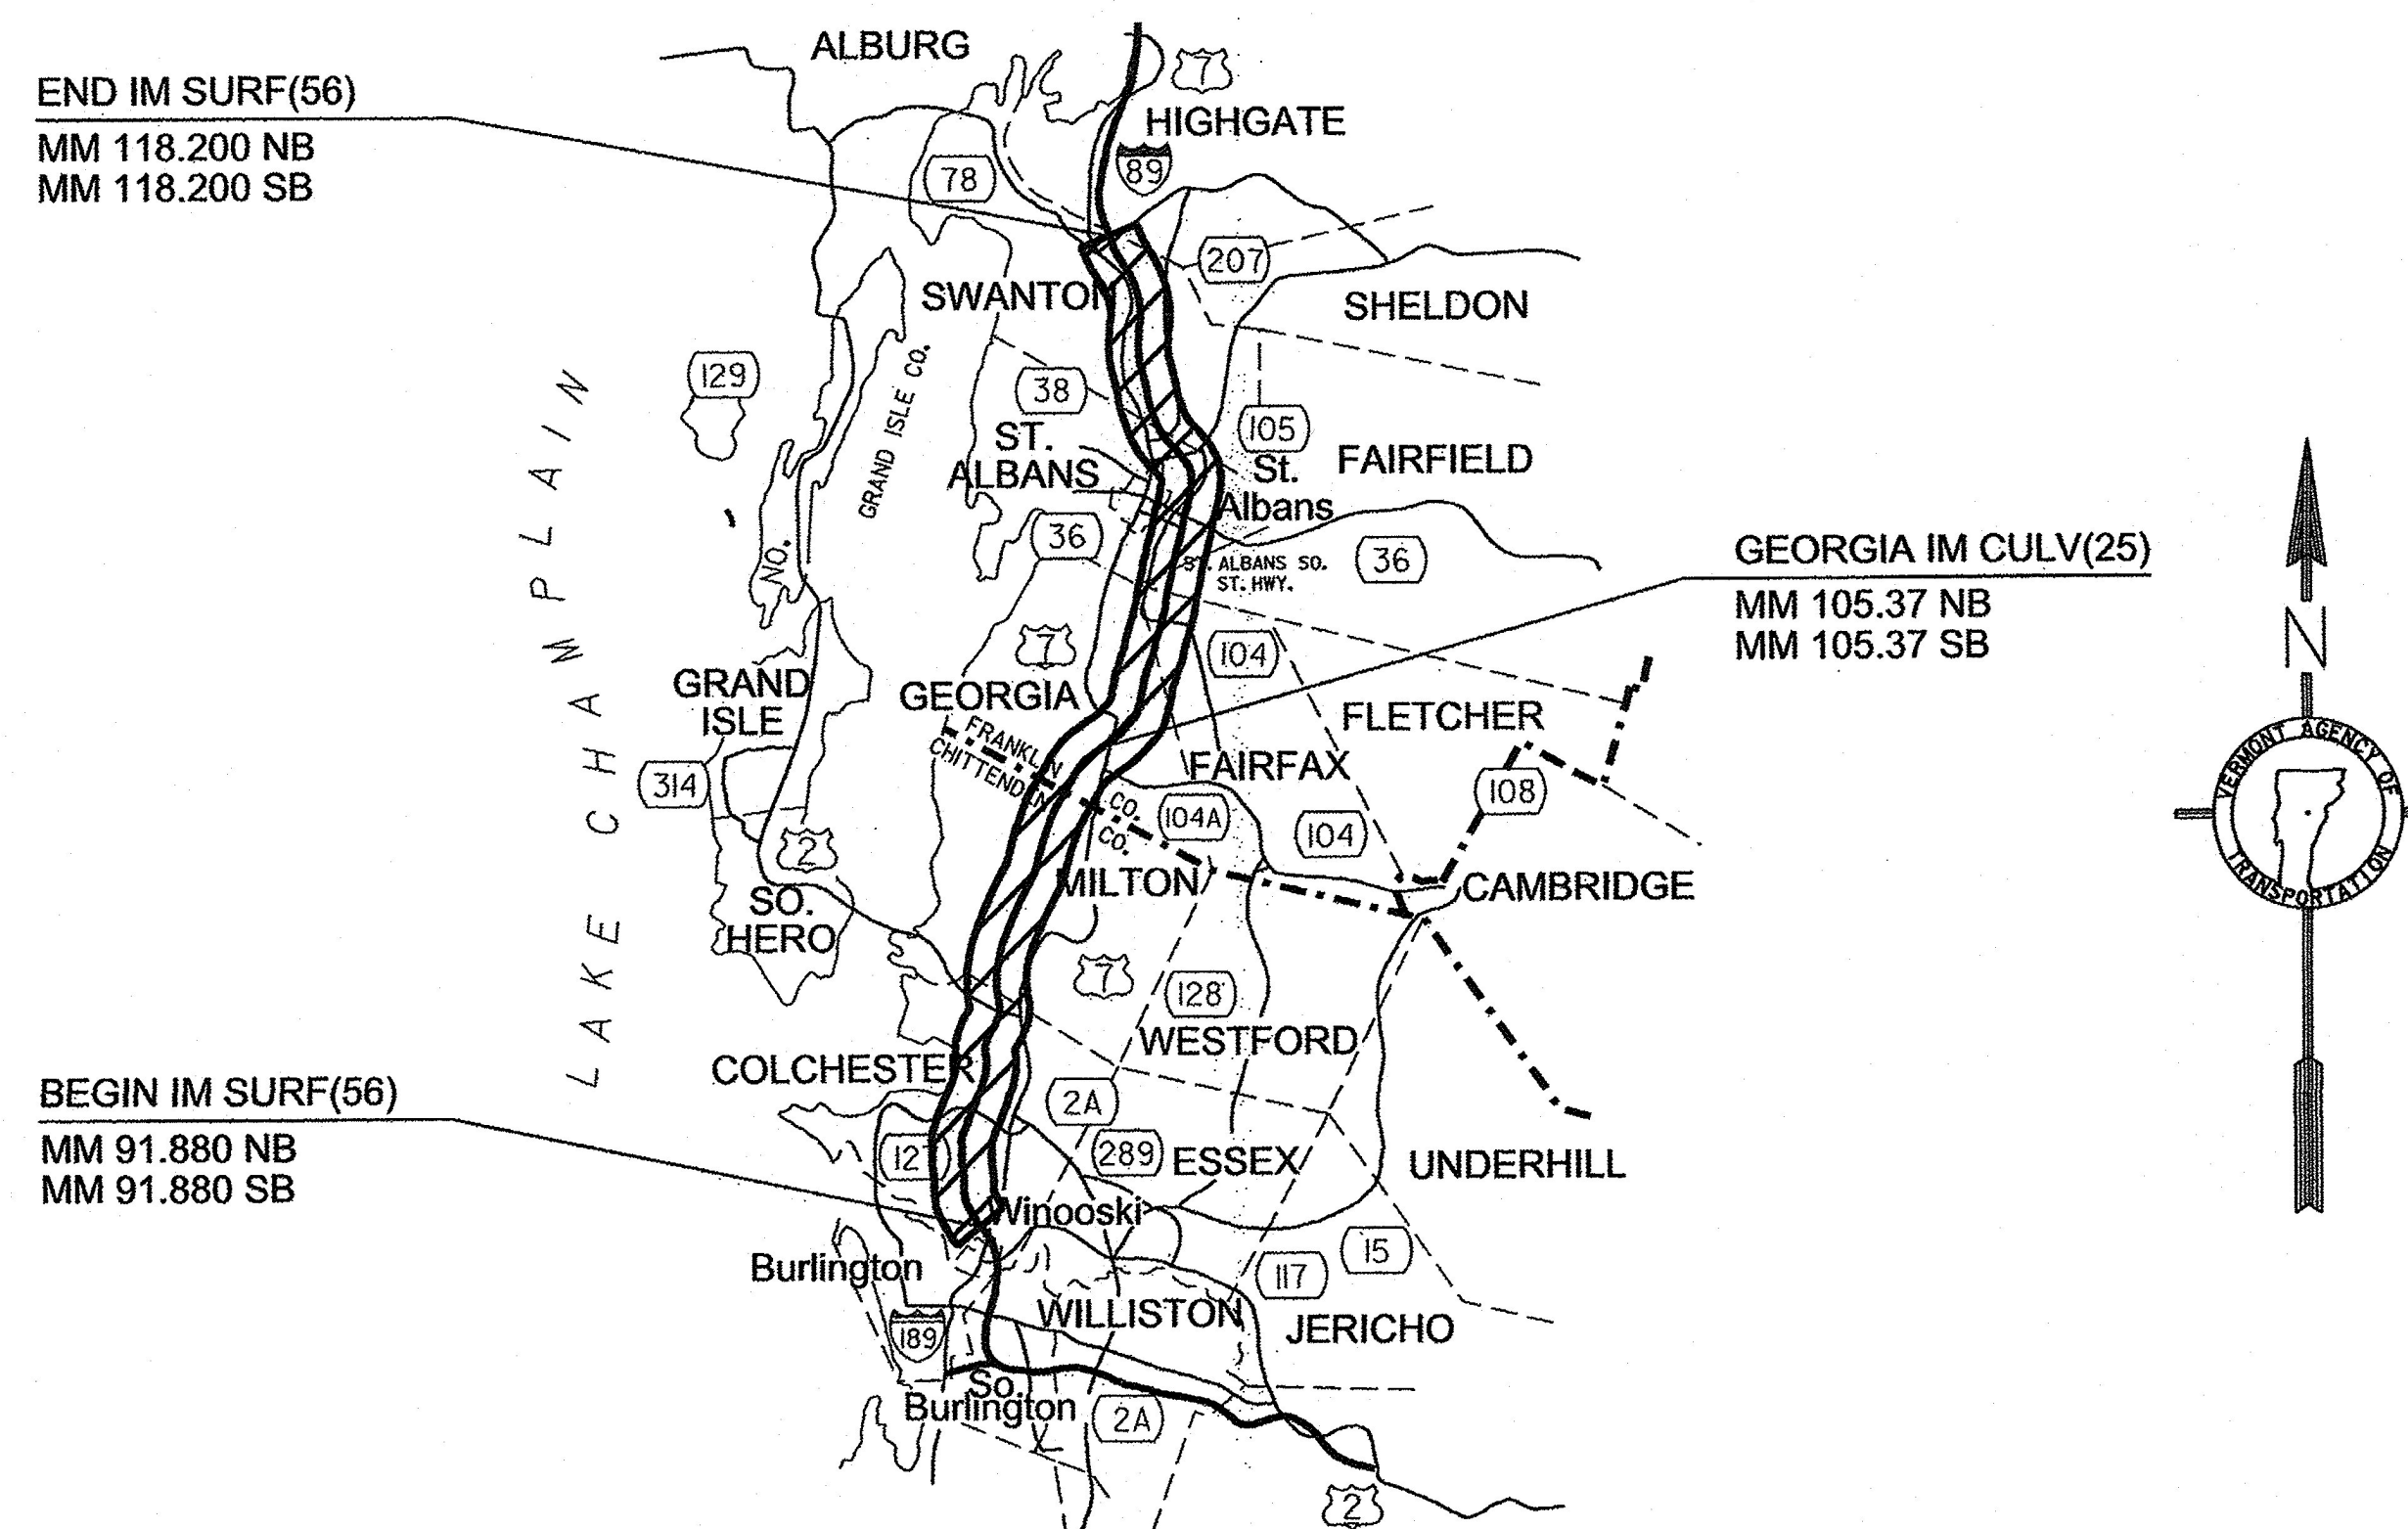

CONSTRUCTION IS TO BE CARRIED ON IN ACCORDANCE WITH THESE PLANS AND THE STANDARD SPECIFICATIONS FOR CONSTRUCTION DATED 2011, AS APPROVED BY THE FEDERAL HIGHWAY ADMINISTRATION ON JULY 20, 2011 FOR USE ON THIS PROJECT, INCLUDING ALL SUBSEQUENT REVISIONS AND SUCH REVISED SPECIFICATIONS AND SPECIAL PROVISIONS AS ARE INCORPORATED IN THESE PLANS.

QUALITY ASSURANCE PROGRAM : LEVEL 1

SURVEYED BY : NA  
SURVEYED DATE : NA

DATUM  
VERTICAL NA  
HORIZONTAL NA

NOT TO SCALE

DIRECTOR OF PROJECT DELIVERY: APPROVED: <i>[Signature]</i> DATE: <i>12/01/2016</i>	
PROJECT MANAGER :	MICHAEL J. FOWLER, P.E.
PROJECT NAME :	COLCHESTER-SWANTON
PROJECT NUMBER :	IM SURF(56)
SHEET 1 OF 53	