


MICRO-MILLING DETAIL - NORMAL SECTION

NOT TO SCALE
 MM 91.880 - MM 98.000 (NORTHBOUND)
 MM 91.880 - MM 98.000 (SOUTHBOUND)

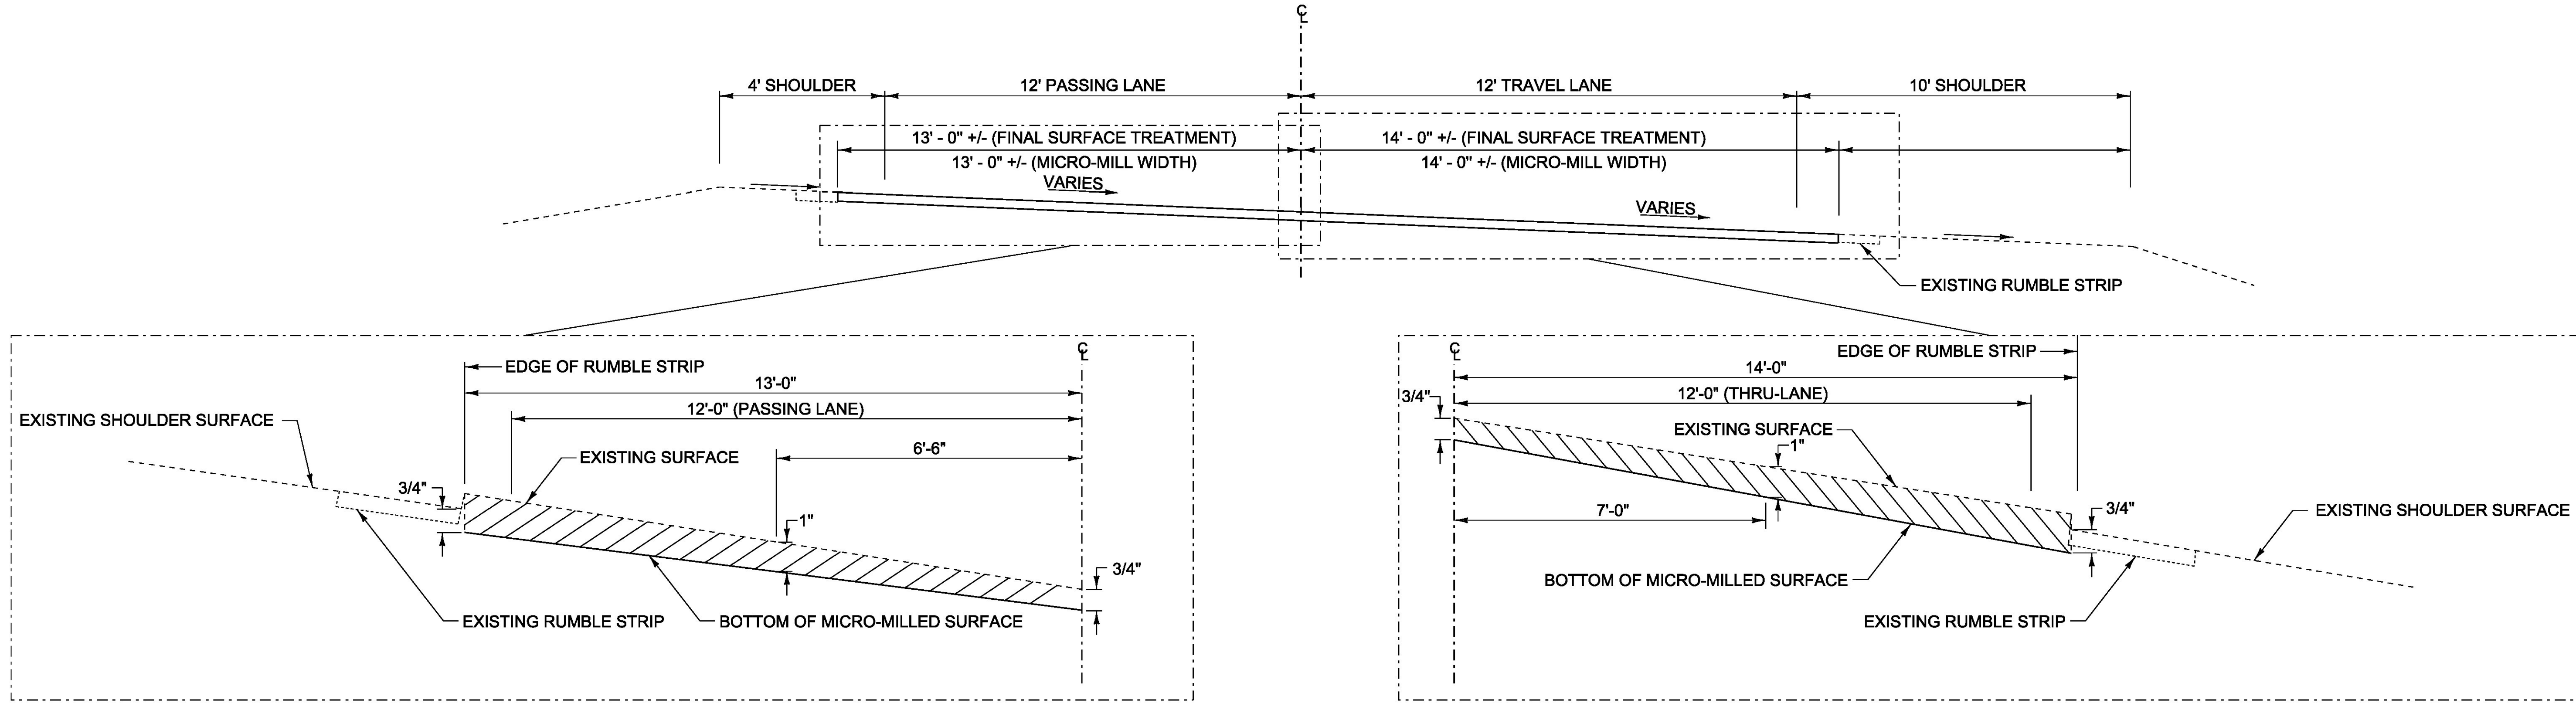

MICRO-MILLING DETAIL - BANKED SECTION

NOT TO SCALE
 MM 91.880 - MM 98.000 (NORTHBOUND)
 MM 91.880 - MM 98.000 (SOUTHBOUND)

PROJECT NAME:	COLCHESTER-SWANTON
PROJECT NUMBER:	IM SURF(56)
FILE NAME:	pl6v07l_wrk.dgn
PROJECT LEADER:	M. FOWLER
DESIGNED BY:	B. KIPP
MICROMILLING DETAIL SHEET	
PLOT DATE:	29-DEC-2016
DRAWN BY:	B. KIPP
CHECKED BY:	M. FOWLER
SHEET	II OF 54