


**BRIDGE #87-S**  
MM 111.351 - FAIRFAX

LENGTH OF NEW ASPHALTIC PLUG JOINTS:  
JOINT #1 = 37'  
JOINT #2 = 37'  
TOTAL = 74'

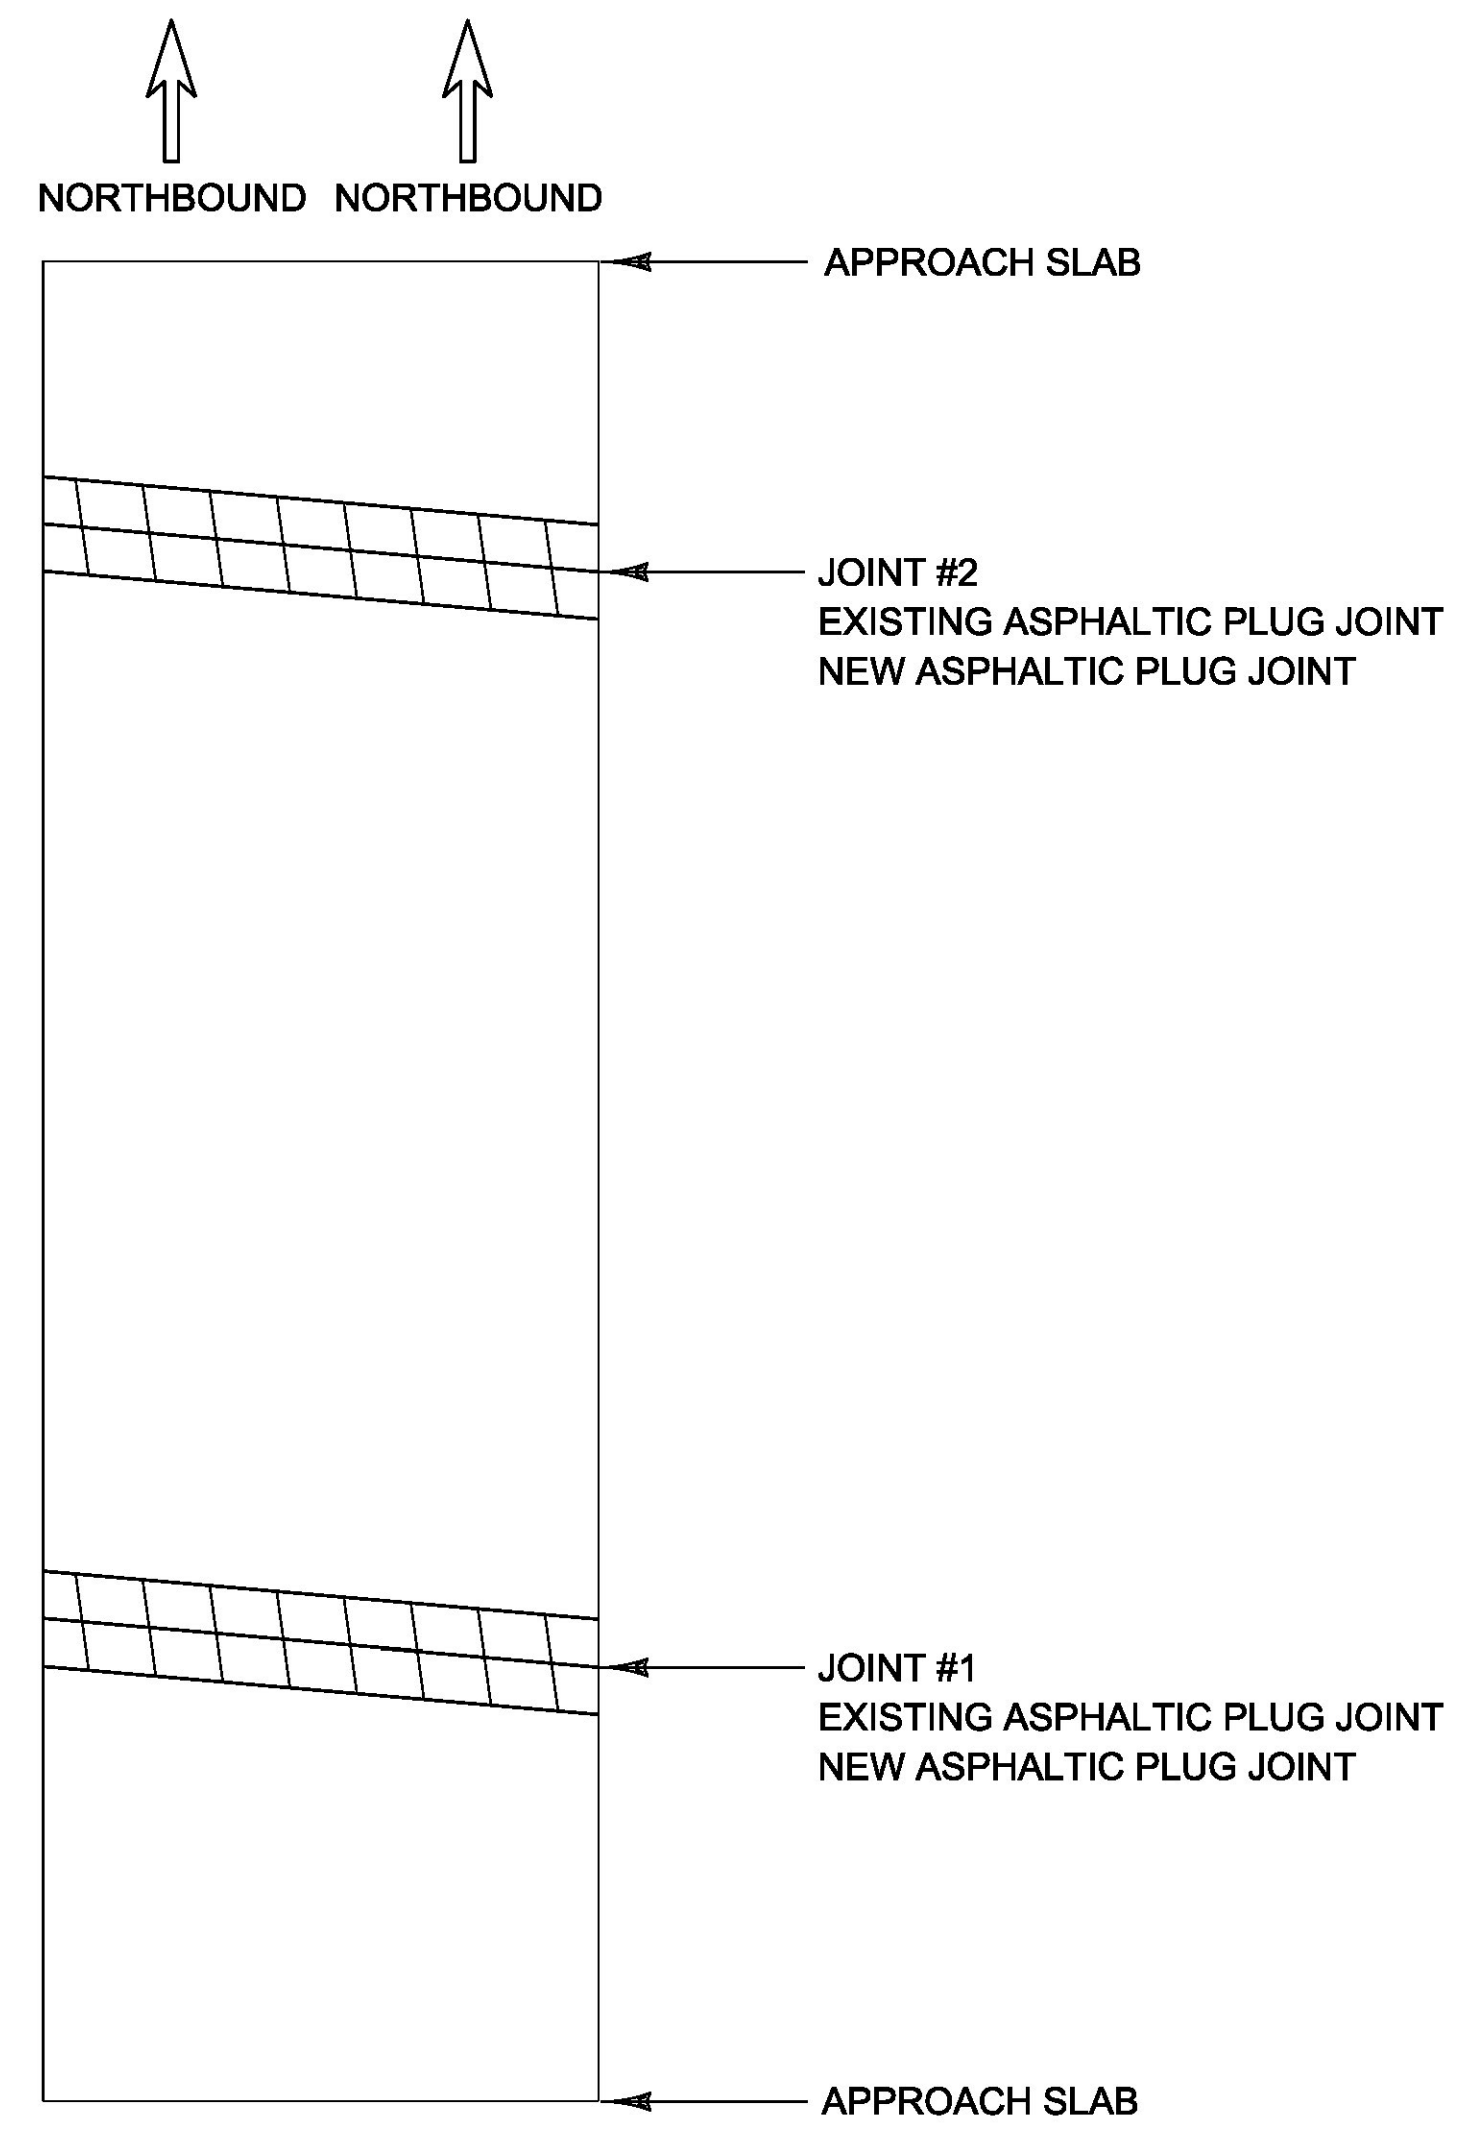

**BRIDGE #87-N**  
MM 111.351 - FAIRFAX

LENGTH OF NEW ASPHALTIC PLUG JOINTS:  
JOINT #1 = 37'  
JOINT #2 = 37'  
TOTAL = 74'

PROJECT NAME:	COLCHESTER-SWANTON
PROJECT NUMBER:	IM SURF(56)
FILE NAME: pl6v071_wrk.dgn	PLOT DATE: 09-DEC-2016
PROJECT LEADER: M. FOWLER	DRAWN BY: B. KIPP
DESIGNED BY: B. KIPP	CHECKED BY: M. FOWLER
BRIDGE DETAIL SHEET 7	SHEET 20 OF 54