


BRIDGE #92-S
MM 116.772 - ST. ALBANS

LENGTH OF NEW ASPHALTIC PLUG JOINTS:
JOINT #1 = 39'
JOINT #2 = 39'
JOINT #3 = 39'
TOTAL = 117'

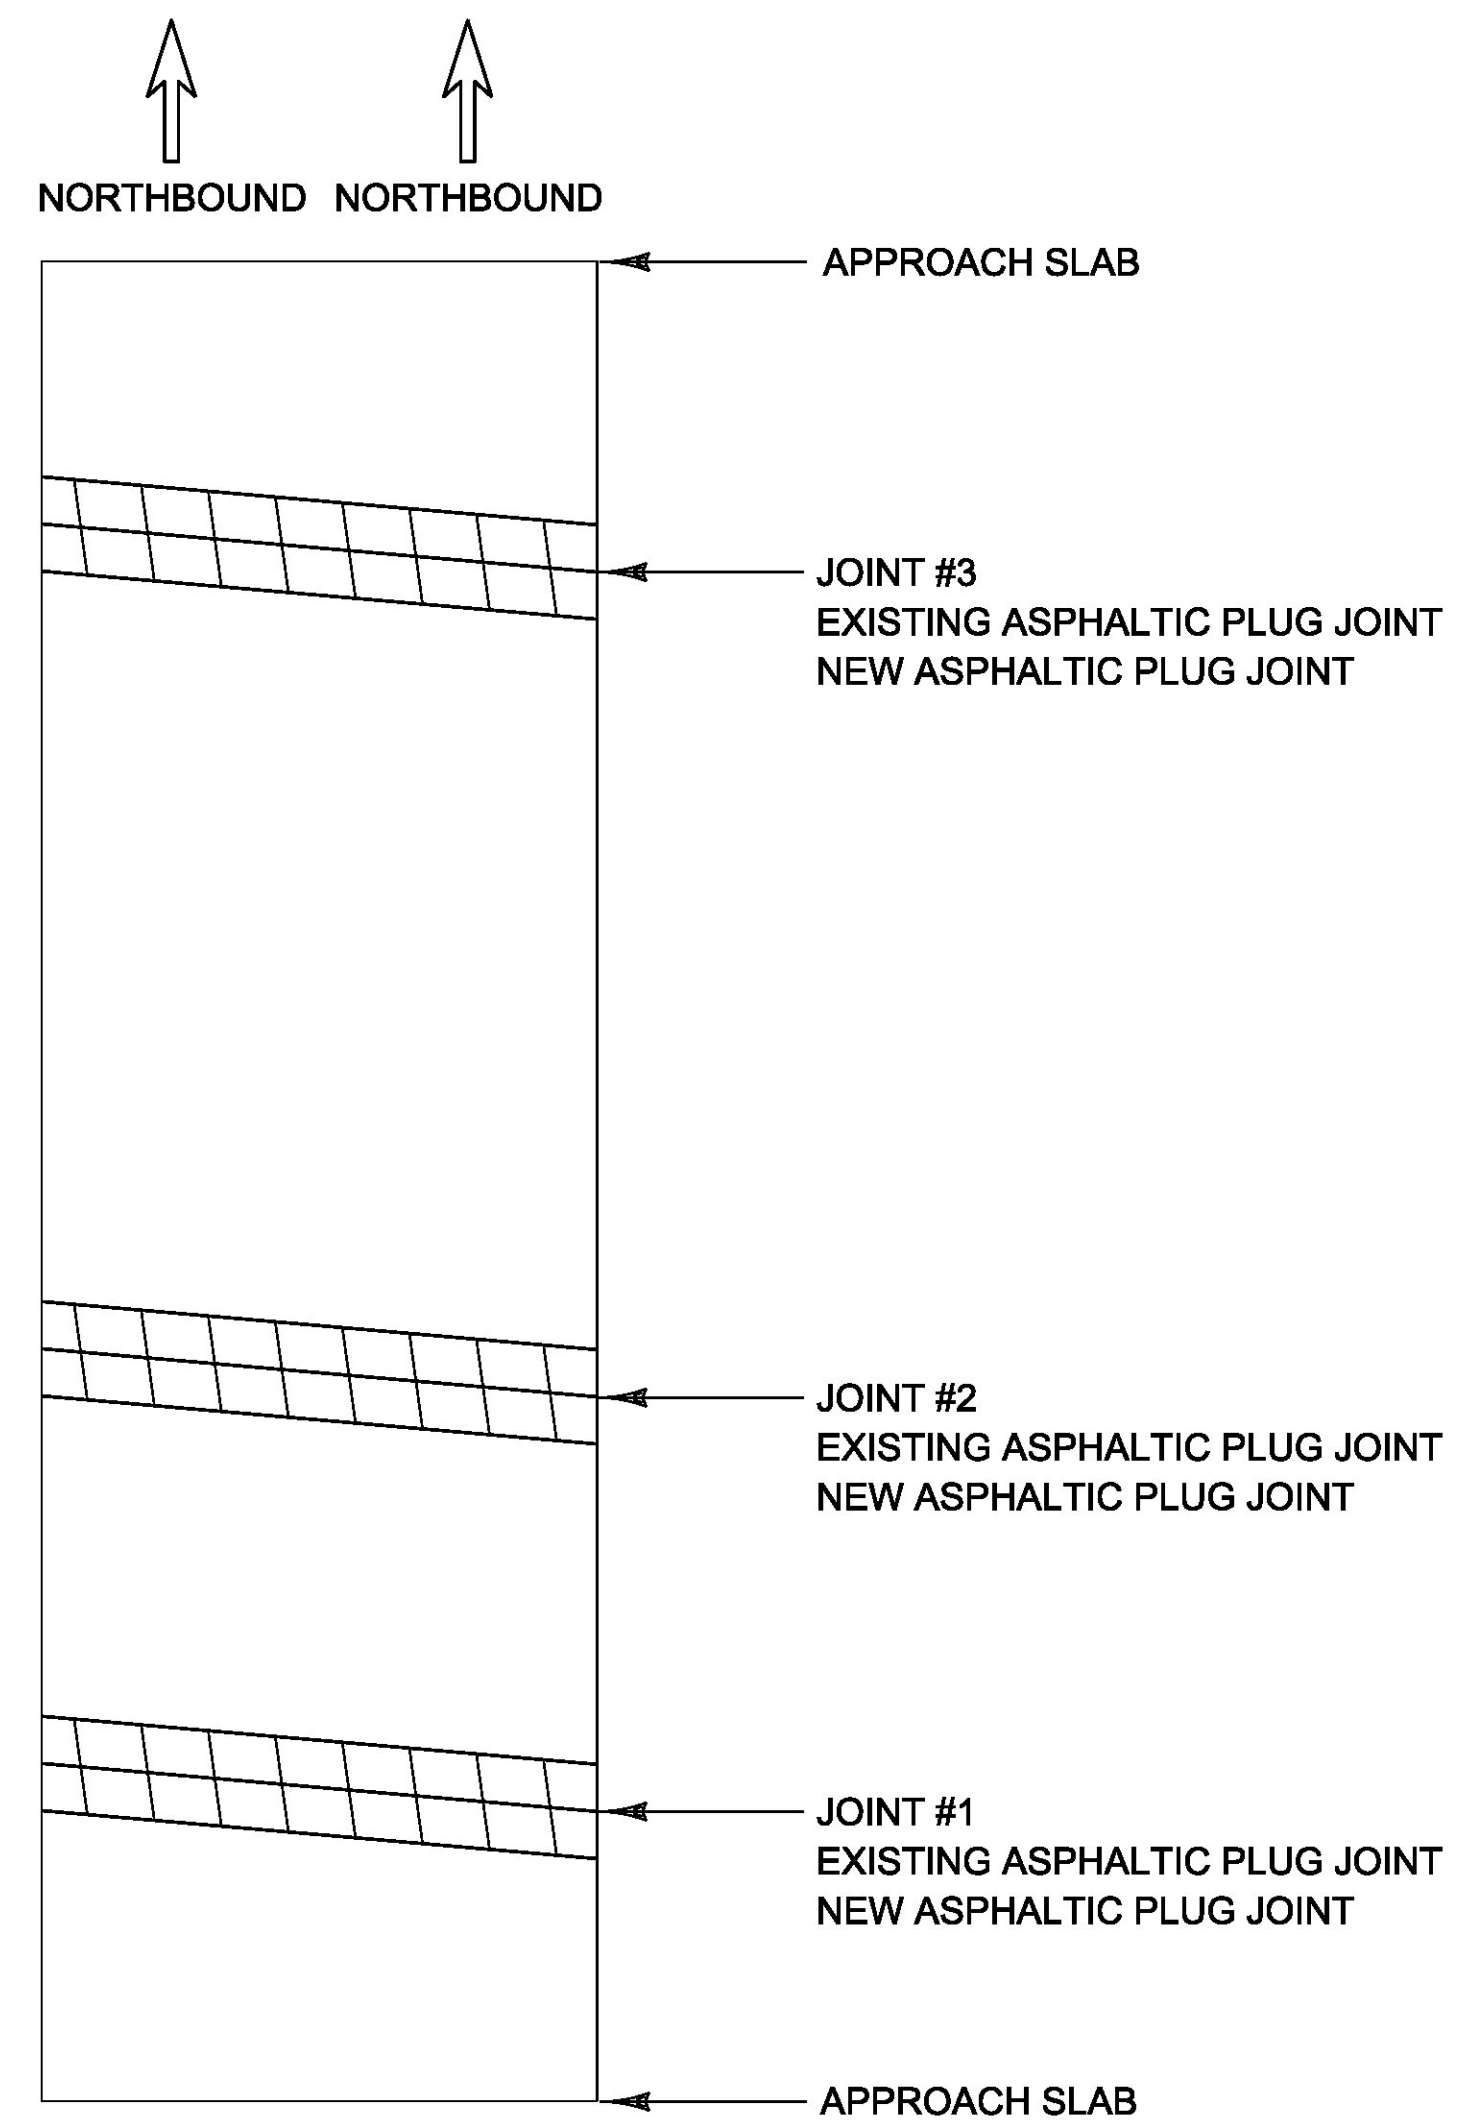

BRIDGE #92-N
MM 116.772 - ST. ALBANS

LENGTH OF NEW ASPHALTIC PLUG JOINTS:
JOINT #1 = 38'
JOINT #2 = 38'
JOINT #3 = 38'
TOTAL = 114'

PROJECT NAME: COLCHESTER-SWANTON	
PROJECT NUMBER: IM SURF(56)	
FILE NAME: pl6v071_wrk.dgn	PLOT DATE: 09-DEC-2016
PROJECT LEADER: M. FOWLER	DRAWN BY: B. KIPP
DESIGNED BY: B. KIPP	CHECKED BY: M. FOWLER
BRIDGE DETAIL SHEET 9	SHEET 22 OF 54