


**BRIDGE #93-S**  
MM 117.633 - ST. ALBANS

LENGTH OF NEW ASPHALTIC PLUG JOINTS:  
 JOINT #1 = 37'  
 JOINT #2 = 37'  
 JOINT #3 = 37'  
 JOINT #4 = 37'  
 TOTAL = 148'

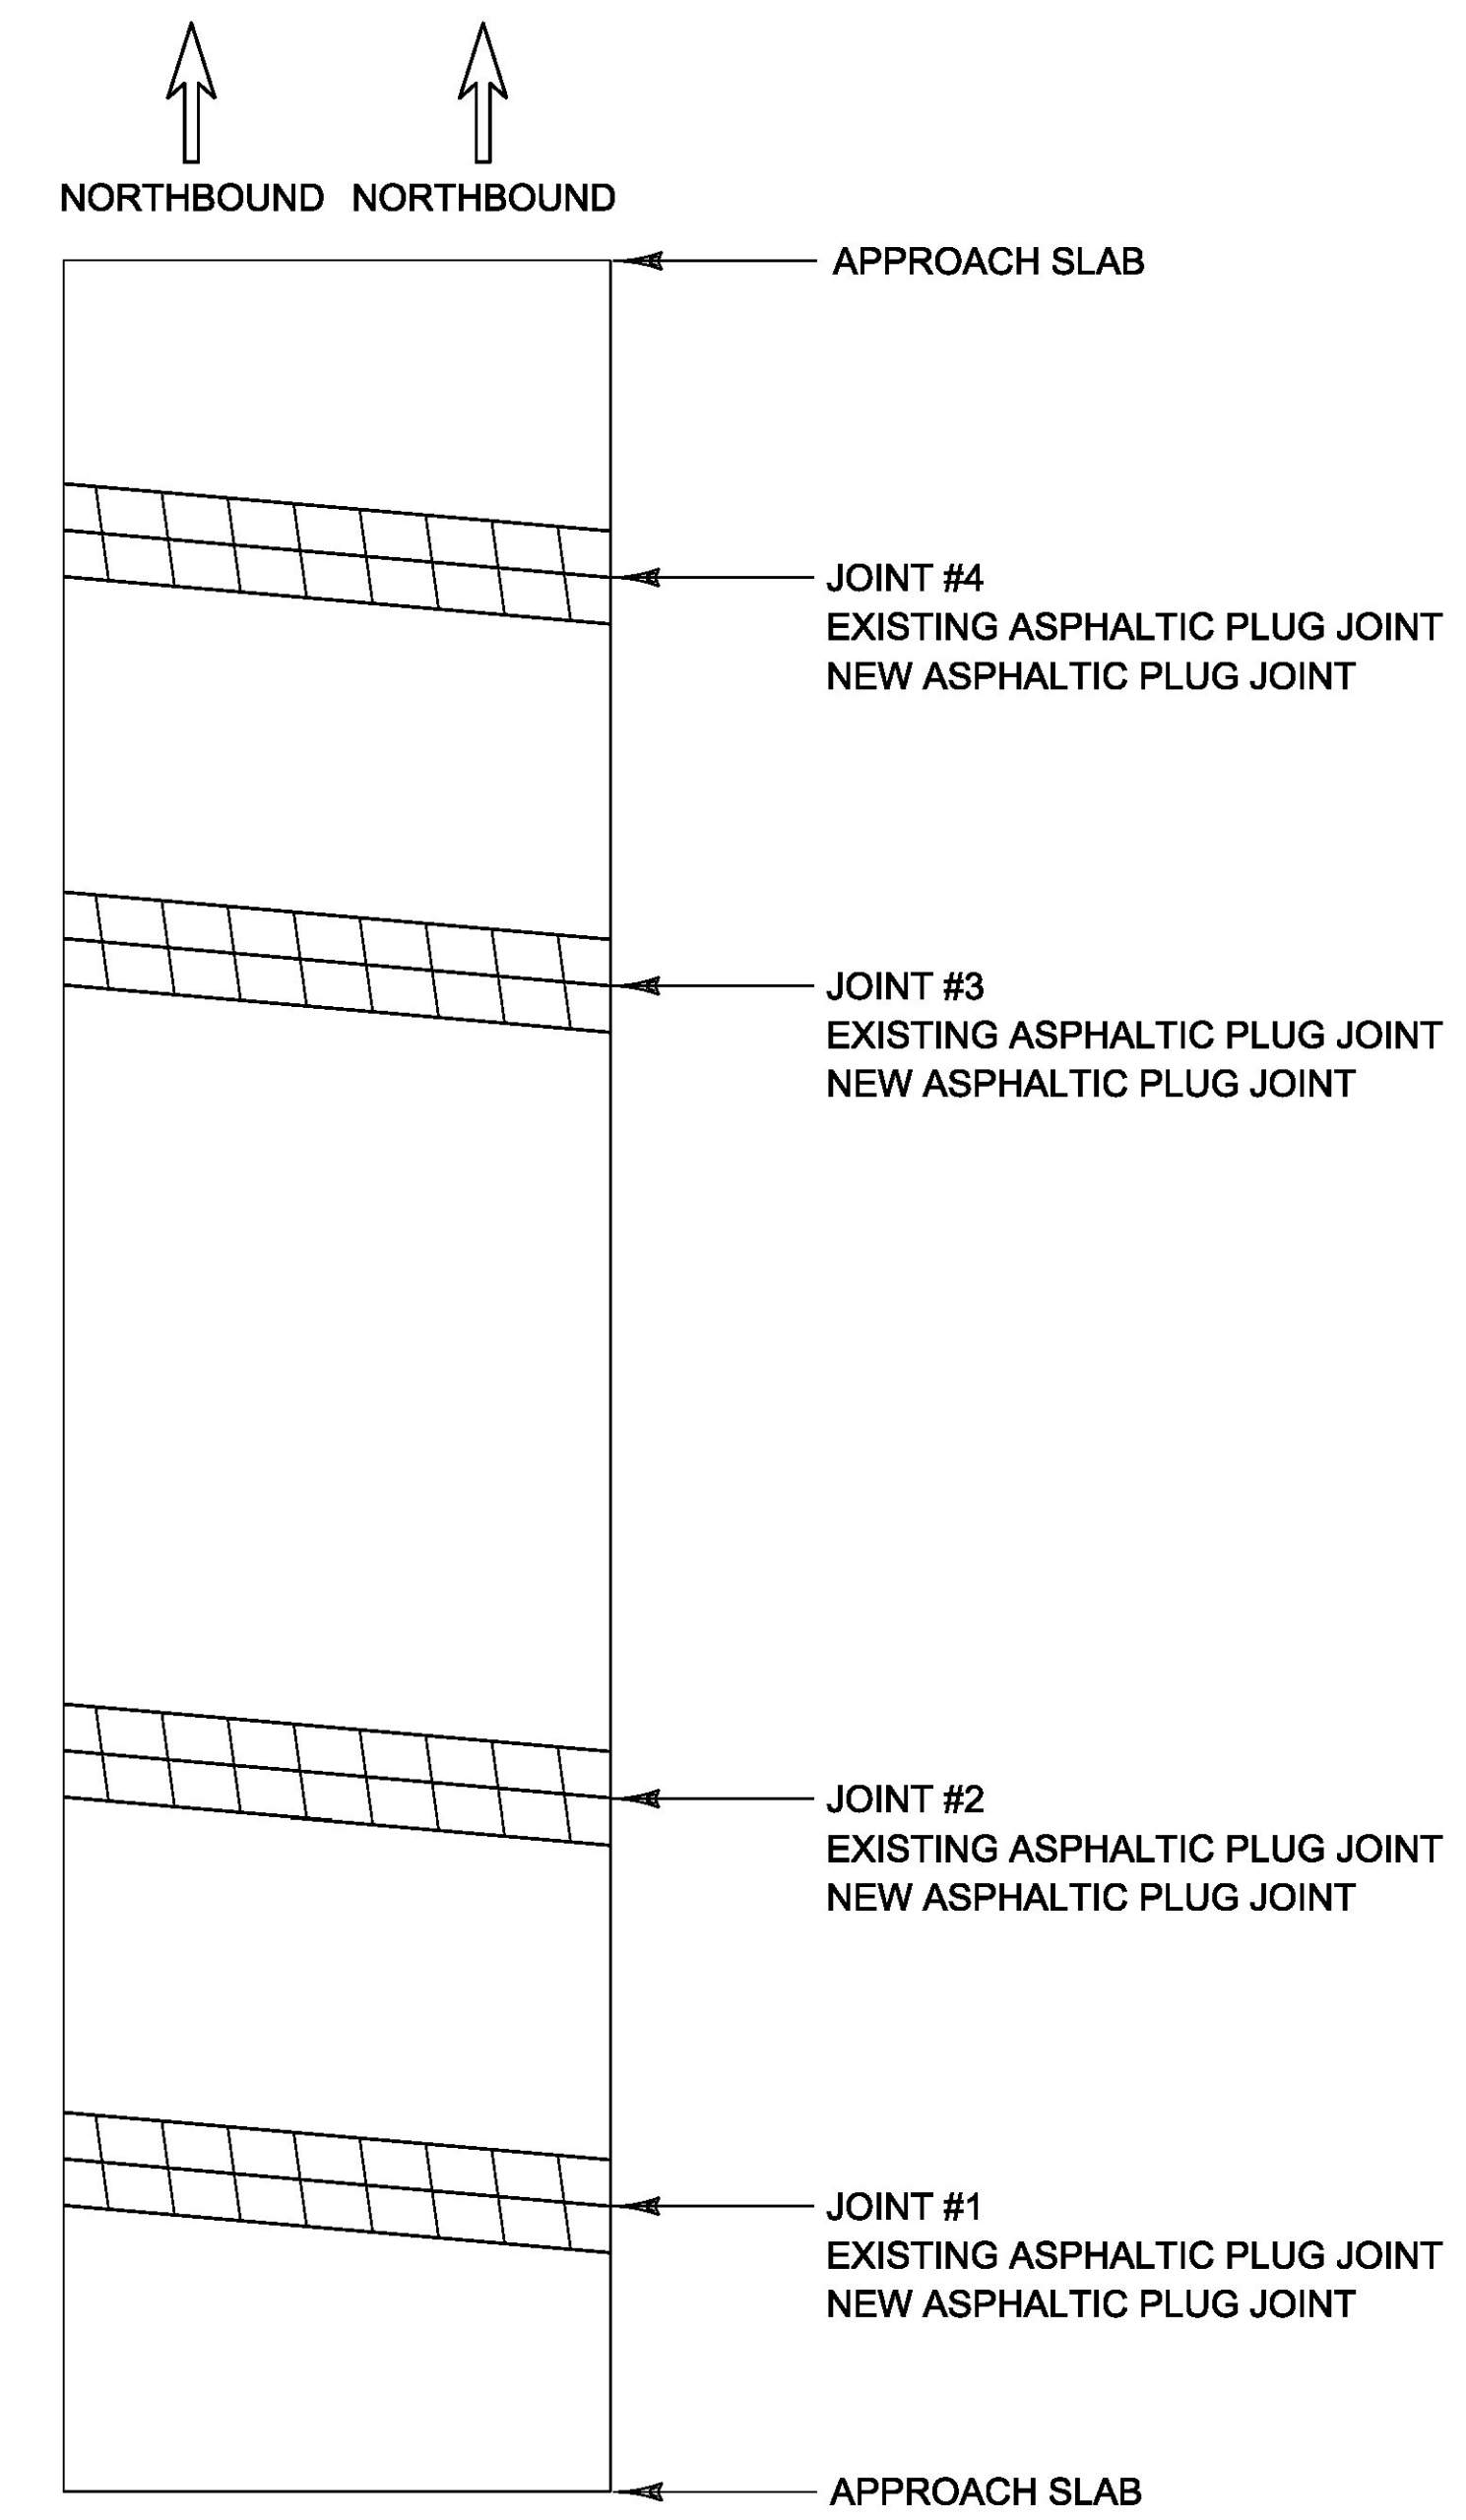

**BRIDGE #93-N**  
MM 117.633 - ST. ALBANS

LENGTH OF NEW ASPHALTIC PLUG JOINTS:  
 JOINT #1 = 37'  
 JOINT #2 = 37'  
 JOINT #3 = 37'  
 JOINT #4 = 37'  
 TOTAL = 148'

PROJECT NAME: COLCHESTER-SWANTON	
PROJECT NUMBER: IM SURF(56)	
FILE NAME: pl6v071_wrk.dgn	PLOT DATE: 09-DEC-2016
PROJECT LEADER: M. FOWLER	DRAWN BY: B. KIPP
DESIGNED BY: B. KIPP	CHECKED BY: M. FOWLER
BRIDGE DETAIL SHEET 10	SHEET 23 OF 54