

DURABLE 6 INCH WHITE LINE (OPTION BID ITEM)

RAMP B:
B0+00 - B12+00 LT (EDGE LINE LT)
B7+00 - A12+00 LT (DOTTED LANE LINE)

DURABLE 6 INCH YELLOW LINE (OPTION BID ITEM)

RAMP B:
B0+40 - B5+00 RT (EDGE LINE RT)

DURABLE 12 INCH WHITE LINE (OPTION BID ITEM)

RAMP B:
B5+00 - B7+00 RT (GORE LINES RAMP B)

DURABLE LETTER OR SYMBOL (OPTION BID ITEM)

RAMP B:
B2+00 CL WRONG WAY ARROW 1 EA
B2+75 CL "A,H,E,A,D" 5 EA
B3+25 CL "S,I,G,N,A,L" 6 EA

TEMPORARY 6 INCH WHITE LINE, PAINT

RAMP B:
B0+00 - B12+00 LT (EDGE LINE LT)
B7+00 - A12+00 LT (DOTTED LANE LINE)

TEMPORARY 6 INCH YELLOW LINE, PAINT


RAMP B:
B0+40 - B5+00 RT (EDGE LINE RT)

TEMPORARY 12 INCH WHITE LINE, PAINT

RAMP B:
B5+00 - B7+00 RT (GORE LINES RAMP B)

TEMPORARY LETTER OR SYMBOL, PAINT

RAMP B:
B2+00 CL WRONG WAY ARROW 1 EA
B2+75 CL "A,H,E,A,D" 5 EA
B3+25 CL "S,I,G,N,A,L" 6 EA

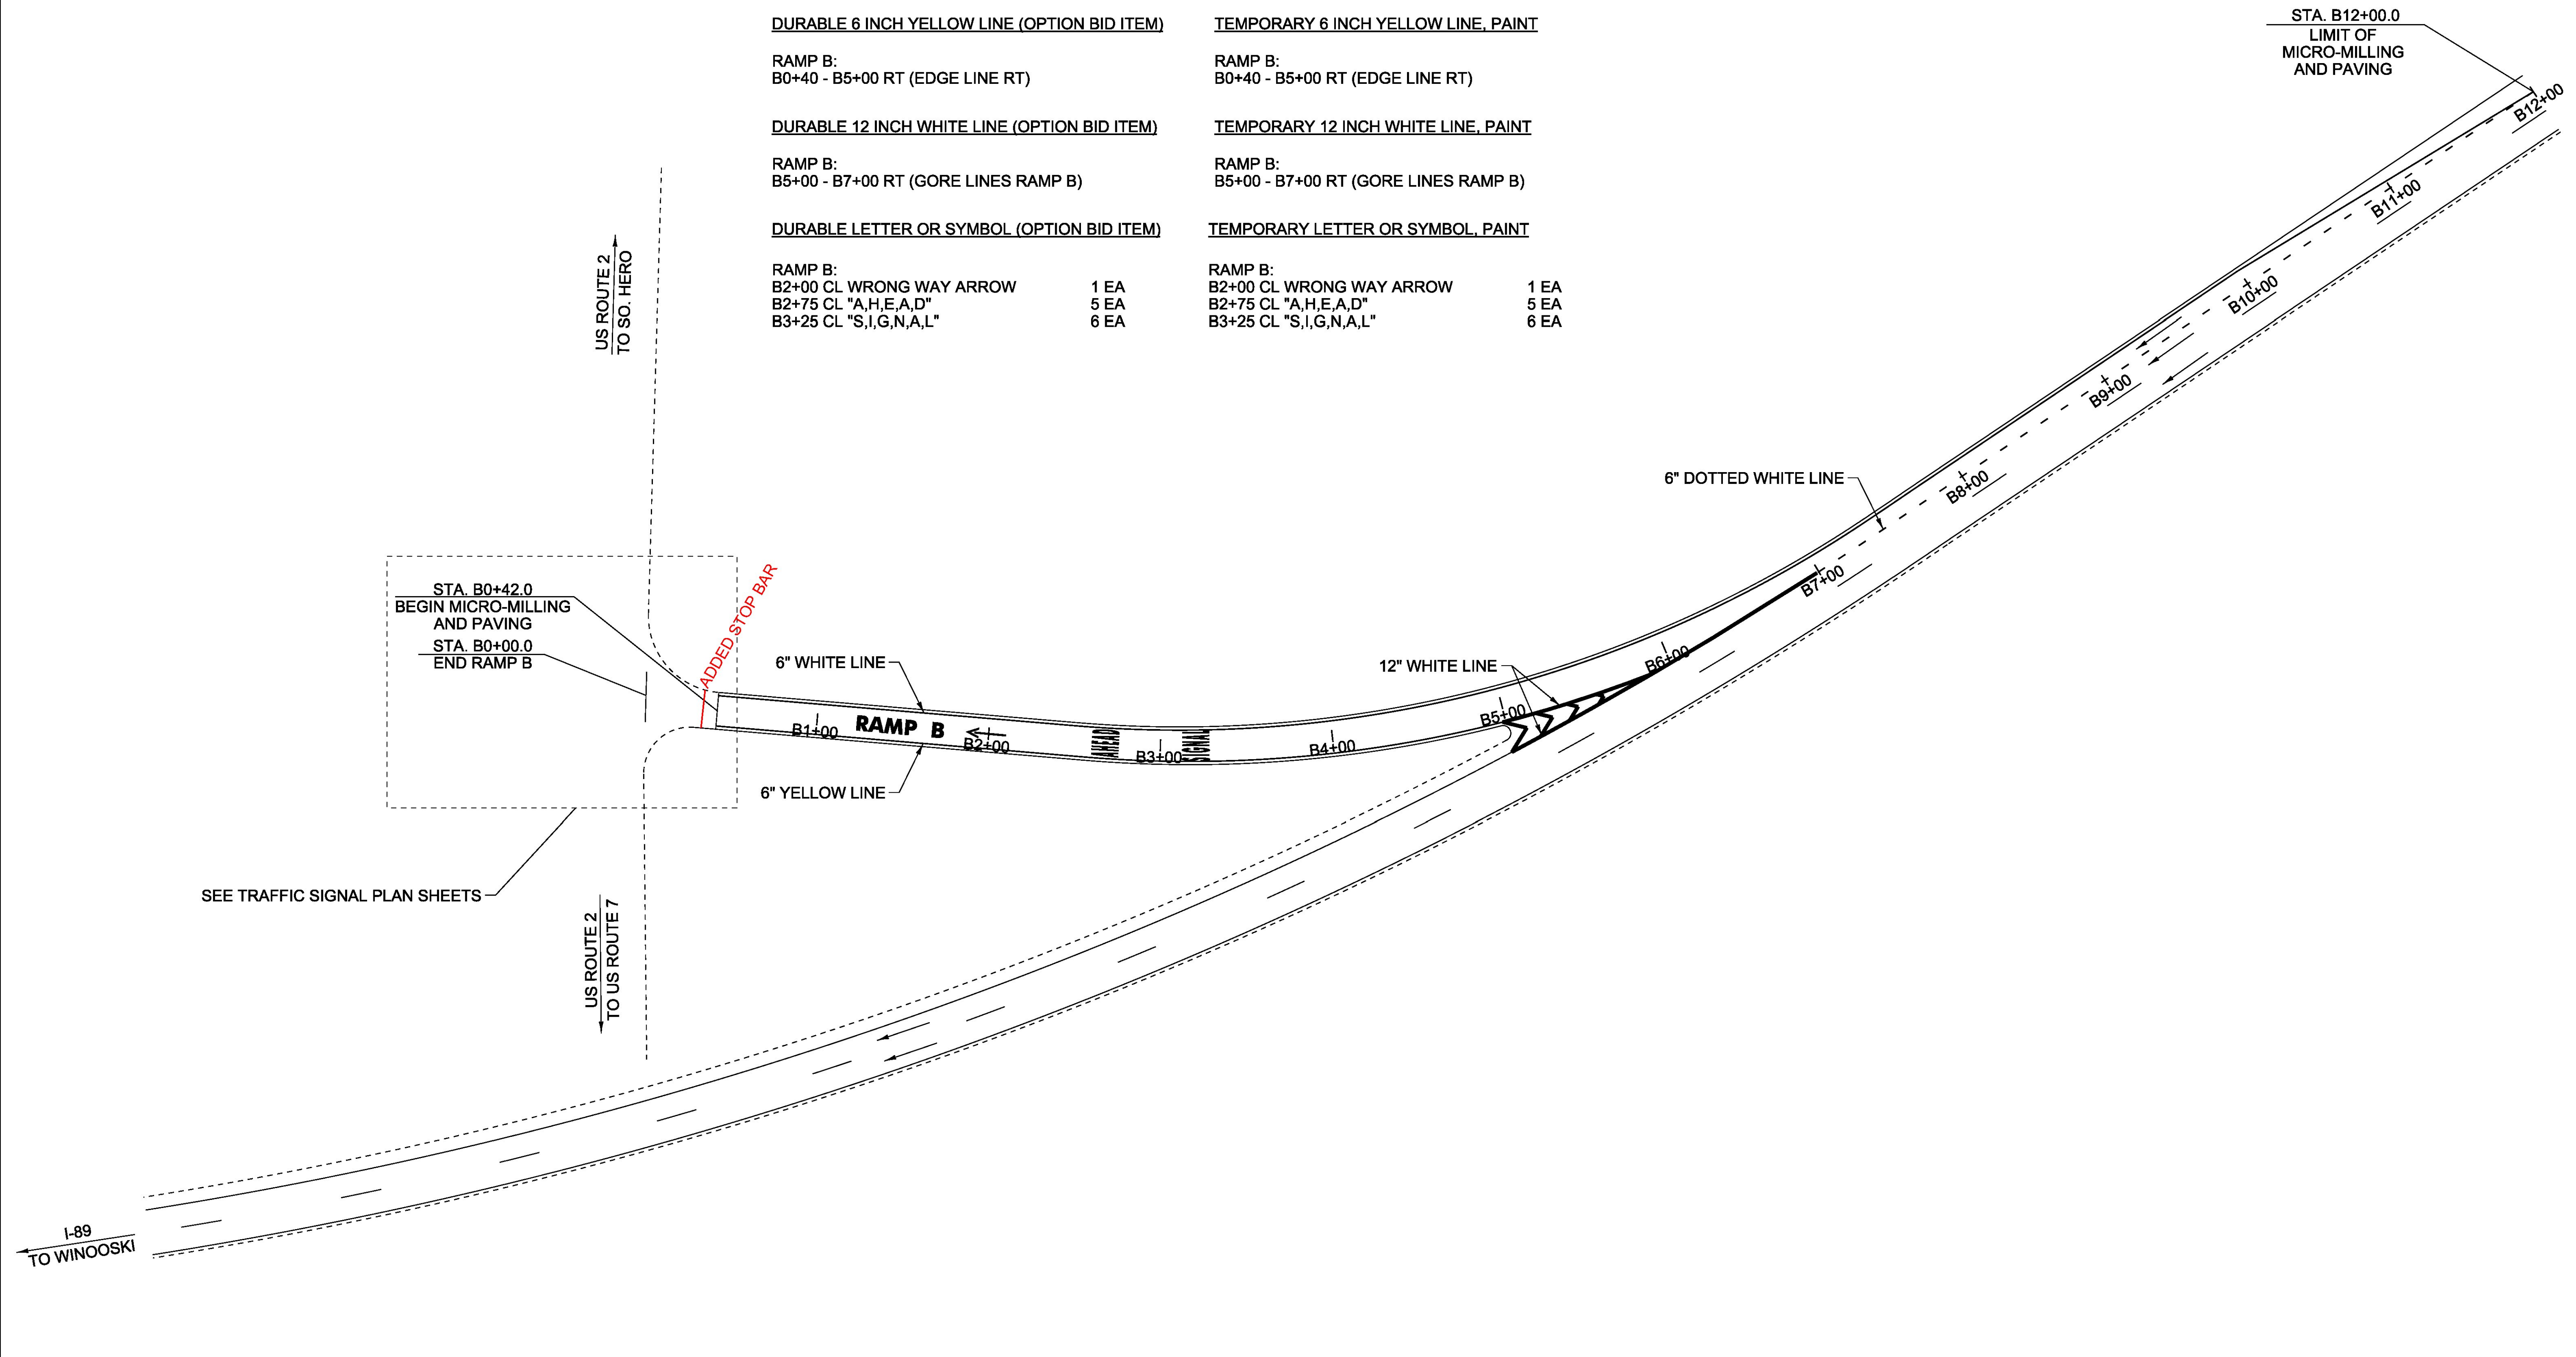

**INTERCHANGE NO. 17 - SOUTHBOUND
RAMP B**

NOT TO SCALE

PROJECT NAME:	COLCHESTER-SWANTON
PROJECT NUMBER:	IM SURF(56)
FILE NAME:	pl6v07l_wrk.dgn
PROJECT LEADER:	M. FOWLER
DESIGNED BY:	B. KIPP
PLAN SHEET	6
PLOT DATE:	09-DEC-2016
DRAWN BY:	B. KIPP
CHECKED BY:	PVT. MGT.
SHEET	31 OF 54