

DURABLE 6 INCH WHITE LINE (OPTION BID ITEM) TEMPORARY 6 INCH WHITE LINE, PAINT

RAMP C:
C0+00 - C15+00 LT (EDGE LINE LT)
C10+40 - C15+00 CL (DOTTED LANE LINE)

RAMP C:
C0+00 - C15+00 LT (EDGE LINE LT)
C10+40 - C15+00 CL (DOTTED LANE LINE)

RAMP D:
D0+00 - A20+50 LT (EDGE LINE LT)
D0+00 - D11+50 CL (DOTTED LANE LINE)

RAMP D:
D0+00 - A20+50 LT (EDGE LINE LT)
D0+00 - D11+50 CL (DOTTED LANE LINE)

DURABLE 6 INCH YELLOW LINE (OPTION BID ITEM) TEMPORARY 6 INCH YELLOW LINE, PAINT

RAMP C:
C0+00 - C9+50 LT (EDGE LINE RT)

RAMP C:
C0+00 - C9+50 LT (EDGE LINE RT)

RAMP D:
D12+50 - C20+50 LT (EDGE LINE RT)

RAMP D:
D12+50 - C20+50 LT (EDGE LINE RT)

DURABLE 12 INCH WHITE LINE (OPTION BID ITEM) TEMPORARY 12 INCH WHITE LINE, PAINT

RAMP C:
C9+50 - C10+50 LT (GORE LINES RAMP C)

RAMP C:
C9+50 - C10+50 LT (GORE LINES RAMP C)

RAMP D:
D11+50 - D12+50 LT (GORE LINES RAMP D)

RAMP D:
D11+50 - D12+50 LT (GORE LINES RAMP D)

DURABLE LETTER OR SYMBOL (OPTION BID ITEM) TEMPORARY LETTER OR SYMBOL, PAINT

RAMP C: C0+50 CL "S,T,O,P" (4 EA)	RAMP C: C0+50 CL "S,T,O,P" (4 EA)
C2+84 CL WRONG WAY ARROW (1 EA)	C2+84 CL WRONG WAY ARROW (1 EA)
C5+40 CL "S,T,O,P" (4 EA)	C5+40 CL "S,T,O,P" (4 EA)
C5+80 CL "A,H,E,A,D" (5 EA)	C5+80 CL "A,H,E,A,D" (5 EA)


RAMP D: D16+50 CL WRONG WAY ARROW (1 EA)	RAMP D: D16+50 CL WRONG WAY ARROW (1 EA)
--	--

DURABLE 24 INCH STOP BAR (OPTION BID ITEM) TEMPORARY 24 INCH STOP BAR, PAINT

RAMP C: C0+20 CL	RAMP C: C0+20 CL
---------------------	---------------------

REHAB. DROP INLETS, CATCH BASINS, OR MANHOLES, CLASS I

RAMP C:
2 EACH

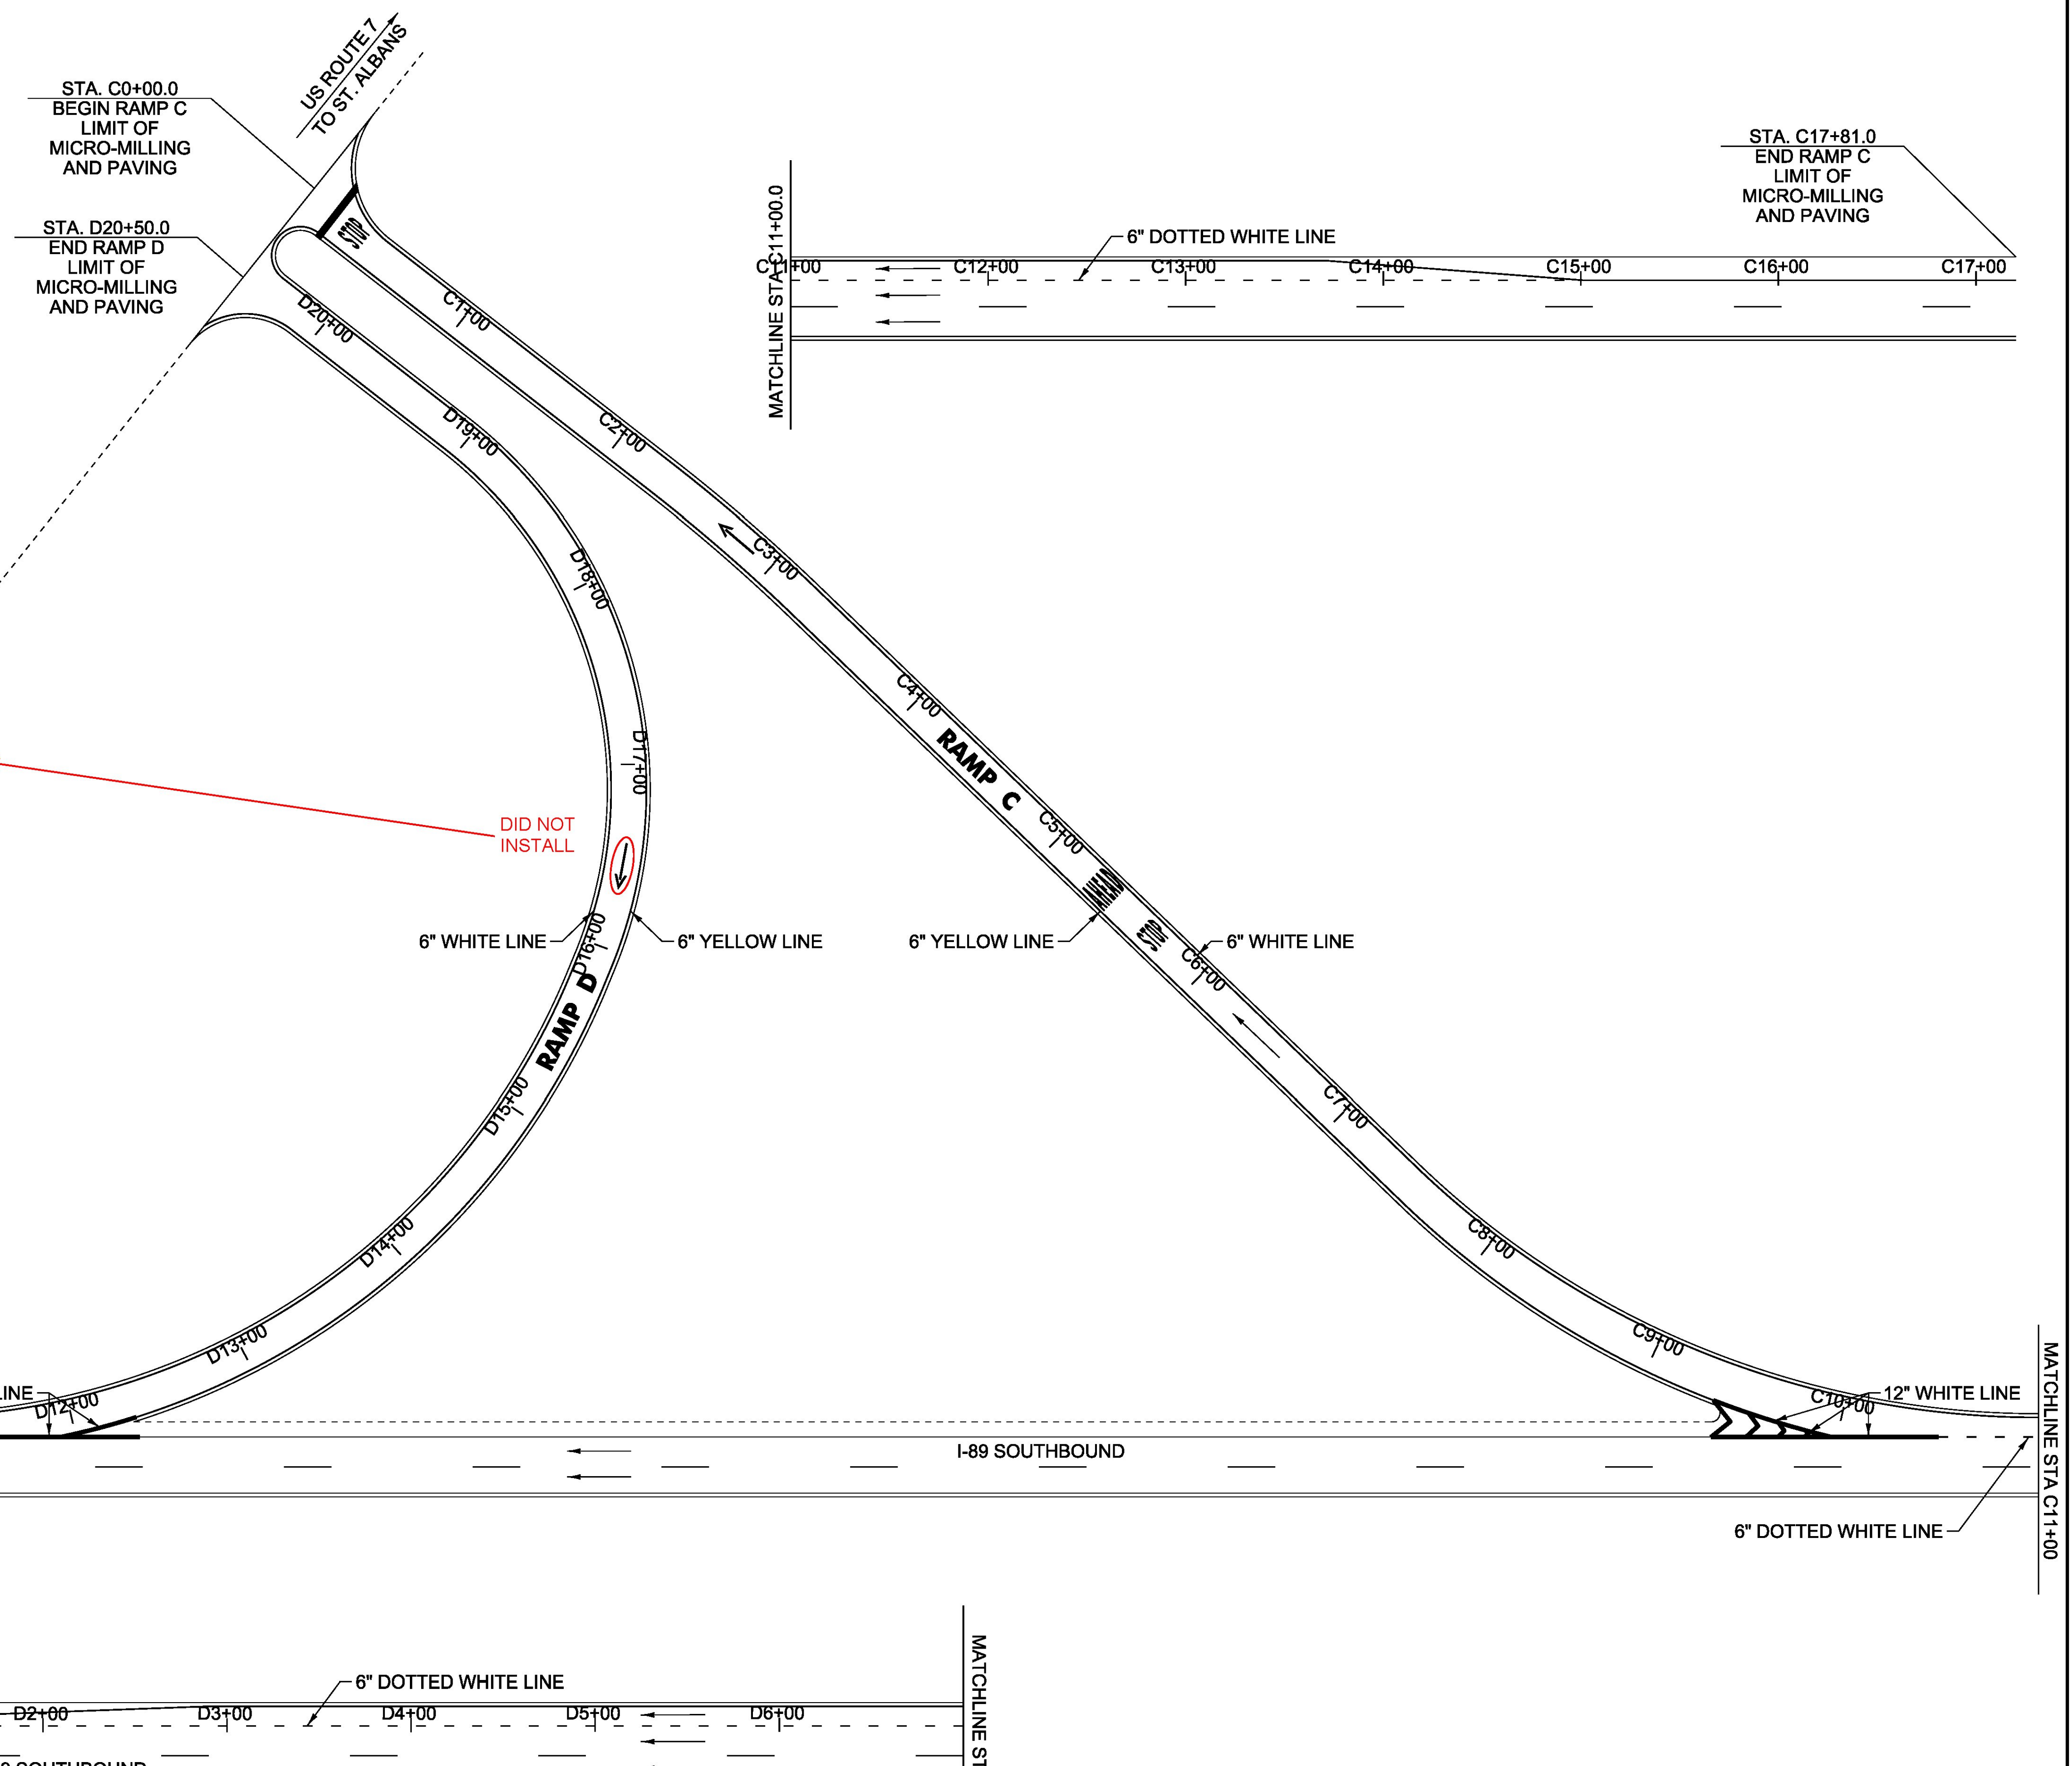

**INTERCHANGE NO. 18 - SOUTHBOUND
RAMP C & D**

NOT TO SCALE

PROJECT NAME: COLCHESTER-SWANTON	PLOT DATE: 09-DEC-2016
PROJECT NUMBER: IM SURF(56)	DRAWN BY: B. KIPP
FILE NAME: pl6v071_wrk.dgn	CHECKED BY: M. FOWLER
PROJECT LEADER: M. FOWLER	SHEET 33 OF 54
DESIGNED BY: B. KIPP	
PLAN SHEET 8	