

DURABLE 6 INCH WHITE LINE (OPTION BID ITEM)

RAMP A:  
A0+00 - A14+00 LT (EDGE LINE LT)  
A9+60 - A13+75 CL (DOTTED LANE LINE)

TEMPORARY 6 INCH WHITE LINE, PAINT

RAMP A:  
A0+00 - A14+00 LT (EDGE LINE LT)  
A9+60 - A13+75 CL (DOTTED LANE LINE)

DURABLE 6 INCH YELLOW LINE (OPTION BID ITEM)

RAMP A:  
A0+00 - A8+35 RT (EDGE LINE RT)

TEMPORARY 6 INCH YELLOW LINE, PAINT


RAMP A:  
A0+00 - A8+35 RT (EDGE LINE RT)

DURABLE 12 INCH WHITE LINE (OPTION BID ITEM)

RAMP A:  
A8+35 - A9+60 RT (EDGE LINE RT)

TEMPORARY 12 INCH WHITE LINE, PAINT

RAMP A:  
A8+35 - A9+60 RT (EDGE LINE RT)

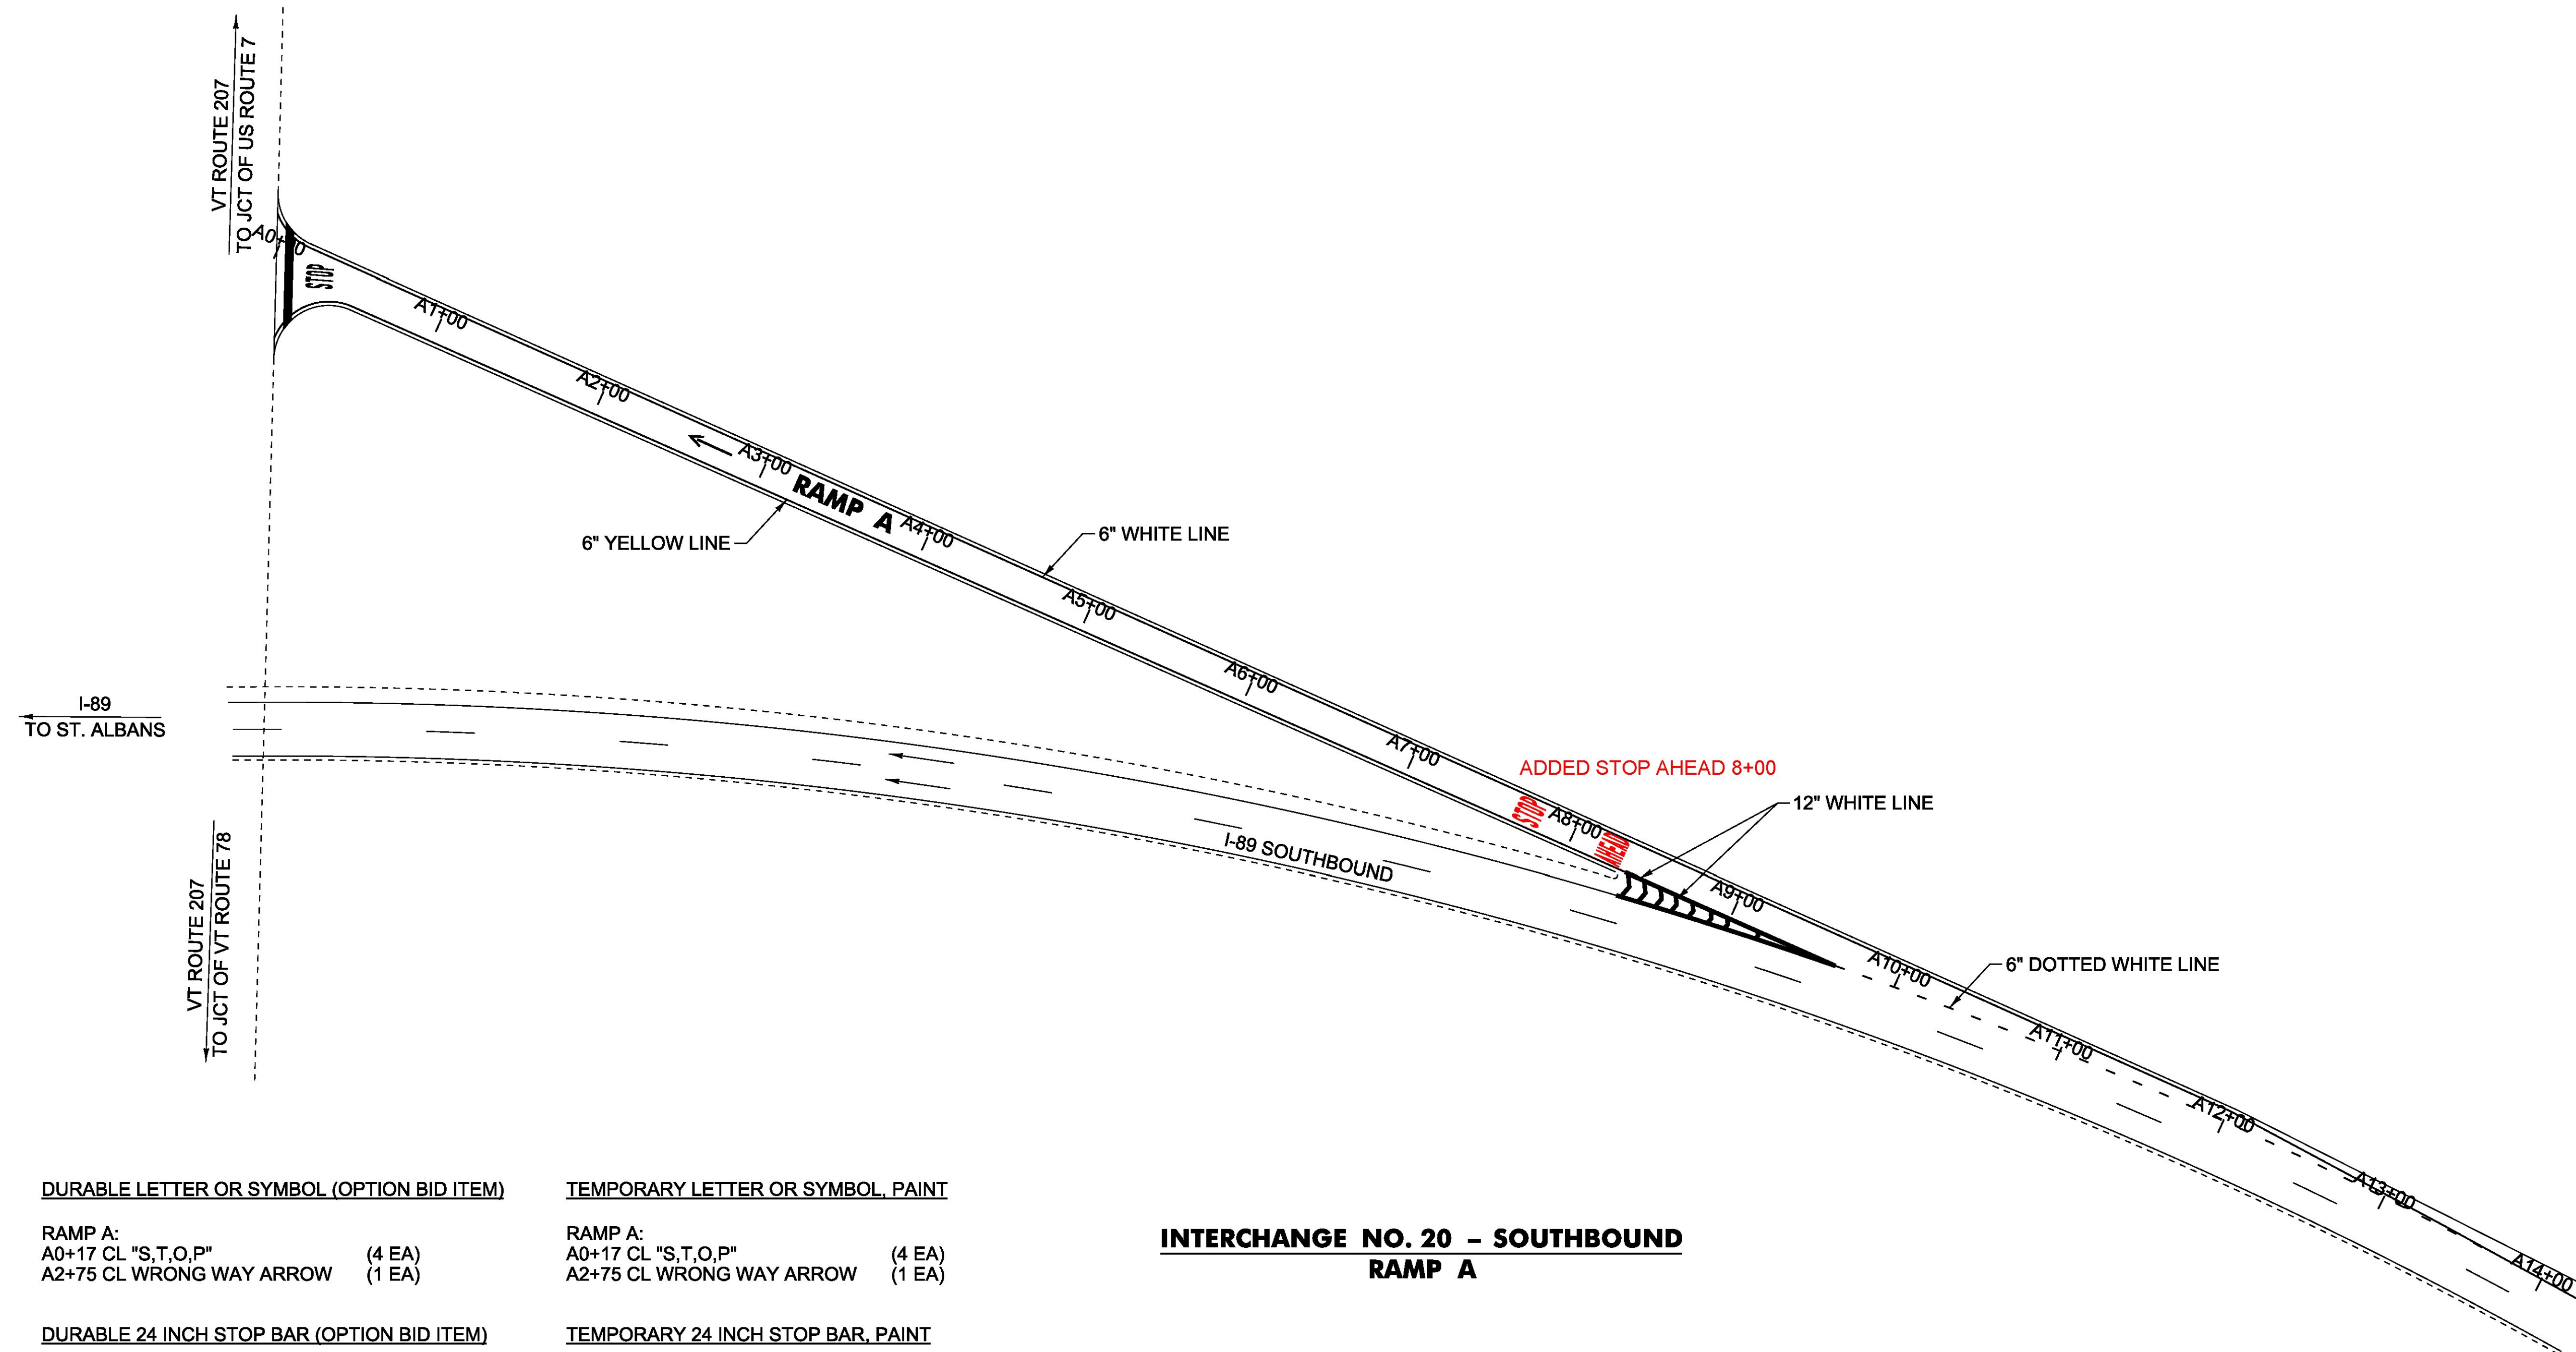

**INTERCHANGE NO. 20 - SOUTHBOUND  
RAMP A**

DURABLE LETTER OR SYMBOL (OPTION BID ITEM)

RAMP A:  
A0+17 CL "S,T,O,P" (4 EA)  
A2+75 CL WRONG WAY ARROW (1 EA)

TEMPORARY LETTER OR SYMBOL, PAINT

RAMP A:  
A0+17 CL "S,T,O,P" (4 EA)  
A2+75 CL WRONG WAY ARROW (1 EA)

DURABLE 24 INCH STOP BAR (OPTION BID ITEM)

RAMP A:  
A0+07 CL

TEMPORARY 24 INCH STOP BAR, PAINT

RAMP A:  
A0+07 CL

**NOT TO SCALE**

PROJECT NAME: COLCHESTER-SWANTON  
PROJECT NUMBER: IM SURF(56)

FILE NAME: pl6v07l_wrk.dgn	PLOT DATE: 09-DEC-2016
PROJECT LEADER: M. FOWLER	DRAWN BY: B. KIPP
DESIGNED BY: B. KIPP	CHECKED BY: M. FOWLER
PLAN SHEET 14	SHEET 39 OF 54