
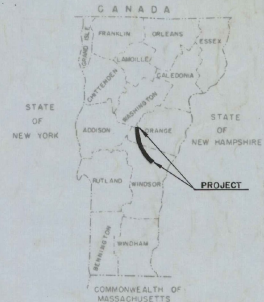
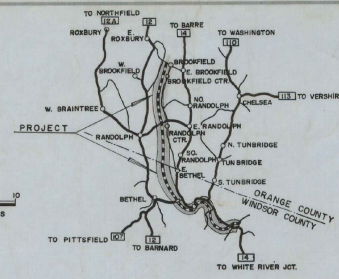




STATE OF VERMONT DEPARTMENT OF HIGHWAYS PROPOSED IMPROVEMENT

INTERSTATE PROJECT

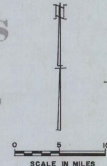


TOWNS OF SHARON-ROYALTON
COUNTY OF WINDSOR
INTERSTATE ROUTE 89
WHITE RIVER JCT.—MONTPELIER ROAD
BEGINNING AT A POINT 2.362 MILES SOUTHEAST OF THE SHARON-ROYALTON TOWN LINE AND EXTENDING NORTH-WESTERLY 8.721 MILES
LENGTH OF ROADWAY 43,558.38 FT. = 8.250 MILES
LENGTH OF BRIDGES 2,488.44 FT. = 0.471 MILE
LENGTH OF PROJECT 46,046.82 FT. = 8.721 MILES

 1193+00
END PROJECT I 89-1 (26) BEGIN PROJECT I 89-1 (27)

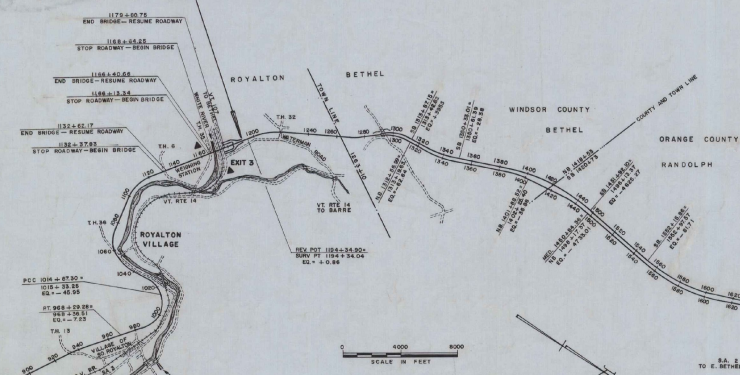

1705+00
END PROJECT I 89-1 (27) BEGIN PROJECT I 89-1 (28)


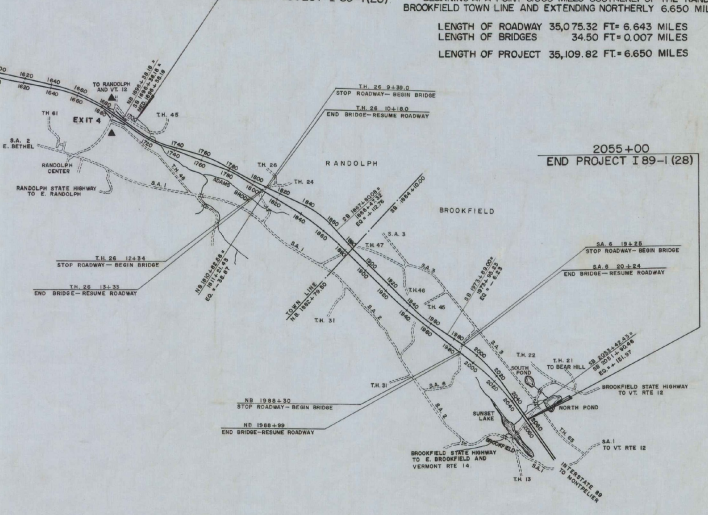


TOWNS OF RANDOLPH-BROOKFIELD
COUNTY OF ORANGE
INTERSTATE ROUTE 89
WHITE RIVER JCT.—MONTPELIER ROAD
BEGINNING AT A POINT 3.360 MILES SOUTHERLY OF THE RANDOLPH-BROOKFIELD TOWN LINE AND EXTENDING NORTHERLY 6.650 MILES
LENGTH OF ROADWAY 35,075.32 FT. = 6.643 MILES
LENGTH OF BRIDGES 34.50 FT. = 0.007 MILES
LENGTH OF PROJECT 35,109.82 FT. = 6.650 MILES

2055+00
END PROJECT I 89-1 (28)

732+00
END PROJECT I 89-1 (26)
BEGIN PROJECT I 89-1 (27)

TOWNS OF ROYALTON-BETHEL-RANDOLPH
COUNTIES OF WINDSOR & ORANGE
INTERSTATE ROUTE 89
WHITE RIVER JCT.—MONTPELIER ROAD
BEGINNING AT A POINT 1.528 MILES SOUTHERLY OF THE ROYALTON-BETHEL TOWN LINE AND EXTENDING NORTHERLY 8.795 MILES
LENGTH OF PROJECT 46,436.68 FT. = 8.795 MILES

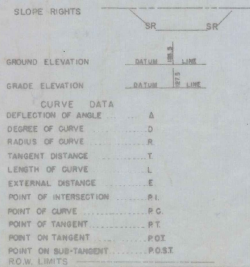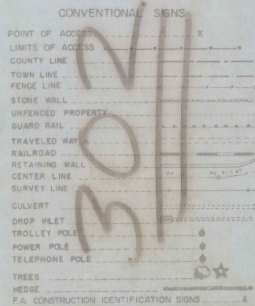

FOR RIGHT OF WAY DETAILS,
SEE RIGHT OF WAY PLANS FOR THIS PROJECT.

APPROVED *J.S. Chase*
DISTRICT ENGINEER
DATE Dec 27, 1968

APPROVED *R.H. Nicholson*
DATE Dec 27, 1968

APPROVED *K.C. Lab*
DATE Dec 27, 1968

APPROVED *Ludjov*
DATE Dec 27, 1968

APPROVED *L.M. Lane*
DATE 12/27/68

APPROVED *E.H. Stebbins*
DATE 12/27/68

APPROVED *R.H. Carroll*
DATE Dec 27, 1968

THESE PLANS ARE SUBJECT TO SUCH REVISIONS AS MAY BE REQUIRED BY THE BUREAU OF PUBLIC ROADS OR THE COMMISSIONER OF HIGHWAYS.
CONSTRUCTION IS TO BE CARRIED ON IN ACCORDANCE WITH THESE PLANS AND THE STANDARD SPECIFICATIONS FOR HIGHWAY AND BRIDGE CONSTRUCTION DATED APRIL 1964, AS APPROVED BY THE BUREAU OF PUBLIC ROADS ON OCTOBER 12, 1964, INCLUDING ALL SUBSEQUENT APPROVED REVISIONS AND SUCH REVISED SPECIFICATIONS AND SPECIAL PROVISIONS AS ARE INCORPORATED IN THESE PLANS.

| | | |
|--|----------|----------------------|
| DEPARTMENT OF TRANSPORTATION BUREAU OF PUBLIC ROADS | | |
| APPROVED | ENGINEER | DATE |
| PROJECT I | NO. 89-1 | (26) (27) (28) |
| SHEET 1 OF 3 SHEETS | | |

*

1969

Royalton-Bethel-Randolph

I-89-1

(26)
(27)
(28)

1969