

EROSION MATTING
ITEM 654.20
ML 54+50-56+00 RT

GUARDRAIL SPD STEEL
BEAM W/ WOOD POSTS, TYPE III
ITEM 621.23
56+00-56+00 RT
53+00-53+00 RT

FLYING SAUCE TREE
FOR ST. JOHN ST. EASEMENT
W/ WOOD POSTS, TYPE III
ITEM 601.17
56+00-56+00 RT
53+00-53+00 RT


Treated Timber Curb
56+50 - 57+64 RT
57+00 - 57+78 LT

Bituminous Surface for Gutters
and Traffic Islands (Islands)
ML RT 53+27 - 54+61 RT U.S. 5 RT.
US 5 54+71 - 55+12 LT
US 5 55+75 - 55+77 LT


R.B. HOAR INC. LESSOR
GAGNON MOTOR INC. LESSEE

HOLMES TERMINAL CORP.

BALLARD,
GEORGE A. & JANE M.

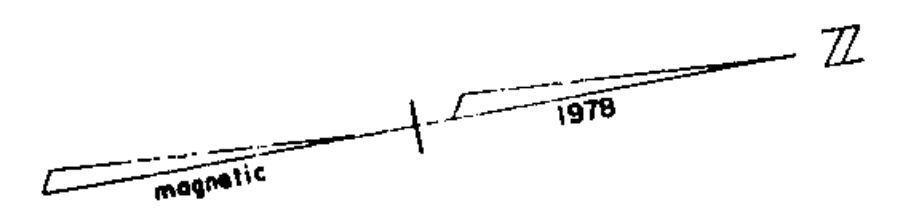

THIS SHEET TO BE USED
FOR ROW INFORMATION ONLY

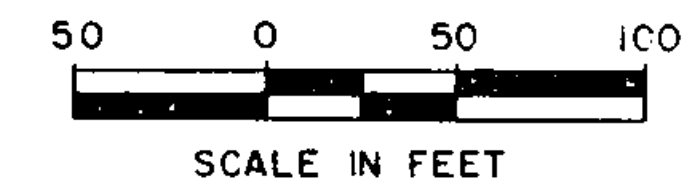

ROW PLANS

ROW SHEET 13 OF 16
ST JOHNSBURY

SURVEYED BY: Fall & Leonard DATE: 9/77
DRAWN BY: Trumbly DATE: 9/77
TRACED BY: Boyd DATE: 11/78

ST JOHNSBURY
DP FF 041-1(10)
SHEET 26 OF 229

BEGIN ROW PROJECT
DP FF 041(10) TH.95 51+50 C

BEGIN MAINT. AGREE. AREA NO. 1
STA. 53+85 19' RT LENGTH 6'

BEGIN RELINQUISHMENT NO. 1
END MAINT. AGREE. AREA NO. 1
STA. 53+85 25' RT

END RELINQUISHMENT NO. 1
STA. TH.95 52+80 C LENGTH 82'

CAST IN PLACE CEMENT CONCRETE
CURB, TYPE A ITEM 616.26
ML RT 53+27 - 54+31 RT U.S. 5 (Island)
US 5 54+71 - 55+25 LT (Island)
US 5 54+93 - 55+83 LT (Island)
US 5 51+00 - 53+30 LT (Island)

BEGIN APPROACH CONSTRUCTION

