


EROSION MATTING
ITEM 65420
ML 54+50-56+00 RT

GUARDRAIL STD STEEL
BEAM W/ WOOD POSTS, TYPE II
ITEM 62123



56+26.5-57+14 RT
56+53-57+28 LT

BREAKAWAY CABLE TIE
FOR GR RAIL, ST BEAM W/
WOOD POSTS, TYPE II
ITEM 62177

56+015-56+26.5 RT
56+20-56+53 LT

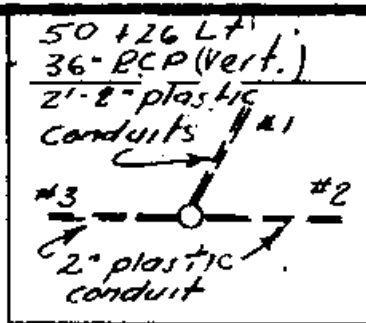

Treated Timber Curb
57+00 - 57+64 MRL
57+00 - 57+78 M LT

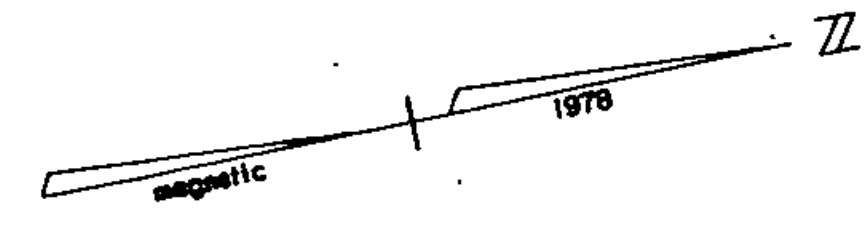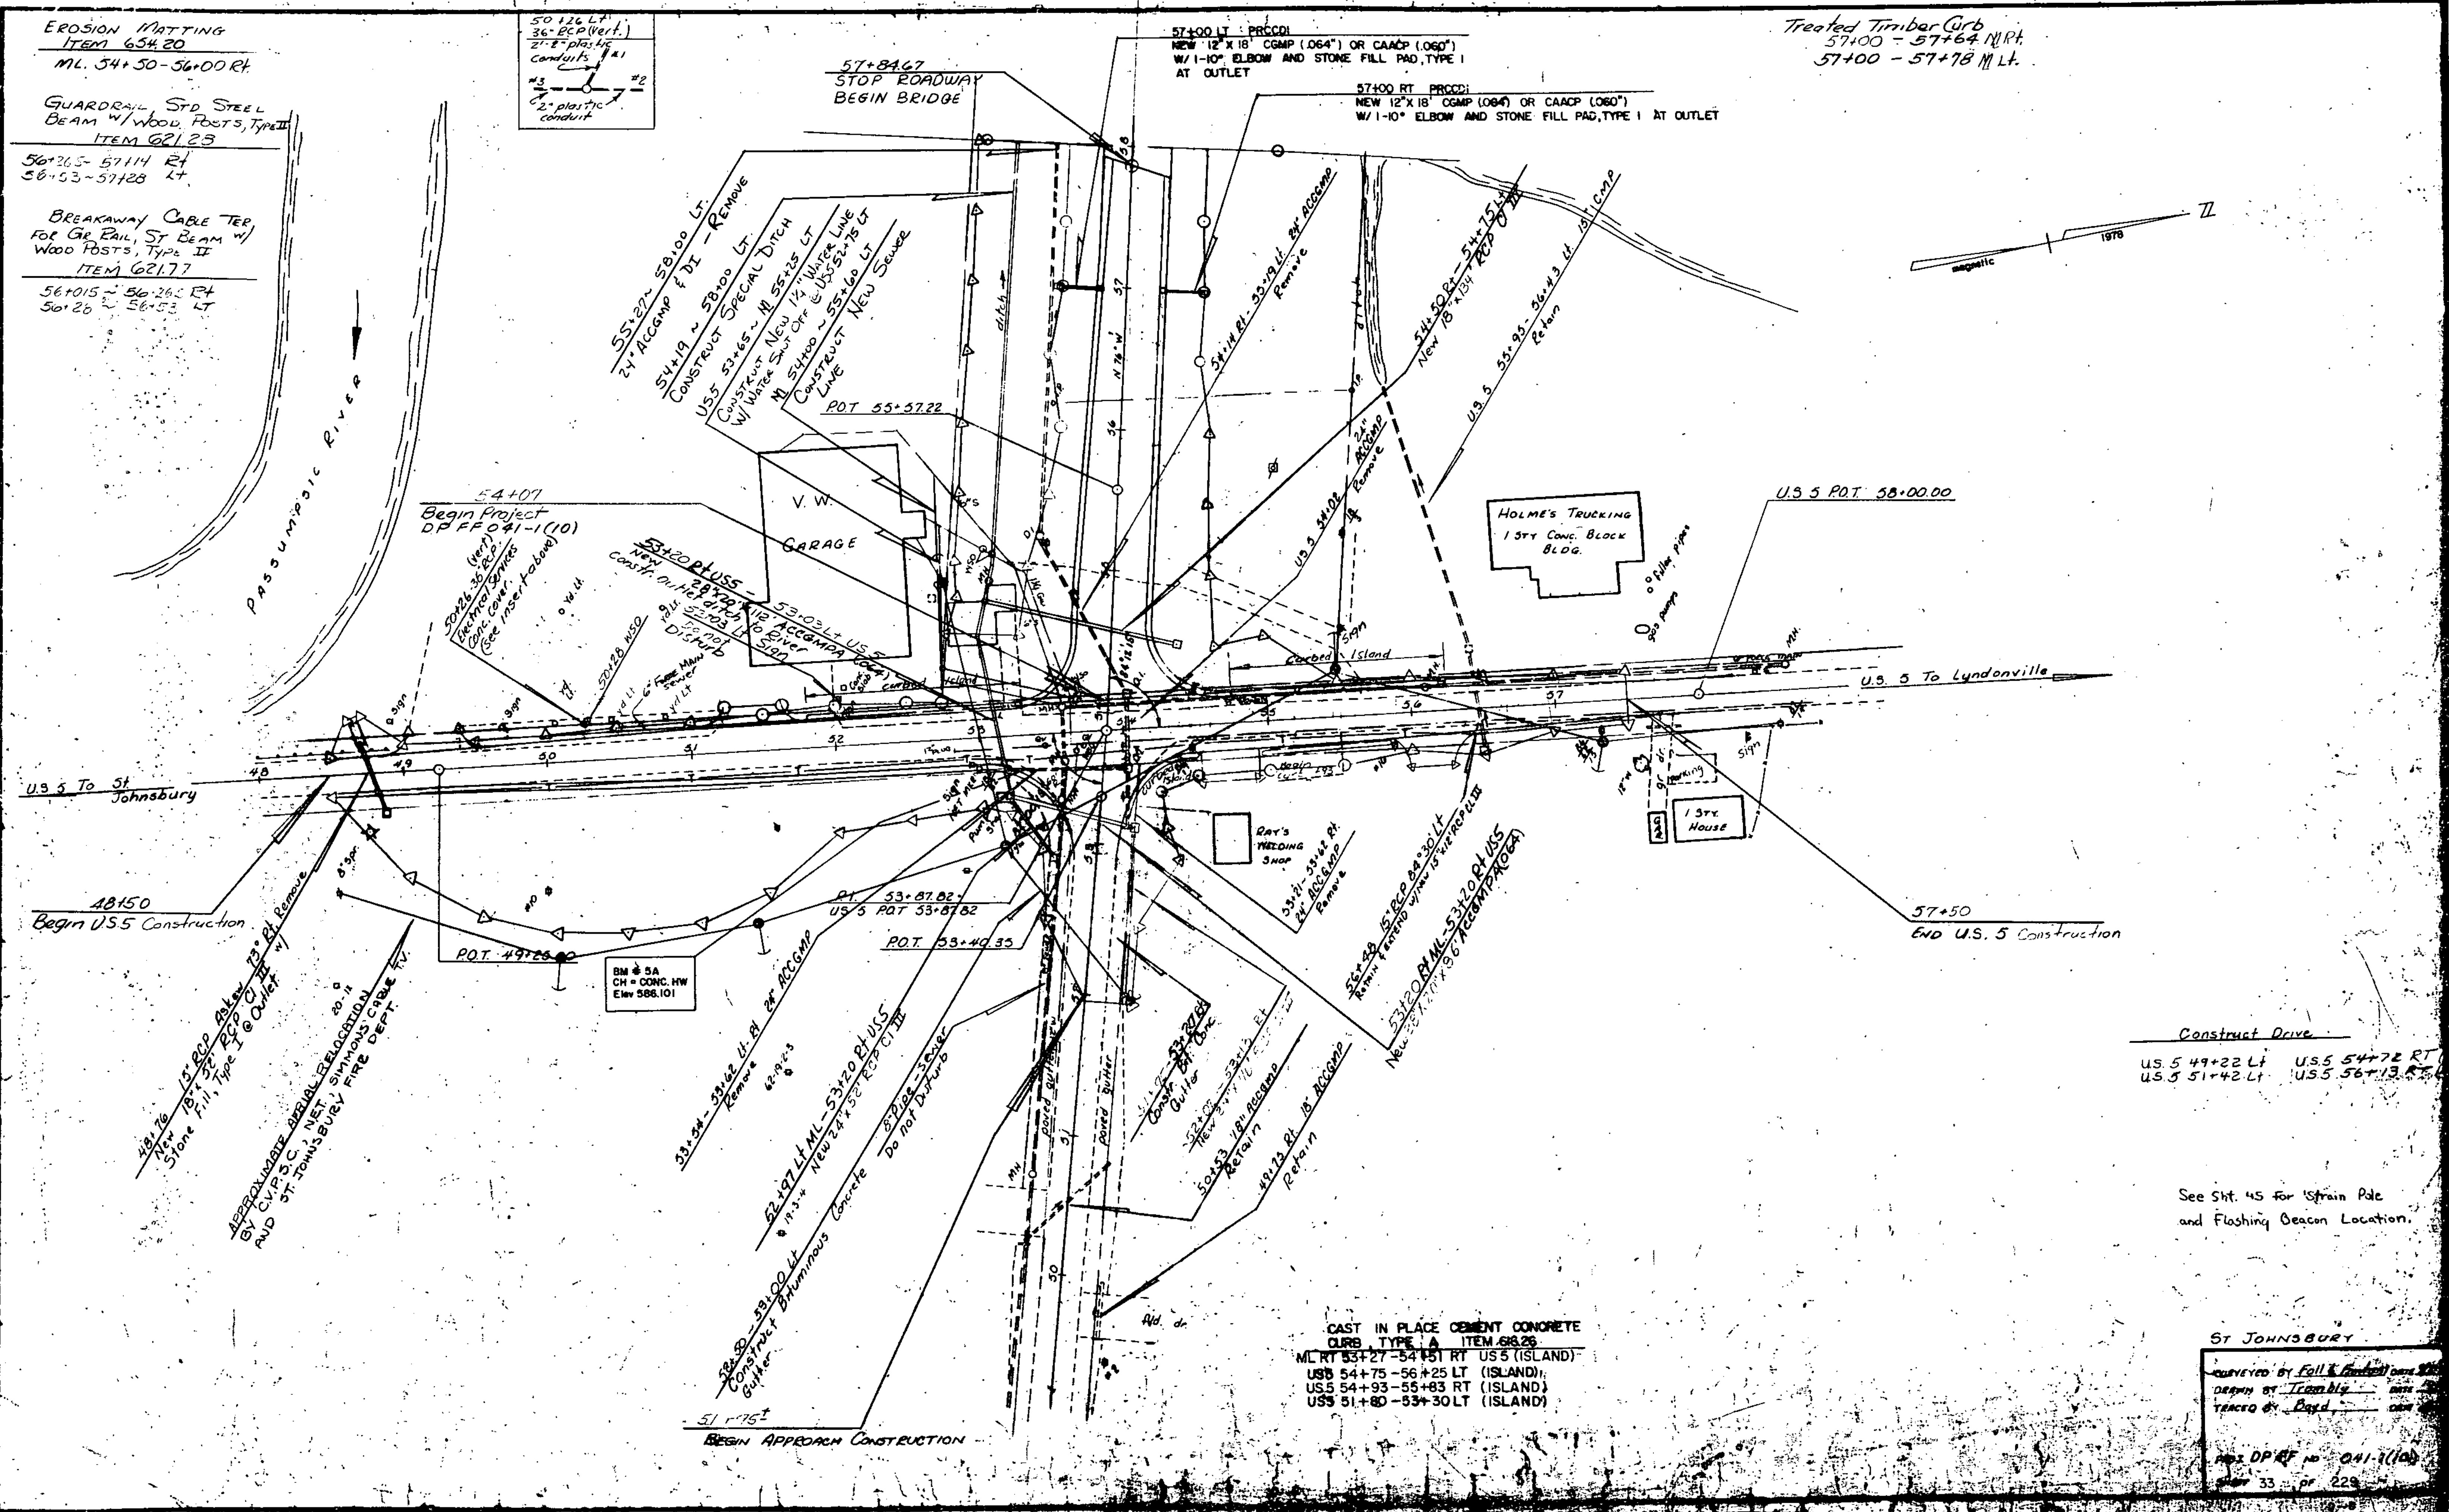

Construct Drive
US 5 49+22 LT US 5 54+72 RT
US 5 51+42 LT US 5 56+13 RT

See Sht. 45 for 'Strain Pole
and Flashing Beacon Location.

CAST IN PLACE CEMENT CONCRETE
CURB TYPE A ITEM 6826
ML RT 53+27-54+31 RT US 5 (ISLAND)
US 5 54+75-56+25 LT (ISLAND)
US 5 54+93-55+83 RT (ISLAND)
US 5 51+80-53+30 LT (ISLAND)

ST JOHNSBURY
Checked by Fall & ...
Design by ...
Traced by ...
Date D.P.R. No. 041-1(10)
Sheet 33 of 229