
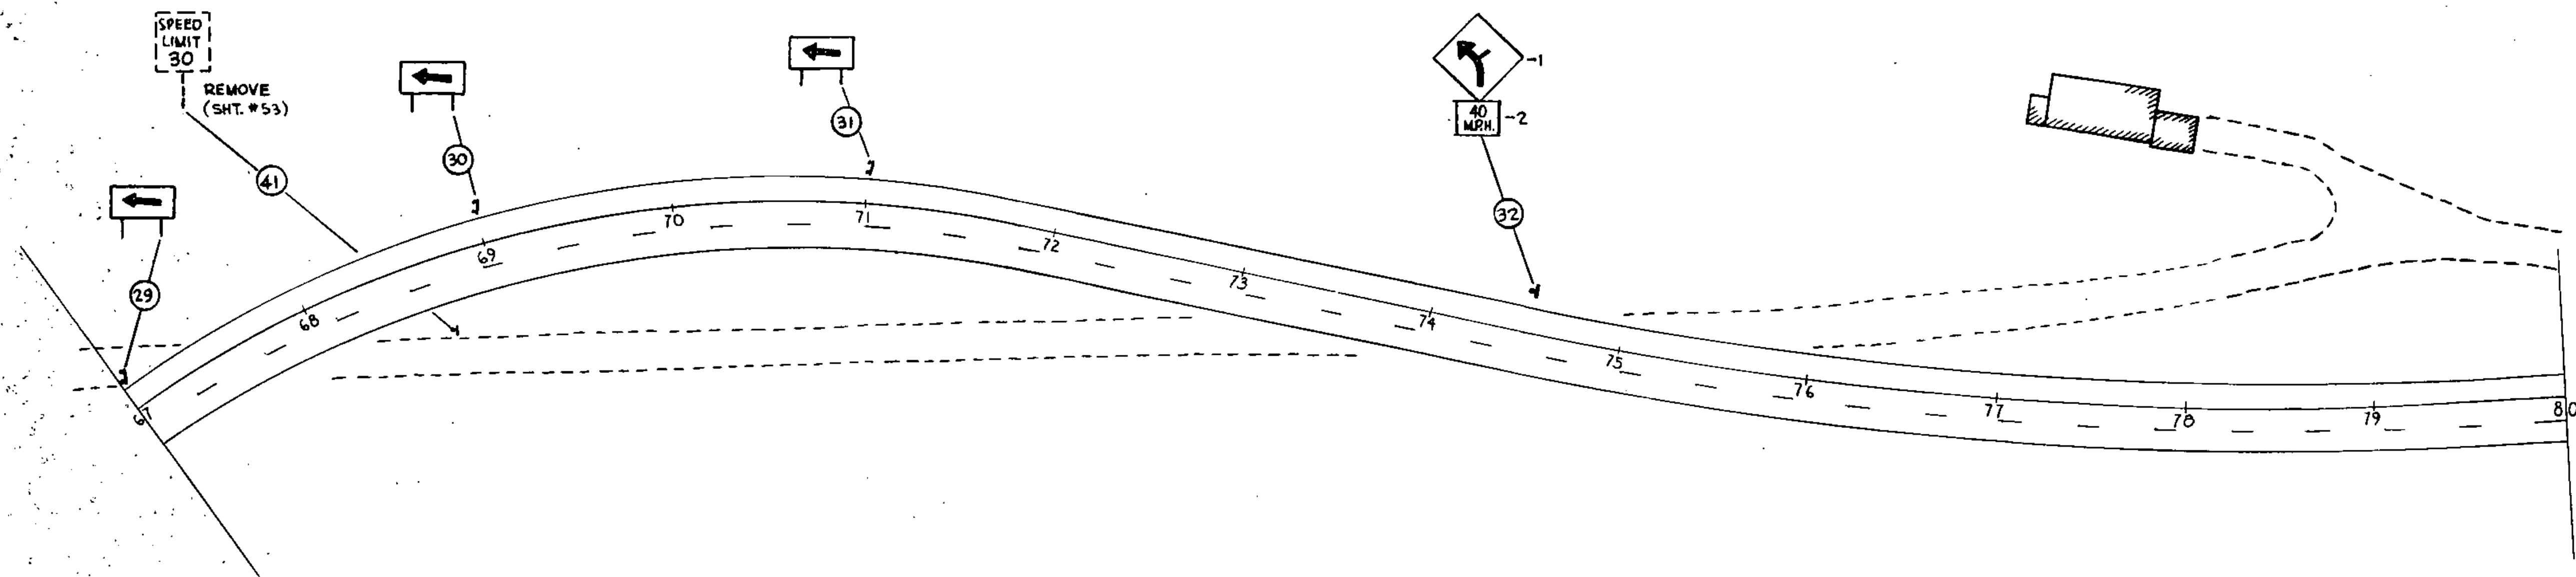


TEMPORARY 4" REFLECTORIZED WHITE LINE

67+00 ~ 80+00, 23' RT.
67+00 ~ 80+00, 12' LT.
67+00 ~ 80+00, 12' RT (DASHED)

TEMPORARY 4" REFLECTORIZED YELLOW LINE


67+00 ~ 80+00 & (OBL.)

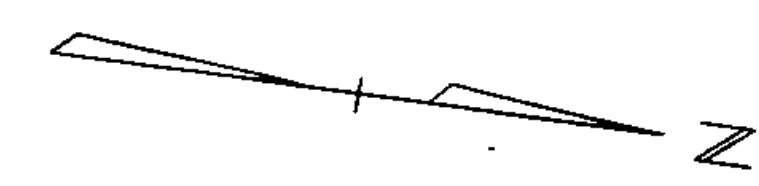

DATUM
VERTICAL _____
HORIZONTAL _____

LEGEND
[Dashed Box] - EXISTING SIGN
[Solid Box] - NEW SIGN

EXISTING SIGNS,
NEW SIGNS AND
PAVEMENT MARKINGS

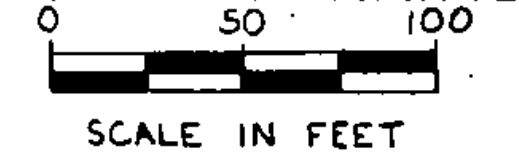

SURVEYED BY _____ DATE _____
DRAWN BY _____ DATE _____
TRACED BY JVS DATE 12/84
ST. JOHNSBURY
PROJ. DP FF NO. 041 - 1(10)
SHEET 48 OF 229