


* DETAIL B IS AT ABUTMENT #2. THE BEARING STIFFENERS AND CROSSFRAMES AT ABUTMENT #1, PIER #1 AND PIER #2 ARE SIMILAR. SEE SHEET BR107.

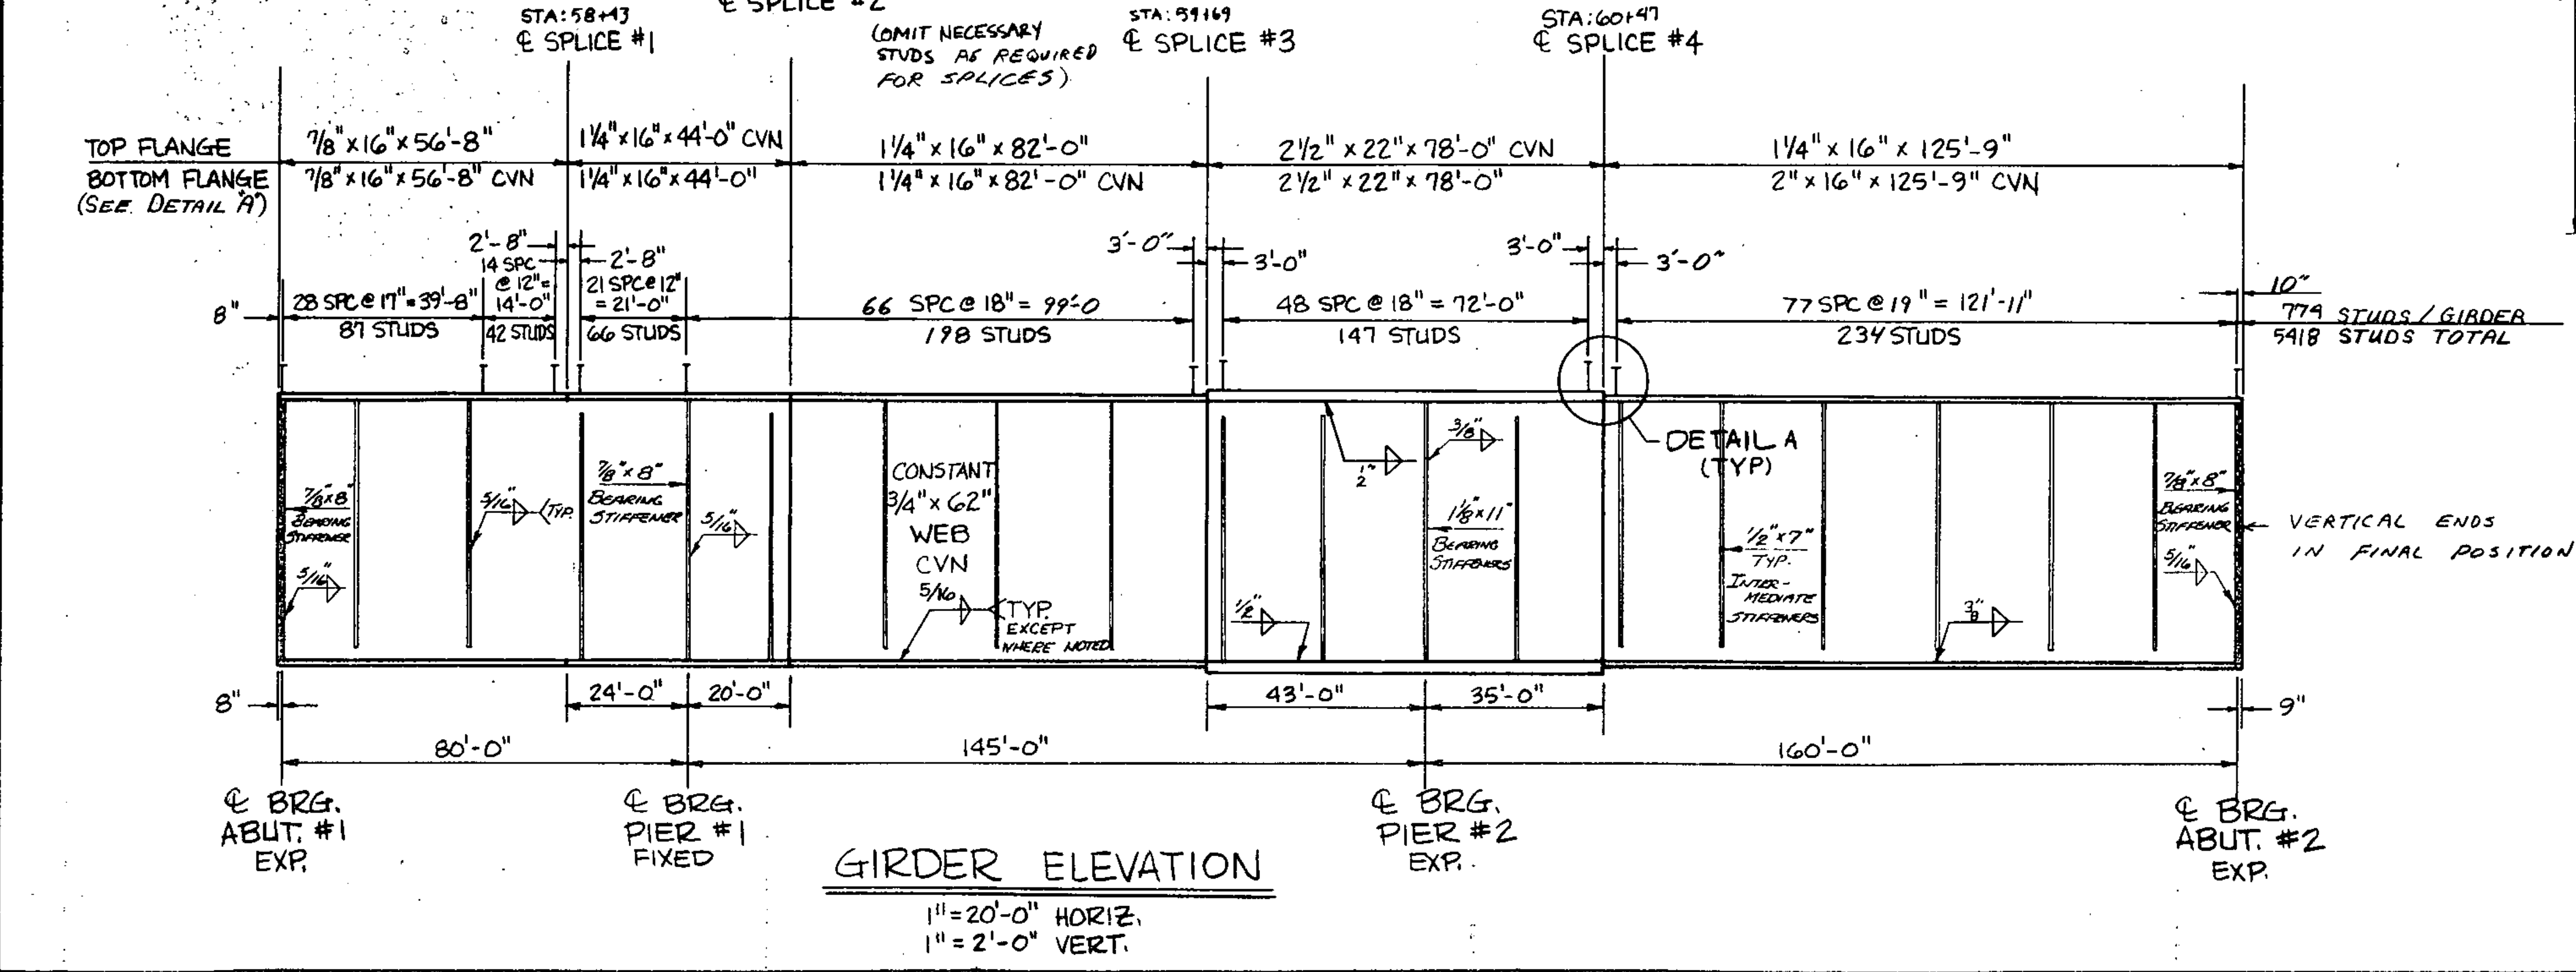

STATE OF VERMONT	
AGENCY OF TRANSPORTATION	
TOWN OF ST. JOHNSBURY	Bridge No. /
HIGHWAY NO. I-91 NORTH CONNECTOR	Log Sta.
	Surr. Sta. 60+0
FRAMING PLAN, GIRDER ELEV.	
I-91 NORTH CONNECTOR OVER PASSUMPSIC RIVER	
Designed by G.V. SPILAK	Drawn by G. KLINEFELTER
Checked by M. GARCIA	Bridge Design Supervisor
PROJECT ST. JOHNSBURY	PROJECT NO. DP-FF041-1(10)
date 6-84	date 10-84
PROJECT ST. JOHNSBURY	PROJECT NO. DP-FF041-1(10)
Bridge Sheet No. BR108	Sheet 66 of 229

BR108-4