



STA. 10+90
 END STONE FILL, TYPE IV
 END UNCLASSIFIED CHANNEL EXCAVATION

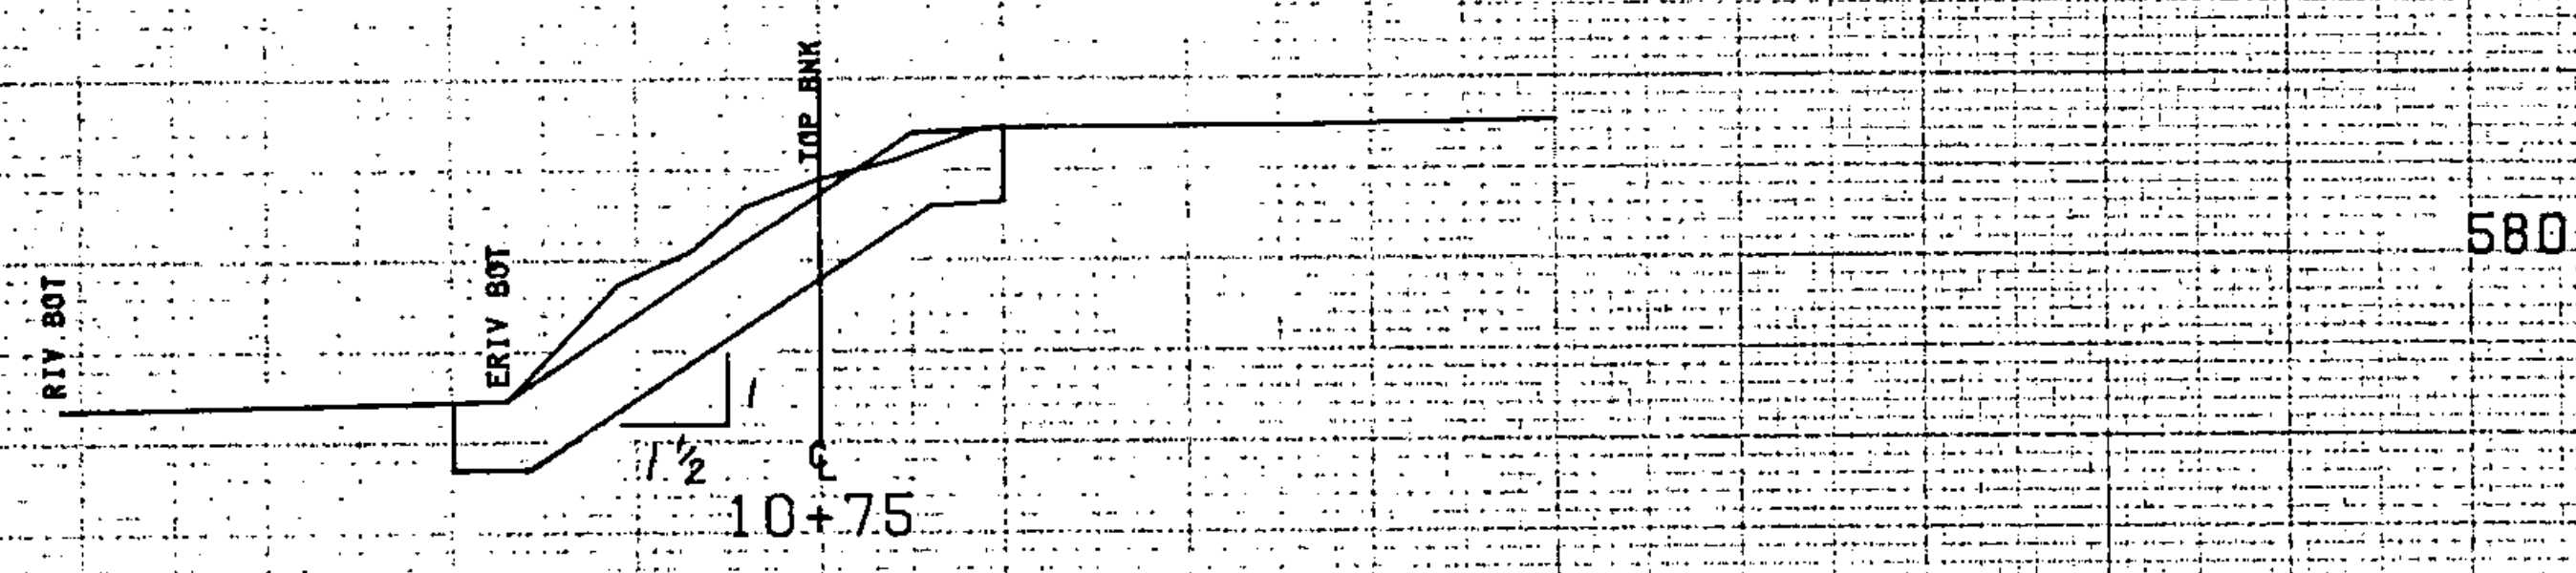

STA. 10+70
 END STRUCTURE EXCAVATION
 END GRANULAR BORROW

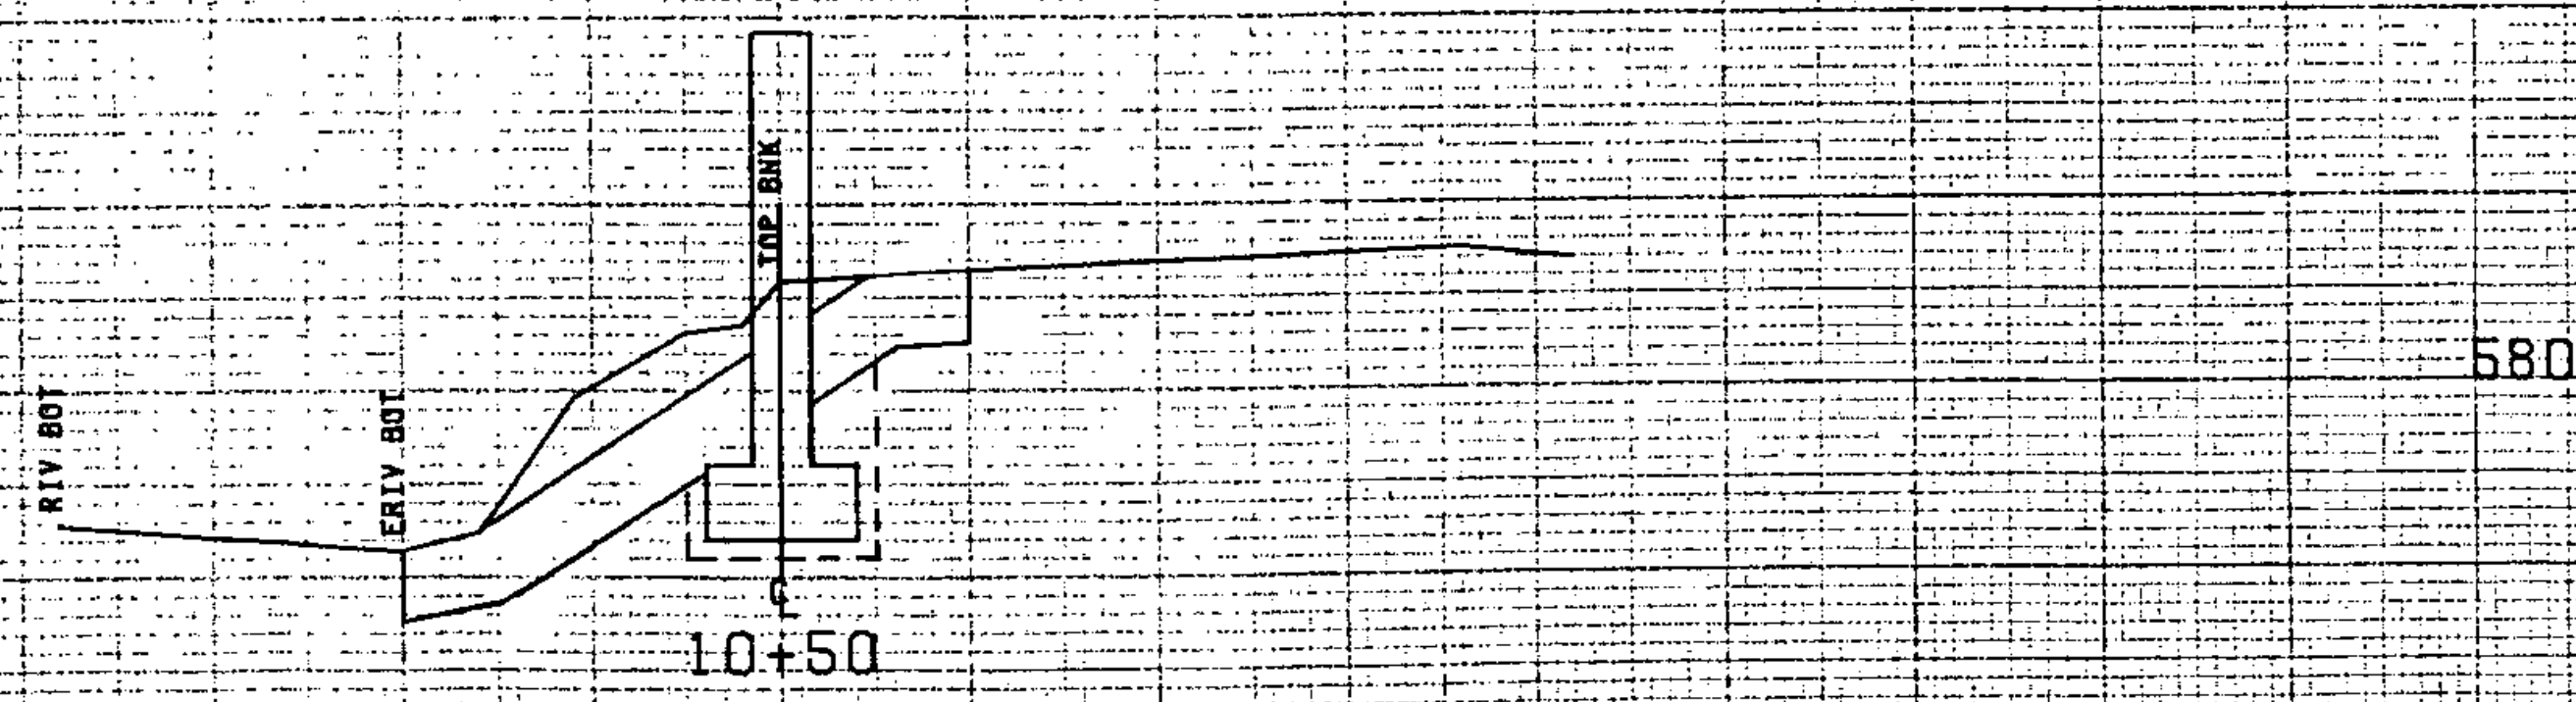

FROM STA.	10+50	TO STA.	11+00
PROJECT NAME	ST. JOHNSBURY	PIER	1
NO.	DP-FF041-1(10)	PLOTTED	02/28/86
SURVEYED BY	LEWIN	FEB	1985
SHEET	70	OF 227	SHEETS
			188/92

SCALE: 1" = 10 FEET