


11+00


570

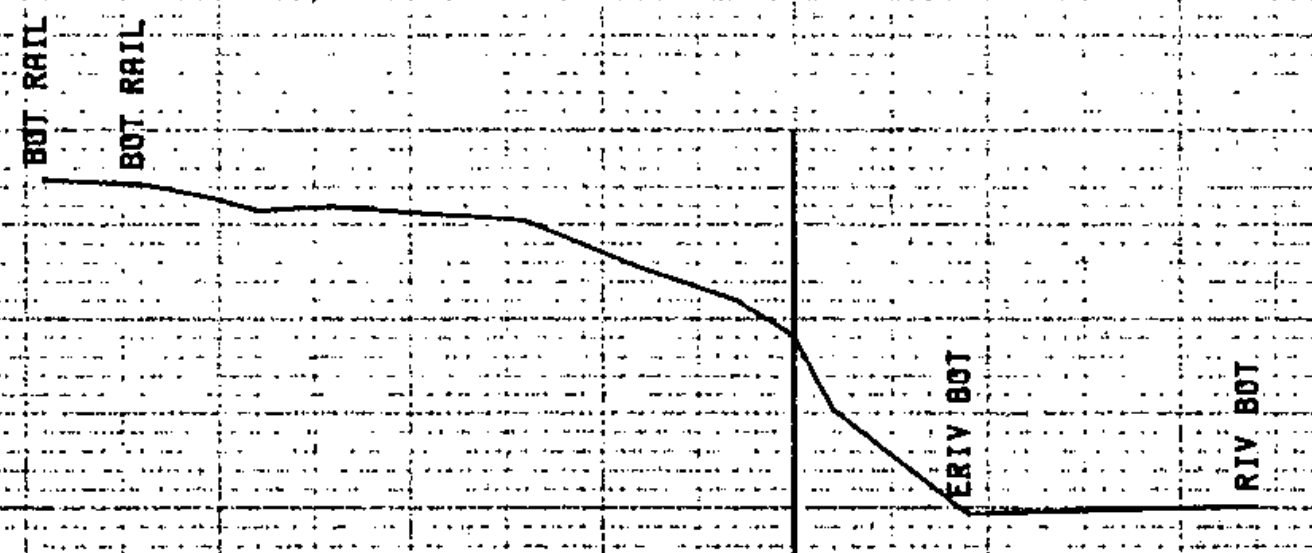

10+75

570

STA. 10+52  
 END STONE FILL, TYPE IV  
 END UNCLASSIFIED CHANNEL EXCAVATION

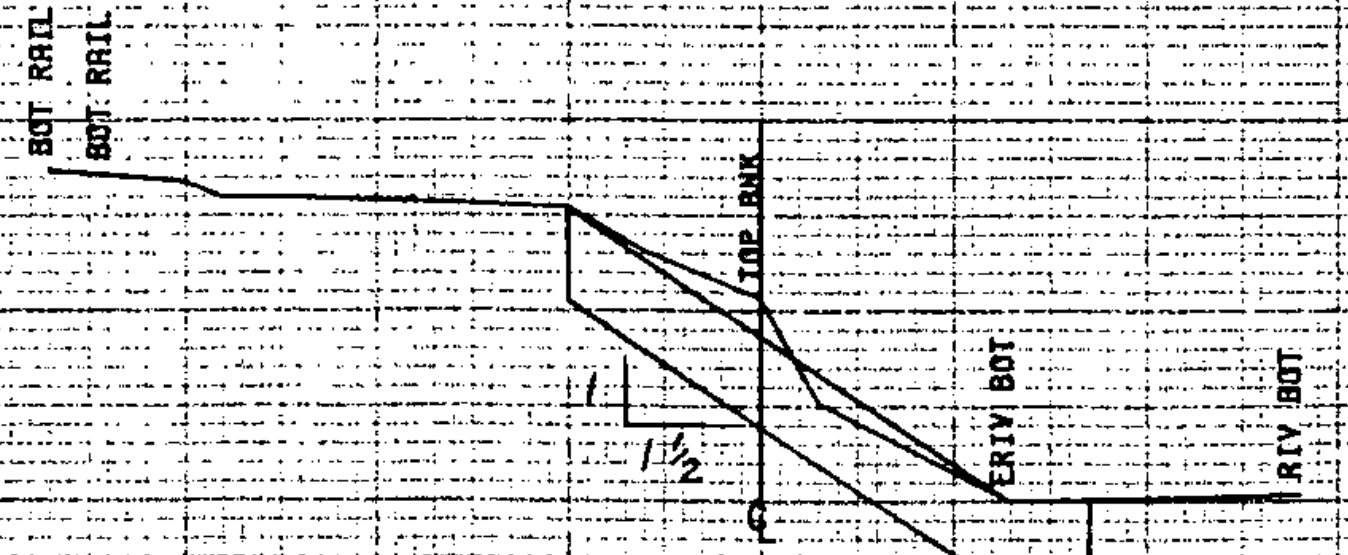

10+50

580

FROM STA. 10+50 TO STA. 11+00  
 PROJECT NAME ST. JOHNSBURY PIER 2  
 NO. DP-P041-1010 PLOTTED 02/28/88  
 SURVEYED BY LEWIN FEB 1988  
 SHEET 27 OF 222 SHEETS 60/96

SCALE 1" = 10' H. P. 1"