


Rk #5 531031 - Rk #5 531002
 New 28" x 20" x 12" A.C.C.M.P.A. (C264)
 Construct Outlet Ditch to River

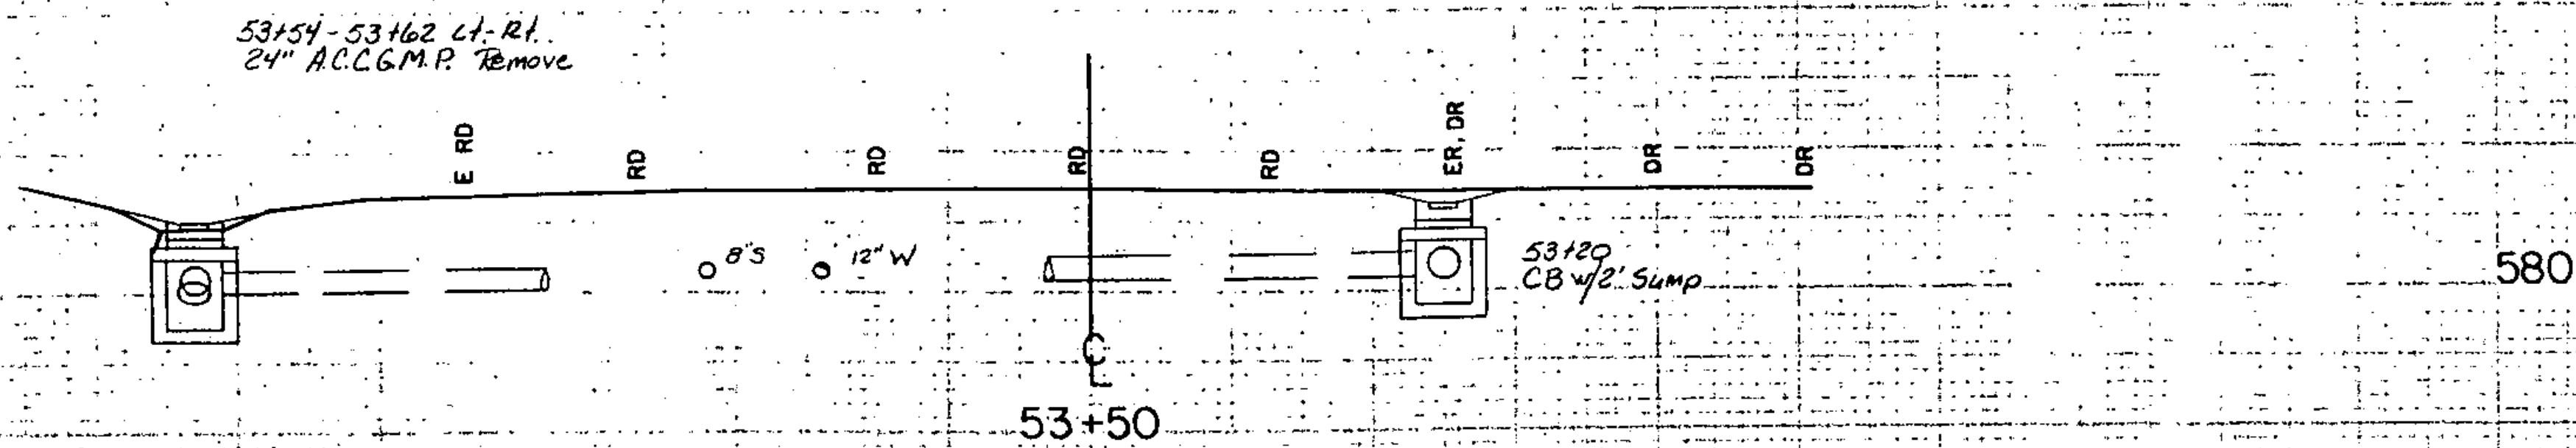

53154 - 53162 Lt. Rt.
 24" A.C.C.M.P. Remove

53120
 CB 4/2' Sump

FROM STA	53+50	TO STA	53+60
PROJECT NAME	ST. JOHNSBURY MAIN LINE		
NO.	DP-FF041-1(10)		
SURVEYED BY	FANTONI		
SHEET	02	OF 229 SHEETS	11/78