

PASTURE

706.63

1.4

FN

E RD


RD

E RD

1.4

690

73+00

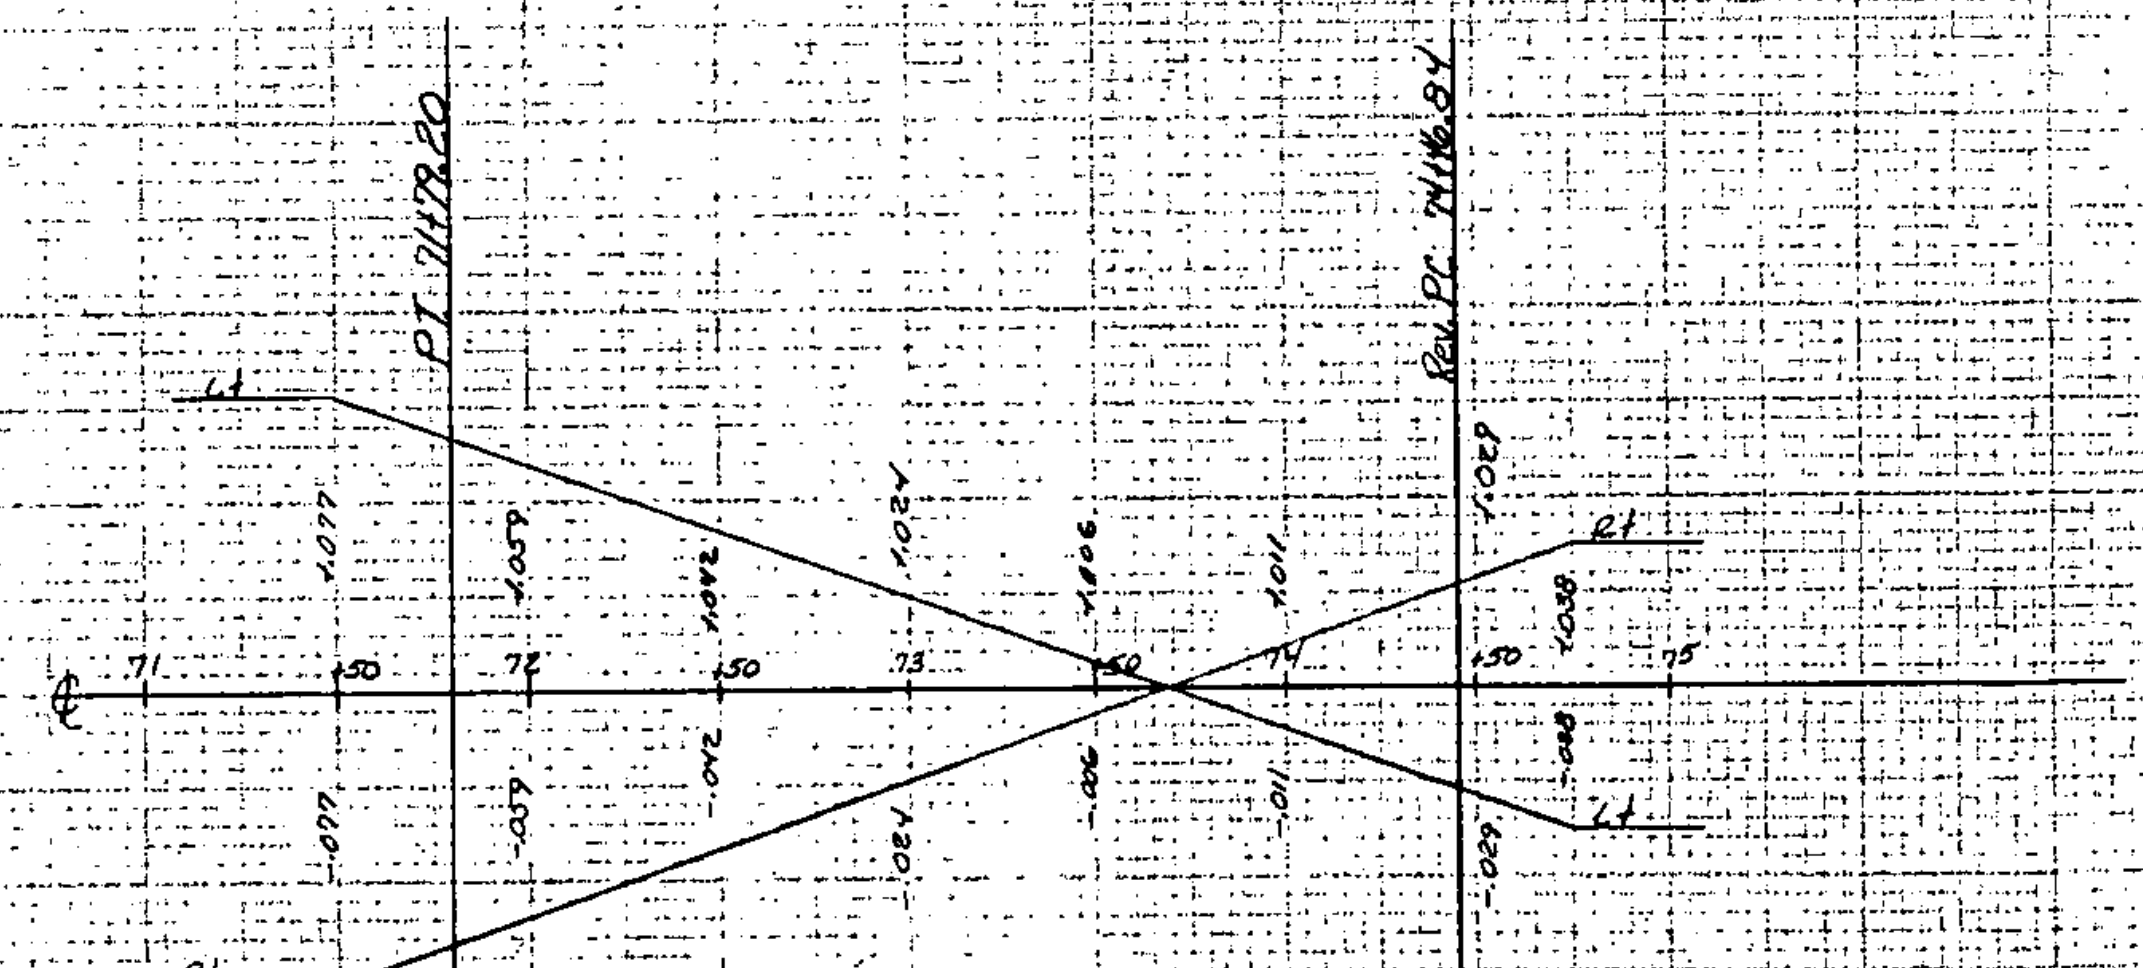

PASTURE

706.64

1.4

FN

E RD

RD

E RD

1.4

690

72+50

Approx. Loc. Tol.

FROM STA	72+50	TO STA	73+00
PROJECT NAME	ST. JOHNSBURY MAIN		
NO.	DP-FF041-1E103	PLOTTED	12/11/84
SURVEYED BY	FRATONI		
SHEET NO.	OF	SHEET	228

SCALE 1" = 50'