


Surv. PC: 74+48.92
 Rev. PC: 74+46.84
 D 3° Lt
 Bank 0.038 f/ft

74+00 - 76+00 Rt.
 Special Ditch w/ Type II Stone Fill
 and Energy Dissipator @ Outlet

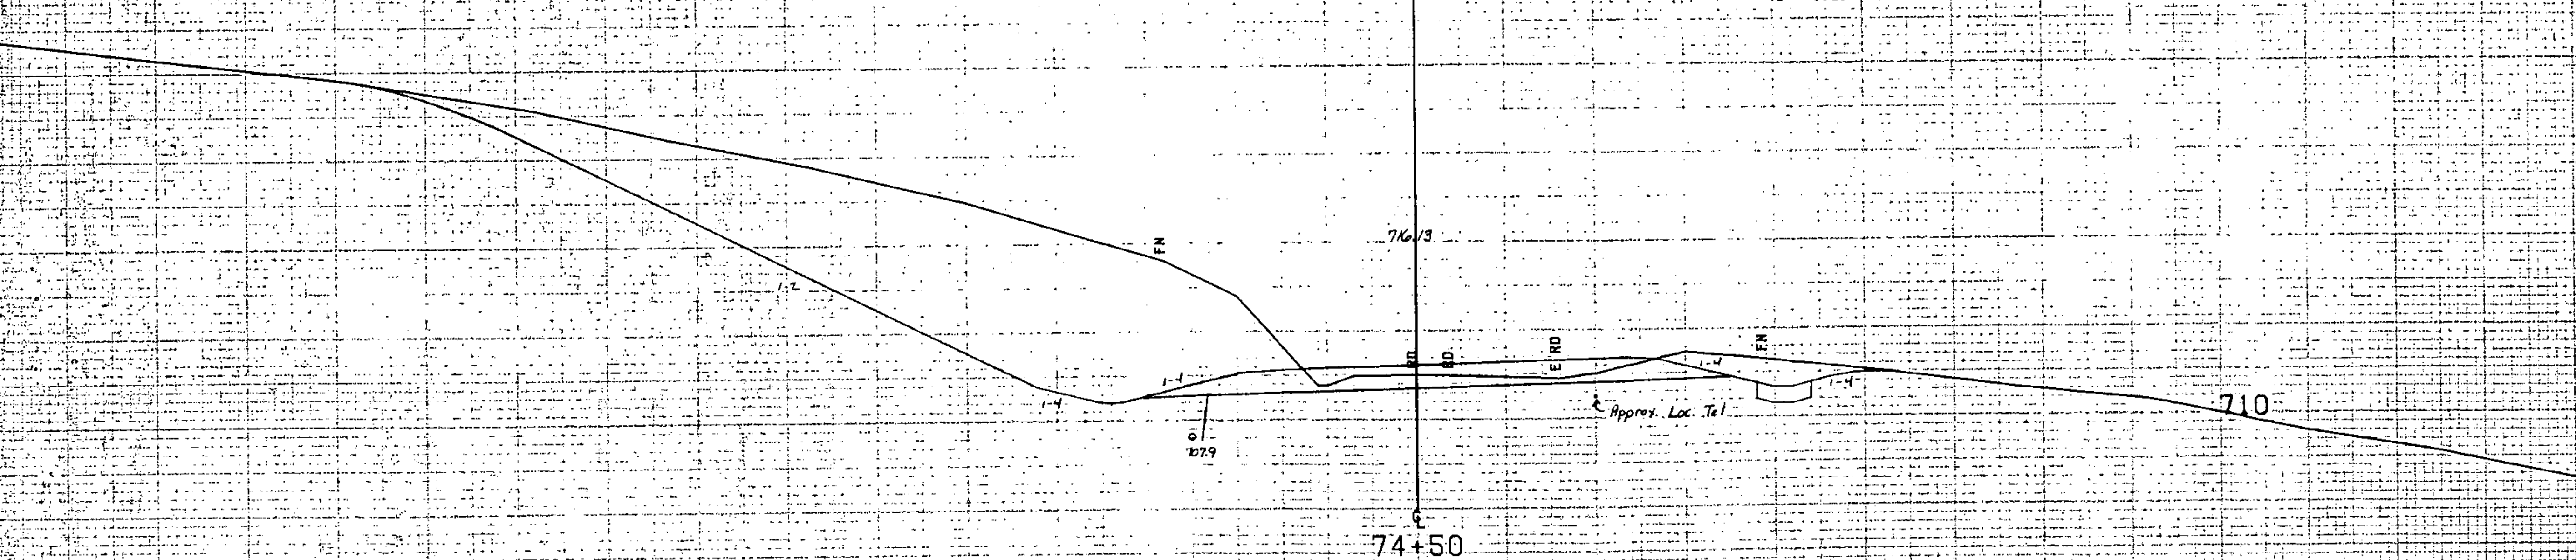

FROM STA.	74+50	TO STA.	75+00
PROJECT NAME	ST. JOHNSBURY MAIN		
NO.	DP-FF041-1010	PLOTTED	12/11/84
SURVEYED BY	FRANTONI		
DATE	11/78	SHEET	229

SCALE 1" = 10' FEET