



77101-80+80 Lt.
New 6" x 376' Underdrain
w/ Flushing Basin @ 80+80

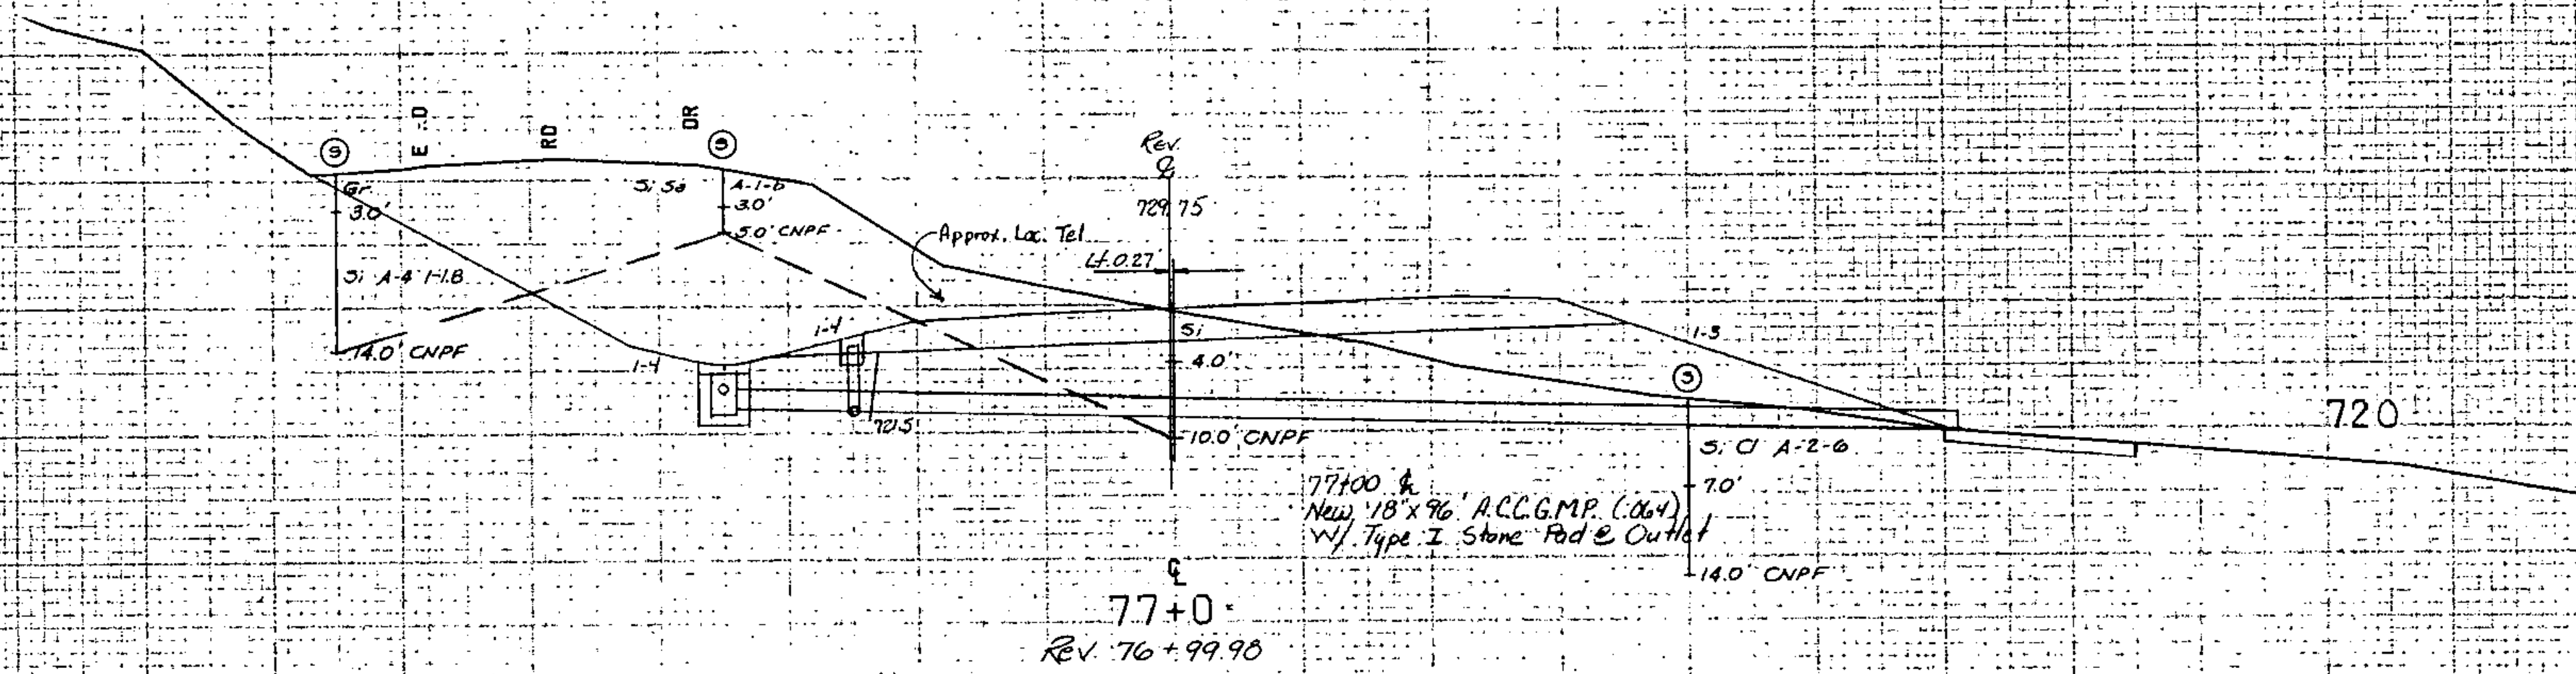

77+0
Rev. 76+99.98

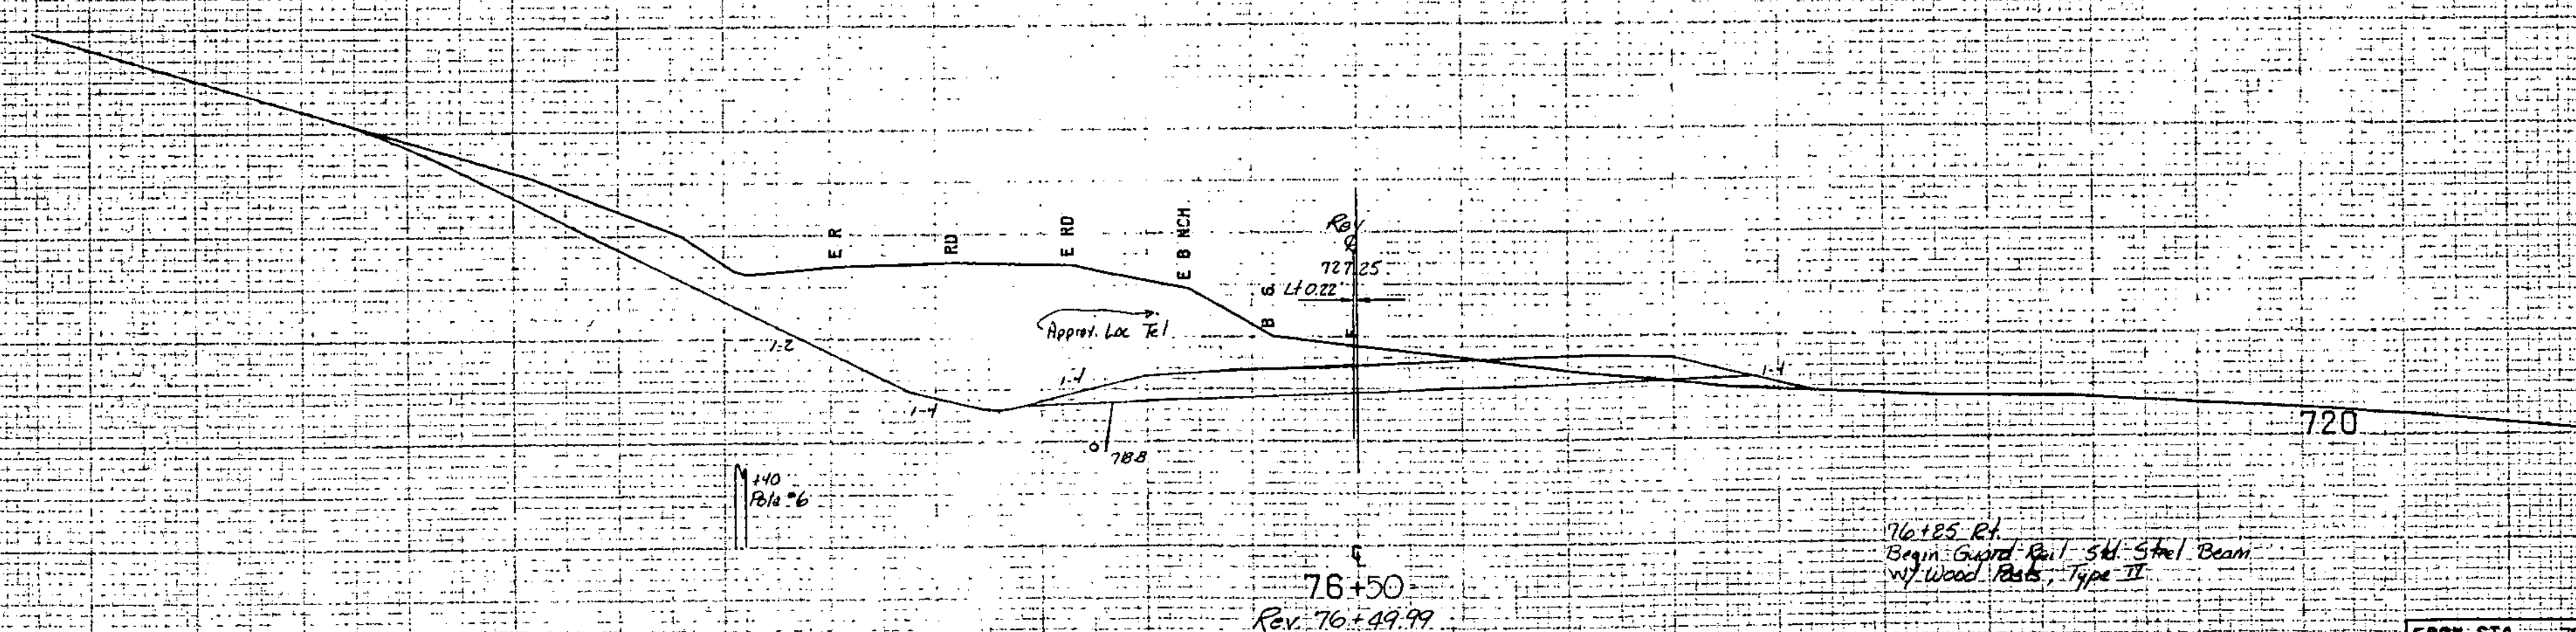

76+50
Rev. 76+49.99

76+25 Rt.
Brn Guard Rail 3rd Steel Beam
w/ Wood Posts, Type II

FROM STA.	76+00	TO STA.	77+00
PROJECT NAME	DT JOHNSBURY MAINLINE		
NO.	DP-FF041-1(10)	PLOTTED	12/11/04
SURVEYED BY	FANTONI 11/78		
SHEET	123 OF 229	SHEETS	229

C:LE 11 x 1