



Rev. P.T. 79+43.13  
 D 3° Lt.  
 Bank .038 f/ft.  
 Surv. P.T. 78+30.59

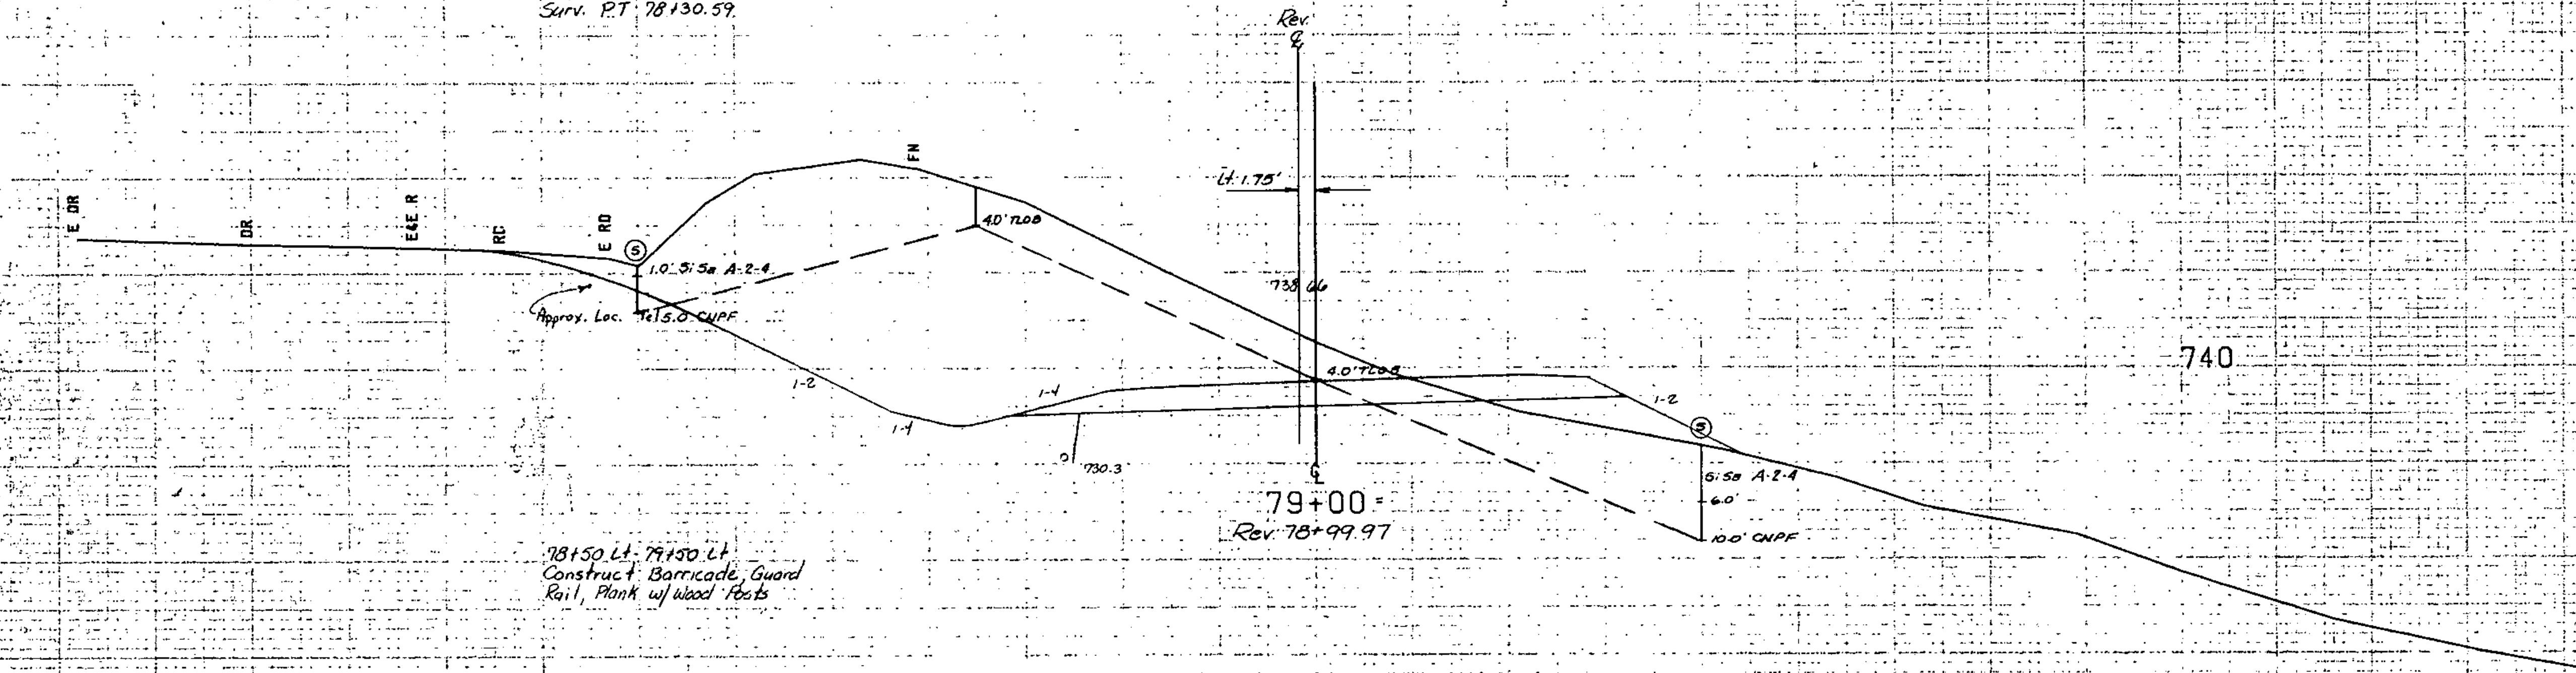

78+50 Lt. 79+50 Lt.  
 Construct Barricade, Guard  
 Rail, Plank w/ wood Posts

79+00  
 Rev. 78+99.97

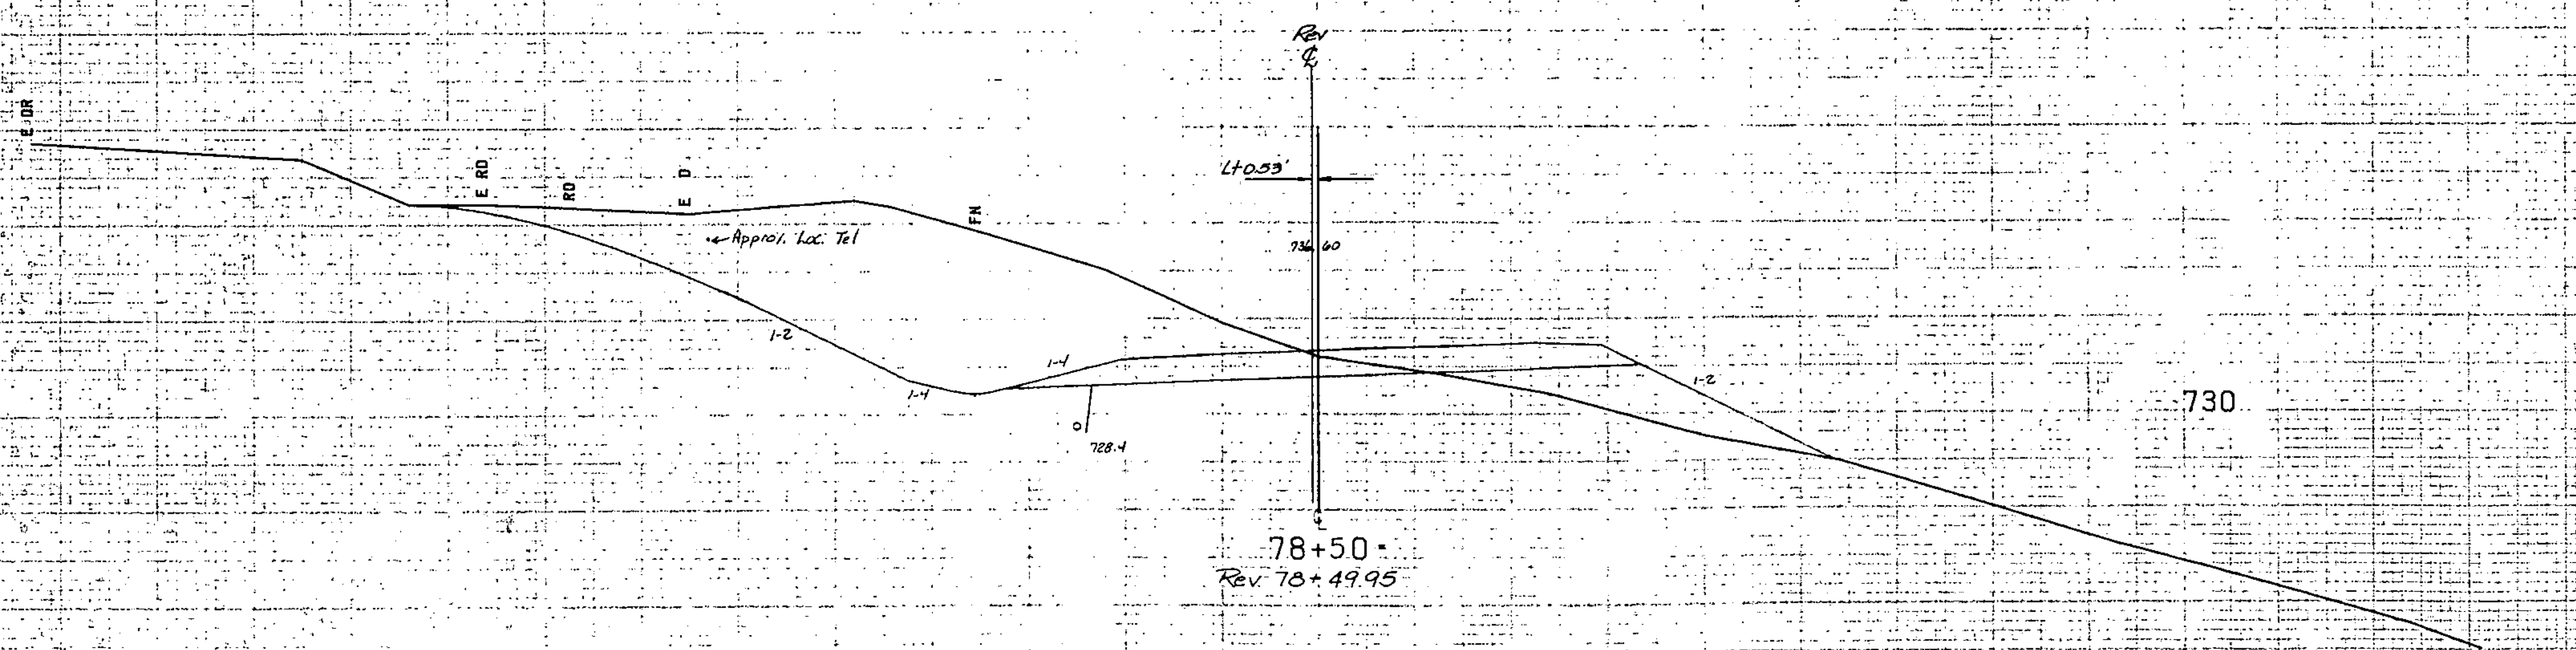

78+50  
 Rev. 78+49.95

FROM STA.	8+50	TO STA.	9+00
PROJECT NAME	ST. JOHNSBURY MAIN		
NO.	DP-FF041-1(10)	PLOTTED	2/11/94
SURVEYED BY	PANTONI 11/78		
SHEET	125 OF	SHEETS	229

SCALE 10' FEET