
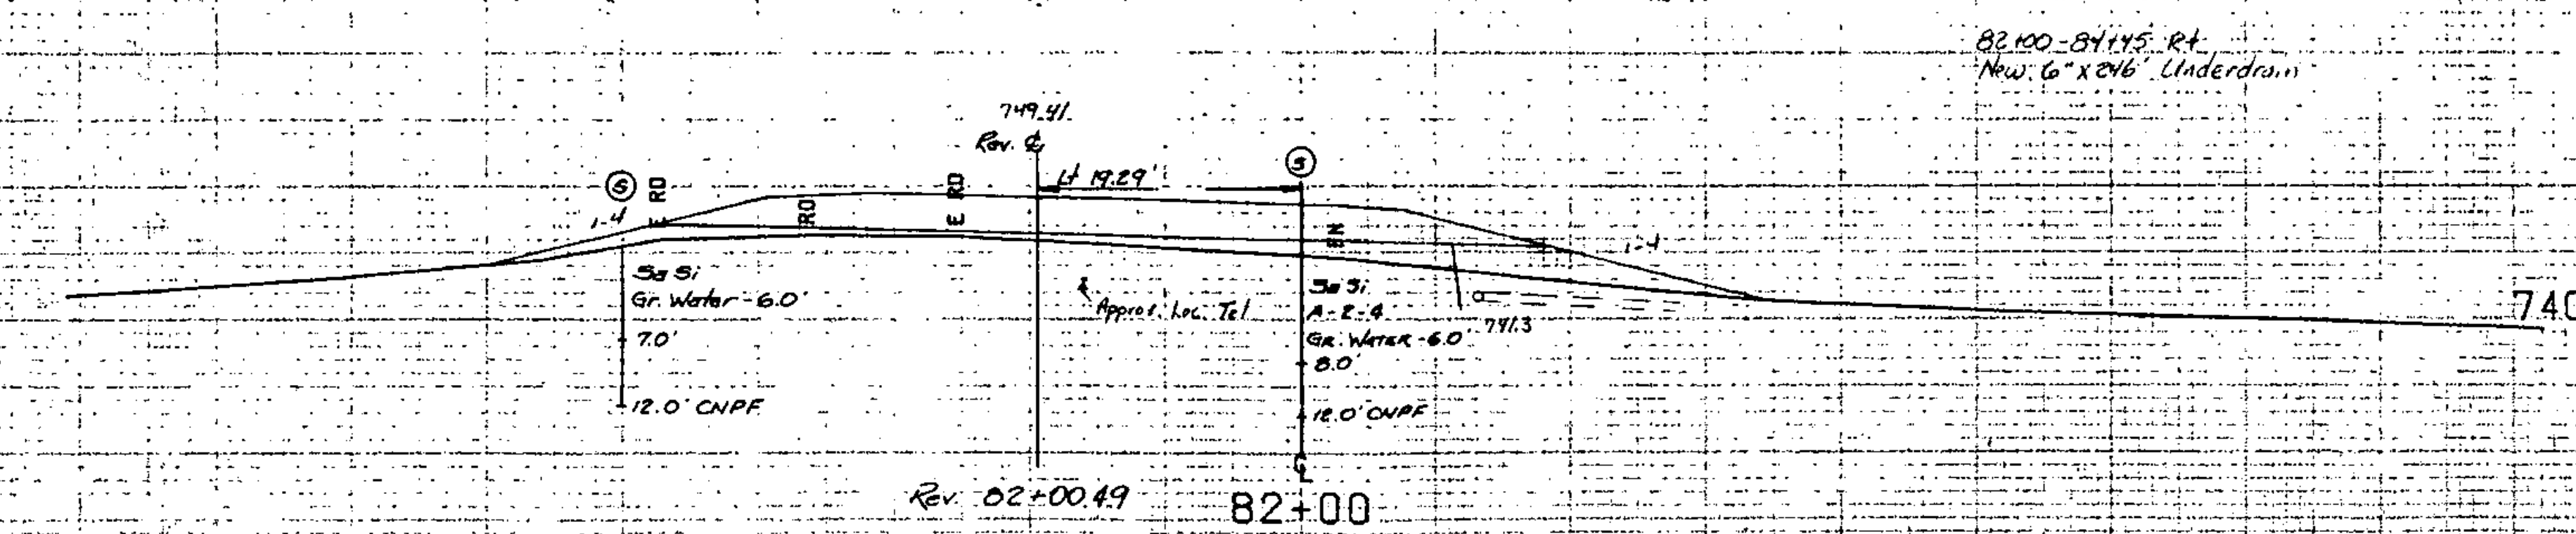


82150-84165 Lt  
Construct Special Ditch  
w/ Type I Stone Fill  
(Refer to Layout)

82150  
End Excavation and Removal  
of Road Surfaces and Pavements

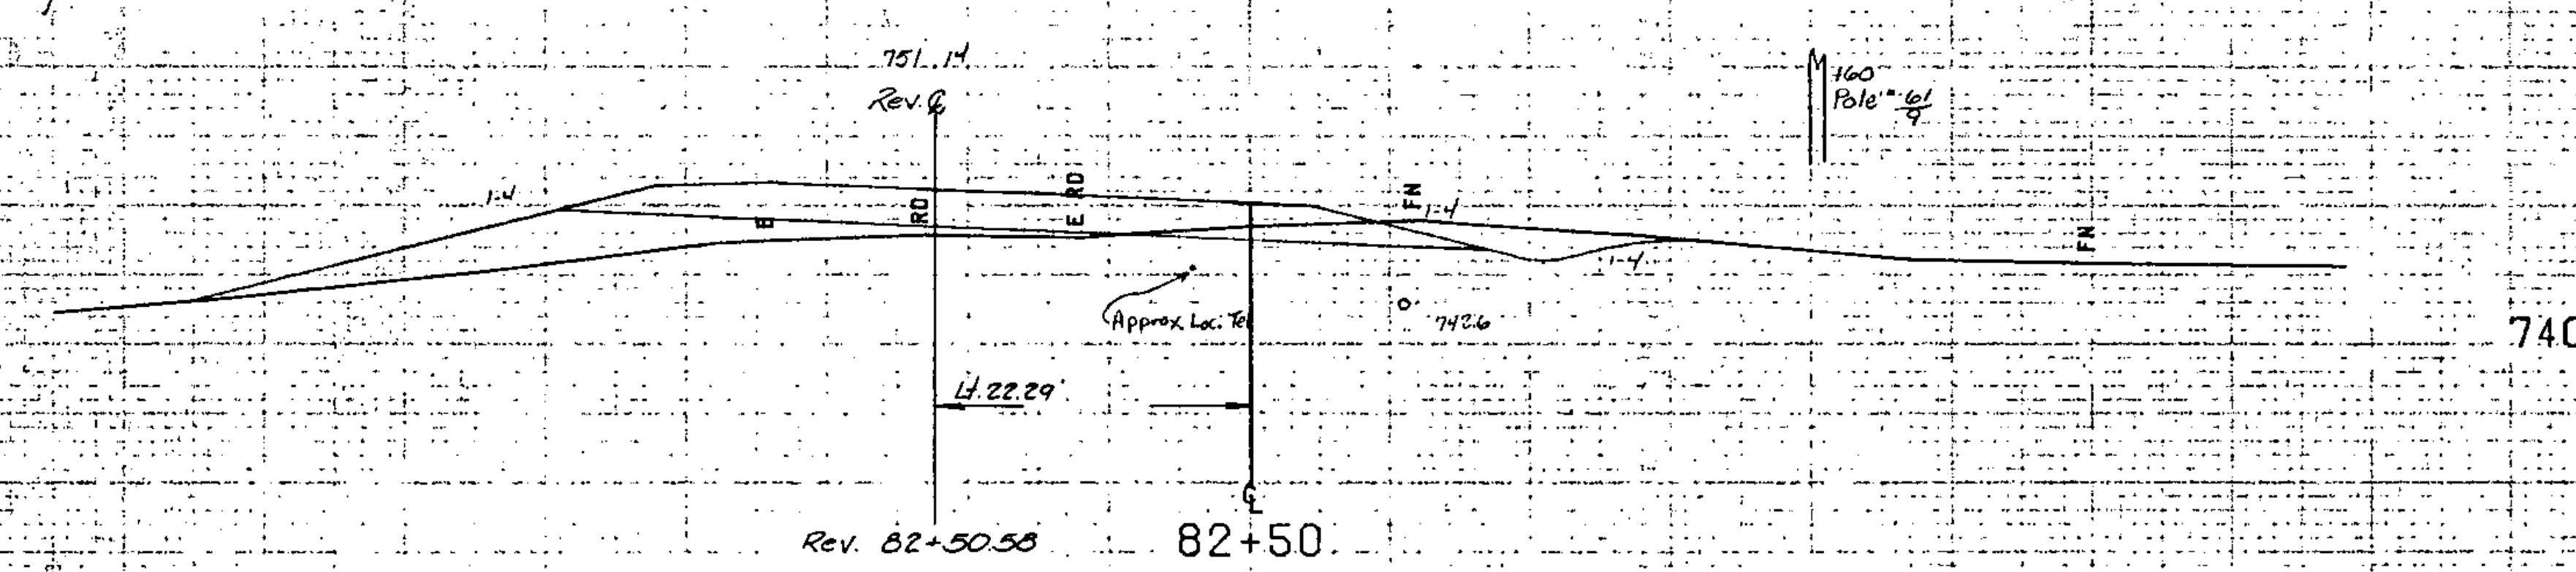

FROM STA.	82+00	TO STA.	83+00
PROJECT NAME	ST. JOHNSBURY MAIN		
NO.	DP-F041-1(10)	PLOTTED	12/11/84
SURVEYED BY	TANTONI		11/78
SHEET 128	OF	SHEETS	229

SCALE 1" = 10' HORIZ