

83175-87183 Lt
New Chain Link Fence (6')

83118-87135 Lt
Remove Chain Link Fence
Cost Subsidiary to price of
New Fence

84100 Lt-84146 Rt
New 18" x 12" H.C.C.G.M.P. (061)

Rev. 84+00.78

84+00

83+98 Pt. 14.0' NLTD
Construct Drive. (Paved)

Rev. 83+50.76

83+50

Rev. P.C. 83147.61
D = 9' RT
Bank .075:1 fill

Rev. 83+20.71

83+20

83124 Rt
Construct Drive
Pave Entire Drive


750

750

750

18" Subbase of Gravel
2" Bit. Conc. Pavement
2" Topsoil
12" Subbase of Gravel
2" Bituminous Conc. Pavt.

Drive Typicals for 83124 and 83198
Scale: Hor. 1" = 20'
Vert. 1" = 10'

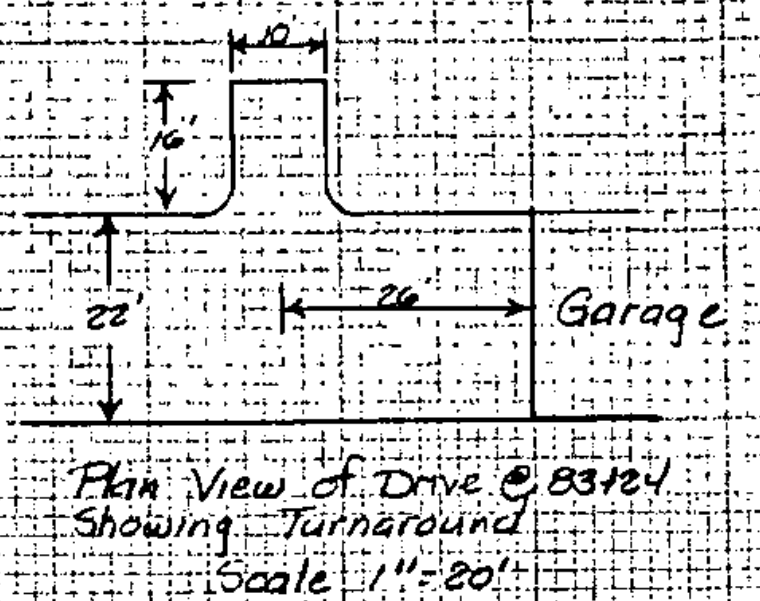

FROM STA.	83+20	TO STA.	84+00
PROJECT NAME	ST. JOHNSBURY MAIN		
NO.	DP-FF041-1(10)	PLOTTED	12/11/88
SURVEYED BY	FANTONI 11/78		
SHEET	123	OF	SHEETS 229

SCALE 1" = 10 FEET