


84+77-89+50 Rt.  
New 6" x 52" Underdrain  
w/ Flushing Basin @ 89+50 Rt.

84+45-86+50 Rt.  
Const. Special Ditch w/  
Type I Stone Fill.

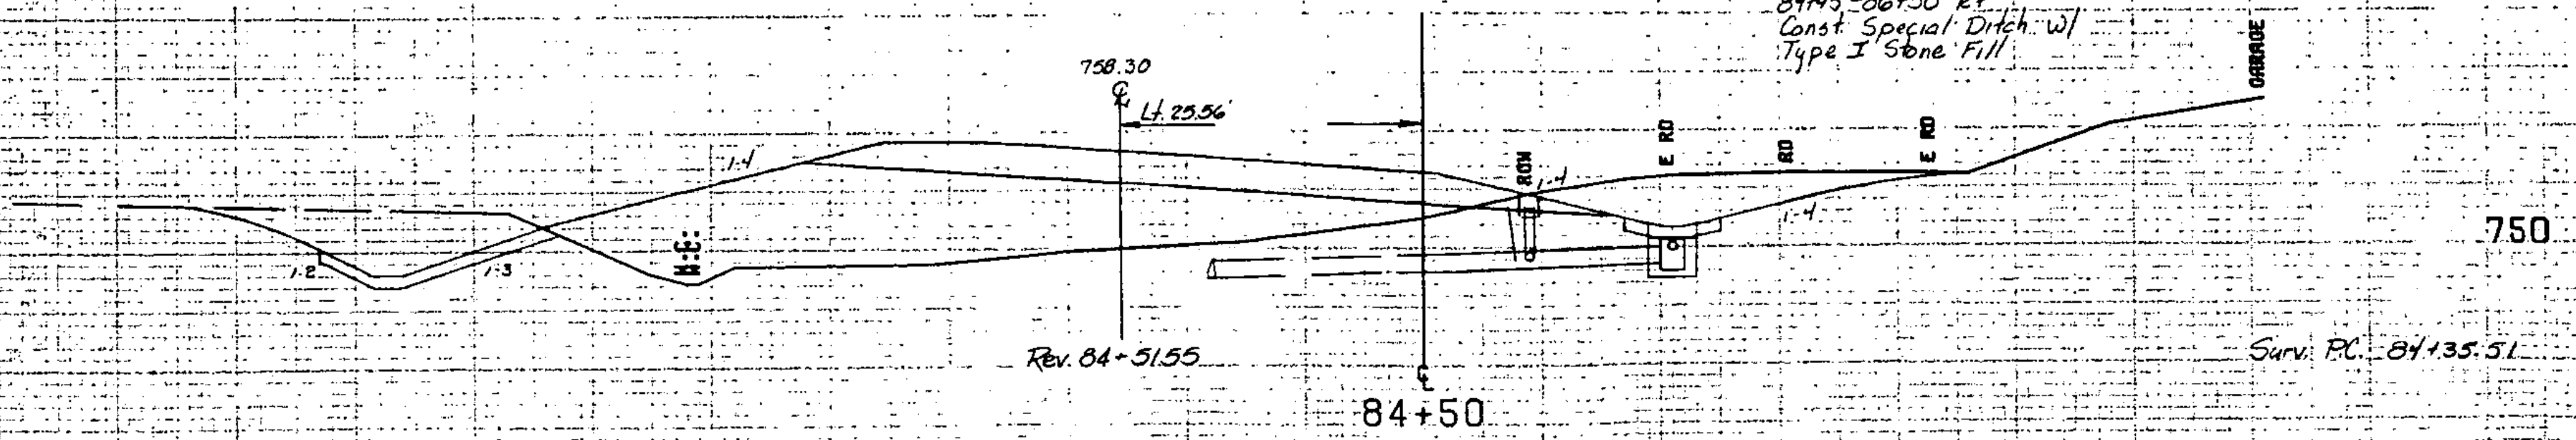

Surv. PC 84+35.51

FROM STA.	84+50	TO STA.	85+50
PROJECT NAME	ST. JOHNSBURY MAIN		
NO.	DP-FF041-1(10)	PLOTTED	12/11/84
SURVEYED BY	FANTONI	1/78	
SHEET NO. OF SHEETS	229		

SCALE 1" = 10' HORIZ.