

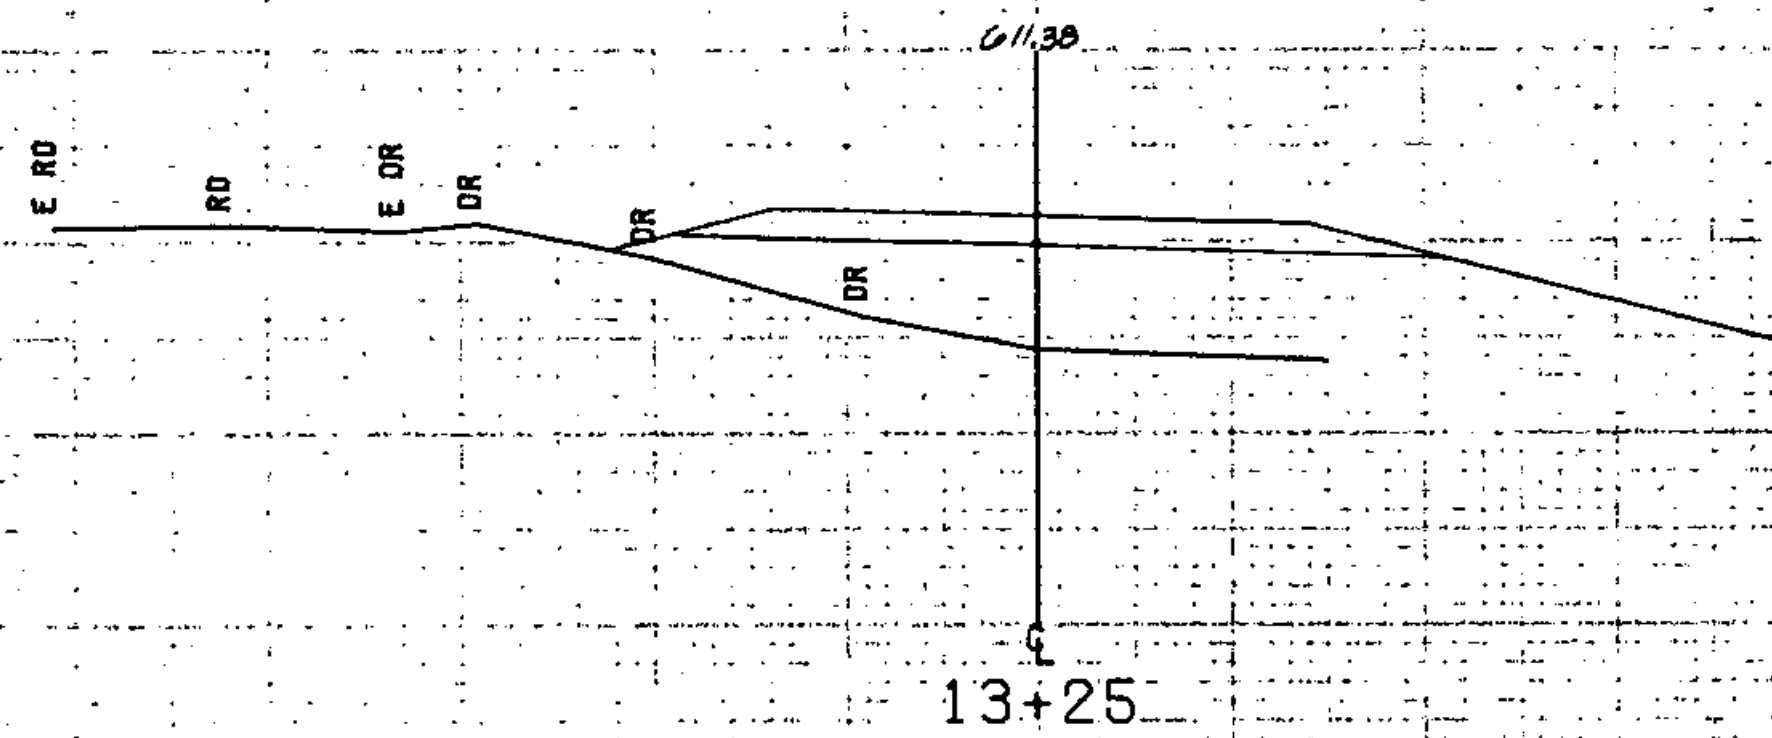
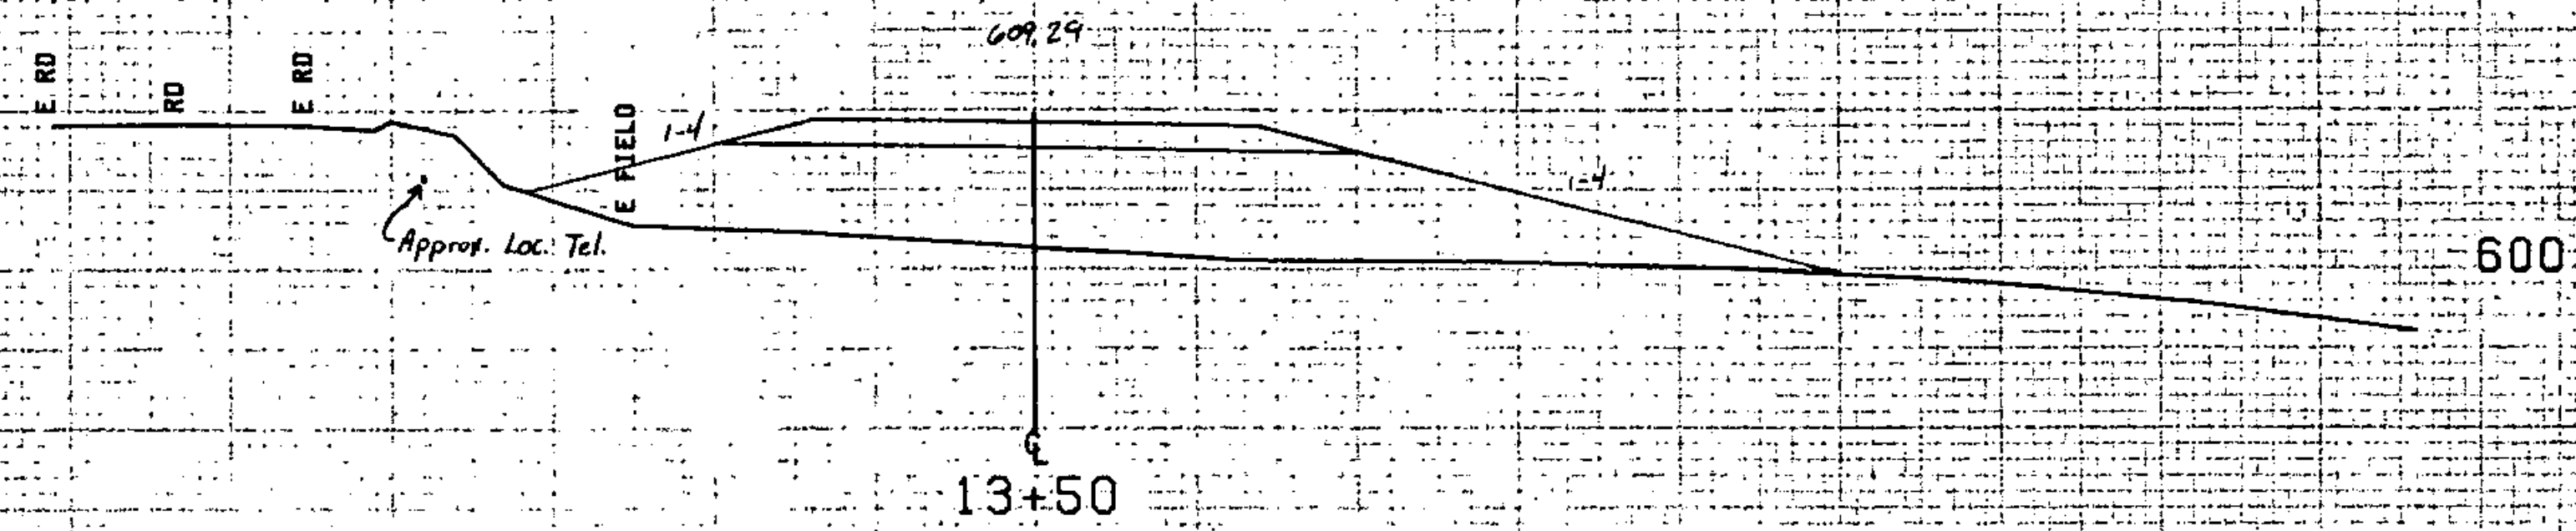


13150-1-1
Construct Barricade Guard
Rail, Plank w/ Wood Posts

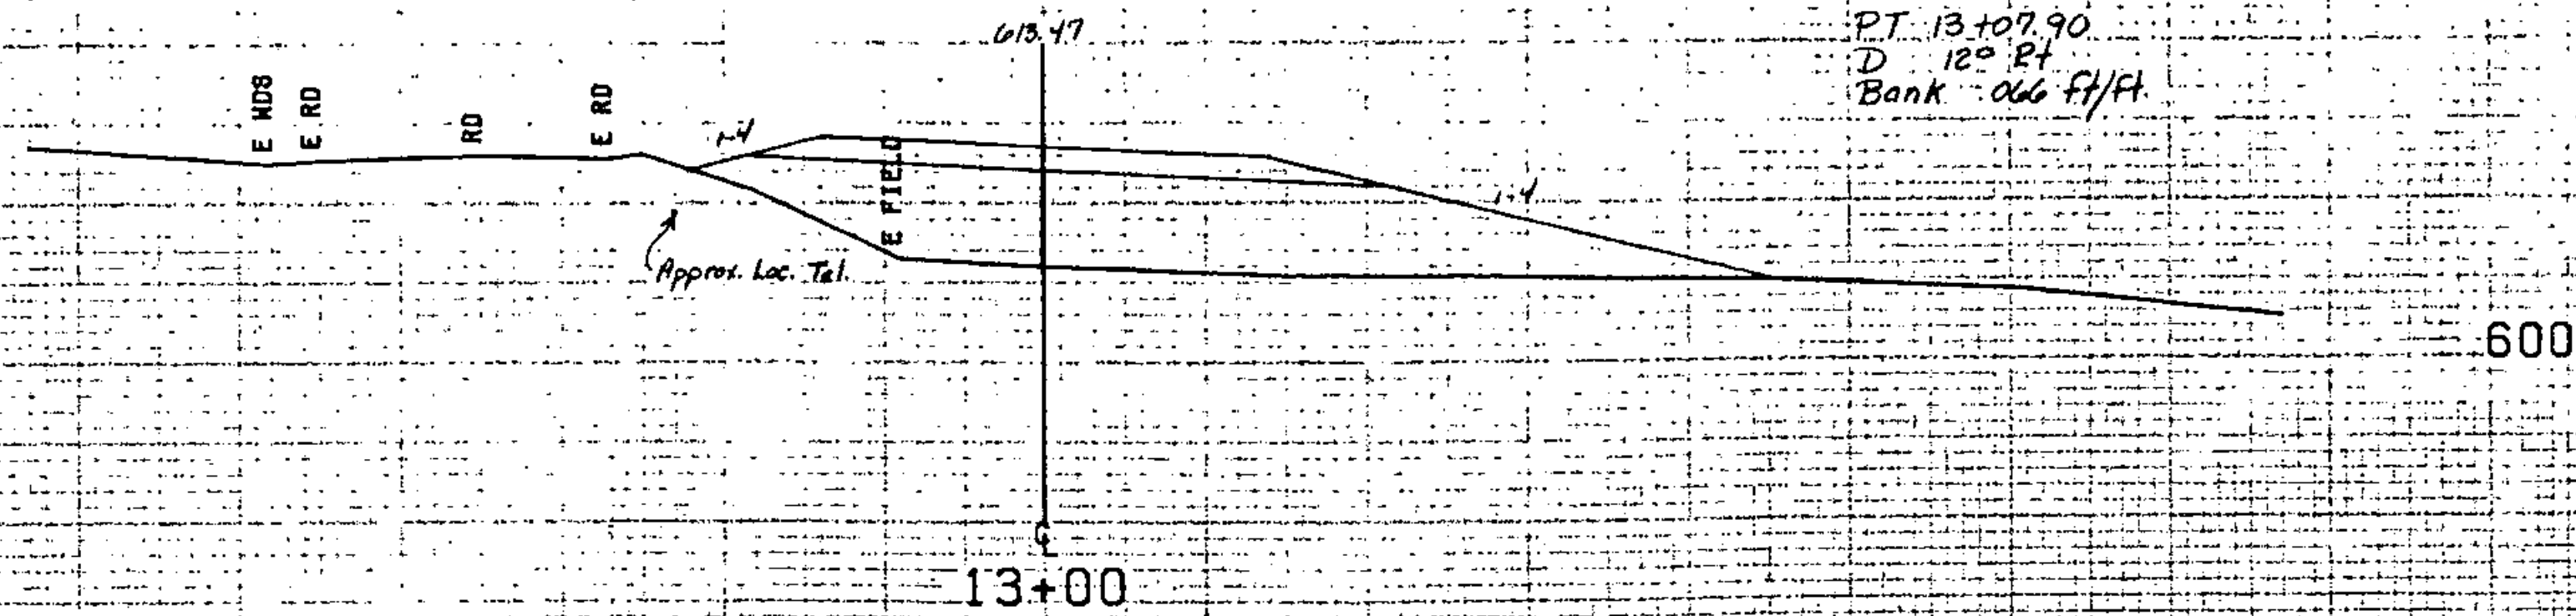

Note: The discontinued portion of
T.H. 27 is to be topsoiled,
seeded, fertilized and mulched

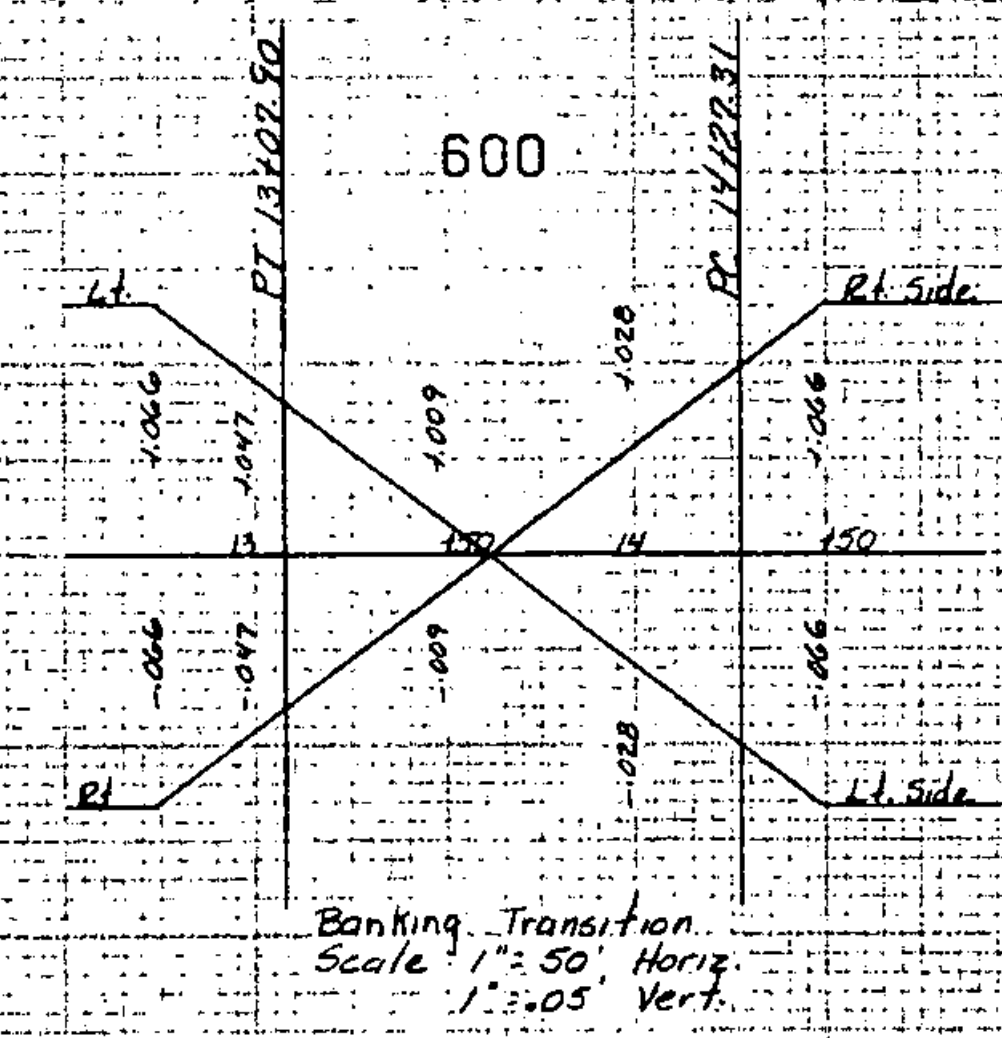

FROM STA	13+00	TO STA	13+50
PROJECT NAME	ST. JOHNSBURY T.H. 27		
NO.	DP-FF041+(10)	PLOTTED	12/11/84
SURVEYED BY	FANTONI 11778		
SHEET	102 OF 100	SHEETS	223

SCALE 1" = 50'