



15100-18150 Lt  
Erosion Matting  
(B' wide)

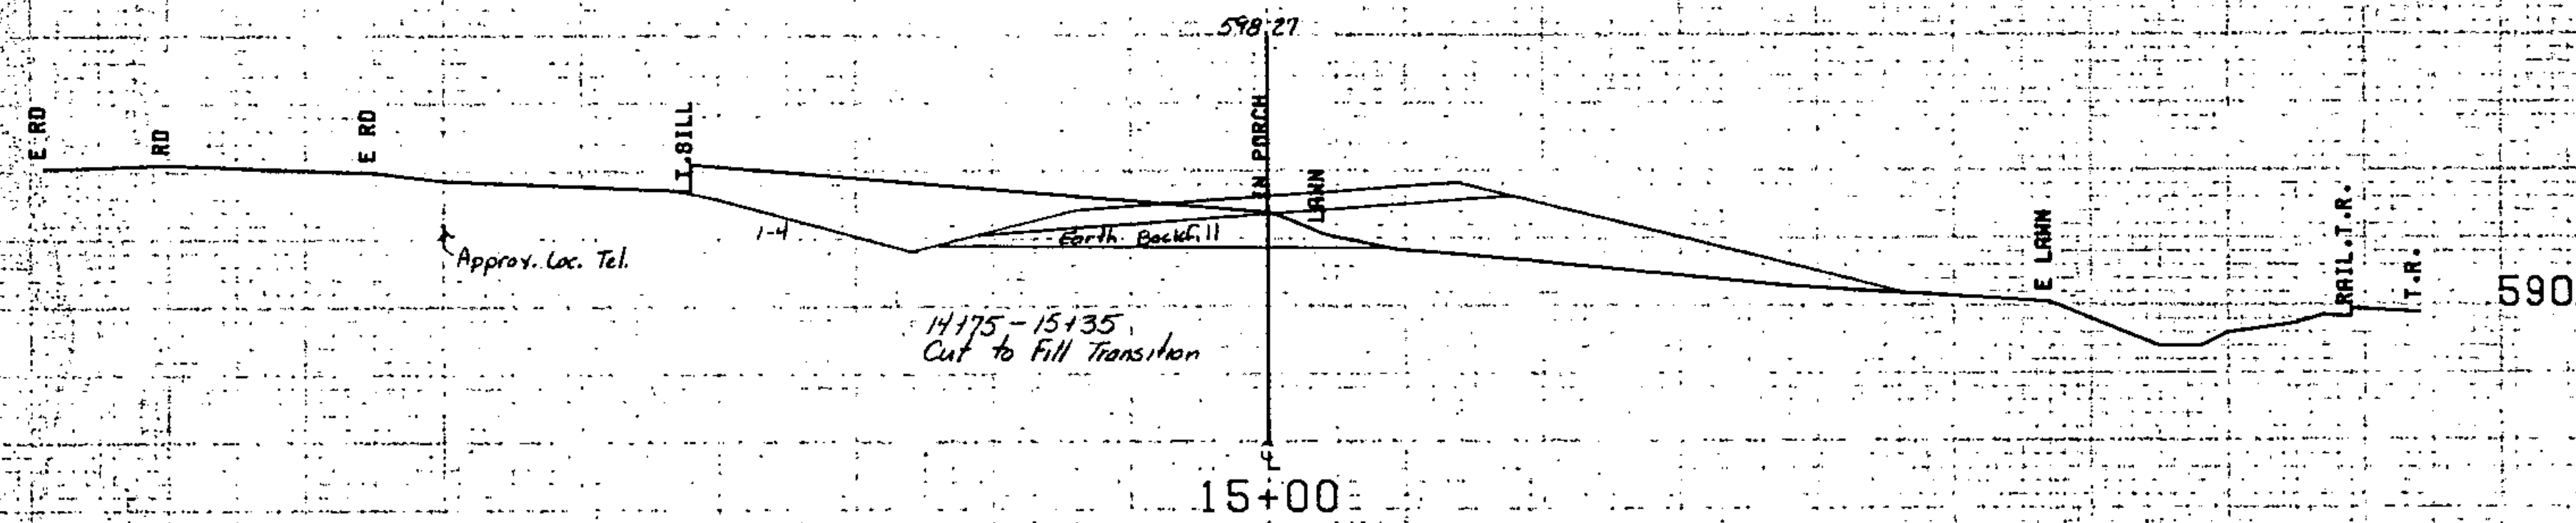

14175-15135  
Cut to Fill Transition

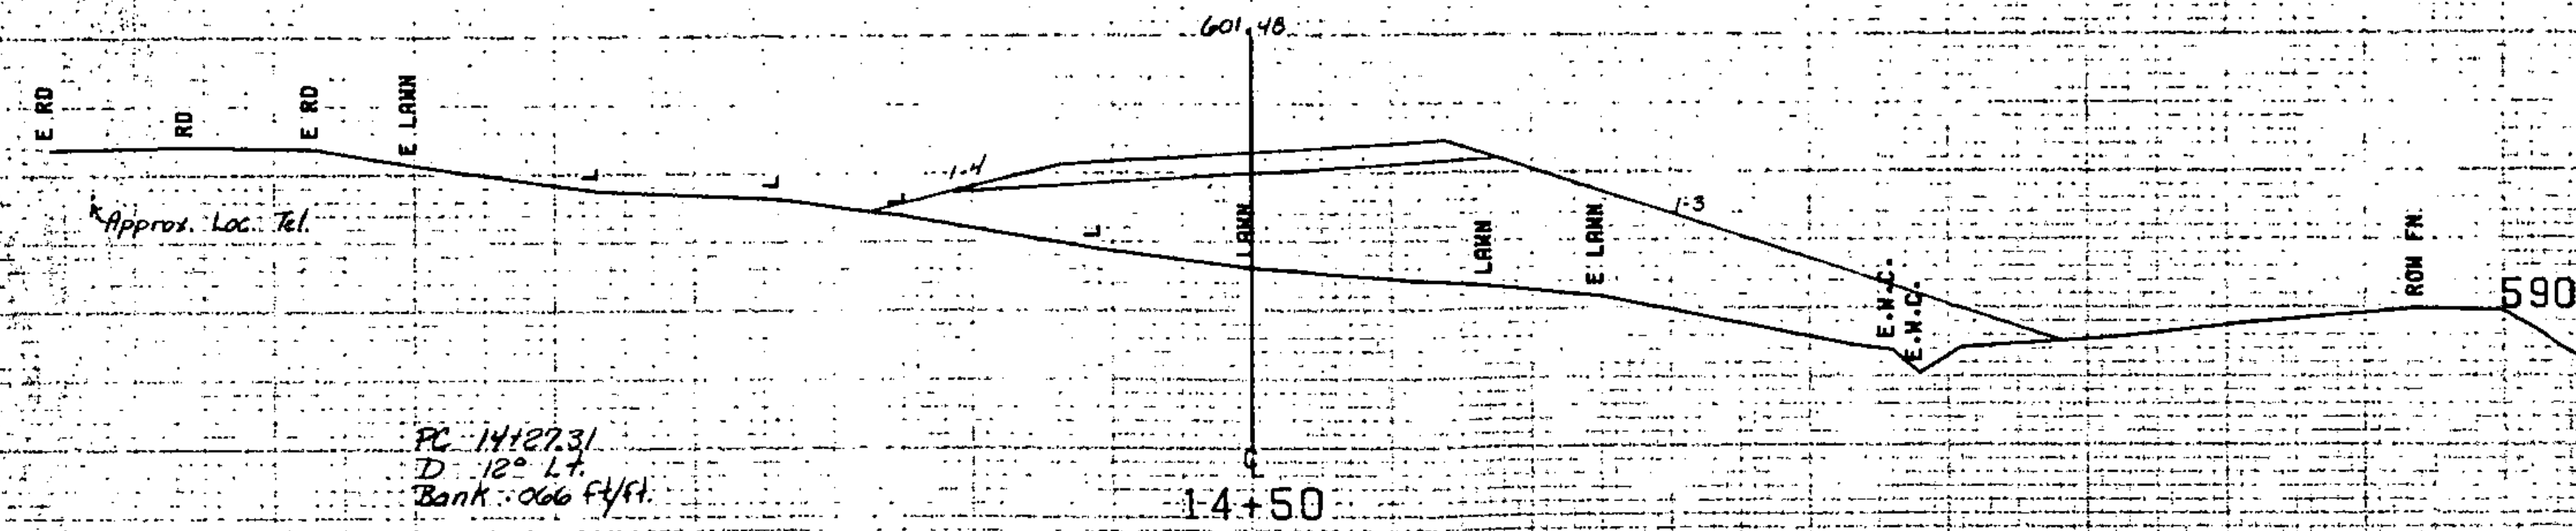

PC 14127.31  
D 12° Lt  
Bank 0.66 Ft/Rt

FROM STA.	14+50	TO STA.	15+50
PROJECT NAME	ST. JOHNSBURY T.M. 127		
NO.	DP-PF041-1(10)	PLOTTED	12/11/84
SURVEYED BY	FRYTON		
SHEET	11	OF	229

SCALE 1" = 10' HORIZ