



PC 18+93.37  
 D 12' Rt  
 Bank .066 f/ft

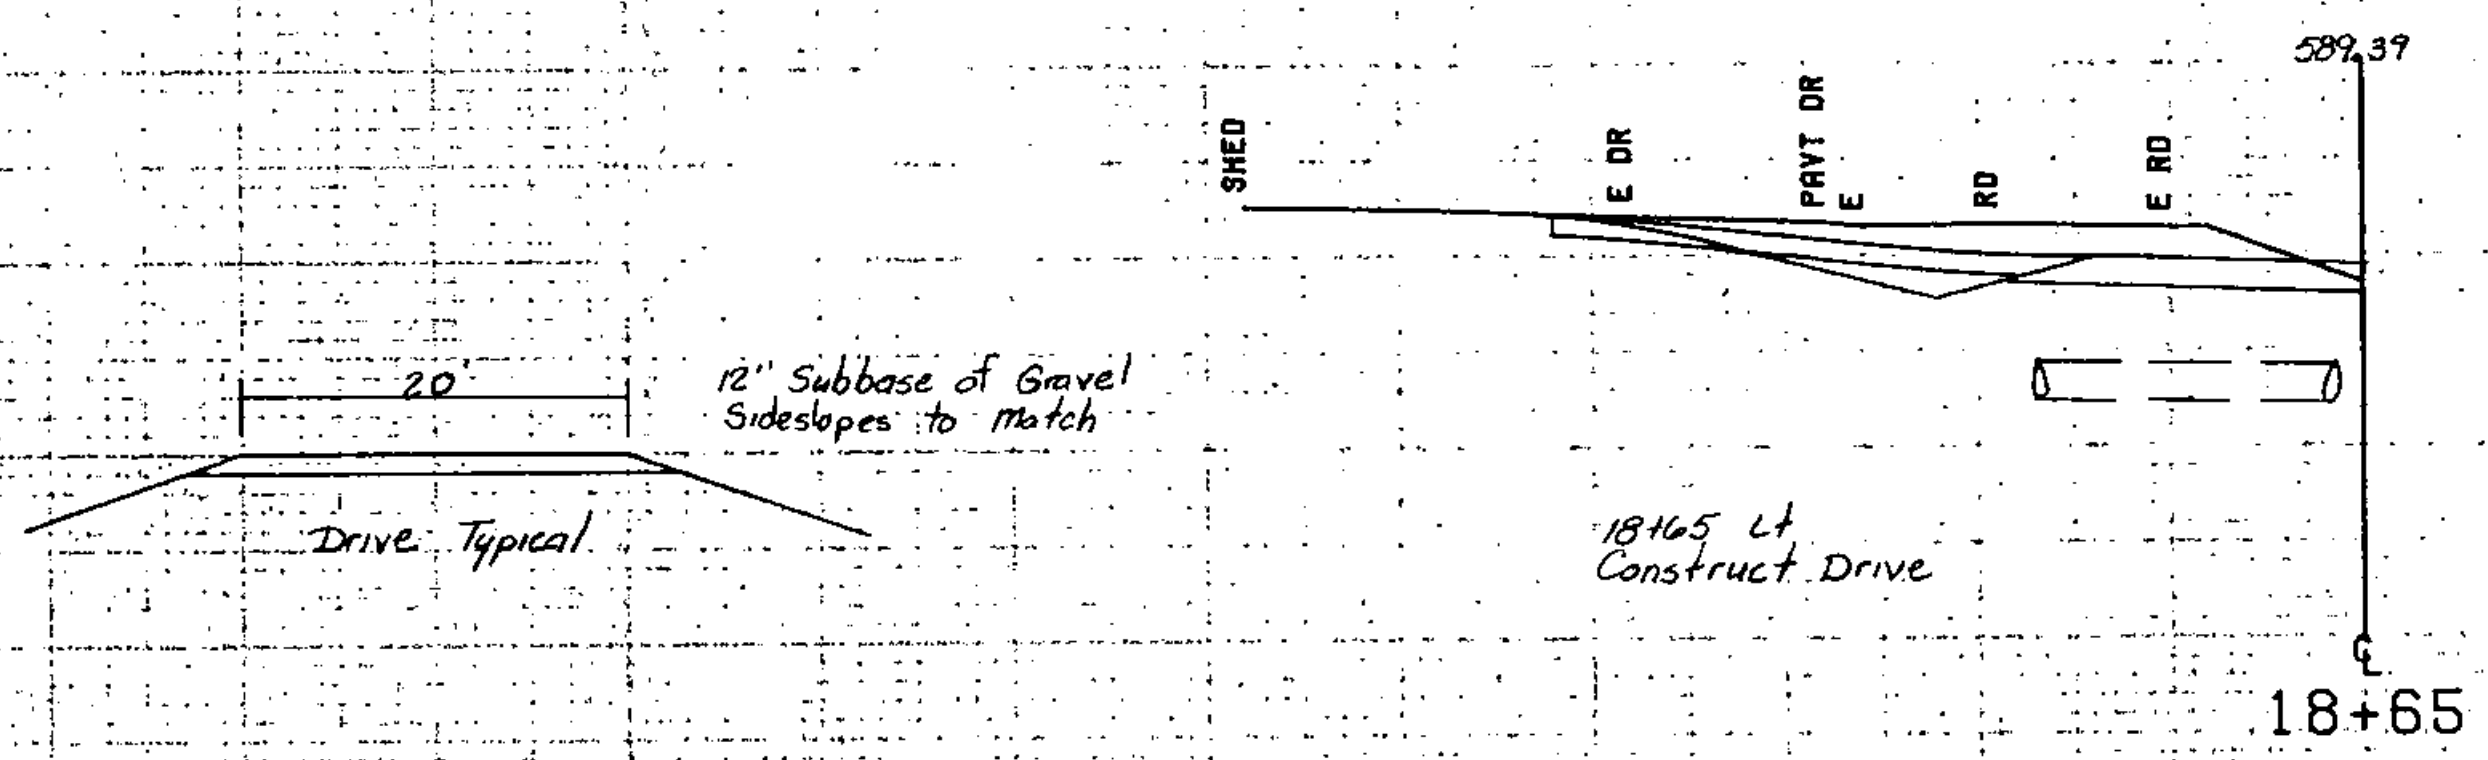

18+40 Lt - 19+20 Rt  
 New 24"x92" ACC.G.M.P. (064)

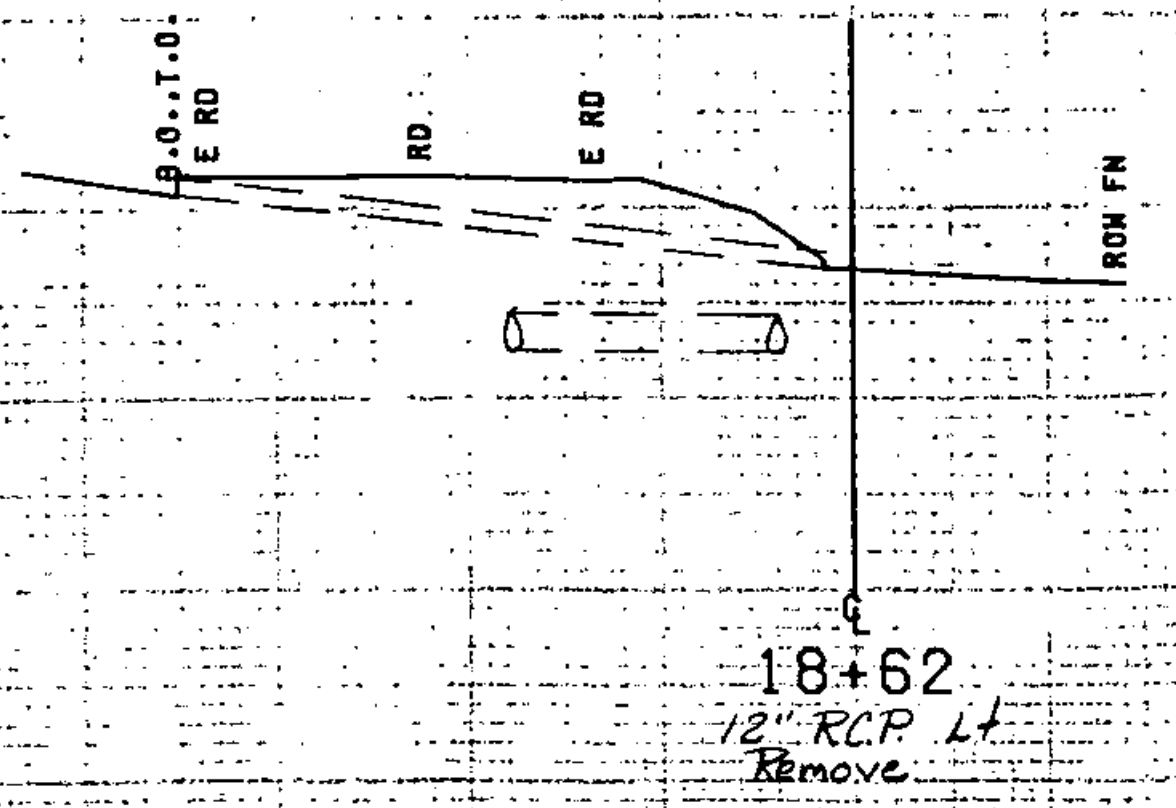

FROM STA.	18+62	TO STA.	19+00
PROJECT NAME	ST. JOHNSBURY T.H. 27		
NO.	DP-FFD41-1(10)	PLOTTED	12/11/84
SURVEYED BY	FANTONI 11/78		
SHEET	183 OF 200	SHEETS	222

SCALE 1" = 10' VERT