




width Transition
Scale 1"=10'

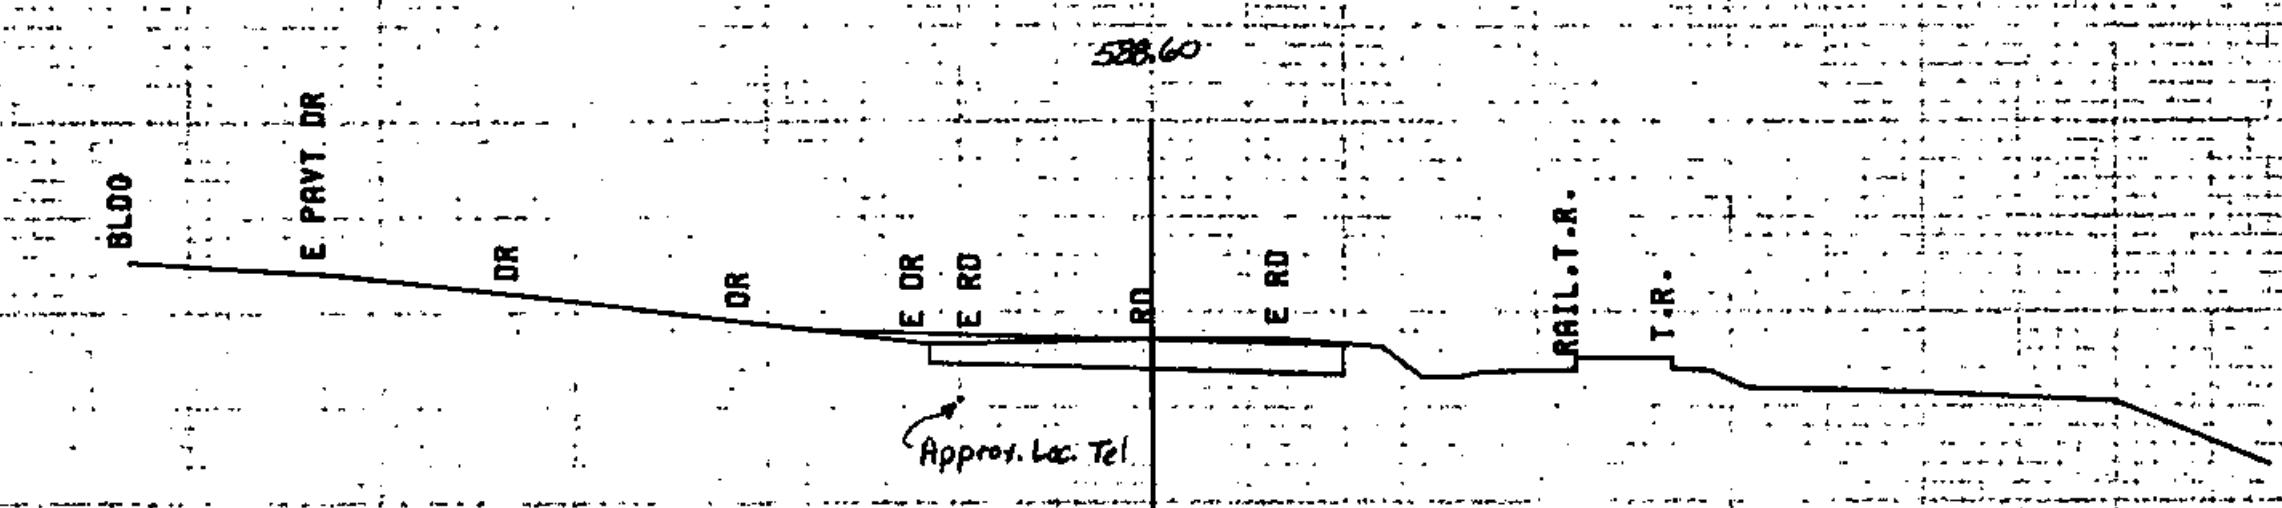

↑ 59
12' 11"

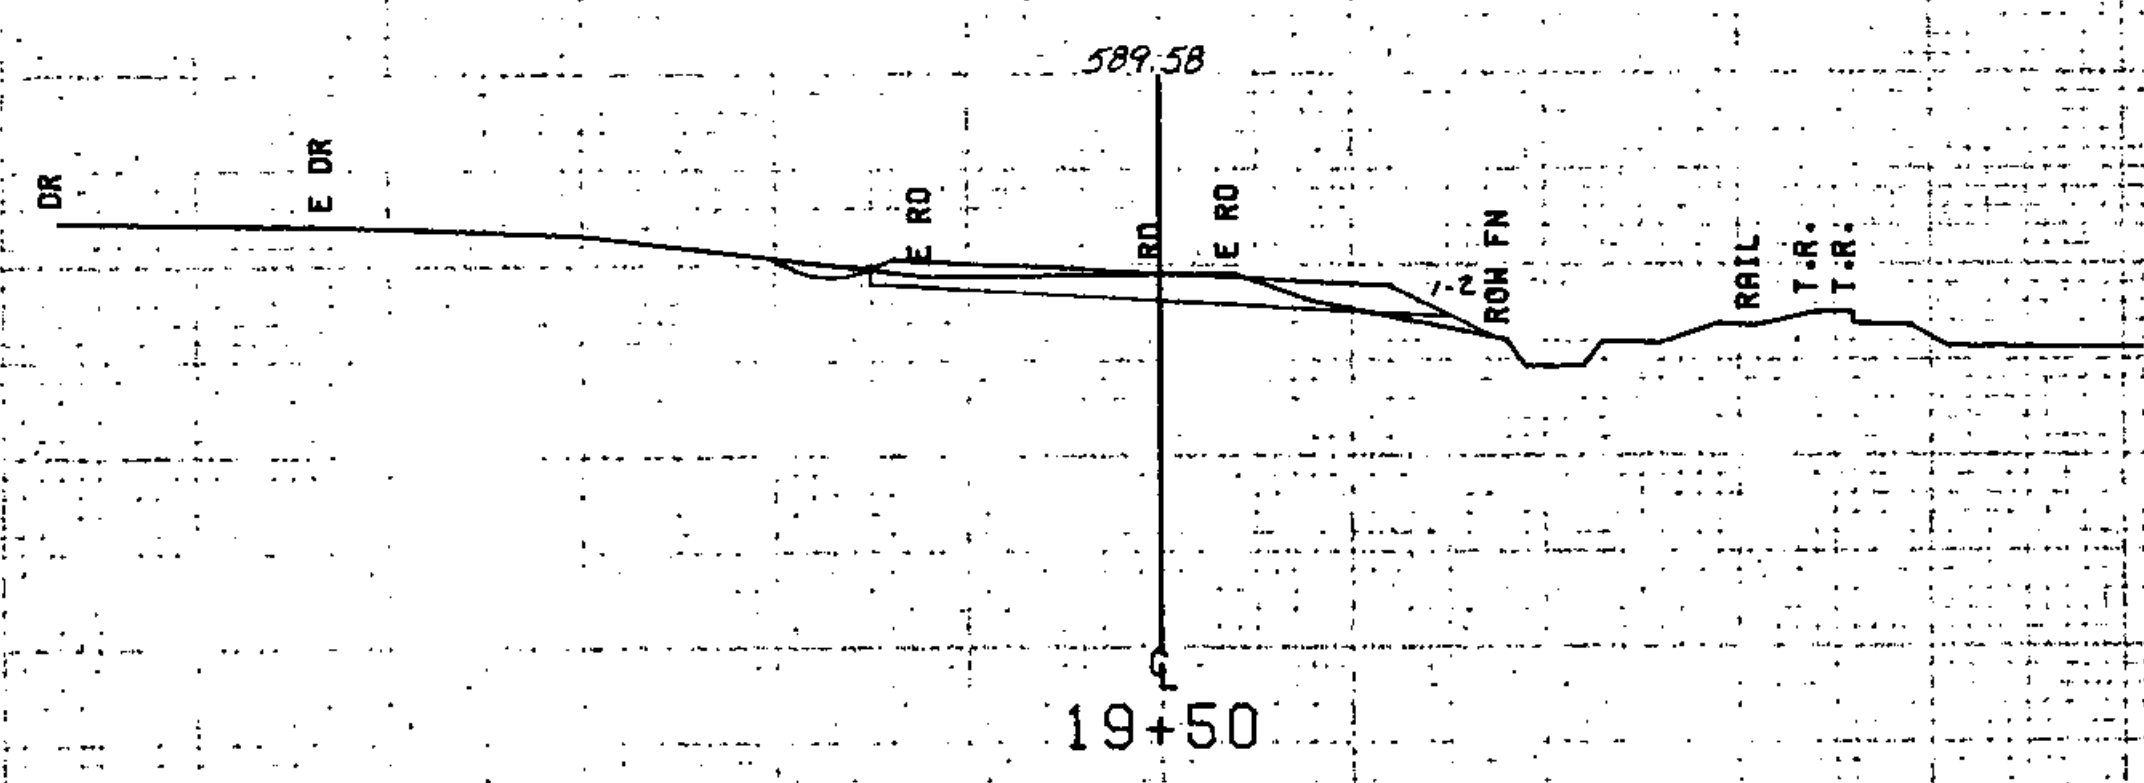

↑ 140
Flag Pole
Do Not Disturb

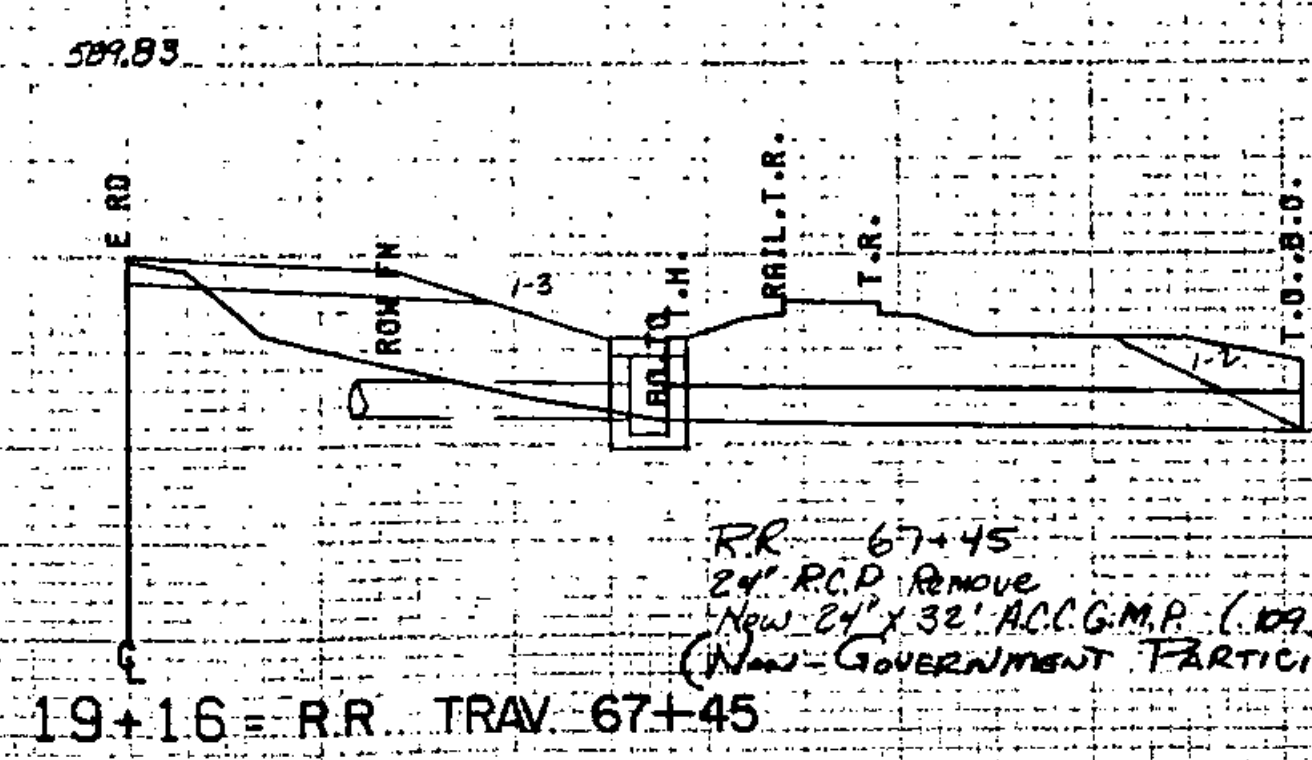

RR 67+45
24" R.C.P. REMOVE
New 24" x 32" A.C.C.G.M.P. (RA)
(New - GOVERNMENT PARTICIPATION)