
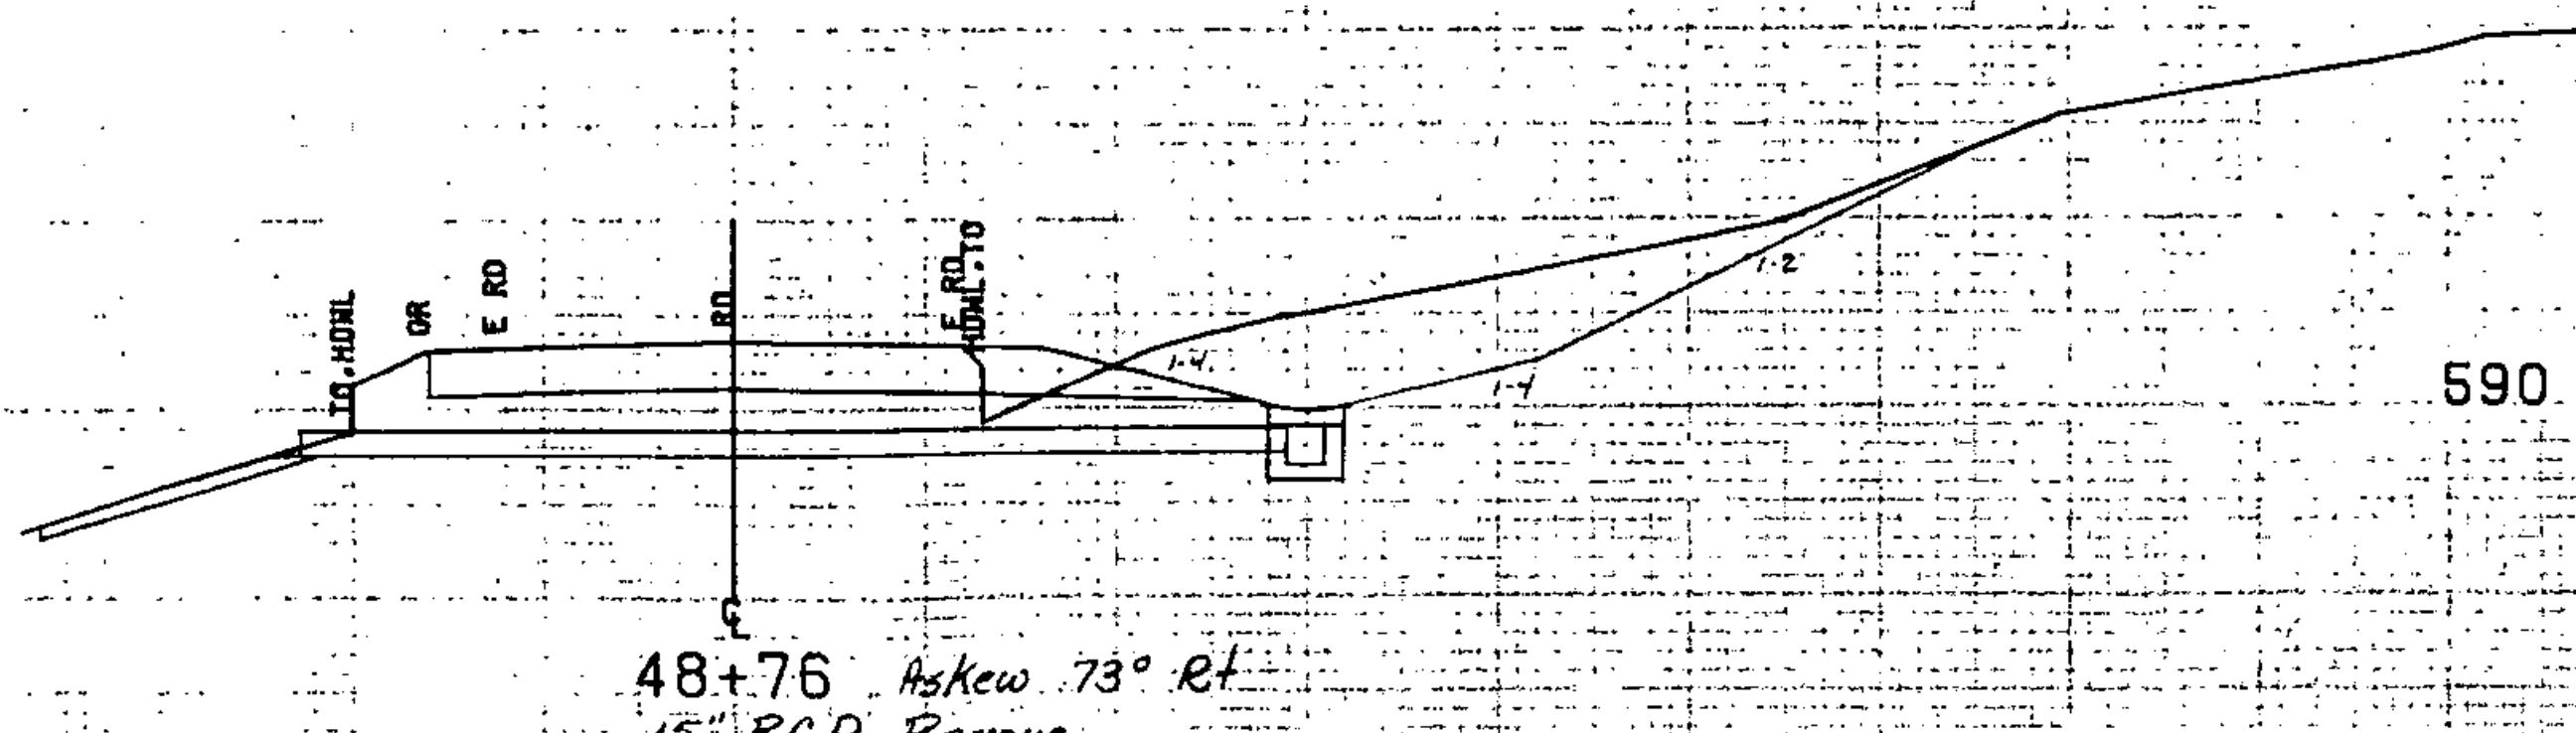


49+22 Lt
Construct Drive
(Commercial Road)

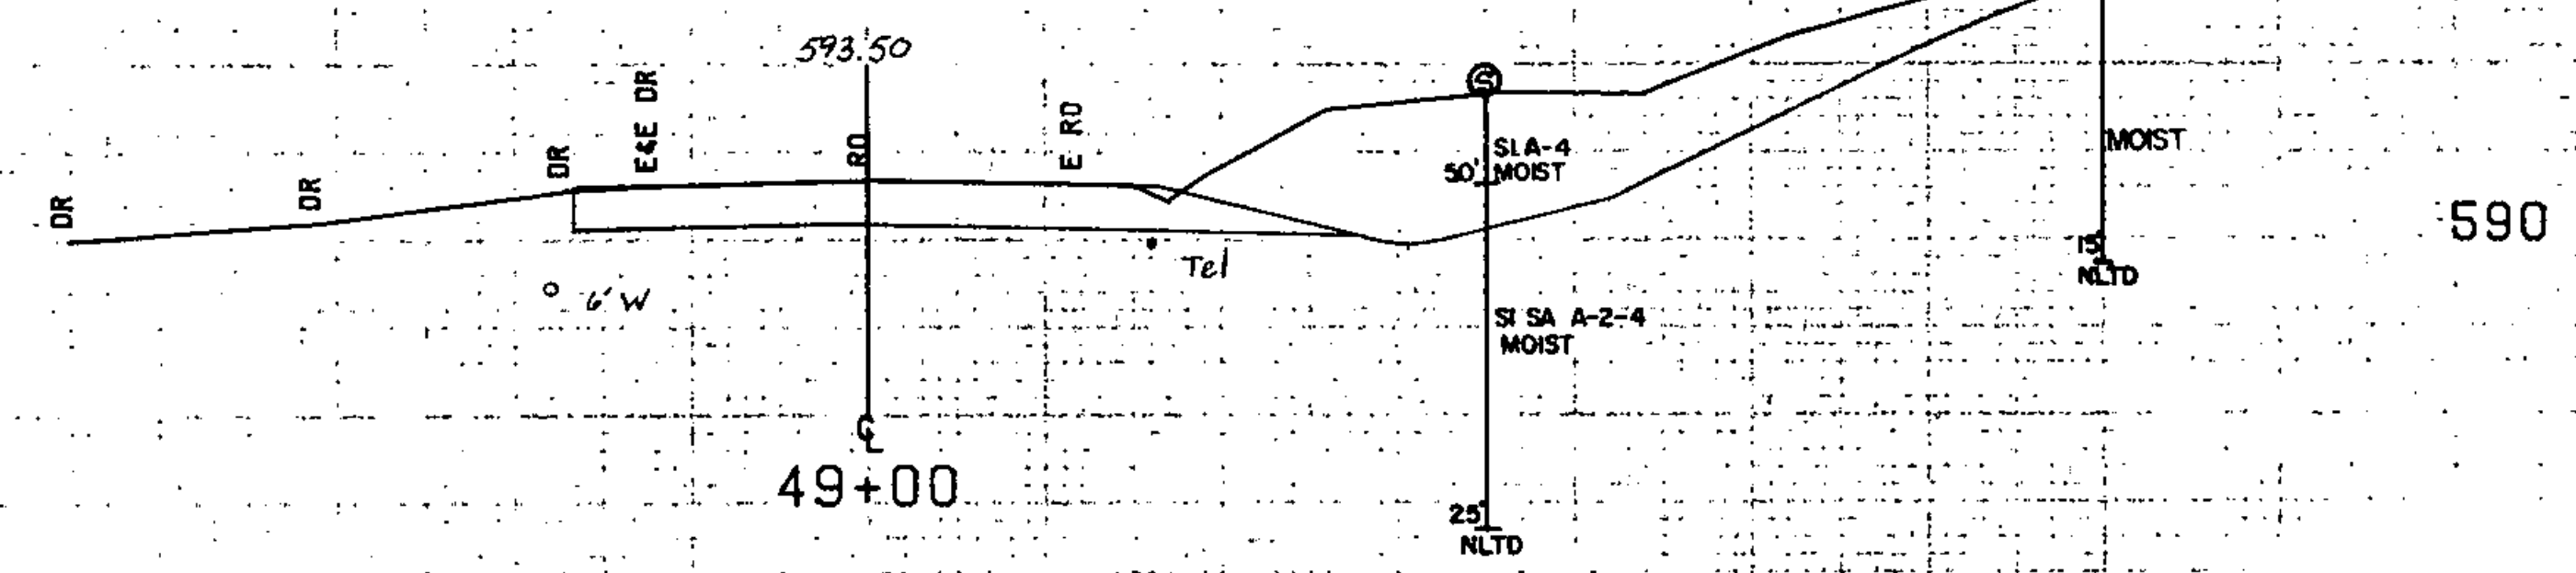

48+76 AsKew 73° Rt
15" R.C.P. Remove
New 18"x30" R.C.P. c.I. III
w/Type I Stone c. Outlet

FROM STA.	TO STA.
PROJECT NAME	ST. JOHNSBURY U.S. RTE. 6
NO.	DR-PP0411-11-101
SURVEYED BY	PANTONI 11/78
DRAWN BY	DR-PP0411-11-101
DATE	12/11/84

SCALE: 10 FEET