




POWER SUPPLY  
75

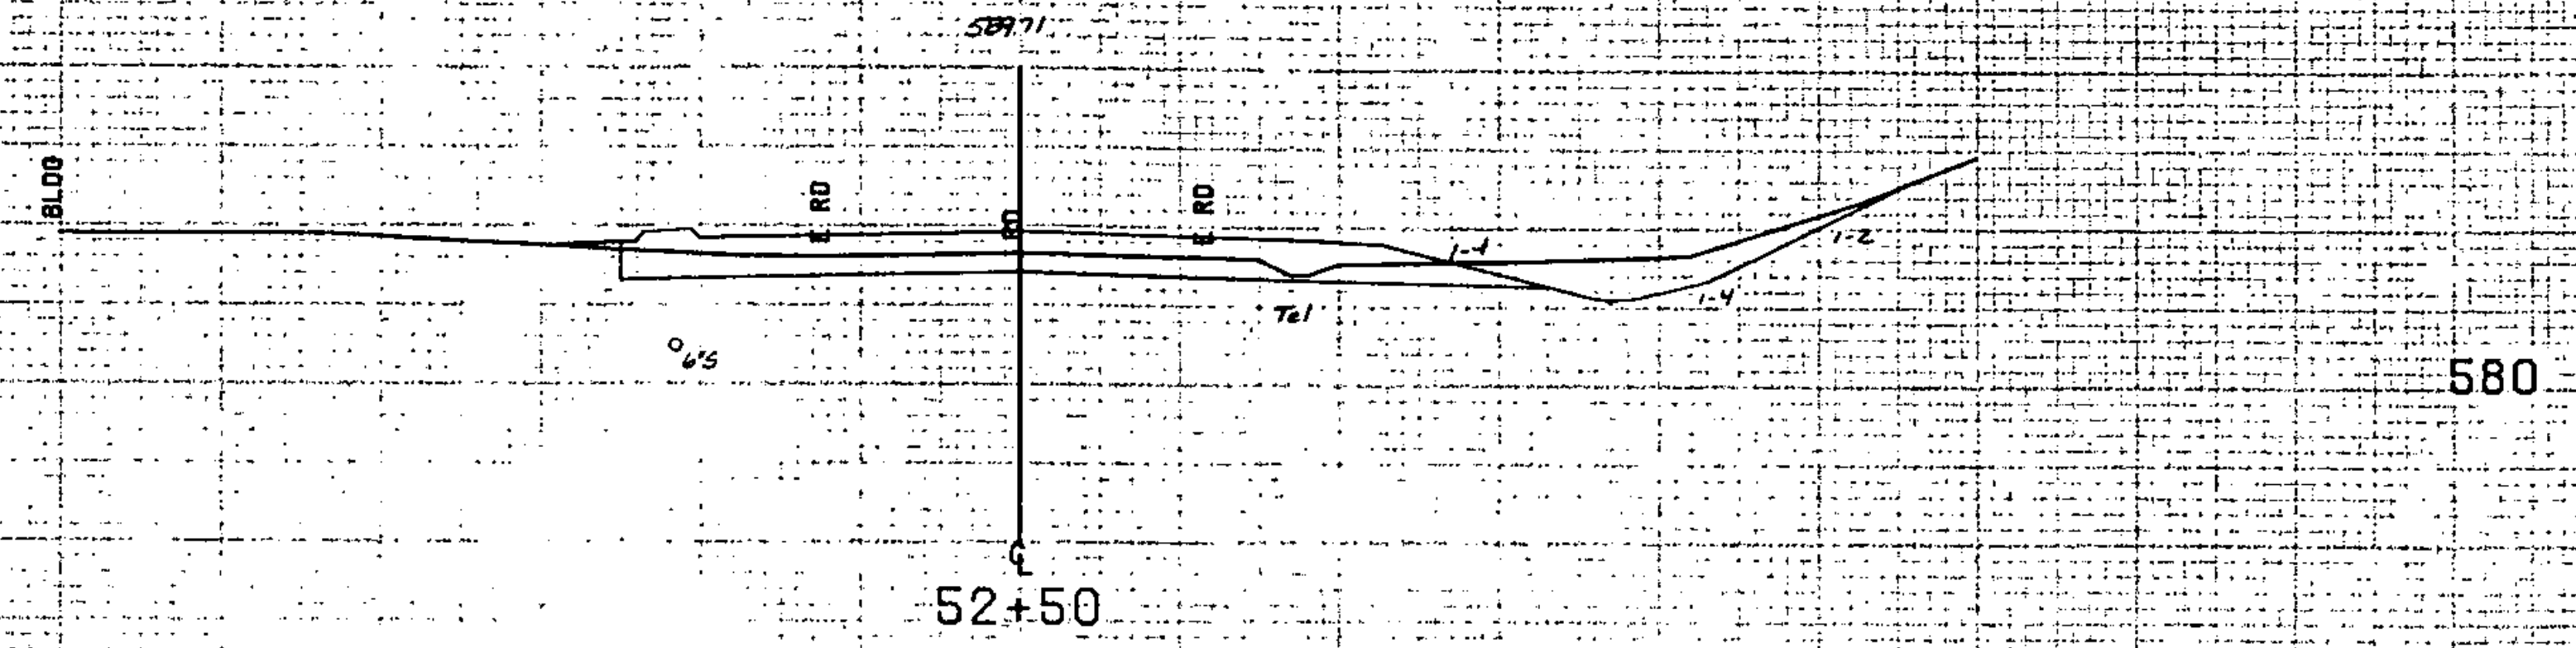

Sta 52+50 - Sta 52+71  
Cast in Place Cement Conc.  
Curb Type A. (Island)

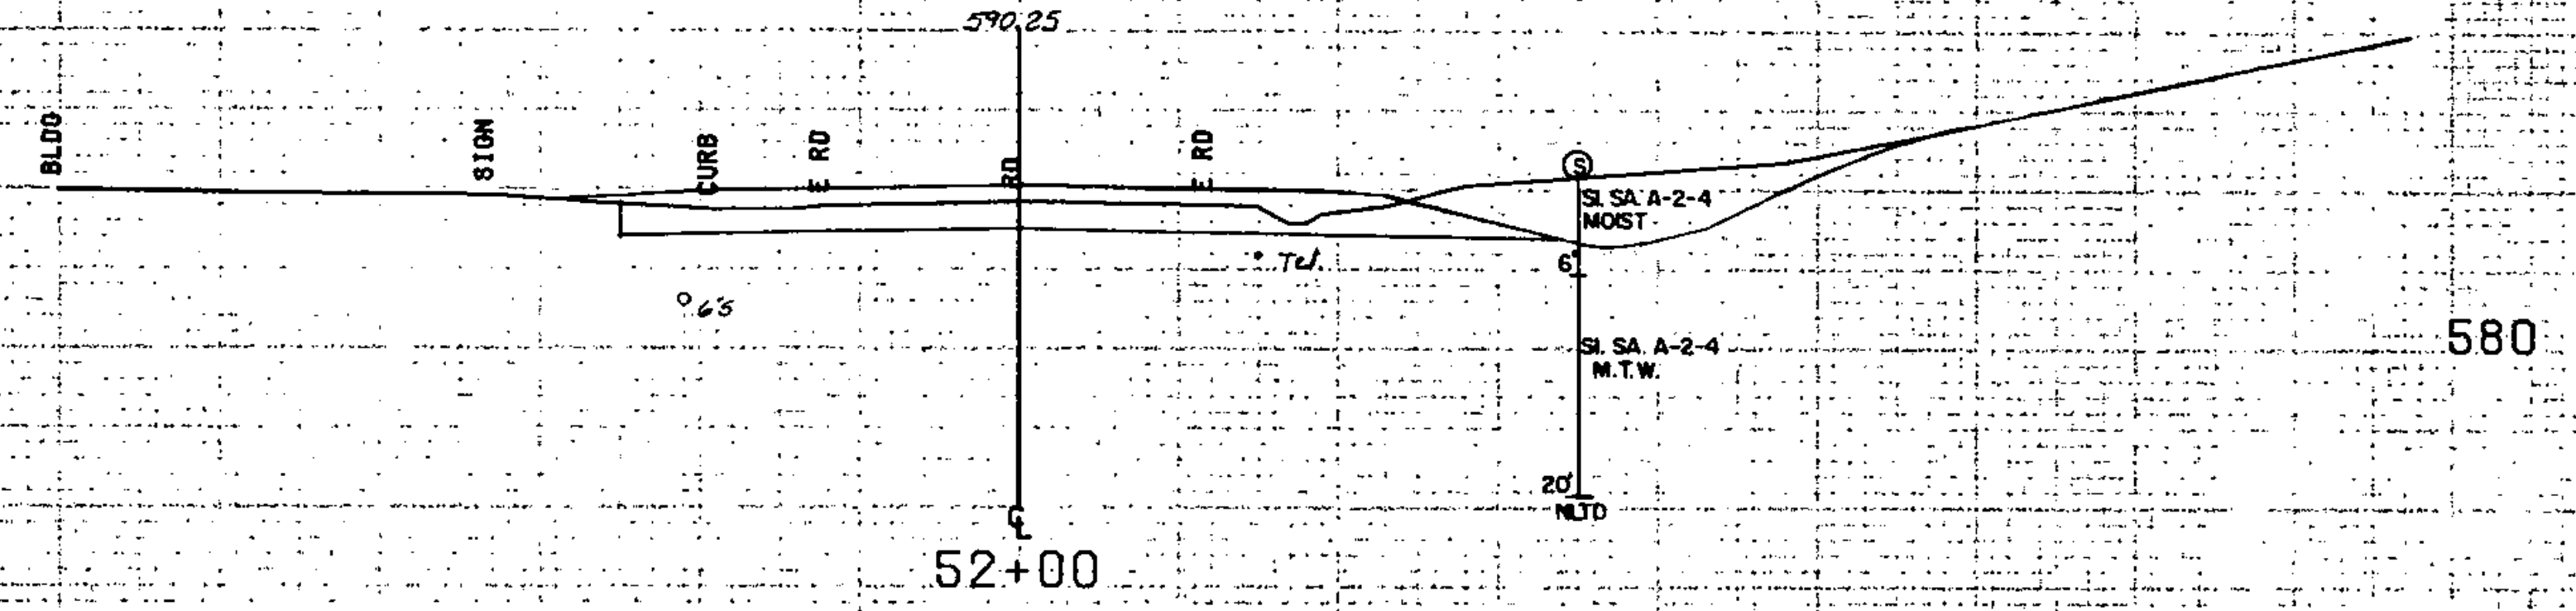

SI SA A-2-4  
MOIST  
SI SA A-2-4  
M.T.W.  
20  
NOT

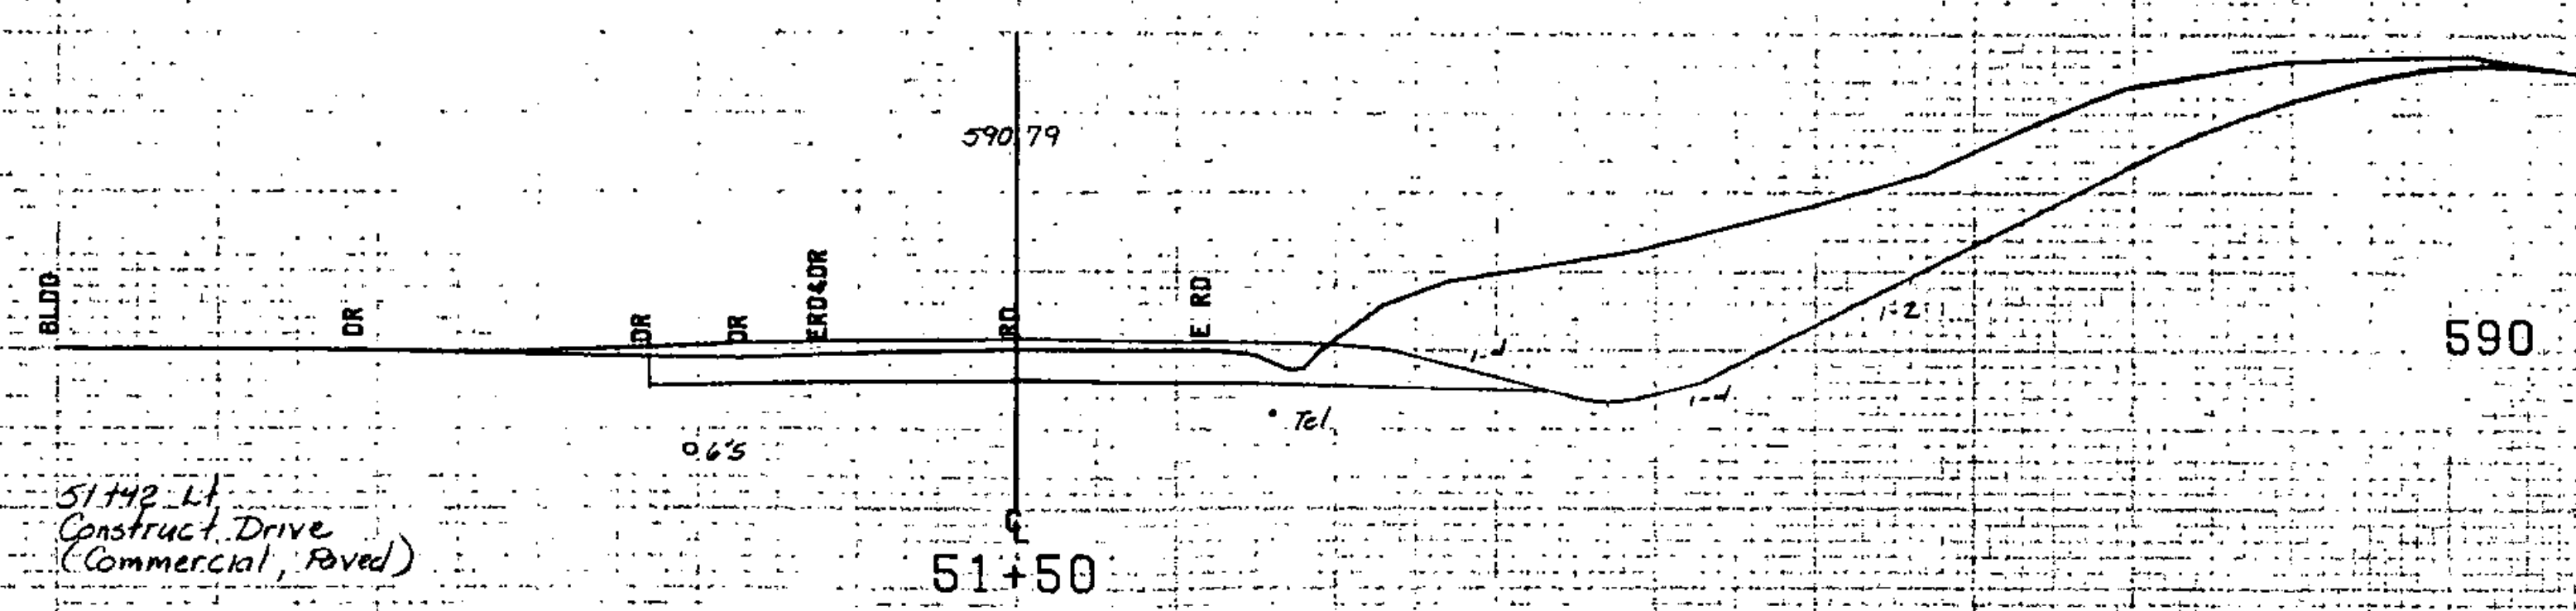

51+50 - 51+79  
Construct Drive  
(Commercial, Paved)

FROM STA.	51+50	TO STA.	52+50
PROJECT NAME	ST. JOHNSBURY U.S. RTE. 6		
NO.	DP-FF041-1(10)	PLOTTED	12/11/84
SURVEYED BY	FANTONI	11/78	
SHEET	102 OF 60	SHEETS	229

SCALE: 1" = 10 FEET