

INDEX OF SHEETS

SHEET #1 TITLE SHEET  
 SHEET #2 BRIDGE SUMMARY SHT & QUANTITIES  
 SHEET #3 - #5 DRAIN TROUGH DET.  
 SHEET #6 STANDARD E-9 6-8-78 R  
 SHEET #7 - #25 REFERENCE BRIDGE DETAILS  
 SHEET #26 - #32 REFERENCE STANDARDS

**RECORD PLANS-MATERIAL SUPPLIERS**


**CONTRACTOR-AMERICAN BRIDGE RAILING CORP., LYNN, MASS. CONTRACT DATED-3 OCTOBER 1979**  
**CONSTRUCTION BEGAN-2 JANUARY 1979 COMPLETED-9 AUGUST 1979 ACCEPTED-23 AUGUST 1979**  
**RESIDENT ENGINEER-FREDERICK W. ROSS III. RECORD PLANS-PAUL E. SINGLETON**  
**1 1/4" GALVANIZE PIPE-AMERICAN BRIDGE RAILING CORP., LYNN, MASS.**  
**JOINT SEALER POLYURETANE-SONNEBORN BUILDING PRODUCTS, MINN-APOLIS, MINN.**  
**PREFORMED FABRIC MATERIAL-B.F. GOODRICH ENGINEERING PRODUCTS CO., AKRON, OHIO**  
**DRAIN TROUGH SUPPORTS-CONCORD STEEL CORP., EVERETT, MASS.**  
**PAINT-CADILAC PAINT AND VARNISH CO. INC., ALLSTON, MASS.**

NOTE: ANY FURTHER INFORMATION CONCERNING  
 PRINAL QUANTITIES, AMOUNTS OR OTHER DETAILS  
 RELATIVE TO THIS PROJECT MAY BE FOUND IN  
 EITHER THE FIELD BOOK OR THE ESTIMATE  
 FILE

STATE OF VERMONT  
 DEPARTMENT OF HIGHWAYS




PROPOSED IMPROVEMENT  
 TOWNS OF  
 VERNON - BRATTLEBORO -  
 PUTNEY - WESTMINSTER - ROCKINGHAM  
 COUNTY OF WINDHAM

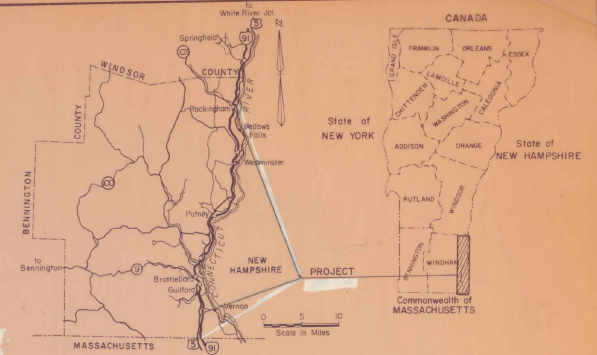

BEGINNING AT BRIDGE #1 ON I-91  
 4.0 MILES NORTHERLY OF THE MASS-  
 CHUSETTS-VERMONT STATE LINE  
 AND EXTENDING NORTHERLY ALONG  
 I-91 TO INCLUDE BRIDGE 23.54N AT M/M 35.2

	Mass. Border to Interchange No. 1	Interchange No. 1 to No. 2	Interchange No. 2 to No. 3	Interchange No. 3 to No. 4	Interchange No. 4 to No. 5	Interchange No. 5 to No. 6
1975 ADT	10,025	9,385	11,465	8,435	7,570	6,500
1975 DHV	1,160	1,110	1,270	1,020	930	820
D	51%	51%	51%	51%	51%	51%
T	7%	7%	7%	7%	7%	7%

PROJECT DESCRIPTION: THIS PROJECT SHALL CONSIST OF THE INSTALLATION OF DRAINAGE SYSTEMS AT PIERS ON INDICATED STRUCTURES.

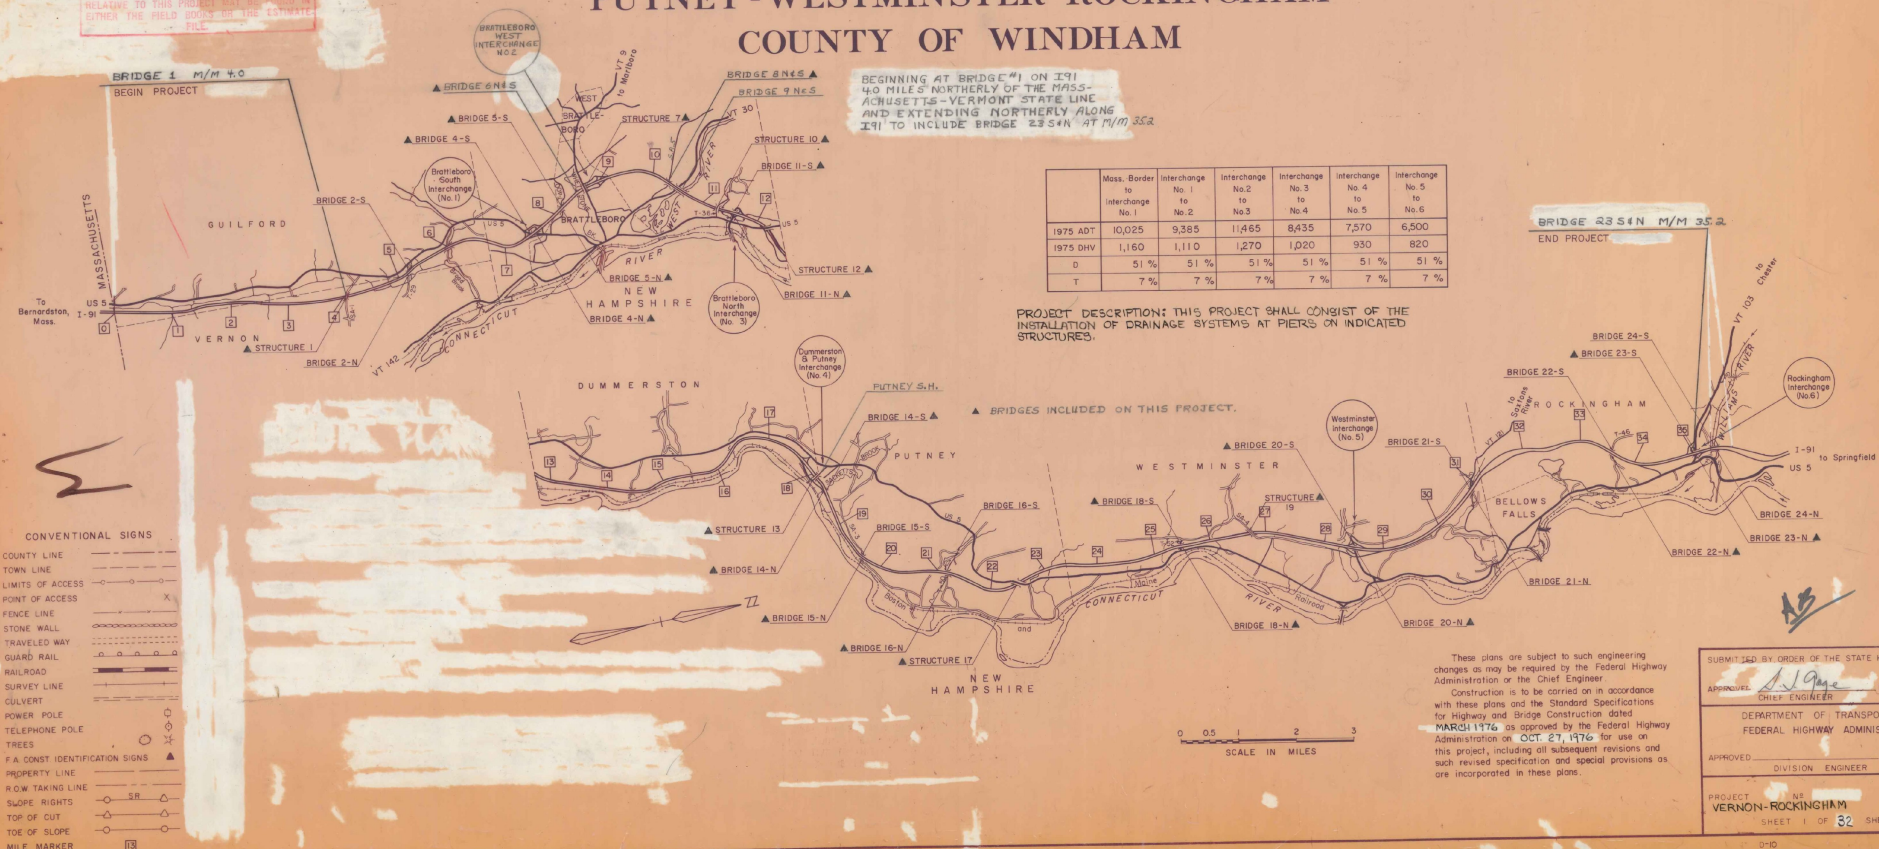

- CONVENTIONAL SIGNS
- COUNTY LINE
  - TOWN LINE
  - LIMITS OF ACCESS
  - POINT OF ACCESS
  - FENCE LINE
  - STONE WALL
  - TRAVELED WAY
  - GUARD RAIL
  - RAILROAD
  - SURVEY LINE
  - CULVERT
  - POWER POLE
  - TELEPHONE POLE
  - TREES
  - F.A. CONST. IDENTIFICATION SIGNS
  - PROPERTY LINE
  - ROW TRAILING LINE
  - SLOPE RIGHTS
  - TOP OF CUT
  - TOE OF SLOPE
  - MILE MARKER


These plans are subject to such engineering changes as may be required by the Federal Highway Administration or the Chief Engineer.  
 Construction is to be carried on in accordance with these plans and the Standard Specifications for Highway and Bridge Construction dated MARCH 1976 as approved by the Federal Highway Administration on OCT. 27, 1976 for use on this project, including all subsequent revisions and such revised specification and special provisions as are incorporated in these plans.

SUBMITTED BY: ORDER OF THE STATE HIGHWAY BOARD  
 APPROVED: *[Signature]* DATE: 12-15-79  
 CHIEF ENGINEER  
 DEPARTMENT OF TRANSPORTATION  
 FEDERAL HIGHWAY ADMINISTRATION  
 APPROVED: \_\_\_\_\_ DATE: \_\_\_\_\_  
 DIVISION ENGINEER  
 PROJECT NO. VERNON-ROCKINGHAM IR-91-1(5)  
 SHEET 1 OF 32 SHEETS  
 SRS 12/17/79

BRIDGE NO.	TOWN	DESCRIPTION	MILEAGE SEE NOTE NO. 4 BELOW	SKEW / SEE DETAIL BELOW	DECK WIDTH CURB TO CURB	CURB WIDTH	REFERENCE STANDARD DWG. FOR EXISTING EXPANSION JOINT	BEAM SPACING	EST. LENGTH OF NEW DRAIN TROUGH	NO. OF NEW DRAIN TROUGH	EST. TOTAL LENGTH OF NEW TROUGH PER BRIDGE	EST. WIDTH OF NEW FABRIC FOR TROUGH	DIRECTION OF FLOW IN TROUGH	EXTERIOR BEAM END PLATES TO BE REMOVED (SEE SHEET NO. 5)	TYPE OF PIER DIAPHRAM	REMARKS
1	VERNON	S.A. #1 OVER I91	4.0	28°	30'	2-2'-5"	SB-20-56	6'-0"	40'	3	120'	16"	LT.	6	CONCRETE	CHEEK WALLS ON PIERS.
4N	BRATTLEBORO	I91 OVER US 5	7.5	41°	30'	↑	SCB-30-56	7'-6"	47'	1	40'	↑	LT.	2	↑	
4S	"	" " "	7.5	41°	44'	↑	" " "	7'-6"	65'	1	65'	↑	LT.	2		
5N	"	I91 OVER MAPLE ST.	8.2	17°	42'	↓	SCB-42-56	7'-0"	49'	2	98'	↓	LT.	4		
5S	"	" " " "	8.2	20°	42'	↓	" " "	7'-0"	50'	2	100'	↓	LT.	4		
6N	"	I91 OVER WILLIAMS ST.	8.4	10°	30'	↓	SCB-30-56	7'-6"	36'	4	144'	↓	RT.	8		
6S	"	" " " "	8.4	5°	30'	2-2'-5"	" " "	7'-6"	36'	4	144'	16"	RT.	8		
7	"	VT 9 OVER I91	8.7	0°	64'	2-2'-5" VAR. MED.	SCB-42-56	7'-3"	78'	1	78'	16 TO 36"	RT. & LT.	2		1-PIPE IN 3RD & 7TH BAY.
8N	"	I91 OVER SA 5	10.3	20°	42'	2-2'-5"	" " "	7'-0"	50'	2	100'	16"	RT.	4		
8S	"	" " " "	10.3	20°	42'	↑	" " "	7'-0"	50'	2	100'	16"	RT.	4		
10	"	TR 36 OVER I91	11.2	4°	30'	↓	SCB-30-56	7'-6"	43'	3	129'	16 TO 36"	RT. & LT.	6		2 PIPES IN 1ST BAY
11N	"	I91 OVER BRATTLEBORO SR.	11.6	1°	42'	↓	SCB-42-56	7'-0"	47'	2	94'	16 TO 36"	RT. & LT.	NONE		
11S	"	" " " "	11.6	1°	42'	↓	" " "	7'-4"	47'	2	94'	16 TO 36"	RT. & LT.	↑		
12	BRATTLEBORO	US 5 OVER I91	12.2	38°	30'	↑	SB-22-58	7'-6"	42'	3	126'	16"	LT.			CONDUIT IN 4TH BAY
13	PUTNEY	PUTNEY S.H. OVER I91	18.2	17°	30'	↑		7'-6"	37'	3	111'	↑	RT.			1 PIPE OUTSIDE RT FACIA BEAM
14N	"	I91 OVER SACKETTS BRK.	18.5	20°	30'	↑		7'-6"	38'	2	76'	↑	LT.			
14S	"	" " " "	18.5	20°	30'	↑		7'-6"	38'	2	76'	↑	LT.			
15N	"	I91 OVER SA 3	19.7	45°	30'	↑		7'-6"	50'	4	200'	↑	LT.			
15S	"	" " " "	19.7	45°	30'	↑		7'-6"	50'	2	100'	↑	LT.			
16N	"	I91 OVER TH 50 + PUT. BRK.	21.3	0°	30'	↑		7'-6"	35'	3	105'	↑	LT.			
16S	"	" " " "	21.3	0°	30'	↑		7'-6"	35'	3	105'	↑	LT.			
17	PUTNEY	US 5 OVER I91	22.6	55°	30'	↑		7'-6"	61'	3	183'	16"	RT.			
18N	WESTMINSTER	I91 OVER TH 52	25.6	22°	42'	↓		7'-0"	51'	2	102'	16 TO 36"	RT & LT			
18S	"	" " " "	25.6	34°	42'	↓		7'-0"	57'	2	114'	16"	LT.			
19	"	SA 4 OVER I91	26.8	39°	30'	↓		7'-6"	45'	3	135'	↑	RT.			
20N	"	I91 OVER WESTMINSTER STATE HIGHWAY	28.6	28°	30'	↓		7'-6"	40'	2	80'	↑	LT.			
20S	WESTMINSTER	" " " "	28.6	28°	30'	2-2'-5"	SB-22-58	7'-6"	40'	2	80'	16"	LT.		CONCRETE	
22N	ROCKINGHAM	I91 OVER TH 46	33.7	15°	38'	2-2'-8"	SB-22-60	7'-6"	45'	2	90'	16 TO 36"	RT & LT.		STEEL	SEE DETAILS SHEET NO. 5
23N	"	I91 OVER VT 103	35.2	16°	30'	2-2'-8"	SB-22-56	7'-6"	37'	2	74'	16"	LT.		CONCRETE	
23S	ROCKINGHAM	" " " "	35.2	16°	42'	2-2'-8"	SB-22-56	7'-0"	50'	2	100'	16"	LT.	NONE	CONCRETE	
									TOTAL	71			TOTAL	50		
											3165					
											3200					

**NOTES**

1. STATIONING FOR I91 IS ASSUMED TO RUN IN A NORTHERLY DIRECTION.
2. STATIONING FOR A STRUCTURE CROSSING OVER I91 IS ASSUMED TO RUN FROM EAST TO WEST.
3. BEAMS OR BAYS BETWEEN BEAMS ARE NUMBERED LEFT TO RIGHT. THE LEFT FACIA BEAM IS ASSUMED TO BE THE "#1" BEAM.
4. MILEAGE NOTED FOR STRUCTURE IS MEASURED FROM THE MASSACHUSETTS-VERMONT LINE IN A NORTHERLY DIRECTION ALONG I91.
5. ESTIMATED LENGTH, WIDTH, AND DIRECTION OF FLOW FOR THE NEW FABRIC TROUGH IS ONLY APPROXIMATE AND MAY BE CHANGED BY THE ENGINEER SO AS TO MEET EXISTING FIELD CONDITIONS.

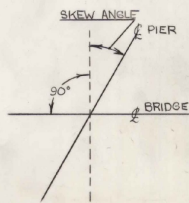


SKEW ANGLE DETAIL

**QUANTITIES**


NO.	ITEM	UNIT	ORIGINAL	FINAL
506.80	DRAIN TROUGH	LF	3200	
637.10	MAINTENANCE OF TRAFFIC FOR BRIDGE PROJECTS	LS	1	

**STATE OF VERMONT  
DEPARTMENT OF HIGHWAYS**


TOWN OF VERNON-ROCKINGHAM	Bridge No. VARIOUS
HIGHWAY NO. I91	Tag Sta. _____ Surv. Sta. _____
<b>SUMMARY CHART OF STRUCTURES</b>	
RECEIVING NEW FABRIC DRAIN TROUGH	
Designed by D. PERKINS	Drawn by D. PERKINS & C. DURAN
Checked by D. E. LATHROP date 6/78	Bridge Design Supervisor W. TRIPP date 6/78
PROJECT VERNON-ROCKINGHAM	PROJECT NO. IR-91-1(3)
Bridge Sheet No. _____	Sheet 2 of 32

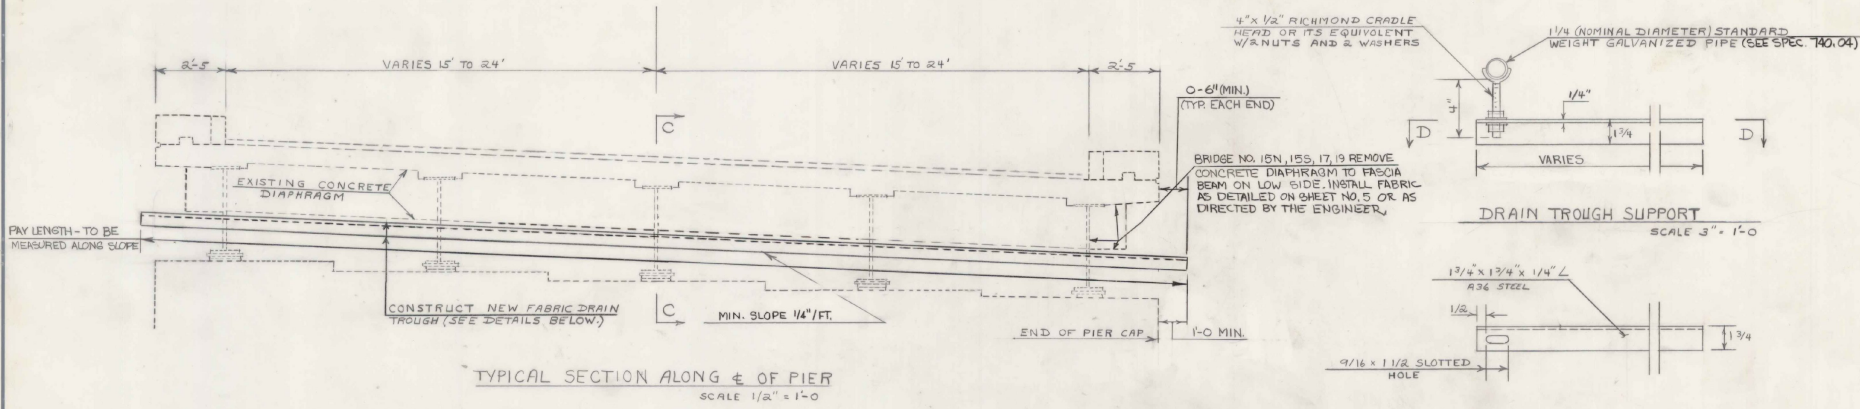

TYPICAL SECTION ALONG C-C OF PIER  
SCALE 1/2" = 1'-0"

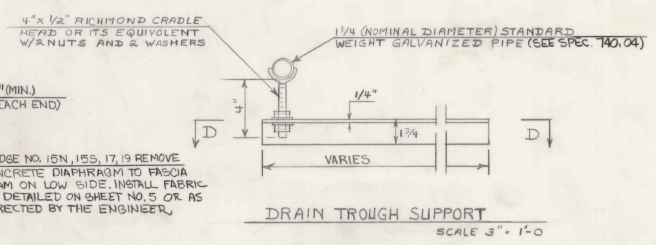

DRAIN TROUGH SUPPORT  
SCALE 3/8" = 1'-0"

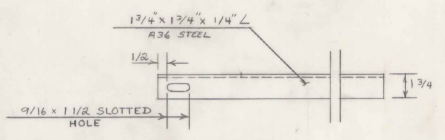


VIEW D-D  
SCALE 3/8" = 1'-0"


NOTES

1. THIS PROJECT CONSISTS MAINLY OF CONSTRUCTING FABRIC DRAIN TROUGHS AT THE PIER EXPANSION JOINTS OF THE BRIDGES DESIGNATED ON THE TITLE PAGE.
2. ALL EXISTING BITUMINOUS MATERIAL ON PIER CAPS WILL BE REMOVED AND ALL POCKETS OR WATER TRAPS WILL BE DAYLIGHTED TO THE EDGE OF THE PIER CAP.
3. ALL FOREIGN MATERIALS SUCH AS SAND, LOOSE CONCRETE, ETC. ON THE PIER CAPS WHERE TROUGH WORK IS DONE WILL BE CLEANED OFF BY FLUSHING WITH WATER. PAYMENT FOR FLUSHING PIER CAP WILL BE INCLUDED IN THE UNIT BID PRICE FOR FABRIC DRAIN TROUGHS.
4. MAINTENANCE OF TRAFFIC FOR BRIDGE PROJECTS WILL BE NECESSARY ONLY DURING WORKING HOURS AT THE CONSTRUCTION RELATED ROADWAY OBSTRUCTIONS SHALL BE REMOVED AFTER EACH DAYS WORK.
5. FABRIC USED IN THE CONSTRUCTION OF THE DRAIN TROUGHS WILL BE A PREFORMED FABRIC MATERIAL AS SPECIFIED IN SECTION 707.13 (IT SHALL BE ONE CONTINUOUS STRIP) THE NORMAL WIDTH OF FABRIC FOR A 5" DEEP TROUGH IS 16", HOWEVER, A VARYING WIDTH FABRIC MAY BE CALLED FOR BY THE ENGINEER IF DEEMED NECESSARY TO STEEPEN THE FLOW LINE GRADE. PAYMENT FOR FABRIC BELTING (ALL WIDTHS) AND THE INSTALLATION OF SAME SHALL BE INCLUDED IN THE UNIT BID PRICE FOR FABRIC DRAIN TROUGHS.
6. IF BOTTOM OF CONCRETE DIAPHRAGM HAS LOOSE OR BROKEN CONCRETE THE CONTRACTOR WILL REMOVE AND DISPOSE OF THESE SECTIONS, THEN WIRE BRUSH ENTIRE AREA SO THAT THE POLYURETHANE DRIP BEADS MAY BE PLACED ON REASONABLY SOUND CONCRETE. PAYMENT FOR THIS WORK WILL BE INCLUDED IN THE UNIT PRICE FOR FABRIC DRAIN TROUGHS.

ALL DETAILS ARE SUBJECT TO REVISIONS AS DIRECTED BY THE ENGINEER TO FIT ACTUAL FIELD CONDITIONS.


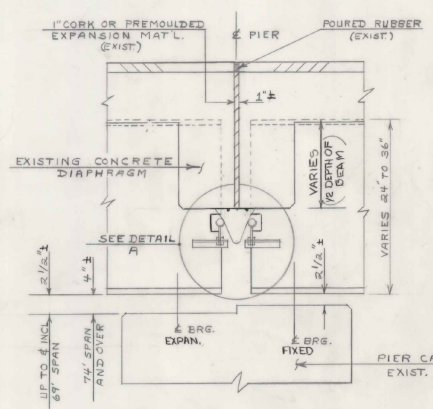


VIEW C-C  
SCALE 1" = 1'-0"

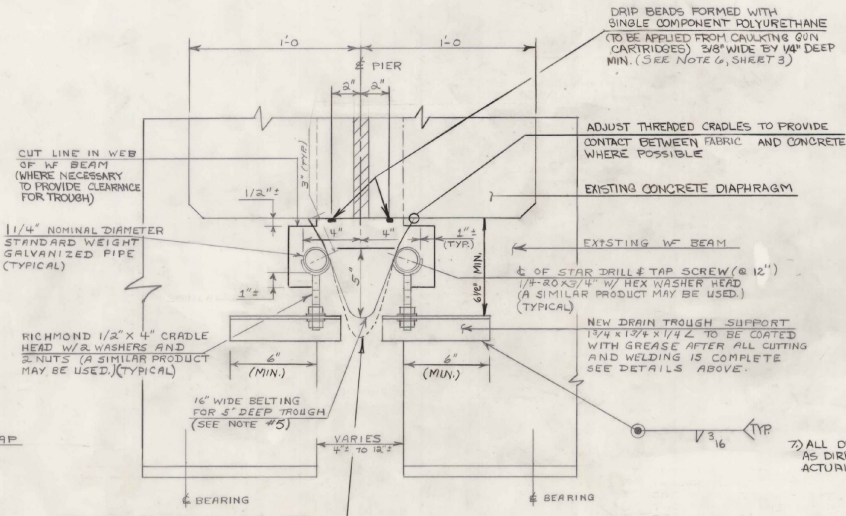


DETAIL A  
SCALE 3/8" = 1'-0"

STATE OF VERMONT DEPARTMENT OF HIGHWAYS	
TOWN OF VERNON-ROCKINGHAM	Bridge No. VARIOUS
HIGHWAY NO. 171	Tag Sta. 197
EXPANSION JOINT DRAIN TROUGH DETAILS	
Designed by D. PERKINS	Drawn by L. PERKINS & G. DUBRAY
Checked by DE. LATHROP date 6/78	Bridge Design Supervisor W. TRIPP date 6/78
PROJECT VERNON-ROCKINGHAM	PROJECT NO. IR-91-1(3)
Bridge Sheet No.	Sheet 3 of 32

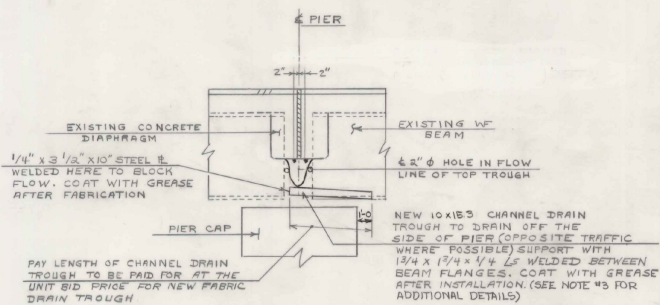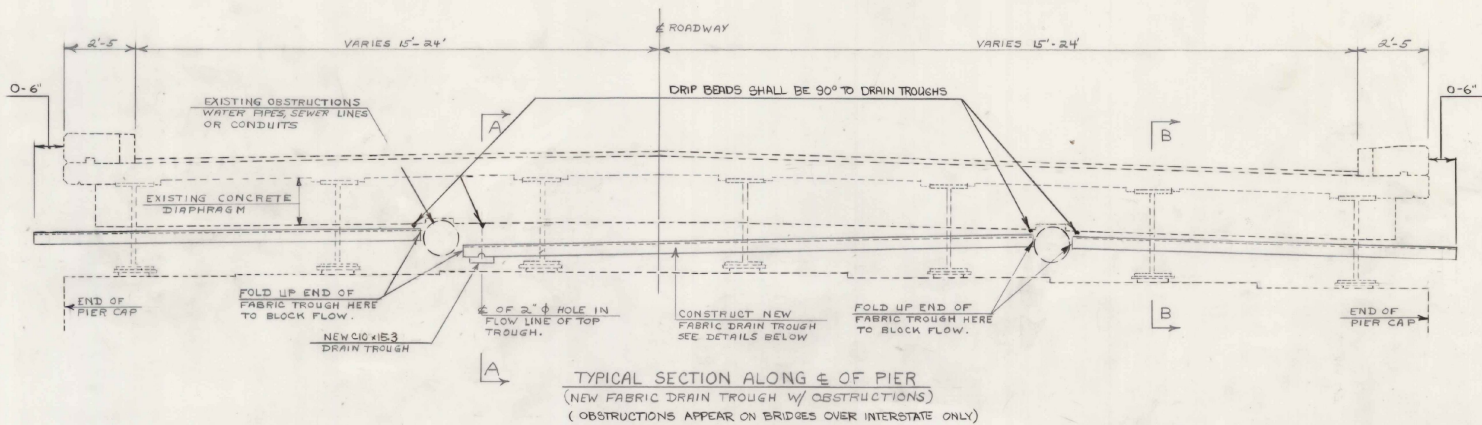


DRIP BEADS FORMED WITH SINGLE COMPONENT POLYURETHANE (TO BE APPLIED FROM CAULKING GUN CARTRIDGES) 3/8" WIDE BY 1/4" DEEP MIN. (SEE NOTE 6, SHEET 3)

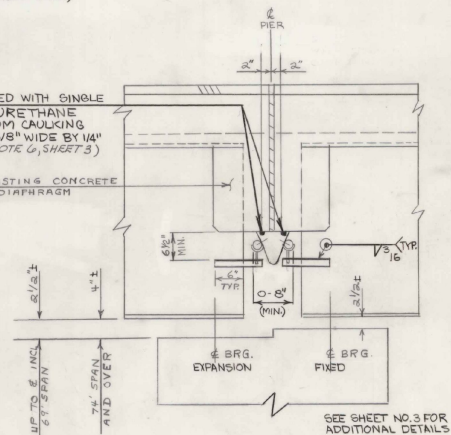


**NOTES**

1. ALL NEW STEEL COMPONENTS USED IN CONSTRUCTING FABRIC DRAIN TROUGHS SHALL BE PAINTED AS SPECIFIED IN SECTION 513 OF STANDARD SPECIFICATIONS AND SPRAY COATED WITH ONE COAT OF GREASE. GREASE WILL BE AS SPECIFIED IN SPECIAL PROVISIONS.
2. IN LIEU OF WELDER CERTIFICATION, THE WELDER MAY BE APPROVED BY DEMONSTRATION TO THE ENGINEER OF HIS ABILITY TO PERFORM SATISFACTORY WELDING.
3. THE NEW 10 X 15.3 CHANNEL SHALL BE USED TO DRAIN WATER OFF THE SIDE OF THE PIERS WHEN AN OBSTRUCTION TO THE MAIN FABRIC TROUGH IS ENCOUNTERED. THE CHANNEL MAY BE SUPPORTED BY SHORT LEGS SETTING ON THE CONCRETE PIER CAP, HOWEVER, IT SHOULD ALSO BE ATTACHED TO WF BEAM FLANGES IN SUCH A MANNER AS TO HOLD THE CHANNEL FIRMLY IN POSITION. PAYMENT FOR CHANNEL TROUGH (MATERIALS AND INSTALLATION) WILL BE AT THE SAME UNIT PRICE AS THE FABRIC DRAIN TROUGH.
4. BRIDGES #1, #7, #10, #12, #18 AS SHOWN ON THE TITLE SHEET HAVE PIPES, CONDUITS, OR CONCRETE PIER CHEEK WALLS THAT WILL OBSTRUCT A CONTINUOUS FABRIC DRAIN TROUGH. THEREFORE, IT WILL BE NECESSARY TO TREAT THESE PIER EXPANSION JOINTS SIMILAR TO THE DETAILS SHOWN ON THIS SHEET.
5. ALL STRUCTURAL STEEL SHALL CONFORM TO ASTM A-36 EXCEPT AS NOTED.

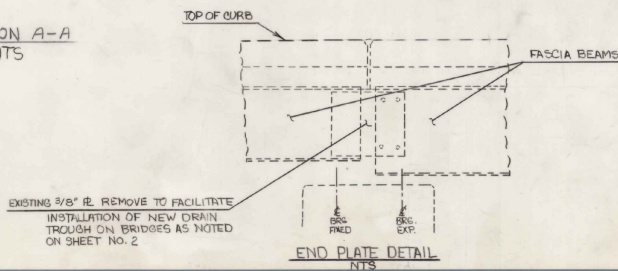


**STATE OF VERMONT  
DEPARTMENT OF HIGHWAYS**


TOWN OF VERNON-ROCKINGHAM	Bridge No. VARIOUS
HIGHWAY NO. 191	Log Sta. Surv. Sta.
<b>EXPANSION JOINT DRAIN TROUGH DETAILS</b>	
Designed by D. PERKINS	Drawn by D. PERKINS
Checked by D.E. LATHROP date 6/78	Bridge Design Supervisor W. TRIPP date 6/78
PROJECT VERNON-ROCKINGHAM	PROJECT NO. IR-91-1(3)
Bridge Sheet No.	Sheet 4 of 32

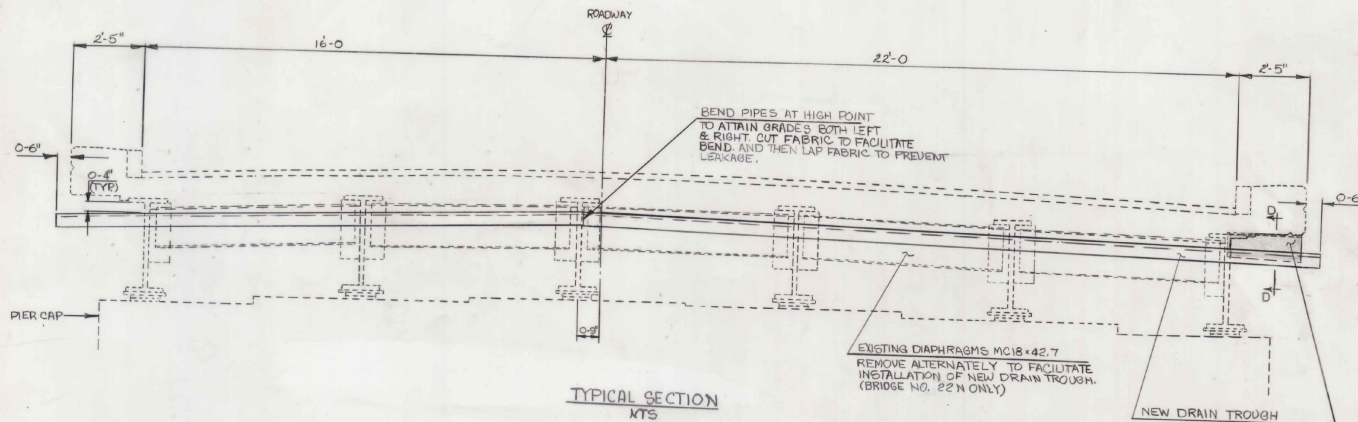


TYPICAL SECTION  
NTS

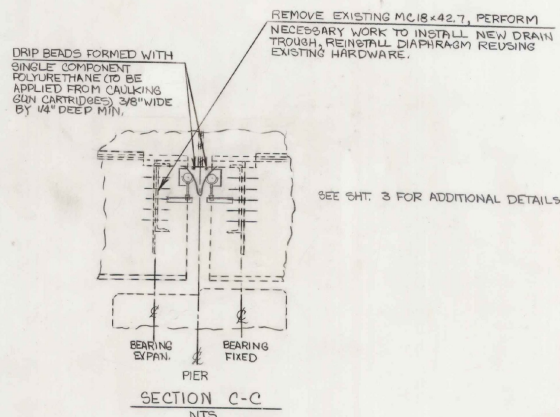


SECTION C-C  
NTS

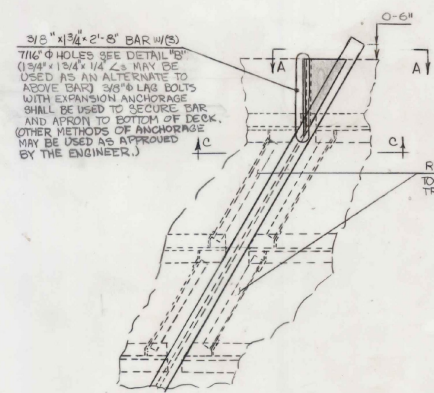


TYPICAL PARTIAL PLAN VIEW @ PIER  
NTS

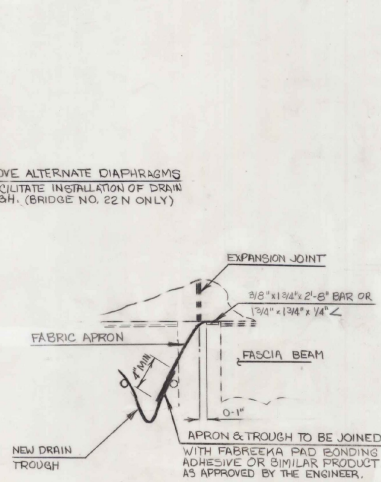

SECTION D-D  
NTS

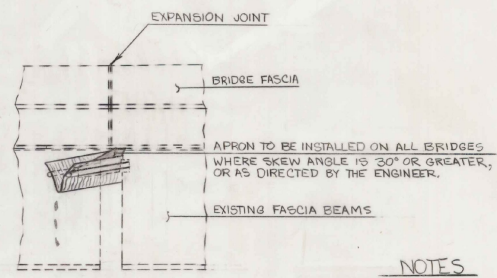

VIEW A-A  
NTS

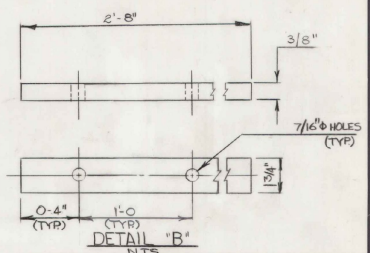

DETAIL 'B'  
NTS

NOTES  
1) FOR INSTALLATION & MATERIAL DETAILS OF TROUGH SEE SHEET NO. 3



**STATE OF VERMONT  
DEPARTMENT OF HIGHWAYS**

TOWN OF	VERNON - ROCKINGHAM	Bridge No. 22 N
HIGHWAY NO.	I 91	Log Sta.
		Surr. Sta. 1783+92.22
EXPANSION JOINT DRAIN TROUGH		
DETAILS		
Designed by	D. PERKINS	Drawn by
Checked by	DE LATHROP	Bridge Design Supervisor
date	6/78	W. TRIPP
PROJECT	VERNON - ROCKINGHAM	PROJECT NO.
	1R-91-1(3)	
Bridge Sheet No.	Sheet	5 of 32



PLAN  
 PROJECT: 1-36  
 SHEET: 34 OF 32  
 DATE: 1-36  
 DRAWN BY: [Signature]  
 CHECKED BY: [Signature]  
 IN CHARGE: [Signature]


PROFILE  
 PROJECT: 1-36  
 SHEET: 34 OF 32  
 DATE: 1-36  
 DRAWN BY: [Signature]  
 CHECKED BY: [Signature]  
 IN CHARGE: [Signature]

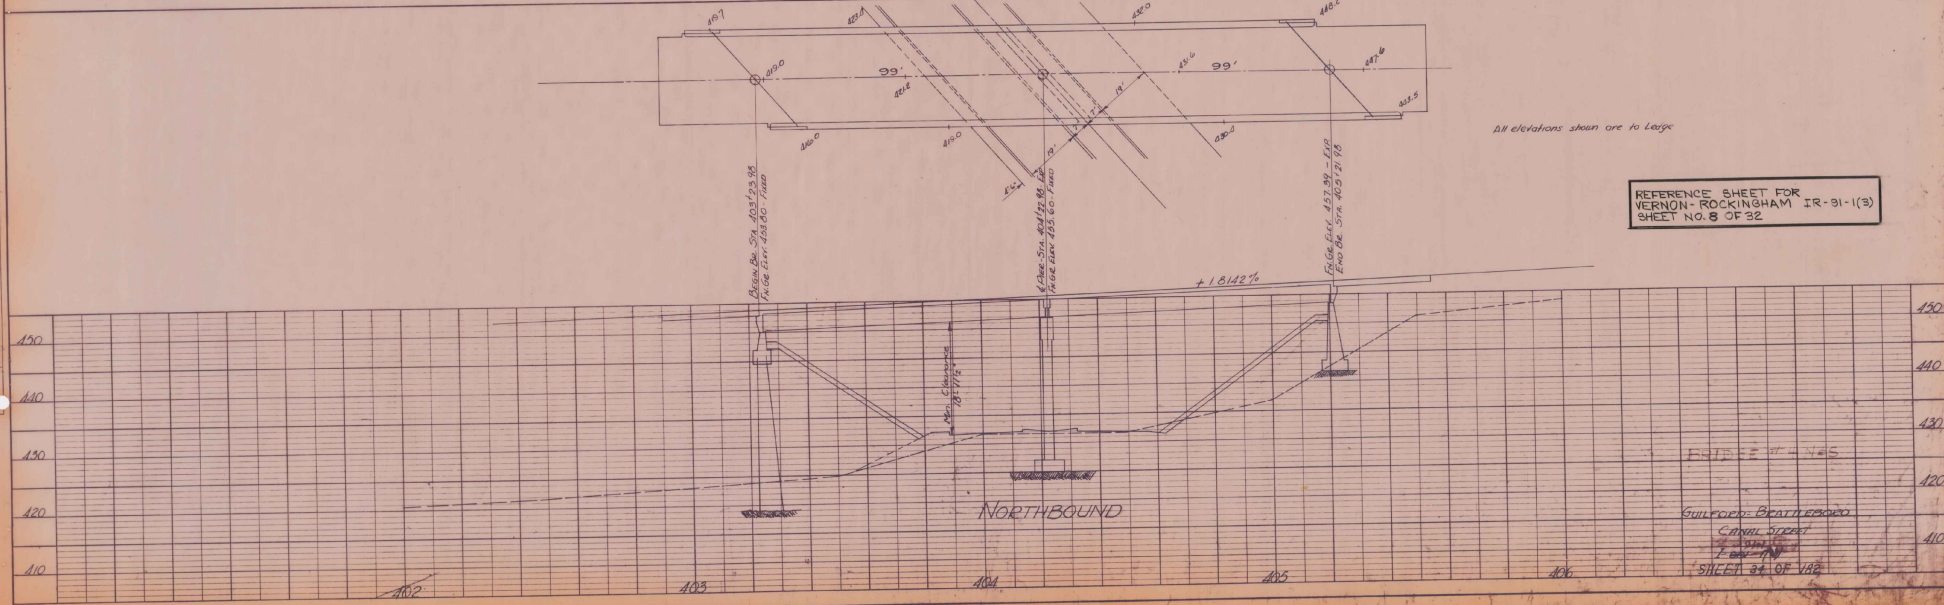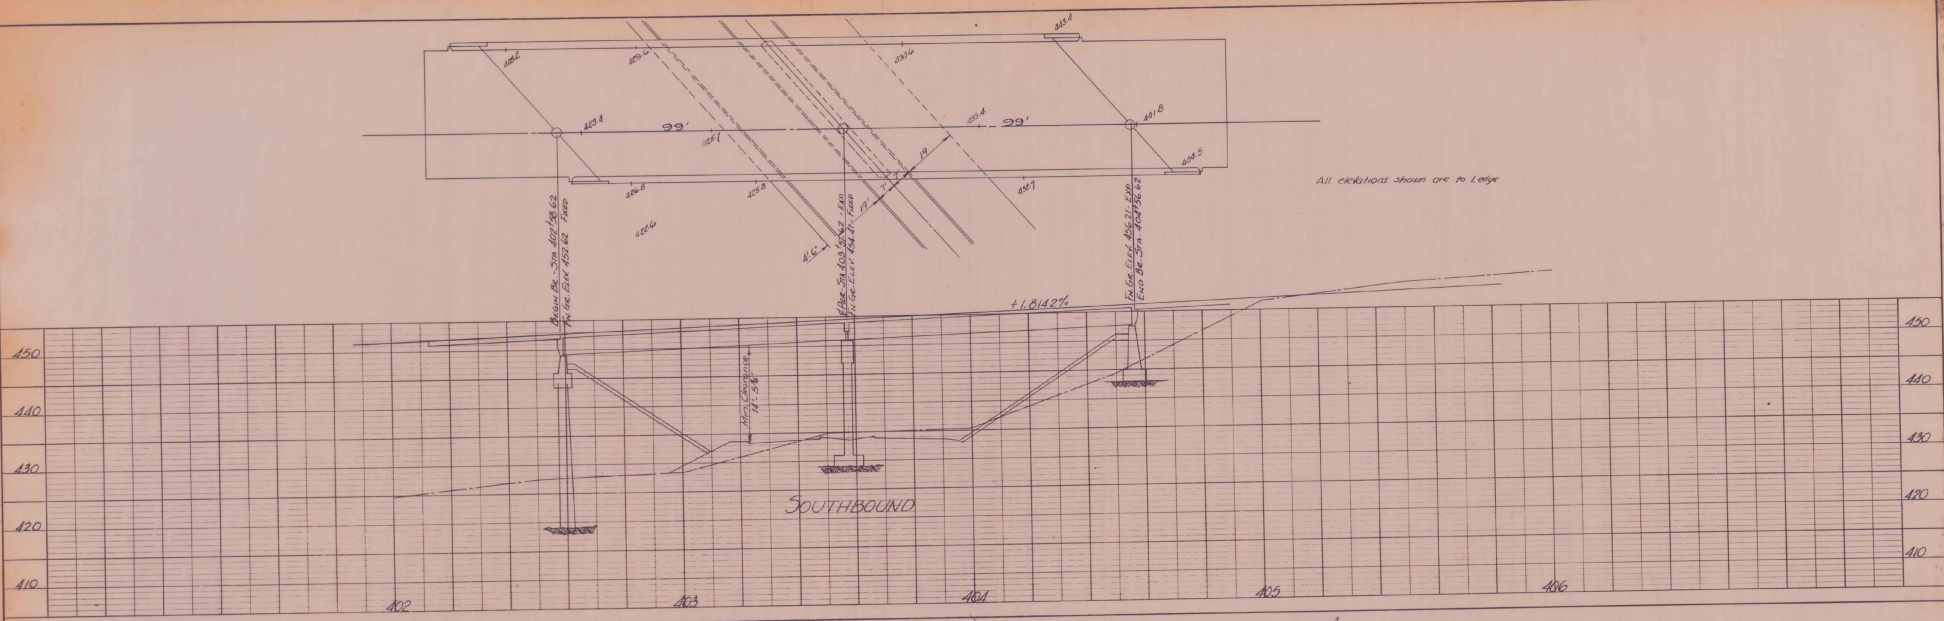

REFERENCE SHEET FOR  
 VERNON-ROCKINGHAM IR-91-1(3)  
 SHEET NO. 8 OF 32

ERIE # 145  
 GUILFORD BEATTLES  
 CAPITAL STREET  
 7.85' x 17'  
 SHEET 34 OF 32



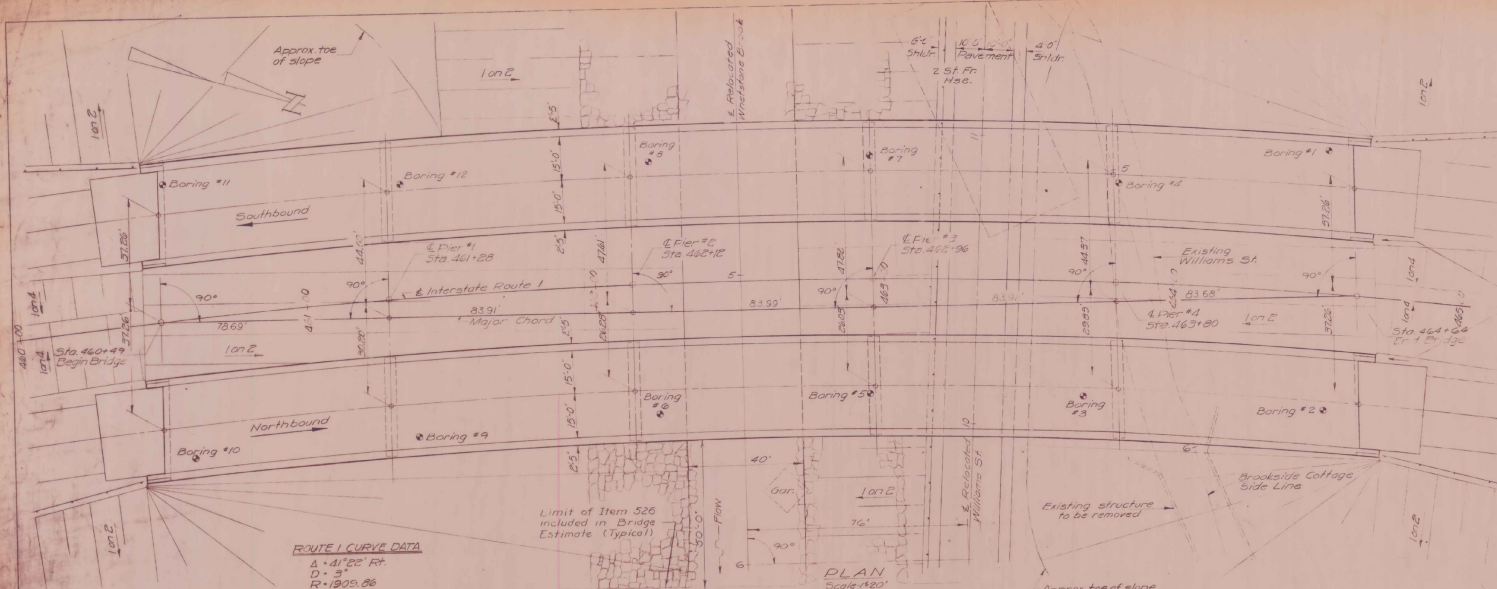

ESTIMATE OF QUANTITIES FOR TWO BRIDGES

ITEM NO	DESCRIPTION	UNIT	QUANTITY
102	Borrow	CY	47700
204	Sub-base of Crushed Rock Mod.	CY	850
36-B	Bituminous Concrete Pavement (Mod)	Ton	390
373	Top Course of Concrete Slab (Supp. Type)	Yd	2
401-2	Concrete Slab (Mod)	CY	2714
402	Reinforcing Steel	Lb	243,910
403	Spiral Reinforcement	Lb	1
404A	Structural Steel	Lb	118,236
501	Turning Equipment for Dr. Piles	L.S.	18
222	Grout Breakfill	Lb	22,000
504	Steel Piling	L.F.	715
506-C	Granite Bridge Curb	L.F.	1642
576	Bridge Railing	C.Y.	2268
607	Structure Excavation	S.Y.	144
526	Riprap for Bank Protection	C.Y.	2070
442	Removal of Present Superstructure	L.S.	1

For 50% of quantity treatment of approaches and standard sheet RS-57-7.


\* R.R. of Sta 464 +25

GENERAL NOTES

- Materials and Construction shall conform to State of Vermont Department of Highway's Standard Specifications for Highway and Bridge Construction dated 1936.
- All design in accordance with AASHTO Standard Specifications for Highway Bridges, dated 1933. Loading is H20-36 44 truck as modified for National System of Interstate Highways.
- Concrete shall attain a minimum strength of 3000 psi prior to the addition of any superimposed load.
- All concrete to be Class "B" throughout.
- All welding to conform with the American Welding Society Standard Specifications for Welded Highway and Railway Bridges.
- All piles to be 105P42 and driven to a minimum bearing capacity of 37 tons. All piling piles are to be driven to the following minimum elev unless otherwise directed by the engineer:  
 Abut #1 SB elev 371  
 #1 NB elev 369  
 Abut #2 SB elev 362  
 #2 NB elev 317
- Use self-fabricating plates for expansion devices on piers (standard 35-20-54).
- The beam seat elevations have been lowered 1/2 inches to allow for camber.
- Computations for layout information given are based on the arc definition for computing a horizontal curve.

REFERENCE DRAWINGS

- BOREING LOGS, PROFILES, & SECTIONS
  - ABUTMENT DETAILS
  - PIER DETAILS
  - REINFORCING BAR SCHEDULE
  - STANDARD DRAWINGS
  - BRIDGE SHEET 2
  - 3
  - 4
  - 5
  - 20-5A-56
  - 35-45-SUB-37-1000
  - 5B-20-56
  - 30B-30-56
  - 34-10-56
  - 34-20-56
- REFERENCE SHEET FOR VERNON-ROCKINGHAM IR-91-(3) SHEET NO. 10 OF 32

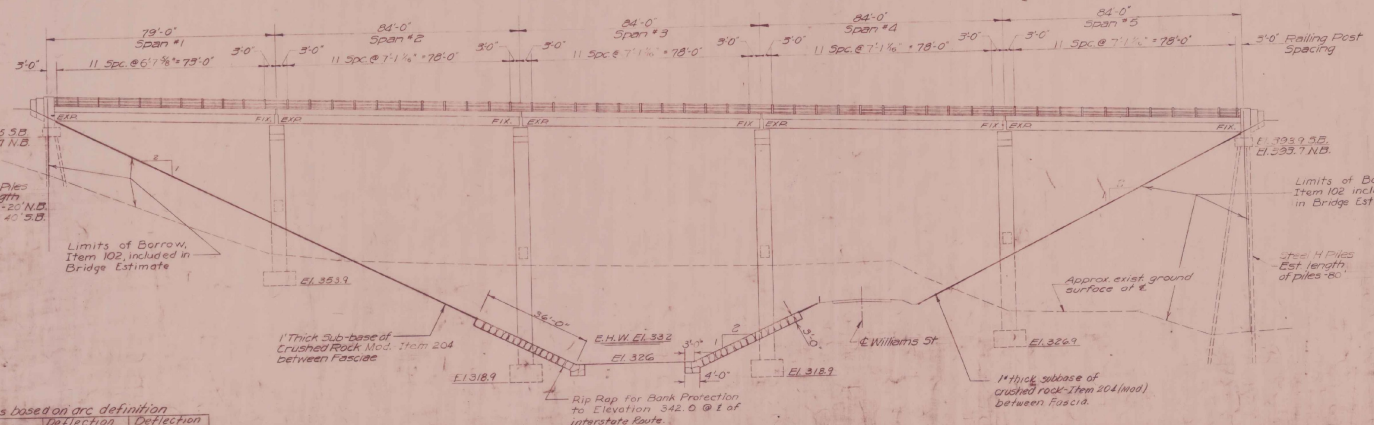

Deflections based on arc definition

	Degree of Curve	Deflection Angle for a 90' Span	Deflection Angle for an 84' Span
Southbound Lane	2°-56'-36" = 2.9433°	1°-12'-31"	1°-17'-06"
Northbound Lane	3°-02'-00" = 3.0333°	1°-09'-45"	1°-14'-10"

BRIDGE 6N4S

VERMONT STATE HIGHWAY DEPARTMENT  
 TOWN OF BRATTLEBORO  
 INTERSTATE ROUTE 1


WHETSTONE BROOK BRIDGE

GENERAL PLAN AND ELEVATION

W. H. WYFARLAND  
 ENGINEER  
 BINGHAMTON, N.Y.

DESIGNED BY W. H. WYFARLAND, DATE 12-28-37  
 DRAWN BY CHARLES W. CHASE, DATE 1-1-38

PROJECT NO. 1-91-1 SHEET 10 OF 49

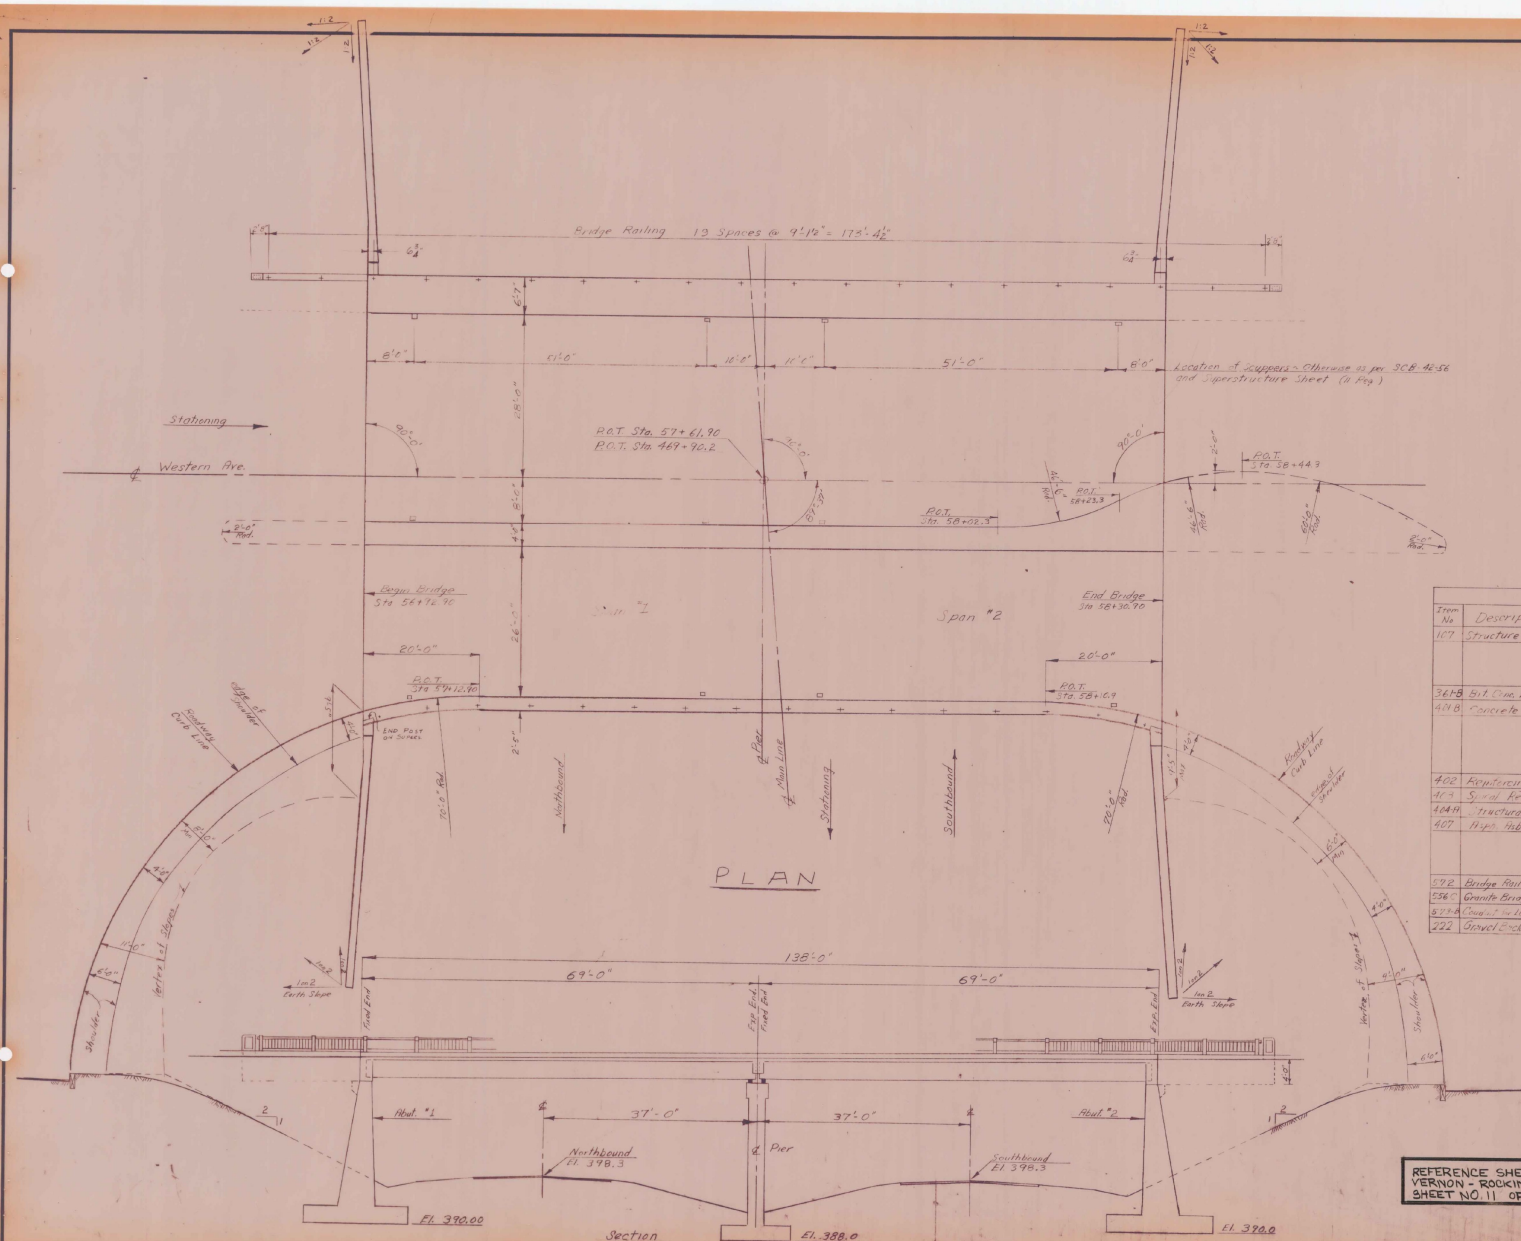

LIST OF WESTERN AVE BRIDGE SHEETS

Estimated Quantities & Plan & Section (1/8 Scale)

Plan (20 Scale)

Profile & Bearings

Abutment Details

Abutment Details (Section)

Pier

Superstructure

Railing Details

Reinforcing Steel Sheet

Standard SB-21-56

Standard SB-20-56

Standard SC-42-56

ESTIMATED QUANTITIES

Item No	Description	Location	Units	Quantities				Total	Price
				Net	Waste	Material	Grand Total		
107	Structure Excavation		CY				2,903	1,174	
	Abut. #1		CY	1220	122	1342		1,936	
	Abut. #2		CY	1220	122	1342		1,936	
	Pier		CY	199	20	219		281	
367B	Bit. Conc. Ret. Bridge	Superstructure	Tons	106	16		122	77	
401B	Concrete Cl. B						2,085	169	
	Abut. #1		CY	739	37	776		761	
	Abut. #2		CY	754	38	792		776	
	Pier		CY	136	7	143		136	
	Super		CY	328	16	344		341	
402	Reinforcing Steel		Lbs				193,370	12,267	
474	Struct. Reinforcement	Super	L.S. (incl. WF - 5,300 Lbs)				1	1	
444H	Structural Steel	Super	Lbs	279,680	6,000		305,680	30,000	
407	1/2" x 1/2" Galv. Coating		Sq. Ft.				67	16	
	Abut. #1		Sq. Ft.	18		18		5	
	Abut. #2		Sq. Ft.	18		18		5	
	Pier		Sq. Ft.	33		33		8	
502	Bridge Railing Aluminum	Super	L.F.	308			308	308	
536	Granite Bridge Curb Spall	Super	L.F.	554			554	110	
579A	Concrete in Landing Section	Abutment	L.S.	1			1	1	
222	Gravel Excavation		CY				0	0	

BRIDGE 7 WESTERN AVE Sta. 9

STATE OF VERMONT  
DEPARTMENT OF HIGHWAYS

TOWN OF BRATTLEBORO

ROUTE No. 91 LOG STA.

Estimated Quantities

Plan & Section

SCALE 1"=10'-0"



SURVEYED BY

DRAWN BY HASSELL CHECKED BY BEMISE


PROJECT No. 1-911 (B)

SHEET 111 OF 496

REFERENCE SHEET FOR  
VERNON - ROCKINGHAM IR-01-1(3)  
SHEET NO. 11 OF 32

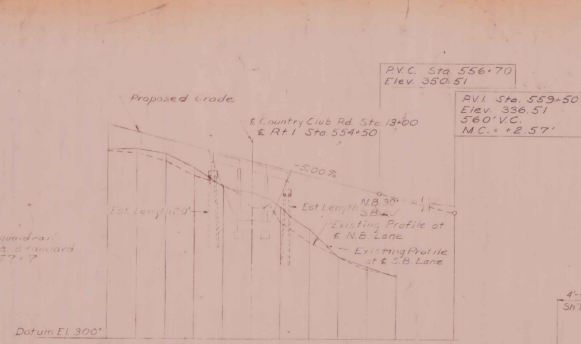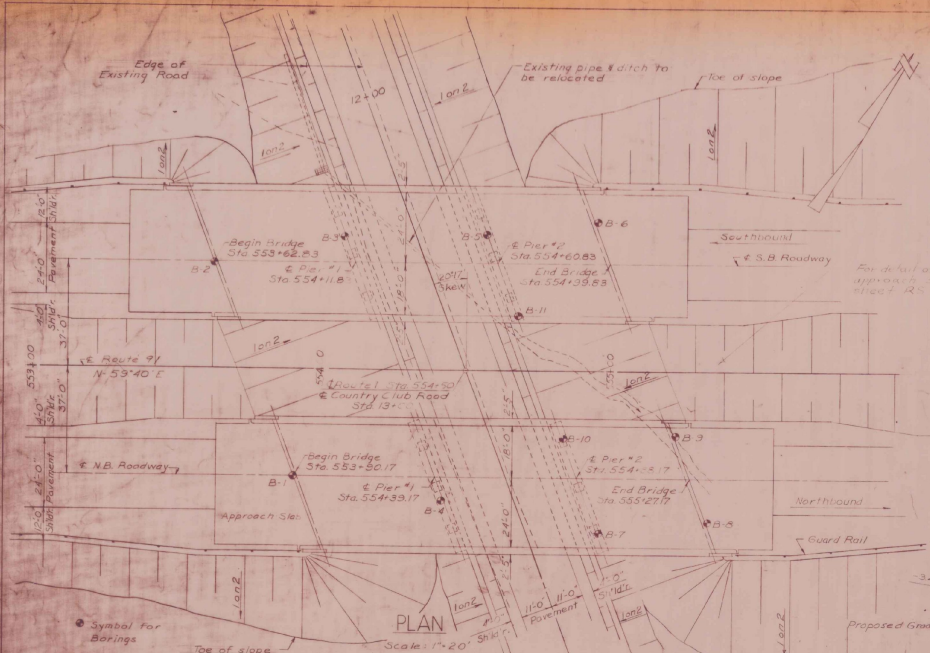

ESTIMATE OF QUANTITIES FOR TWO BRIDGES			
ITEM NO.	DESCRIPTION	UNIT	QUANTITY
102	Borrow	CY	2052
204	Subbase of Crushed Rock Mod.	CY	369
361 B	Bituminous Concrete Pavement Mod.	Ton	235
222	Gravel Backfill	CY	0
401 B	Concrete - Class B' Mod.	CY	1253
402	Reinforcing Steel	Lb.	18,510
403	Spiral Reinforcement	Lb.	6230
404 A	Structural Steel	Lb.	286,700
501	Furnishing Equipment for Driving Piles	L.S.	Reqd.
504	Steel Piling	L.F.	1200
526-C	Granite Bridge Curb	L.F.	608
572	Bridge Rolling	L.F.	530
107	Structure Excavation	CY	514
407	Asphaltic-Asbestos Coating	S.Y.	112
312	Tr. Emulsion for Bridge Floors (Supp. Type)	gal	0

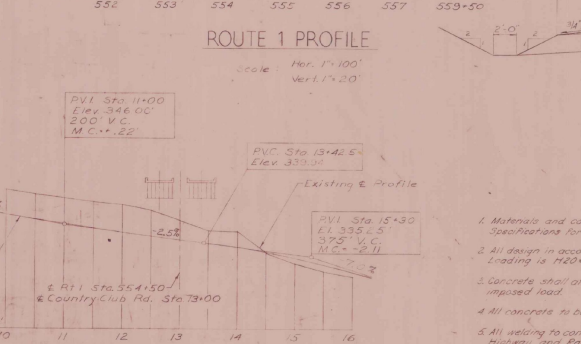

TYPICAL SECTION COUNTRY CLUB ROAD  
Scale: 1" = 5'-0"

GENERAL NOTES

1. Materials and construction shall conform to State of Vermont Department of Highway Standard Specifications for Highway and Bridge Construction, dated 1956.
2. All design in accordance with A.S.H.T.O. Standard Specifications for Highway Bridges, dated 1953. Loading is H20+S16-44 truck as modified for National System of Interstate Highways.
3. Concrete shall attain a minimum strength of 3000 psi prior to the addition of any super-imposed load.
4. All concrete to be Class B' throughout.
5. All welding to conform with the American Welding Society Standard Specifications for Welded Highway and Railway Bridges.
6. All piles to be 125-P42 and driven to a minimum bearing capacity of 37 tons.
7. Bridge seat elev. has been lowered 1/2" to allow for camber in the beams.
8. Standard drawing SB-AS-15" skew-57 shall be modified 1" 1/2" x 20"-17" as per...

FOUNDATION INFORMATION

Obtainees for design purposes only, and the State assumes no responsibility whatsoever for the sufficiency or accuracy of the information shown. Soil conditions may be encountered at any site or at different locations.

Weight of Hammer = 150"  
Drop of Hammer = 24"  
Diameter of Casing = 2 1/2"  
Thickness of Shell = 1/2"



For location of Borings, See 1" = 20'-0" Plan

REFERENCE DRAWINGS

- Abutment Details Pier Details Standard Drawings
- Bridge Sheet E-3 SB-5A-56 SB-AS-15" Skew-57 (Mod) SB-20-56 SCB-42-56 Sk' of 2 Sk' of 2
- 1/4" Thick Subbase of Crushed Rock Mod. Term. C&S between fasciae
- Existing Ground of N.B. Lane
- Country Club Road

ELEVATION

Scale: 1" = 20'

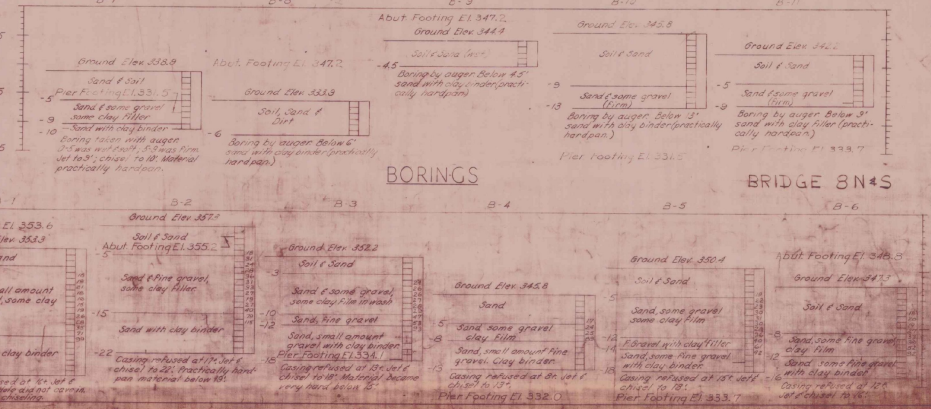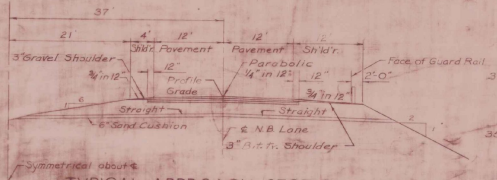

BORINGS

BRIDGE SPANS

VERMONT STATE HIGHWAY DEPARTMENT  
TOWN OF BRATTLEBORO  
INTERSTATE ROUTE 1


COUNTRY CLUB ROAD OVERPASS  
GENERAL PLAN, ELEVATION  
PROFILES & SECTIONS

WILLIAM J. BRAND  
ENGINEER  
BURLINGTON

DESIGNED, DRAWN, CHECKED, CALC. DATE 1957  
DRAWN, CHECKED, CALC. DATE 1957  
DRAWN, CHECKED, CALC. DATE 1957  
PROJECT NO. E-12 SHEET 12 OF 45  
BRIDGE SHEET 12 OF 45






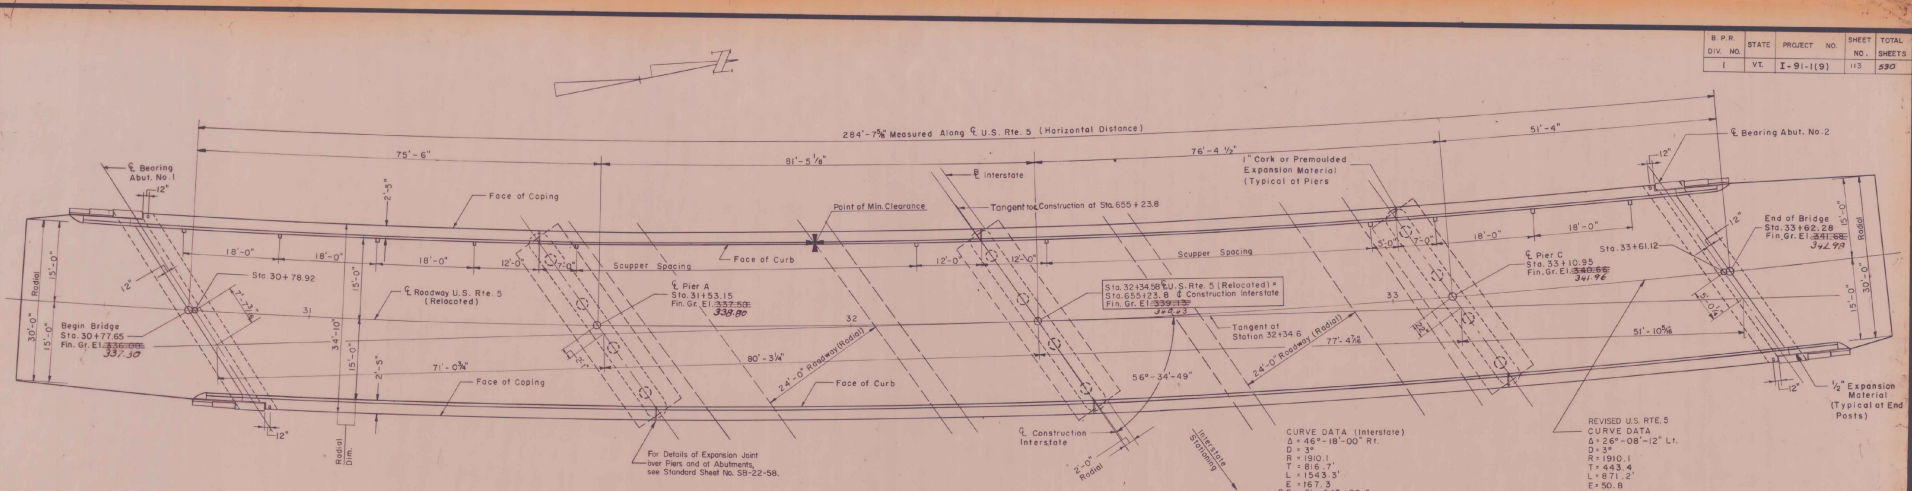

**CURVE DATA (Interstate)**  
 $\Delta = 46^\circ - 18' - 00''$  Rt.  
 $D = 34'$   
 $R = 1910.1'$   
 $T = 916.7'$   
 $L = 1543.3'$   
 $E = 167.9'$   
 $PC = Sta. 643+89.8$   
 $Bank = \frac{1}{2}''$  Per Ft.

**REVISED U.S. RTE. 5 CURVE DATA**  
 $\Delta = 26^\circ - 08' - 12''$  Lt.  
 $D = 34'$   
 $R = 1910.1'$   
 $T = 443.4'$   
 $L = 871.2'$   
 $E = 50.8'$   
 $PC = Sta. 25+13.8$   
 $Bank = \frac{1}{2}''$  Per Ft.

**PLAN**  
 Scale:  $\frac{3}{32}'' = 1'-0''$

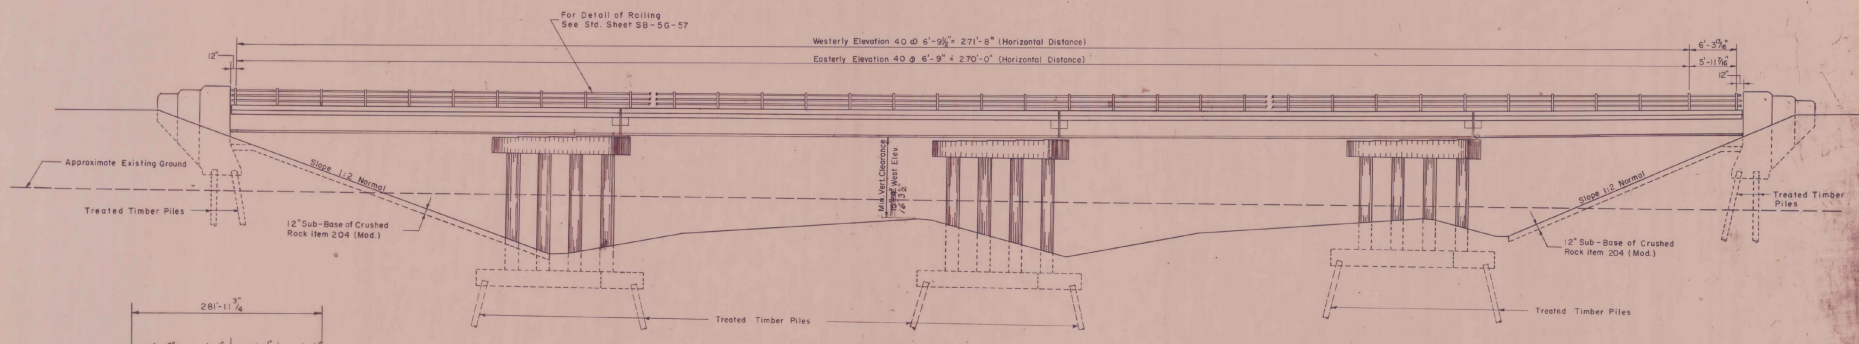


**EASTERLY ELEVATION  
 WESTERY ELEVATION (SIMILAR)**  
 Scale:  $\frac{3}{32}'' = 1'-0''$

- Notes:  
 1. Rolling posts to be set normal to grade.  
 2. Omit set screws at top and rolling panels of expansion joint over piers.  
 3. The Contractor's attention is called to the material which is located under the various pier foundations. Test piles will be required. After driving test piles the engineer shall determine if piles are necessary and the length to be ordered. If piles are called, the findings of design are to be used unless otherwise ordered by the Engineer.

REFERENCE SHEET FOR  
 VERNON - ROCKINGHAM IR-91-1(C)  
 SHEET 15 OF 32

**ESTIMATED QUANTITIES**

ITEM NO.	ITEM	UNIT	ESTIMATED QUANTITIES	
			NET	OVER-RUN TOTAL FINAL
505-C	Granite Bridge Curb (Type 1)	LF	603	603
572	Bridge Rolling	LF	558	558
361-B	Bimimous Concrete Pavement	Ton	133	153


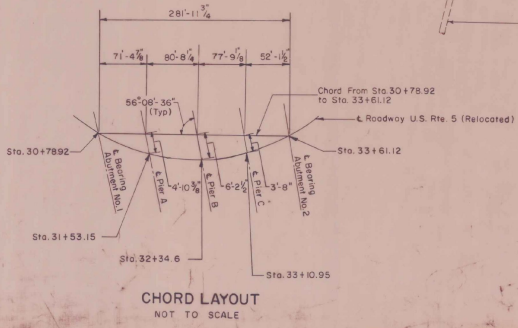


**CHORD LAYOUT**  
 NOT TO SCALE

CONSULTING ENGINEERS  
 CLARKESON ENGINEERING CO. INC.  
 BOSTON MASSACHUSETTS

BRIDGE 12  
 STATE OF VERMONT  
 DEPARTMENT OF HIGHWAYS  
 TOWN OF BRATTLEBORO  
 ROUTE NO. INTERSTATE STA. 655+23.8  
 UNDER U.S. RTE. 5 (RELOCATED)  
 PLAN & ELEVATION  
 SCALE  $\frac{3}{32}'' = 1'-0''$   
 SURVEYED BY  
 DRAWN BY D.W.F. CHECKED BY D.S.B.G.B.  
 PROJECT NO. I-91-1(9)  
 SHEET 113 OF 330

S.P. & DW. NO.	STATE	PROJECT NO.	SHEET NO.	TOTAL SHEETS
I	Vt	I-91-119	143	390

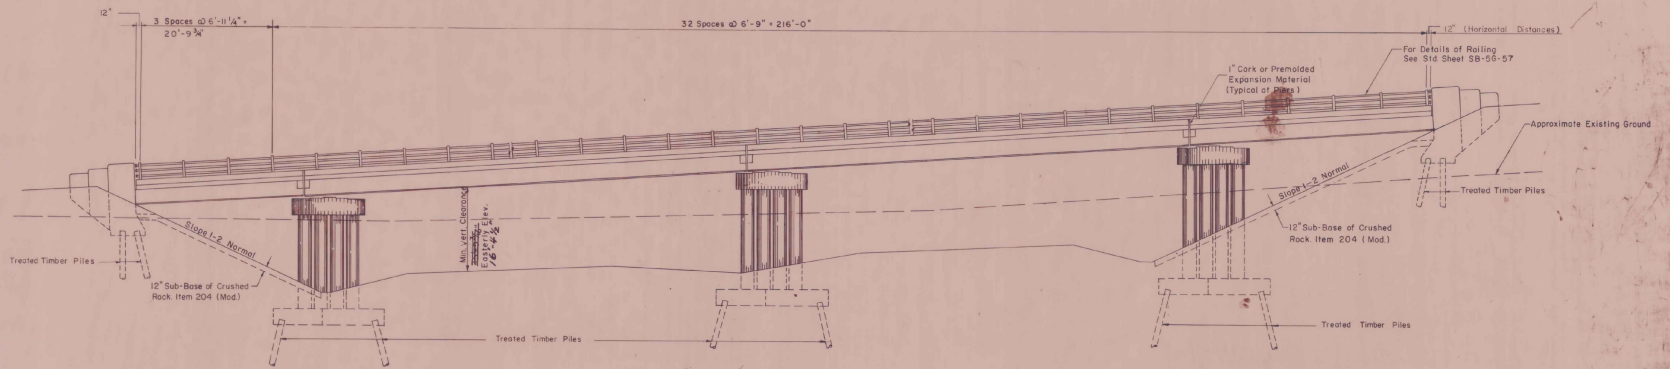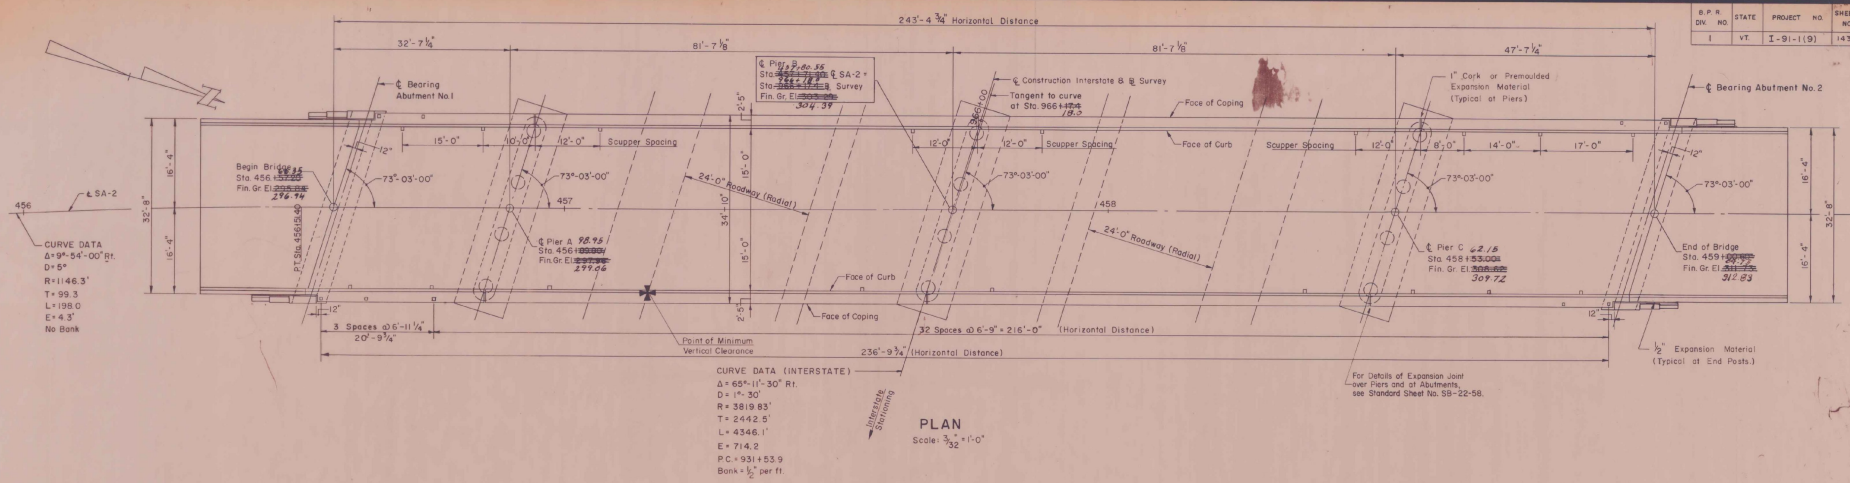

Note: 1. Rolling Posts to be set normal to grade.  
 2. Omit set screws of up-grade end of rolling posts at expansion joints over piers.  
 3. The contractor's attention is called to the material which is located under the various pier foundations. Test piles will be required. After driving test piles the engineer shall determine if piles are necessary and the length to be ordered. If piles are omitted, the footings as designed are to be used unless otherwise ordered by the Engineer.

REFERENCE SHEET FOR  
 VERNON - ROCKFORD HAM IR-91-13  
 SHEET 16 OF 32

ITEM NO.	DESCRIPTION	UNIT	ESTIMATED QUANTITIES			
			NET	OVERRUN	TOTAL	FINAL
556-C	Granite Bridge Curb (Type 1)	LF	+87 <sup>7</sup> / <sub>8</sub>	-	+87 <sup>7</sup> / <sub>8</sub>	530
572	Bridge Rolling	LF	+47 <sup>7</sup> / <sub>8</sub>	-	+47 <sup>7</sup> / <sub>8</sub>	478

CONSULTING ENGINEERS  
 CLARKSON ENGINEERING CO. INC.  
 BOSTON MASSACHUSETTS

BRIDGE 13

STATE OF VERMONT  
 DEPARTMENT OF HIGHWAYS


TOWN OF DUMMERSTON  
 ROUTE NO. INTERSTATE STA. 966+174.4  
 UNDER SA-2 (RELOCATED)

PLAN & ELEVATION  
 SCALE  $\frac{3}{32} = 1'-0''$

SURVEYED BY  
 DRAWN BY H.B.C. CHECKED BY D.S.B.C.B.

PROJECT No. I-91-119  
 SHEET 143 OF 390

S. P. R.	STATE	PROJECT NO.	SHEET NO.	TOTAL SHEETS
VT.	VT.	I 91 - (110)	79	328

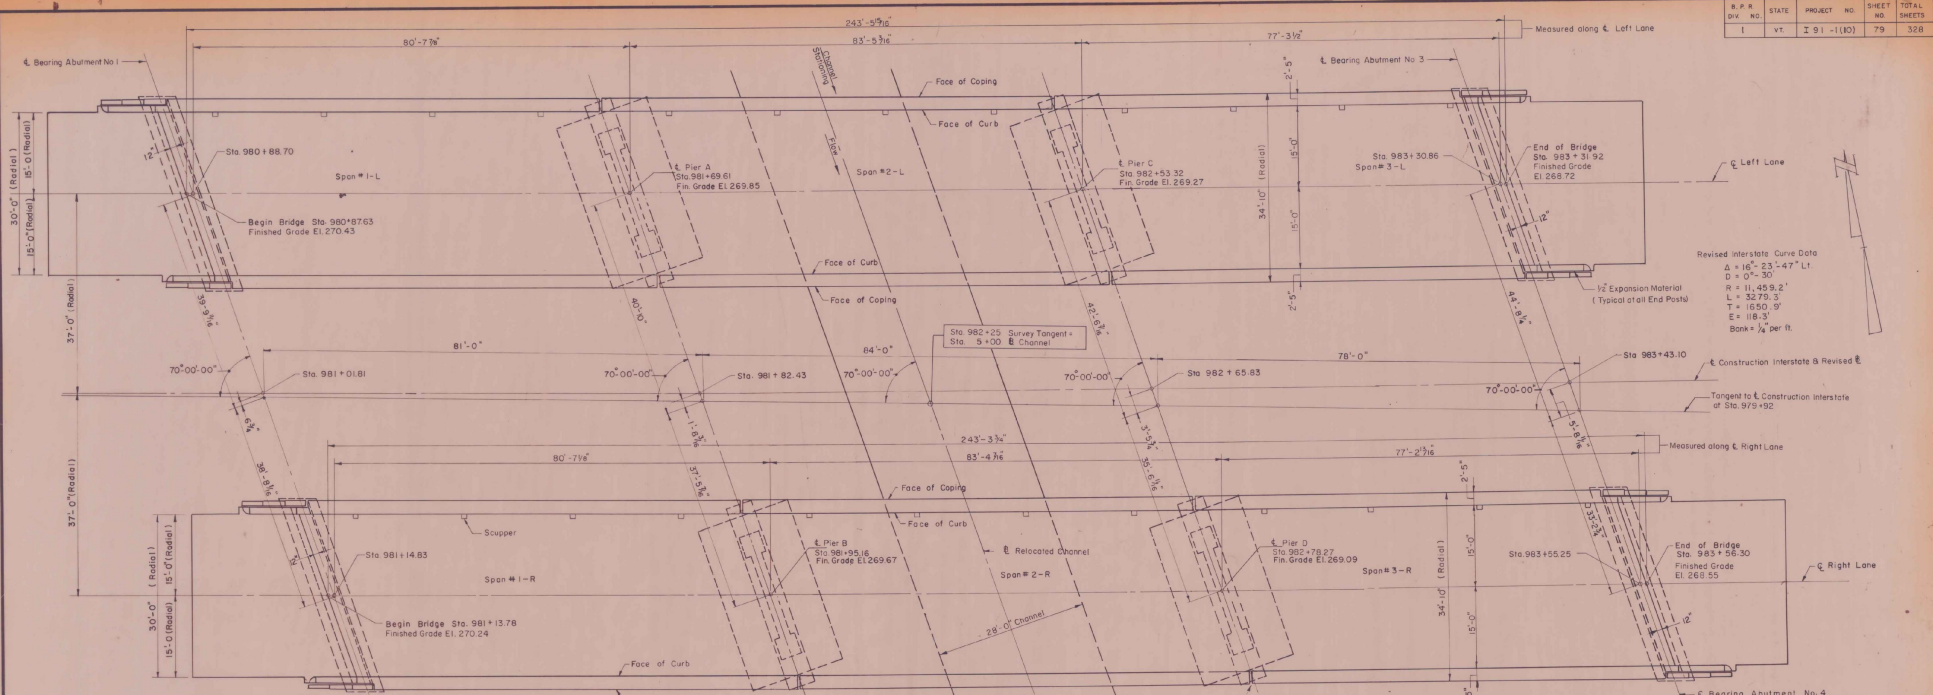

PLAN  
Scale: 1/32" = 1'-0"

Revised Interstate Curve Data  
 $\Delta = 16^{\circ} 23' 47''$  Lt.  
 $D = 0^{\circ} 30'$   
 $R = 11,499.2'$   
 $L = 3279.3'$   
 $T = 650.3'$   
 $E = 118.3'$   
 $Bank = 1/4$  per ft.

- 1. Rolling posts to be set normal to grade.
- 2. Omit set screws at high end of rolling panels of expansion joints over piers.
- 3. All Stations refer to  $\bar{C}$  Construction Interstate excluding channel station.
- 4. For scupper layout, see Framing Plan Sheet 85.
- 5. For details of railing, see Standard Sheet SB-56-57.
- 6. For Quantity Estimate see Sheet 86.
- 7. All dimensions are horizontal dimensions.
- 8. For chord layout see Sheet 85.

REFERENCE SHEET FOR  
VERNON-ROCKINGHAM I.R. 91(10)  
SHEET 17 OF 32


BRIDGE 14N4S  
PLAN AND ELEVATION

STATE OF VERMONT  
DEPARTMENT OF HIGHWAYS  
INTERSTATE PROJECT in the town of  
PUTNEY

INTERSTATE OVER STA. 982+25  
SACKETTS BROOK STA. 5+00


THE CLARKESON ENGINEERS CO., INC.  
CONSULTING ENGINEERS  
BOSTON MASSACHUSETTS  
DESIGNED BY: [Signature] CHECKED AND DRAWN: [Signature] SCALE AS NOTED  
DRAWN BY: A.L.E. IN CHARGE: J.V.M. DATE: 10-25-57

PROJECT NO. I 91 - (110) SHEET 81 OF 328 CONTRACT NO. 1


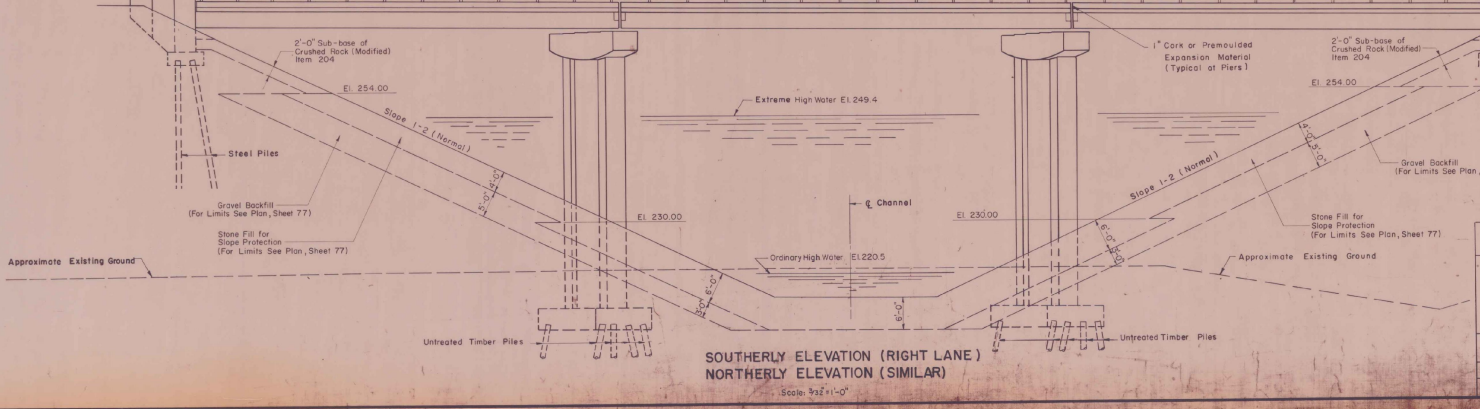


SOUTHERLY ELEVATION (RIGHT LANE)  
NORTHERLY ELEVATION (SIMILAR)  
Scale: 1/32" = 1'-0"

S. F. R. DIV. NO.	STATE	PROJECT NO.	SHEET NO.	TOTAL SHEETS
1	VT	191-1(10)	97	328

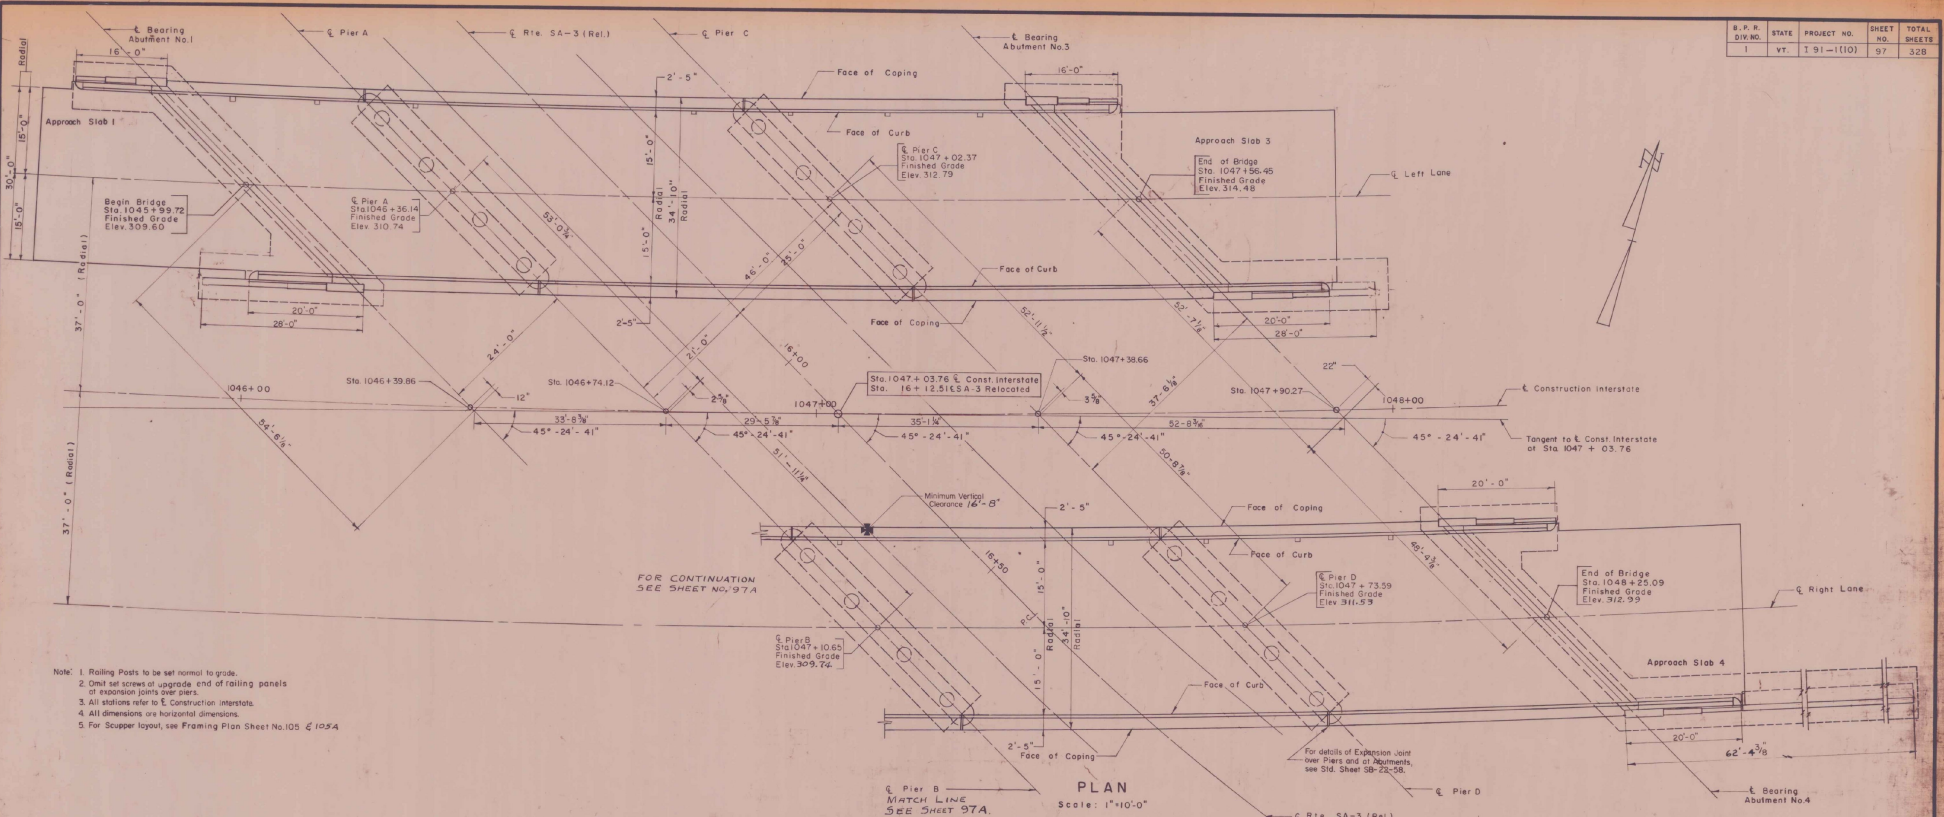

- Note: 1. Rolling Posts to be set normal to grade.  
 2. Check set screws of upgrade end of railing panels at transition points over piers.  
 3. All stations refer to Construction Interstate.  
 4. All dimensions are horizontal dimensions.  
 5. For Scupper layout, see Framing Plan Sheet No. 105 & 105A.

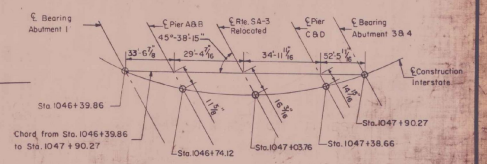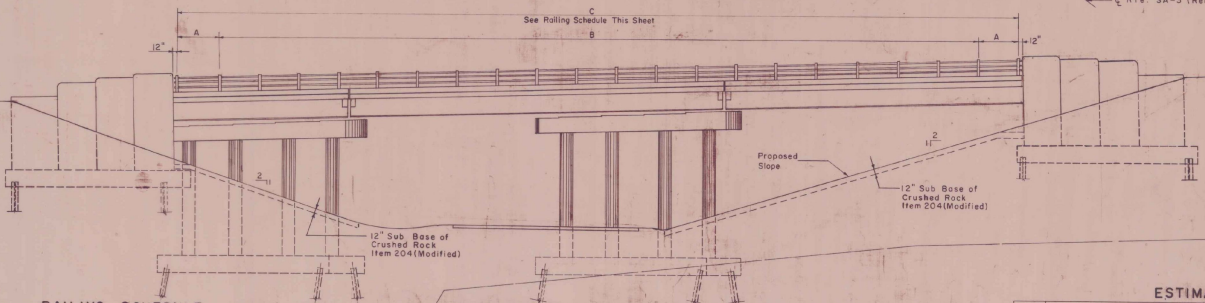

**BRIDGE 15 N4S**  
**PLAN AND ELEVATION**  
 STATE OF VERMONT  
 DEPARTMENT OF HIGHWAYS

REFERENCE SHEET FOR  
 VERNON - ROCKHAMPTON RR-9-H-103  
 SHEET 18 OF 32







		RAILING SCHEDULE		
		A	B	C
LEFT LANE	NORTH	7'-1"	19 @ 7'-0" = 133'-0"	147'-2"
	SOUTH	6'-11 3/4"	19 @ 6'-11 3/4" = 131'-5"	145'-4"
RIGHT LANE	NORTH	7'-0 1/2"	40 @ 7'-0 1/2" = 281'-6"	295'-0"
	SOUTH	6'-11 1/2"	40 @ 6'-11 1/2" = 278'-9"	292'-7 1/2"

ESTIMATED QUANTITIES				
ITEM NO.	DESCRIPTION	UNIT	NET	OVERRIN TOTAL FINAL
556-C	Granite Bridge Curb (Type 1)	L.F.	1044.8	1044.8
572	Bridge Railing	L.F.	687.7	687.7
503	Splices for Steel Piling	SP	84	84

INTERSTATE PROJECT in the town of  
**PUTNEY**  
 INTERSTATE OVER STA. 1047+03.76  
 SA-3 (REL) OVER STA. 16+12.51

THE CLARKSON ENGINEERING CO., INC.  
 CONSULTING ENGINEERS  
 200 STATE STREET, VERMONT, MASSACHUSETTS

DRAWN BY J.E.R. & J.S. CHECKED BY R.A.K. SCALE AS NOTED  
 PROJECT NO. 191-1(10) SHEET 97 OF 328 CONTRACT NO. 1

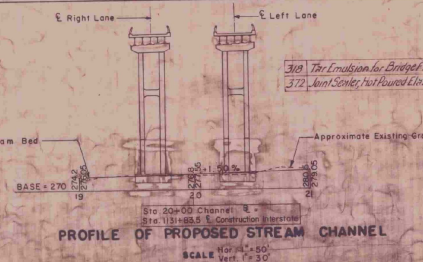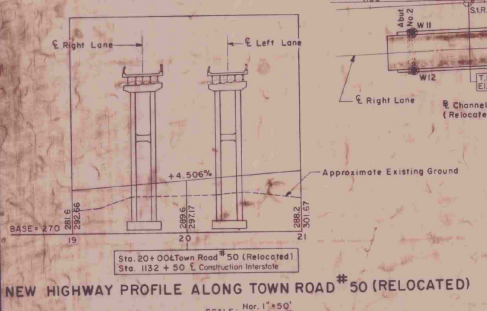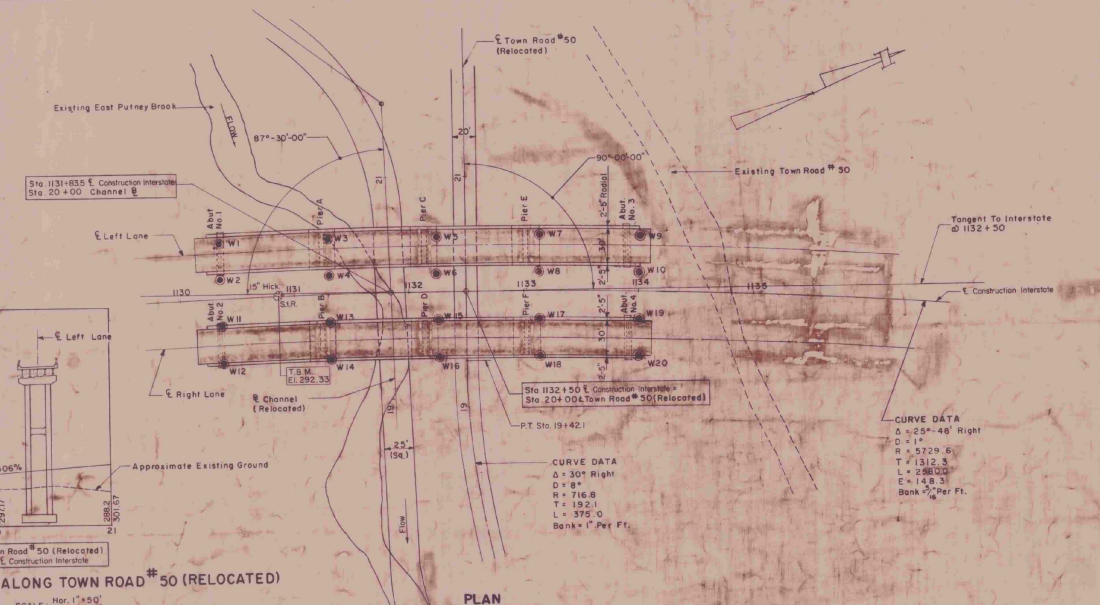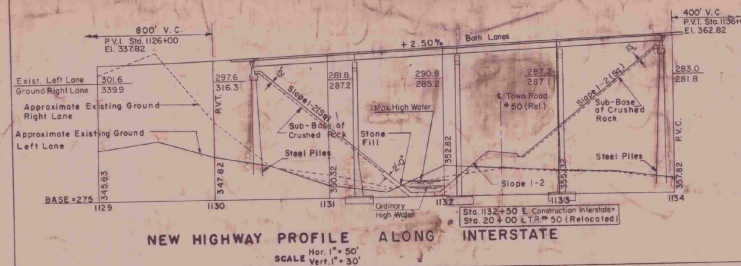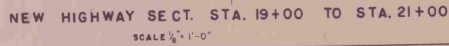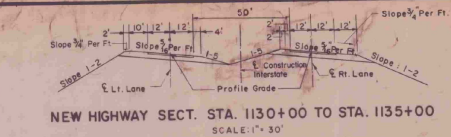

HIGHWAY NO.	191 N. Sec. 1	NAME OF HIGHWAY	Interstate	S. No.	STATE	PROJECT NO.	SHEET	TOTAL
STRUCTURE NO.		COUNTY	Windsor	TOWN	Putney	1	10	328
PROJECT NO.	191-110	LOCATION	Sta. 1132+50					

- ### EXISTING STRUCTURE
- RATED LOADING OF EXISTING STRUCTURE - None
  - TYPE OF EXISTING STRUCTURE -
  - UNDERCLEARANCE ELEVATION OF EXISTING STRUCTURE - COST OF REMOVAL
  - WHAT DISPOSITION SHOULD BE MADE OF EXISTING STRUCTURE -
  - SHOULD EXISTING STRUCTURE BE USED TO MAINTAIN TRAFFIC DURING CONSTRUCTION OF NEW STRUCTURE -
  - SHOULD NEW TEMPORARY STRUCTURE BE BUILT -
  - ORDINARY HIGH WATER SURFACE ELEV. AT EXISTING STRUCTURE - WATERWAY TO ORDINARY H.W.
  - EXTREME HIGH WATER AT EXISTING STRUCTURE - WATERWAY TO EXTREME H.W.
  - SPAN OF EXISTING BRIDGE UPSTREAM - WATERWAY TO EXTREME H.W.
  - SPAN OF EXISTING BRIDGE DOWNSTREAM - WATERWAY TO EXTREME H.W.
  - TYPE OF FOUNDATION UNDER EXISTING ABUTMENTS -
  - DOES ALL WATER AT FLOOD ELEVATION PASS THROUGH EXISTING STRUCTURE -
  - IF NOT AT WHAT ELEVATION IS RELIEF AFFORDED -
  - ADDITIONAL WATERWAY AREA PROVIDED -
- ### NEW STRUCTURE
- RECOMMENDED TYPE OF STRUCTURE - 4 Span Composite Steel Stringer Bridge
  - RECOMMENDED CLEAR SPAN OR SPANS - 60'-00"-80'-00"
  - MEASURED PARALLEL TO & NEW HIGHWAY -
  - MEASURED AT RIGHT ANGLES TO & STREAM -
  - ARE THERE OBJECTIONS TO A PIER IN THE STREAM, ANSWER YES OR NO - YES
  - ORDINARY HIGH WATER ELEVATION AT NEW STRUCTURE - 4' Above Bottom
  - EXTREME HIGH WATER ELEVATION AT NEW STRUCTURE - 6' Above Bottom
  - IS ALL WATER INTENDED TO PASS THROUGH NEW STRUCTURE? -
  - DOES STREAM REACH ITS MAXIMUM HIGH WATER ELEVATION RAPIDLY? No. IS ORDINARY RISE RAPID? -
  - LOW WATER ELEVATION AT NEW STRUCTURE - 0' 5" Above Bottom
  - DRAINAGE AREA IN ACRES ABOVE STRUCTURE 8,390 CHARACTER OF TERRAINE -
  - IS STREAM EVER DRY? - No.
  - VELOCITY OF STREAM AT HIGH WATER STAGE 10.3 F.P.S. ESTIMATED DISCHARGE -
  - AREA FULL OPENING - AREA BELOW ORDINARY H.W. 234
  - CHARACTER OF SCOUR - DRIFT Light ICE Light
  - ESTIMATED DRAINAGE AREA ABOVE NATURAL OR ARTIFICIAL STORAGE -
  - VERTICAL CLEARANCE ABOVE FLOOD ELEVATION -
  - ARE SIDEWALKS REQUIRED, IF SO ON WHAT SIDE - BOTH SIDES
  - RECOMMENDED TYPE OF PAVEMENT - 2 Bituminous Conc. Pavement For Bridge Floors
  - TRAFFIC TO BE MAINTAINED UNDER ITEM NO. - None ONE OR TWO WAYS PROBABLE COST -
  - PROBABLE COST OF CLEARING AND GRUBBING STREAM CHANNEL AT STRUCTURE SITE -
  - SHOULD PROVISIONS BE MADE FOR PUBLIC UTILITIES? - No.
  - ESTIMATED ALLOWABLE LOAD ON FOUNDATIONS - SHOULD PILES BE USED? - EST. LATH

- ### FOUNDATION INFORMATION
- OBTAINED FOR DESIGN PURPOSES ONLY, AND THE STATE ASSUMES NO RESPONSIBILITY WHATSOEVER FOR THE SUFFICIENCY OR ACCURACY OF THE INFORMATION SHOWN. BOULDER MAY BE ENCOUNTERED AT ANY PIER OR ABUTMENT LOCATION. For Boring Logs, see sheet 111.

- ### GENERAL NOTES
- DESIGN SPECIFICATIONS: AASHTO 1957 Edition and as modified by Vermont Dept. of Highways.
- LIVE LOAD: H-20-S16-A4 and Military Loading
- DESIGN STRESSES: Structural steel 16" 18,000 psi; Reinforcing steel 16" 20,000 psi; Concrete 16" 1,200 psi; Lumber 16" 3,000 psi.
- CLEARANCES: Vertical as shown on drawings; Vertical: 60'-0" Clear Over Town Road #50
- FOUNDATION: Piers - Spigot Foundations; Abutments - Steel Piles

REFERENCE SHEET FOR VERNON - ROCKINGHAM IR-91-1(3) SHEET 19 OF 32

### SUMMARY OF QUANTITIES

ITEM NO.	DESCRIPTION	UNIT	NET	OVER-RUN	TOTAL	FINAL
107	Structural Excavation	C.Y.	639.8	663.6	1,303.4	1,303.4
204	Sub-Bank of Crushed Rock (Moist)	C.Y.	408.0	48.0	456.0	456.0
222	Gravel Backfill	C.Y.	408.0	48.0	456.0	456.0
361(B)	Bit. Coat Pavement	Sq. Yds.	2,424.0	0.0	2,424.0	2,424.0
404(B)	Concrete Class B (Moist)	C.Y.	309.0	0.0	309.0	309.0
402	Reinforcing Steel	LS	17.0	0.0	17.0	17.0
403	General Reinforcement (12,000)	LS	17.0	0.0	17.0	17.0
404A	Structural Steel	Lbs.	240,000.0	94,300.0	334,300.0	334,300.0
407	Asphaltic-Albestos Coating	S.Y.	424.0	0.0	424.0	424.0
50A	Steel Piling	L.F.	468.0	0.0	468.0	468.0
522	Stone Fills for Slope Protection	C.Y.	424.0	0.0	424.0	424.0
582	Concrete Bridge Curb (Type 1)	L.F.	468.0	0.0	468.0	468.0
572	Bridge Railings	L.F.	468.0	0.0	468.0	468.0
501	Flashings Equip. for Working Piles	Required	0.0	0.0	0.0	0.0
503	Splices for Steel Piling	Eq.	0.0	0.0	0.0	0.0

### LIST OF SHEETS

SHEET NO.	DESCRIPTION
110	GENERAL PLAN
111	BORINGS
112	PLAN & ELEVATION
113	ABUTMENTS
114	WINGWALLS & APPROACH SLABS
115	PIERS A & B
116	PIERS C & D
117	PIERS E & F
118	STRUCTURAL STEEL PLAN
119	STRUCTURAL STEEL DETAILS
120	REINFORCING SCHEDULE
120A	REINFORCING SCHEDULE
120B	REINFORCING SCHEDULE
120C	REINFORCING SCHEDULE
120D	REINFORCING SCHEDULE
120E	REINFORCING SCHEDULE
120F	REINFORCING SCHEDULE
120G	REINFORCING SCHEDULE
120H	REINFORCING SCHEDULE
120I	REINFORCING SCHEDULE
120J	REINFORCING SCHEDULE
120K	REINFORCING SCHEDULE
120L	REINFORCING SCHEDULE
120M	REINFORCING SCHEDULE
120N	REINFORCING SCHEDULE
120O	REINFORCING SCHEDULE
120P	REINFORCING SCHEDULE
120Q	REINFORCING SCHEDULE
120R	REINFORCING SCHEDULE
120S	REINFORCING SCHEDULE
120T	REINFORCING SCHEDULE
120U	REINFORCING SCHEDULE
120V	REINFORCING SCHEDULE
120W	REINFORCING SCHEDULE
120X	REINFORCING SCHEDULE
120Y	REINFORCING SCHEDULE
120Z	REINFORCING SCHEDULE

BRIDGE 16N4S  
GENERAL PLAN  
STATE OF VERMONT  
DEPARTMENT OF HIGHWAYS

INTERSTATE PROJECT in the town of  
PUTNEY  
INTERSTATE OVER STA. 1132+50  
TOWN ROAD #50 (REL.) STA. 20+00


DESIGNED BY: J. H. CLARKSON  
CHECKED BY: R. K. CLARKSON  
DATE: 1-15-58

THE CLARKSON ENGINEERING CO. INC.  
CONSULTING ENGINEERS

SCALE: AS SHOWN  
SHEET NO. 10 OF 328



S.P.R. NO.	STATE	PROJECT NO.	SHEET NO.	TOTAL SHEETS
1	VT.	I 91-1(11)	192	555

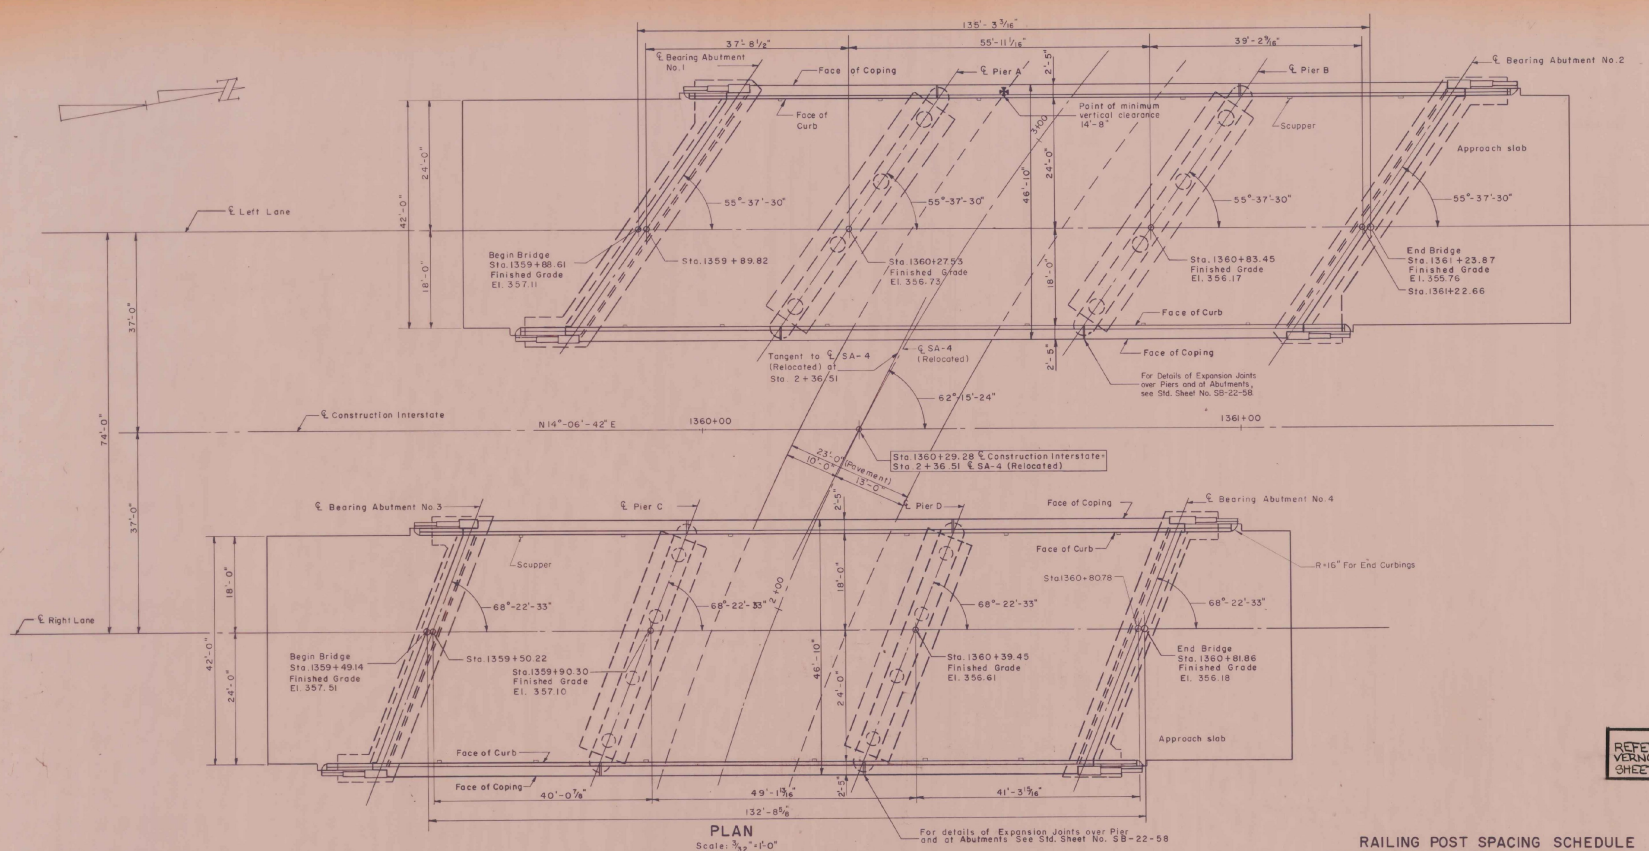


PLAN  
Scale: 3/32" = 1'-0"

RAILING POST SPACING SCHEDULE

	A	B	C	D
LEFT LANE	7'-2 1/8"	16 @ 7'-1" = 113'-4"	7'-2 1/8"	127'-8 1/8"
RIGHT LANE	6'-11 7/8"	16 @ 7'-0" = 112'-0"	6'-11 7/8"	125'-11 1/8"

- Notes:
1. Railing posts to be set normal to grade. Omit set screw at high end of railing panel or expansion joints over pier.
  2. All stationing refers to Construction Interstate excluding stationing along SA-4 (Relocated).
  3. For scupper layout see Framing Plan Sheet No. 198.
  4. For railing details see standard Sheet SB-56-57 (1B.2).
  5. All dimensions are horizontal dimensions.
  6. For Bridge Marker See Drawing SB-20-56 (Detail A).

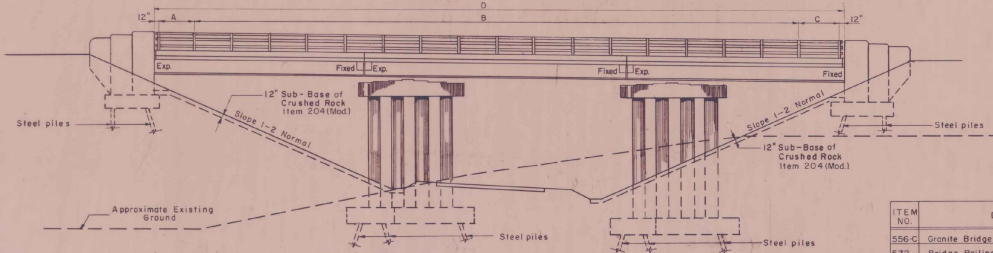

EASTERLY ELEVATION  
WESTERLY ELEVATION (SIMILAR)  
Scale: 3/32" = 1'-0"



ESTIMATED QUANTITIES

ITEM NO.	DESCRIPTION	UNIT	NET	OVER-RUN	TOTAL	FINAL
556-C	Granite Bridge Curb-Type I - Left Lane	L.F.	309	309	309	309
572	Bridge Railing - Left Lane	L.F.	255	255	255	255
556-C	Granite Bridge Curb-Type I - Right Lane	L.F.	306	306	306	306
572	Bridge Railing - Right Lane	L.F.	256	256	256	256

REFERENCE SHEET FOR  
VERNON-ROCKINGHAM IR-91-1(3)  
SHEET 21 OF 32

BRIDGE 18N4S  
PLAN AND ELEVATION  
STATE OF VERMONT  
DEPARTMENT OF HIGHWAYS  
INTERSTATE PROJECT in the town of  
WESTMINSTER  
INTERSTATE OVER STA. 1360+29.28  
SA-4(RELOCATED) STA. 2+36.51  
THE CLARKSON ENGINEERING CO., INC.  
CONSULTING ENGINEERS  
BOSTON MASSACHUSETTS  
DRAWN BY R.J.F. CHECKED BY J.M.B. SCALE AS NOTED  
PROJECT NO. I 91-1(11) SHEET 192 OF 555

D.P.R. Div. No.	STATE	PROJECT NO.	SHEET NO.	TOTAL SHEETS
1	VT.	1 91-1 (17)	211	555

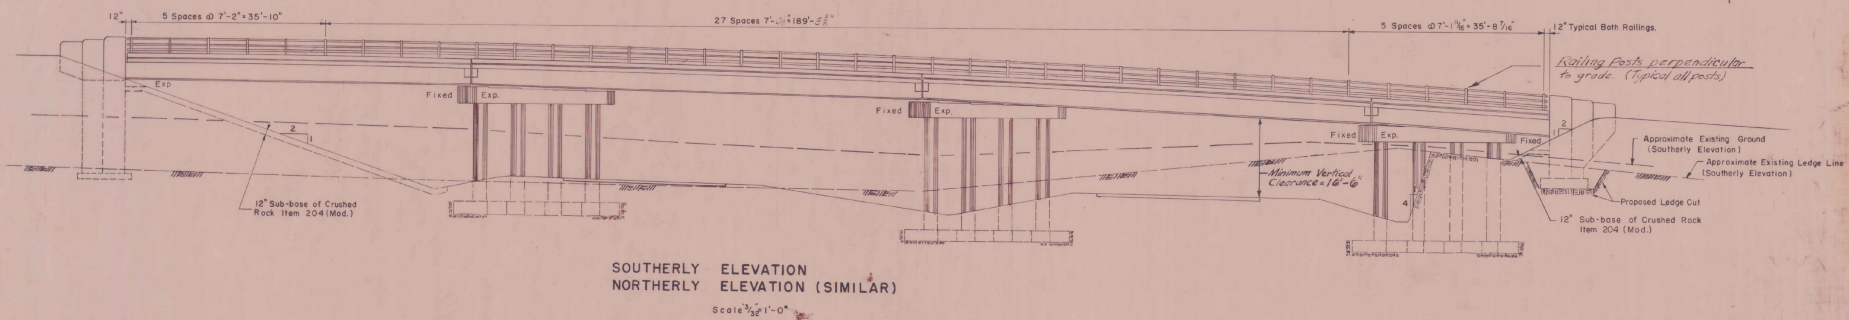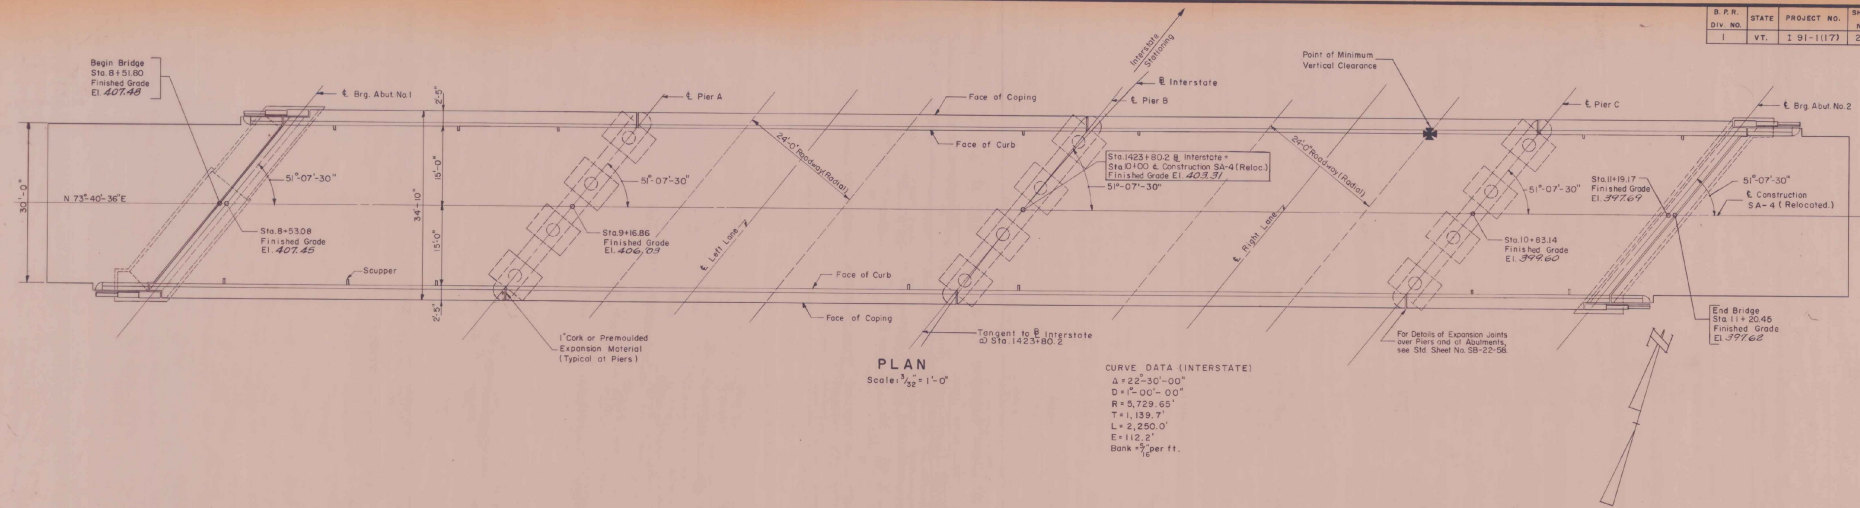

**ESTIMATED QUANTITIES**


ITEM NO.	DESCRIPTION	UNIT	NET	OVER-RUN	TOTAL	FINAL
556-C	Granite Bridge Curb (Mod.)	L.F.	470	-	470	377
572	Bridge Railing	L.F.	525	-	525	325

- Notes:
1. Railing posts to be set normal to grade.
  2. Omit set screws of one end of railing panel at expansion joints over piers.
  3. All dimensions are horizontal dimensions.
  4. For scupper spacing see Sheet 215.
  5. For Bridge Marker see Drawing SB-20-56 (Detail A).
  6. For Details of Railing see standard Sheet SB-50-60 (1 & 2).

REFERENCE SHEET FOR  
 VERNON-ROCKINGHAM PR-91-(3)  
 SHEET 22 OF 32

**BRIDGE 17**  
**STAGE I CONSTRUCTION**  
**PLAN AND ELEVATION**  
**STATE OF VERMONT**  
**DEPARTMENT OF HIGHWAYS**  
 INTERSTATE PROJECT in the town of  
**WESTMINSTER**  
 INTERSTATE UNDER STA. 1423+80.2  
**SA-4 (RELOCATED) STA. 10+00**  
 THE CLARKSON ENGINEERING CO. INC.  
 CONSULTING ENGINEERS WASHINGTON  
 BOSTON  
 SURVEYED BY: [ ] CHECKED BY: D. BRUB [ ] SCALE AS NOTED  
 DRAWN BY: A. B. C. [ ] IN CHARGE: J. V. A. [ ] DATE: [ ]  
 PROJECT NO. 1 91-1 (17) SHEET 37 OF 129  
 CONTRACT NO. 1 37

B.P.R. DIV. NO.	STATE	PROJECT NO.	SHEET NO.	TOTAL SHEETS
1	VT.	191-101(23)		

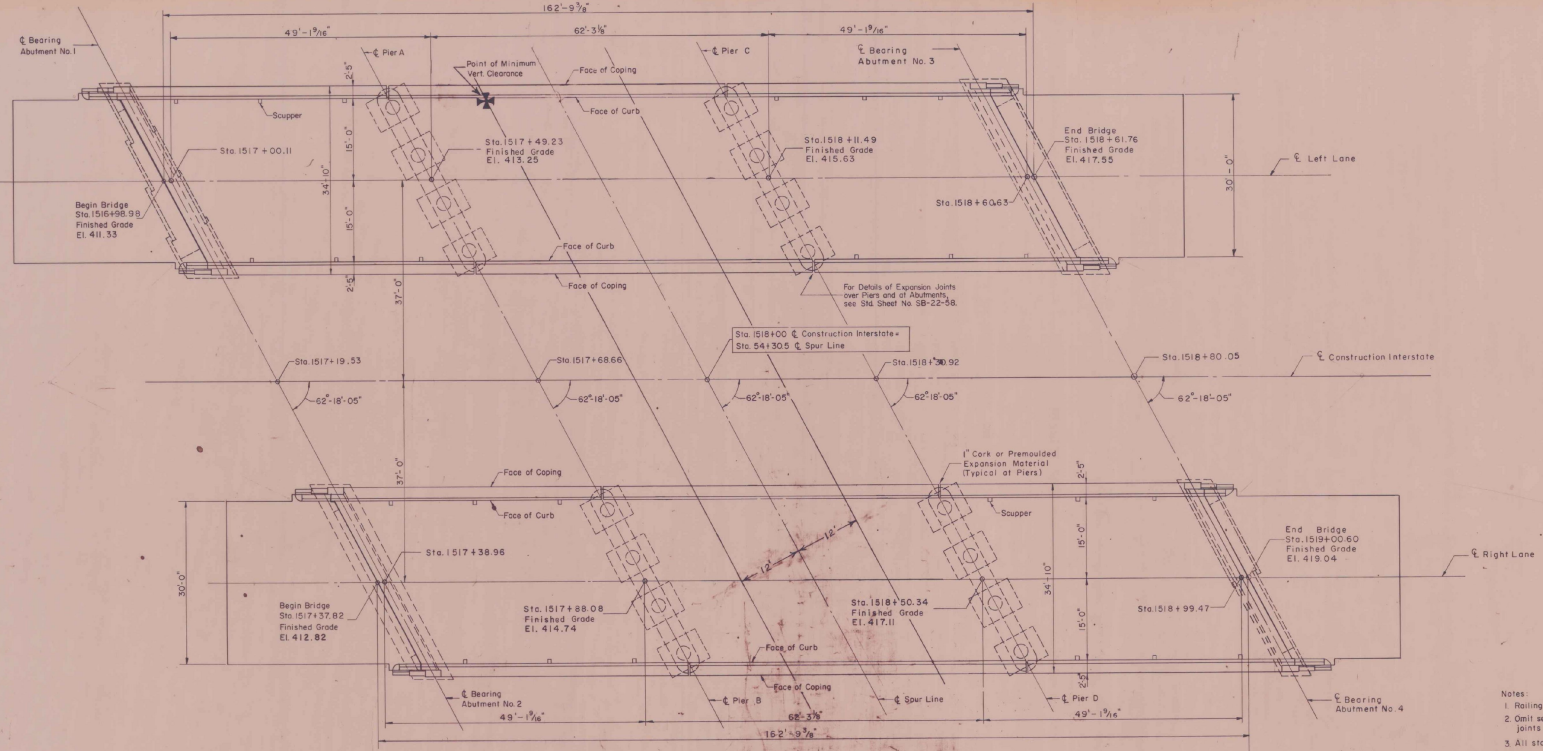


PLAN  
Scale: 1/32" = 1'-0"

- Notes:
- Rolling Posts to be set normal to grade.
  - Omit set screws at one end of rolling panels at expansion joints over piers.
  - All stations refer to  $\nabla$  Construction Interstate.
  - All dimensions are horizontal dimensions.
  - For Scupper layout see Framing Plan Sheet No. 243.
  - For Details of Rolling see, Standard Sheet SB-50-60(182).

REFERENCE SHEET FOR  
VERNON - ROCKINGHAM IR-91-(3)  
SHEET 23 OF 32

ESTIMATED QUANTITIES

ITEM NO.	DESCRIPTION	UNIT	NET	OVER-RUN	TOTAL	FINAL
556-C	Shim Bridge Curb (WOOD)	L.F.	203		203	211
572	Bridge Rolling	L.F.	629		629	629

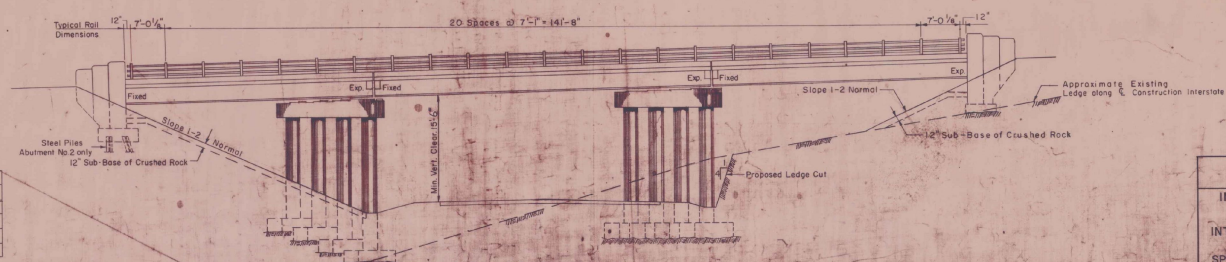

EASTERLY ELEVATION RIGHT LANE  
WESTERLY ELEVATION (SIMILAR EXCEPT AS NOTED)  
Scale: 1/32" = 1'-0"


BRIDGE 30 N4S  
STAGE 1 CONSTRUCTION

PLAN AND ELEVATION  
STATE OF VERMONT  
DEPARTMENT OF HIGHWAYS  
INTERSTATE PROJECT IN THE TOWN OF  
WESTMINSTER

INTERSTATE STA 1518+00  
OVER STA 54+30.5

SPUR LINE

THE CLARKSON ENGINEERING CO., INC.  
CONSULTING ENGINEERS  
BOSTON MASSACHUSETTS  
DRAWN BY H.B.C. CHECKED BY G.B.S. SCALE AS NOTED  
PROJECT NO. 191-101(23) SHEET 23 OF 192

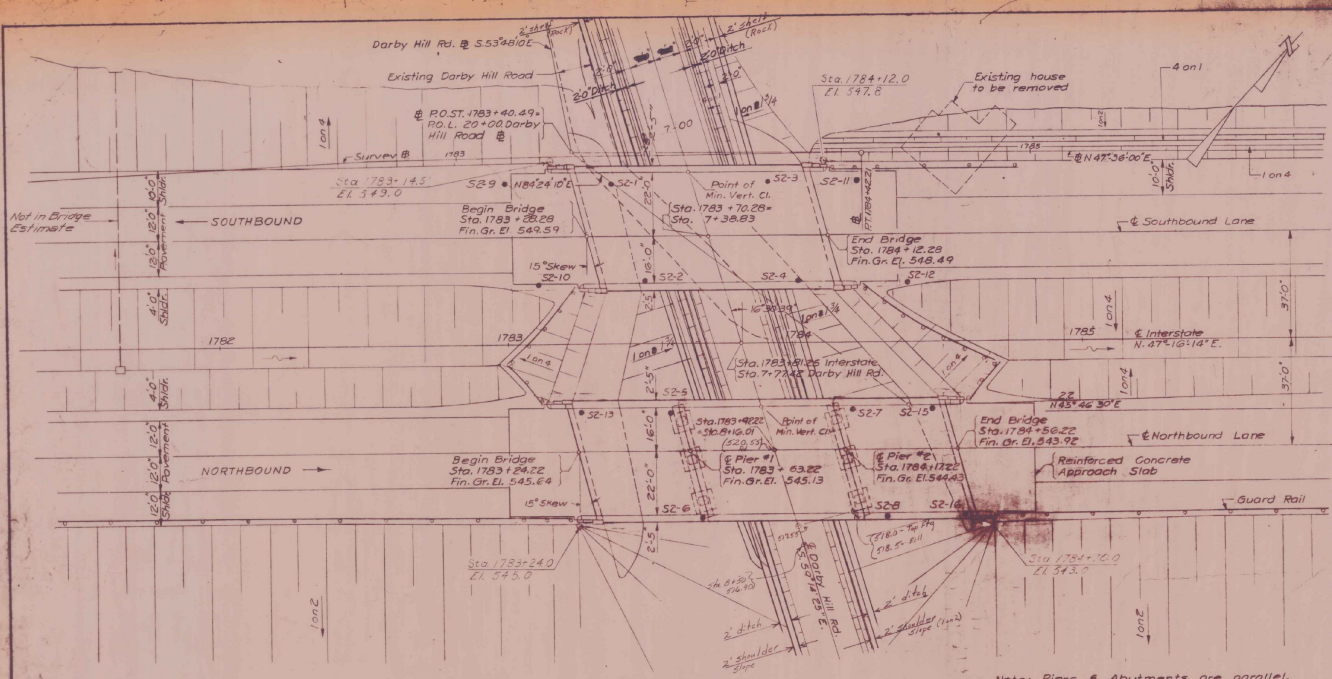

PLAN  
Scale: 1" = 20'

NOTE:

Where granular material is indicated around bridge abutments rock fill, if available, shall be substituted except in the area where piles are to be driven. Wherever materials from excavation are used in embankments requiring granular material they shall be paid for as indicated under Item 101, Excavation.

Note: Piers & Abutments are parallel.  
• Boring Symbol.

The embankment for a distance of 100 ft from approach slabs shall be of granular material conforming to the specification for granular borrow - Item 102-A.

SUMMARY OF QUANTITIES

ITEM NO.	ITEM	UNIT	QUANTITIES @	
			S.B. BRIDGE	N.B. BRIDGE
107	Structure Excavation	c.y.	269	317
204	Sub-base of Crushed Rock (Mod. under Structures)	c.y.	74	161
222	Gravel Backfill	c.y.	90	100
318	Tar Emulsion for Bridge Floors	gal.	227	306
321-E	Bituminous Concrete Pavement	sq. yd.	72	98
401-B	Concrete Class B, Mod.	cu. yd.	529	535
402	Reinforcing Steel	lb.	43,492	70,542
403	Spiral Reinforcement (SB-2054 NB-400)	lb.	N/C	Nec.
404-A	Structural Steel	lb.	149,540	134,680
407	Asphaltic Asbestos Coating	sq. yd.	10	46
501	Furnishing Equipment for Driving Piles	hr.	-	Nec.
503	Splices for Steel Piling	ea.	-	3
504	Steel Piling	lf.	199	240
556-C	Granite Bridge Curb, Mod.	lf.	159	295
575	Bridge Rolling	lf.	159	258
572	Joint Sealant - Hot-poured elastic type	lf.	78	158

\* These items to be included in the roadway estimate

• For Final Quantities See Original Tracing  
SH 38 OF 181  
BRIDGE SHEET 1 OF 10

GENERAL NOTES:

- Materials and Construction shall conform to State of Vermont Department of Highways Standard Specifications for Highway and Bridge Construction dated 1986.
- All design in accordance with A.A.S.H.O. Standard Specifications for Highway Bridges, dated 1957. Loading is H20-S16-44 truck as modified for National System of Interstate Highways.
- Concrete shall attain a minimum strength of 2000 p.s.i. prior to the addition of any superimposed load.
- All concrete to be Class "B".
- All welding to conform with the American Welding Society Standard Specifications for Welded Highway and Railway Bridges.
- The haunch over each beam to vary in order to compensate for camber remaining after dead load deflection. Beam seat elevations have been lowered to account for difference between actual camber and required camber.
- Minimum cover for reinforcing bars shall be 2" unless noted.
- All piles to be 12" x 12" and driven to ledge rock or refusal as directed by Engineer. Minimum bearing capacity = 46 tons.
- Chamfer all exposed edges of concrete 1" unless otherwise shown.
- Care must be exercised in removing the ledge rock in the area of piers & abutments founded on ledge rock.
- All expansion material shall be premoiled cork containing no bituminous or asphalt.

REFERENCE SHEET FOR  
VERNON-ROCKINGHAM IR-91- (2)  
SHEET 24 OF 32

INDEX OF DRAWINGS

- General Plan & Elevations
- Boring Logs, Profiles, Sections & Framing Plans.
- South Abutment - Southbound
- North Abutment - Southbound
- South Abutment - Northbound
- North Abutment - Northbound
- Piers - Northbound
- Approach Slabs
- Reinforcement Sheet 2 of 2
- Reinforcement Sheet 2 of 2

Standard Drawings

- SCB-D-60
- SCB-36-60
- SB-59-60-sheet 1 of 2
- SB-20-60
- SB-22-60


BRIDGE R2N4S  
VERMONT  
STATE HIGHWAY DEPARTMENT  
TOWNS OF WESTMINSTER ROCKINGHAM  
INTERSTATE ROUTE 91

DARBY HILL ROAD BRIDGE  
GENERAL PLAN  
AND ELEVATIONS


WMH McFARLAND  
ENGINEER  
BURLINGTON, VT.

DESIGNED: L.H.S. CHECKED: L.H.S. DATE: 12-30-60  
DRAWN: J.H.T. IN CHARGE: H.G.C. SCALE: 1" = 20'  
PROJECT: 191-115 CONT'G. SH 38 OF 187


PRELIMINARY INFORMATION  
SHEET FOR BRIDGES

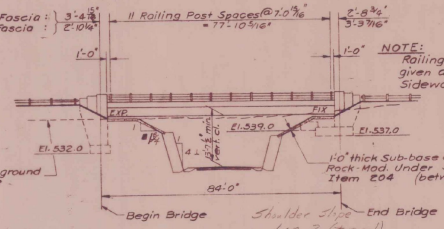

ELEVATION - S.B. BRIDGE  
Scale: 1" = 20'

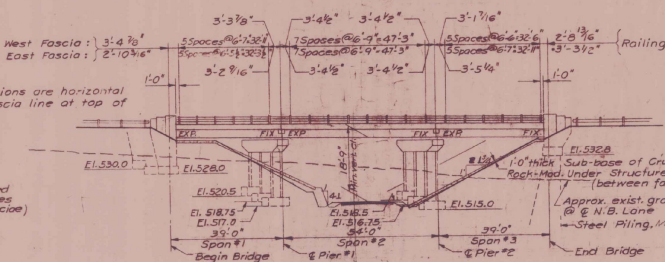


ELEVATION - N.B. BRIDGE  
Scale: 1" = 20'

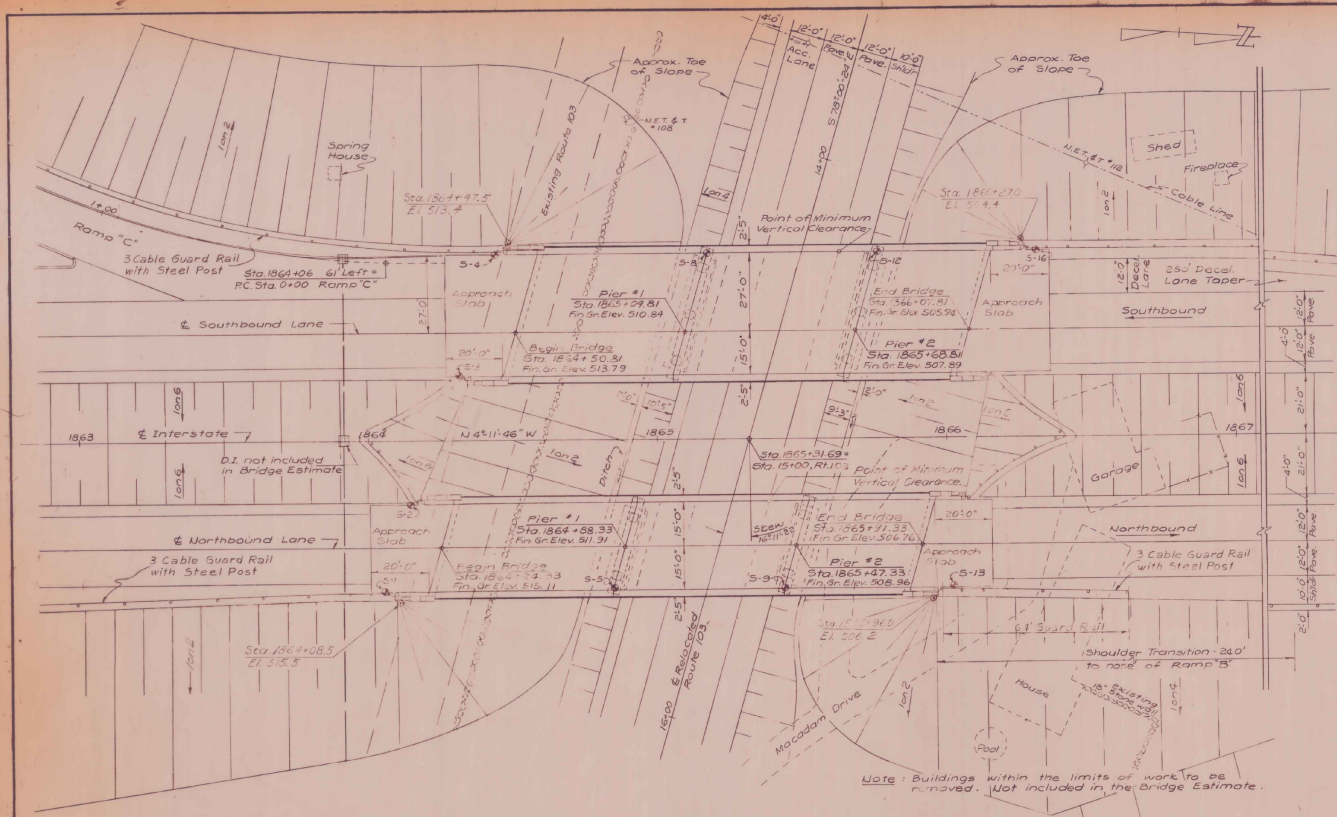

**PLAN**  
Scale: 1"=20'

- NOTES:**
- The embankment for a distance of 100ft from approach slabs shall be of granular material conforming to the specification for Granular Borrow, Item 102-A.
  - Where granular material is indicated around bridge abutments rock fill, if available, shall be substituted except in the area where piles are to be driven. Wherever materials from excavation are used in embankments requiring granular material they shall be paid for as indicated under Item 101, Excavation.

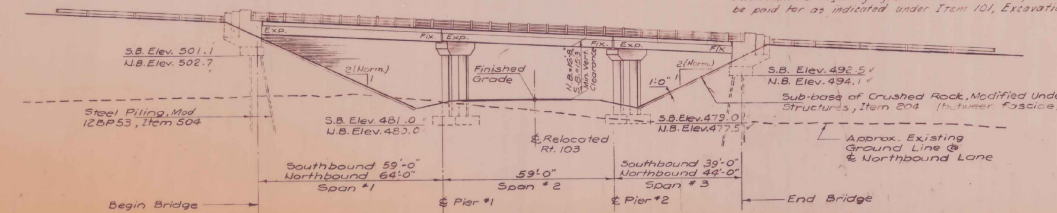

**ELEVATION**  
Scale: 1"=20'

SUMMARY OF QUANTITIES		QUANTITIES			
ITEM NO.	ITEM	S.B. BRIDGE		N.B. BRIDGE	
107	Structure Excavation,	C.Y.	175	132	144
204	Sub-base of Crushed Rock, Mod. Under Structure	C.Y.	131	120	126
222	Gravel Bchfill	C.Y.	88	66	66
315	Tar Emulsion for Bridge Floors	gal.	391		288
361-B	Bituminous Concrete Pavement, Mod.	ton	158		115
401-B	Concrete Class B, Mod.	C.Y.	637	649	493
402	Reinforcing Steel (S.B. 102, 547, N.B. 80, 79)	Lb.	70,725		78,455
403	Spiral Reinforcement (7010" 5, 8, 20, 20)	Lb.			
404A	Structural Steel (Total S.D.G.N.B. = 306, 248)	Lb.			
407	Asphaltic Asbestos Coating	S.Y.	48	48	36
501	Furnishing Equipment for Driving Piles	I.S.	Nec.	Nec.	Nec.
503	Salices for Steel Piling	ea.	0	0	0
504	Steel Piling	L.F.	1257	1,011	1,011
596C	Granite Bridge Curb, Mod.	L.F.	366	383	377
572	Bridge Railing	L.F.	327	327	343
372	Joint Sealer, hot-poured elastic type	L.F.			
		<b>FINAL</b>	<b>FINAL</b>	<b>FINAL</b>	<b>FINAL</b>

\* These items to be included in the roadway estimate.

**GENERAL NOTES**

- Materials and Construction shall conform to State of Vermont Department of Highways Standard Specifications for Highway and Bridge Construction dated 1956.
- All design in accordance with A.A.S.H.O. Standard Specifications for Highway Bridges, dated 1957. Loading is H-20-S16+44 truck as modified for National System of Interstate Highways.
- Concrete shall attain a minimum strength of 2,000 p.s.i. prior to the addition of any superimposed load.
- All concrete to be Class "B".
- All welding to conform with the American Welding Society Standard Specifications for Welded Highway and Railway Bridges.
- The haunch over each beam to vary in order to compensate for camber remaining after dead load deflection. Beam seat elevations have been lowered to account for difference between actual camber and required camber.
- Minimum cover for reinforcing bars shall be 2" unless noted.
- All piles to be 12 BP 53 and driven to minimum bearing capacity of 25 tons.
- Chamfer all exposed edges of concrete 1" unless otherwise shown.
- All expansion material shall be premoled cork containing no bituminous or asphalt.
- Refer to SCB-D-60 for cambering of beams & joint material details.

**INDEX OF DRAWINGS**

- General Plan and Elevation.
- Boring Logs - Profiles, Sections & Firming Plans
- South Abutment - Southbound
- North Abutment - Southbound
- South Abutment - Northbound
- North Abutment - Northbound
- Piers Southbound
- Piers Northbound
- Approach Slab and Railing Plan.
- Reinforcement Sheet 2 of 2.

REFERENCE SHEET FOR  
VERNON-ROCKINGHAM IR-91-1(B)  
SHEET 25 OF 32










- STANDARD DRAWINGS:**
- SCB-30-53 Sheet 1 of 2
  - " " " 2 " 2
  - SCB-42-53 " 1 " 2
  - " " " 2 " 2
  - SB-50-60 2 Sheets
  - SB-AS-(15" S.C.W.)-57
  - SB-20-56
  - SB-22-56
  - SCB-D-60

PRELIMINARY INFORMATION  
SHEET FOR BRIDGES

BRIDGE 23N4S  
VERMONT  
STATE HIGHWAY DEPARTMENT  
TOWNS OF WESTMINSTER-ROCKINGHAM  
INTERSTATE ROUTE 91

ROUTE 103 INTERCHANGE  
GENERAL PLAN  
AND ELEVATION

WM. H. McFARLAND  
ENGINEER  
BINGHAMTON, N.Y.  
DESIGNED: L.H.S. CHECKED: L.H.S. DATE: 12-30-60  
DRAWN: R.Courty IN CHARGE: M.C. SCALE: As Shown  
PROJ. 191-1(15) CONT. 5 SH. 37 OF 141

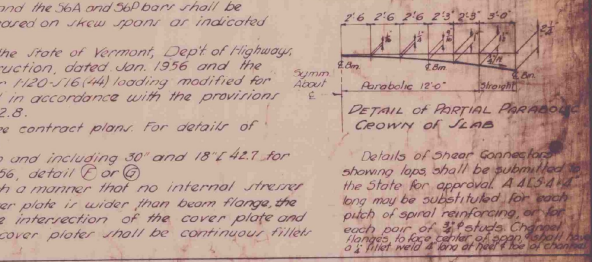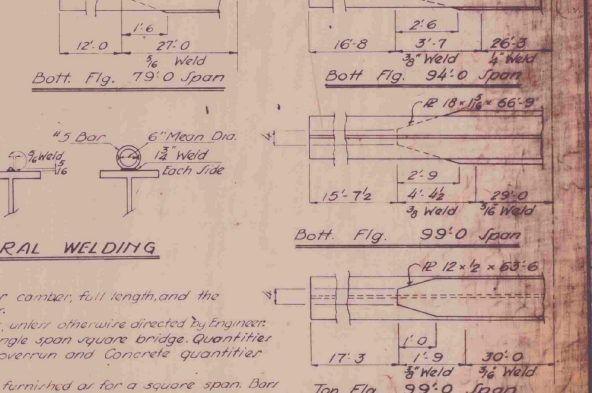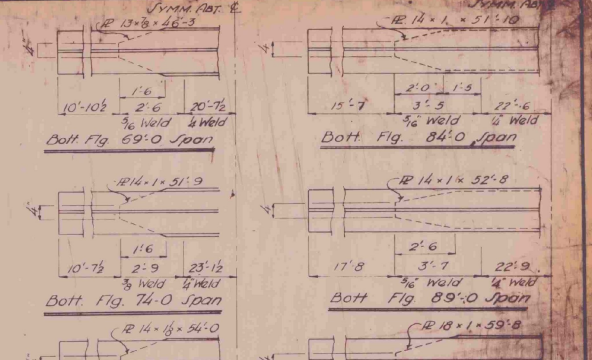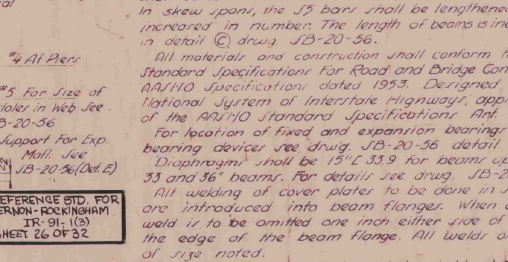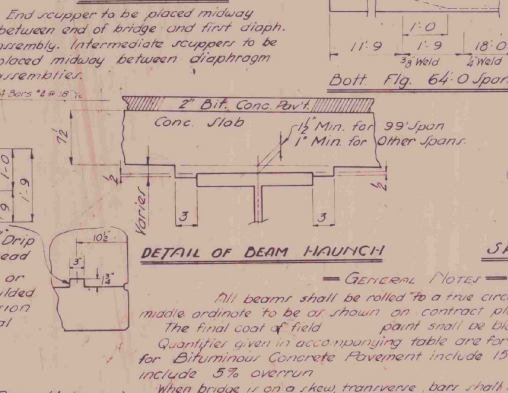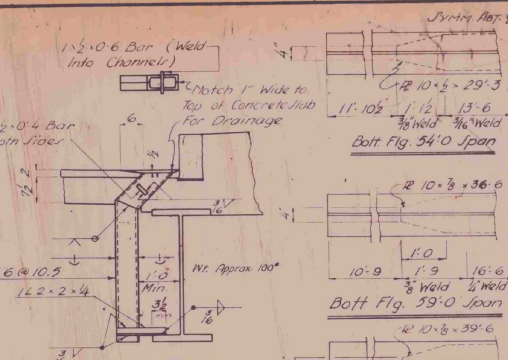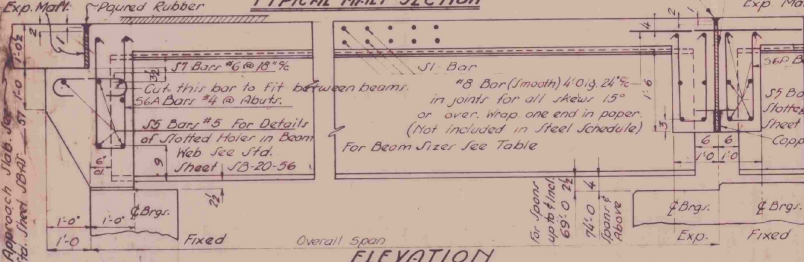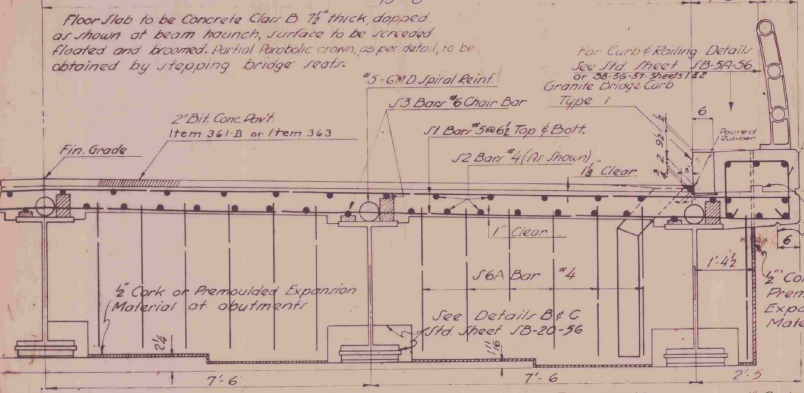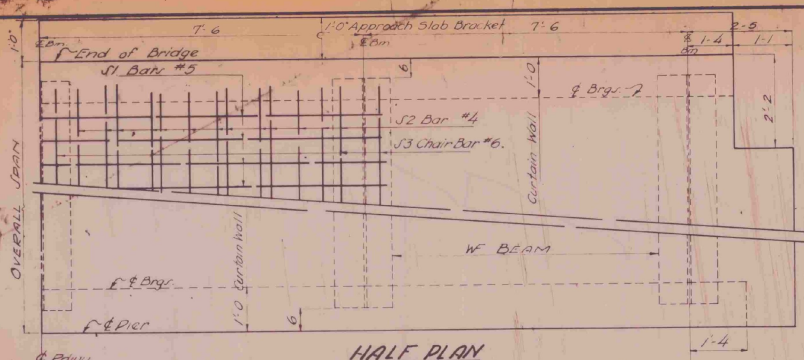

**REVISIONS & CORRECTIONS**

Cover Plate Revised 8/4/56

Slab Added to Back of Scupper 2/26/57

Note on Scupper Location added 8/29/57

Added reference to S1, S2, S3, S999, S1000.

**REVISIONS & CORRECTIONS**

Drawn By: [Signature]

Traced By: [Signature]

Checked By: [Signature]

Correct: [Signature]

Approved: [Signature]

**DETAILS OF 30 FT. ROADWAY COMPOSITE BEAM BRIDGES**

Scuppers are to be omitted over Roadways or Sidewalks under a bridge and placed at least 2'-0" outside of shoulder point on edge of sidewalk, but not within 4'-0" of face of Abutment or Pier. On a banked Bridge Scuppers are to be placed on the lower side only.

All exposed edges of concrete to be chamfered 1" All construction joints to be made as on drawing S3-20-56 details (a) and (b) unless otherwise noted.

**DEPARTMENT OF HIGHWAYS STANDARD STRUCTURES**

**SCB-30-56**

TABLE OF QUANTITIES FOR SINGLE SPAN (Square)

Span, Out-to-Out	93'-0"	94'-0"	89'-0"	84'-0"	79'-0"	74'-0"	69'-0"	64'-0"	59'-0"	54'-0"	49'-0"	44'-0"	39'-0"	34'-0"
Span & No. Brngs.	91'-0"	92'-0"	87'-0"	82'-0"	77'-0"	72'-0"	67'-0"	62'-0"	57'-0"	52'-0"	47'-0"	42'-0"	37'-0"	32'-0"
Length of Brng.	98'-0"	93'-0"	88'-0"	83'-0"	78'-0"	73'-0"	68'-0"	63'-0"	58'-0"	53'-0"	48'-0"	43'-0"	38'-0"	33'-0"
Size WF Beam	36" @ 300*	36" @ 300*	36" @ 300*	36" @ 245*	36" @ 194*	36" @ 170*	36" @ 160*	36" @ 150*	33" @ 130*	33" @ 130*	33" @ 121*	33" @ 150*	30" @ 100*	27" @ 94*
Lgth. & Size Bar: Cover R.	66'-0" @ 3/8"	58'-0" @ 3/8"	58'-0" @ 3/8"	51'-0" @ 3/8"	54'-0" @ 3/8"	51'-0" @ 3/8"	46'-3" @ 3/8"	39'-6" @ 3/8"	36'-6" @ 3/8"	30'-3" @ 3/8"	29'-3" @ 3/8"	---	---	---
Top	63'-0" @ 3/8"	55'-0" @ 3/8"	55'-0" @ 3/8"	48'-0" @ 3/8"	51'-0" @ 3/8"	48'-0" @ 3/8"	43'-0" @ 3/8"	36'-0" @ 3/8"	33'-0" @ 3/8"	27'-0" @ 3/8"	26'-0" @ 3/8"	---	---	---
Dead Load Deflection	3"	2 1/2"	2 1/2"	2 1/2"	1 1/2"	1 1/2"	1 1/2"	1"	1"	3/4"	5/8"	5/8"	4"	4"
Dia of Spiral Bars	---	---	---	---	---	---	---	---	---	---	---	---	---	---
Mean Dia of Spiral	---	---	---	---	---	---	---	---	---	---	---	---	---	---
Spiral Ditch 0'-10" from Brng.	4"	4"	4"	4"	4"	4"	4 1/2"	4"	4 1/2"	4"	4 1/2"	5"	5"	5"
- 10'-20" or 4 Span	4 1/2"	5"	5"	5"	5"	5 1/2"	5 1/2"	6"	6"	6 1/2"	7"	8"	8"	8 1/2"
- 20'-30" or 4.5 Span	6"	6 1/2"	7"	7"	7 1/2"	8"	8 1/2"	9 1/2"	10"	11 1/2"	13 1/2"	---	---	---
- 30'-40" or 4.5 Span	9"	9 1/2"	10"	10"	11 1/2"	13"	15"	9 1/2"	---	---	---	---	---	---
- 40'-4 Span	14"	15"	15"	16"	---	---	---	---	---	---	---	---	---	---
Length of 1/2" Studs	(2 Studs required per pitch. 6" long unless otherwise specified on the plans)													
Tot. Struct. Steel (1 Span)	192,860	169,891	154,403	123,400	99,028	82,980	69,499	59,081	48,883	42,556	39,399	33,392	23,554	19,399
Reinforcing Bars - #1	366	356	328	310	292	274	254	236	218	200	180	162	144	126
- #2	192	192	192	192	192	192	192	188	188	188	188	188	188	64
- #3	30	30	30	30	30	30	30	20	20	20	20	20	20	10
- #4	128	120	114	108	100	94	88	80	74	68	60	54	48	40
- #5	16	16	16	16	16	16	16	16	16	16	16	16	16	16
- #6A	52	52	52	52	52	52	52	52	52	52	52	52	52	52
- #7	44	44	44	44	44	44	44	44	44	44	44	44	44	44
Tot. Weight - Reinf. Bars	20,450	19,416	18,480	17,513	16,551	15,610	14,571	13,478	12,508	11,555	10,525	9,572	8,602	7,502
Approx. Wt. Spiral Reinf.	1,710	1,585	1,510	1,380	1,335	1,275	1,210	1,080	1,060	920	790	725	655	580
Tot. Cu. Yds. Conc. Class B'	116	110	105	100	95	89	84	79	73	68	62	57	51	45
Tot. Wt. Brkm. Conc. Pavement	42	40	38	36	34	32	29	27	25	23	21	19	17	15

REINFORCING STEEL SCHEDULE

51 - #5 - 34'-4" - Straight				55 - #5 - 32'-2" - Straight			
52 - #4		53 - #6		56A - #4			
Straight		Straight		Straight			
Span	lath	Span	lath	Span	Ø D	T.L.	
34'-0"	33'-6"	34'-0"	33'-6"	34'-0"	2'-0"	5'-6"	
39'-0"	20'-3"	30'-0"	20'-6"	30'-0"	2'-3"	6'-0"	
44'-0"	22'-9"	44'-0"	23'-0"	44'-0"	2'-6"	6'-6"	
49'-0"	25'-3"	49'-0"	25'-6"	49'-0"	2'-6"	6'-6"	
54'-0"	27'-9"	54'-0"	28'-0"	54'-0"	2'-6"	6'-6"	
59'-0"	30'-3"	59'-0"	30'-6"	59'-0"	2'-6"	6'-6"	
64'-0"	32'-9"	64'-0"	33'-0"	64'-0"	2'-9"	7'-0"	
69'-0"	24'-3"	69'-0"	24'-6"	69'-0"	2'-9"	7'-0"	
74'-0"	26'-0"	74'-0"	26'-3"	74'-0"	2'-9"	7'-0"	
79'-0"	27'-6"	79'-0"	28'-0"	79'-0"	2'-10"	7'-2"	
84'-0"	29'-3"	84'-0"	29'-6"	84'-0"	2'-10"	7'-2"	
89'-0"	31'-0"	89'-0"	31'-3"	89'-0"	2'-10"	7'-2"	
94'-0"	32'-6"	94'-0"	33'-0"	94'-0"	2'-10"	7'-2"	
99'-0"	34'-3"	99'-0"	34'-6"	99'-0"	2'-10"	7'-2"	
54 - #4 - T.L. 4'-10"		56D - #4 - T.L. 4'-10"		57 - #6 - T.L. 3'-0"			

REFERENCE STANDARD FOR  
VERNON - ROCKINGHAM IR-91-(3)  
SHEET 27 OF 32


Revisions & Corrections  
Structural Steel Rev. for 84' span 2/26/57

Drawn By H.W.S. Nov. 1956  
Traced By H.W.S.  
Checked By D.T.B.  
Correct 12/17/56  
A.S. [Signature]  
Bridge Engineer  
Approved 12/13/56  
H. [Signature]  
Chief Engineer


TABLES TO BE USED IN CONNECTION WITH  
SCB-30-56

DEPARTMENT OF HIGHWAYS  
STANDARD STRUCTURES


SCB-30-56

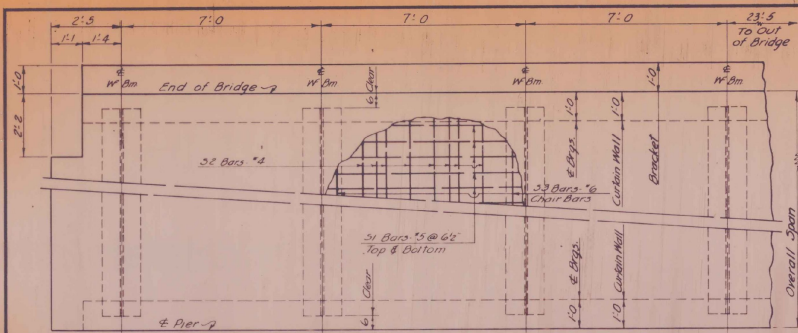



**PARTIAL PLAN**

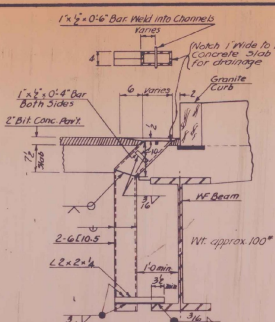


**SCUPPER DETAIL**

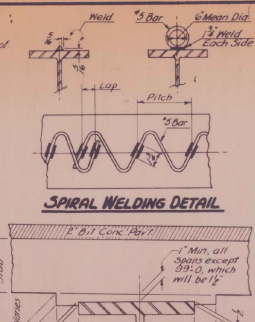


**DETAIL OF BEAM HAUNCH**

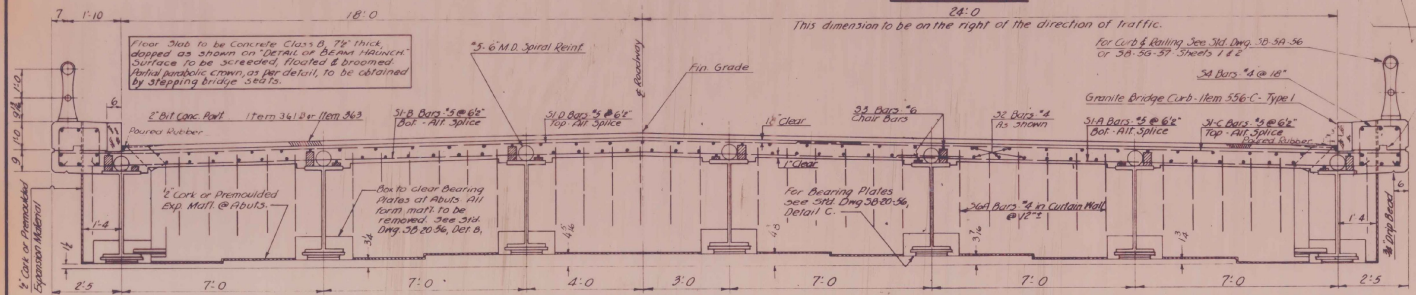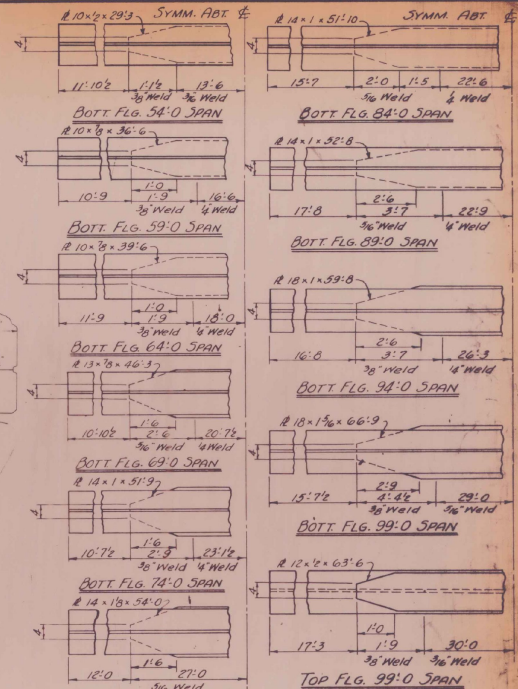

**TYPICAL SECTION**

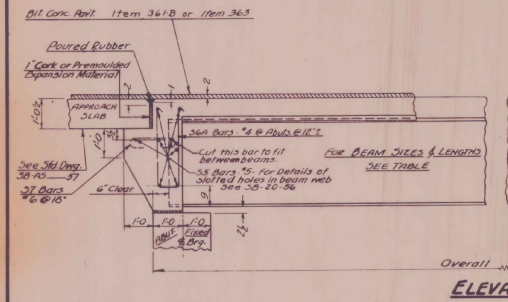

**ELEVATION**

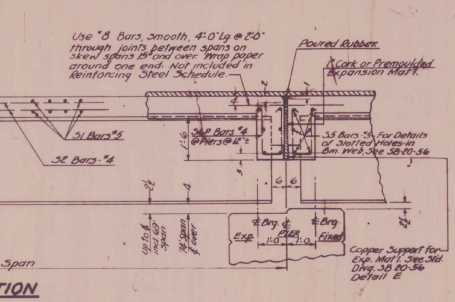

**DETAIL OF PARTIAL PARABOLIC SLAB CROWN**

**GENERAL NOTES**

All beams shall be related to a true circular center, full length, and the middle ordinate to be as shown on contact plans. The final cut of final paint shall be black, unless otherwise directed by the Engineer. Quantities given in accompanying table are for single span square bridge. Quantities for Bifurcated Concrete Formwork include 15% overrun. Concrete quantities include 5% overrun.

When bridge is on a skew, transverse bars shall be furnished as for a square span. Bars shall be cut in field to fit skew end, and castoffs shall be used in opposite skew end in spans beyond the 35 bars shall be furnished, and the 34 ft and 34 ft bars shall be increased in number. The length of beams is increased on skew spans as indicated in detail C.

See 310 Dmp. 38-20-56.

All materials and construction shall conform to the State of Vermont Dept. of Highways Standard Specifications for Road and Bridge Construction dated Jan. 1886, and the A.A.S.H.O. Specifications dated 1923, designed for N. 20-516 (44) loading modified for National System of Interstate Highways applied in accordance with the provisions of the A.A.S.H.O. Standard Specifications Part 2-2.5.

For location of fixed and expansion bearings see contract plans. For details of bearing devices see 310 Dmp. 38-20-56, detail C.

Diaphragms shall be 15, 13 1/2 for beams up to 6 and including 36 beams, and 16, 14 1/2 for 39 and 36 beams. For details see 310 Dmp. 38-20-56, detail C.

All welding of cover plates to be done in such a manner that no internal stresses are introduced into the beam flanges. When cover plate is wider than beam flange, the weld is to be omitted one inch either side of the intersection of the cover plate and the edge of the beam flange. All welds on cover plates shall be continuous fillers of size noted.

Details of shear connectors shall be submitted to the State for approval. A 4 1/2 x 4 1/2 may be substituted for each pitch of spiral reinforcing, or for each pair of 3/4 bars. Channel flanges to face center of span, and shall have a 1/2" fillet weld 4" long at heel and toe of channel.

Scuppers to be finished over abutments or otherwise, under of bridge and placed at least 2'0" outside of shoulder, point of edge of sidewalk, but not within 4'-0" of face of Abutment or Pier. Only finished Bridge Scuppers are to be placed on the lower side only.

All exposed edges of concrete to be chamfered 1". All cast joints to be made as on drawing 38-20-56 details C & D unless otherwise noted.

THIS IS SHEET 1 OF 2 SHEETS  
REFERENCE STANDARD FOR  
VERNON - ROCKINGHAM IR - 91-1(3)  
SHEET 28 OF 32

**REVISIONS & CORRECTIONS**

COVER PLATE REVISED 84' SPAN  
NOTCH ADDED TO BACK OF SCUPPER  
Note on Scupper Location worked  
Added reference to 310.38.56-97.3ms 182  
Added Approx Scupper weight (100')  
Changed ref. to 310.38.56-42.56 to 38-183-57  
Added Const Joint & Chemfer notes

3/26/57  
8/20/57  
11/25/57  
11/25/57  
6/21/58

DRAWN BY: R.T.B. 11/13/56  
TRACED BY: R.T.B. 11/13/56  
CHECKED BY: H.V.S. Dec. 56

CORRECT 12/21/56  
G. D. Dwyer  
BRIDGE ENGINEER

APPROVED 12/10/56  
H. V. S.  
CHIEF ENGINEER

**DETAILS OF 42 FT. ROADWAY-COMPOSITE  
BEAM BRIDGES:**


DEPARTMENT OF HIGHWAYS  
STANDARD STRUCTURES  
**SCB-42-56**

TABLE OF QUANTITIES FOR A SINGLE SPAN (SQUARE)

SPAN - CUT TO CUT	99-0	94-0	89-0	84-0	79-0	74-0	69-0	64-0	59-0	54-0	49-0	44-0	39-0	34-0	
SPAN & EQ BEARINGS	97-0	92-0	87-0	82-0	77-0	72-0	67-0	62-0	57-0	52-0	47-0	42-0	37-0	32-0	
LENGTH OF BEAMS	98-0	93-8	88-0	83-0	78-0	73-0	68-0	63-0	58-0	53-0	48-0	43-0	38-0	33-0	
SIZE OF BEAM	36W300	36W300	36W300	36W245	36W174	36W170	36W160	36W150	33W130	33W130	33W121	33W130	30W108	27W94	
LGTH & SIZE BOT COVER #	60" x 10" 18-1	59" x 10" 18-1	58" x 10" 18-1	57" x 10" 18-1	56" x 10" 18-1	55" x 10" 18-1	54" x 10" 18-1	53" x 10" 18-1	52" x 10" 18-1	51" x 10" 18-1	50" x 10" 18-1	49" x 10" 18-1	48" x 10" 18-1	47" x 10" 18-1	
LGTH & SIZE TOP COVER #	60" x 10" 18-1	59" x 10" 18-1	58" x 10" 18-1	57" x 10" 18-1	56" x 10" 18-1	55" x 10" 18-1	54" x 10" 18-1	53" x 10" 18-1	52" x 10" 18-1	51" x 10" 18-1	50" x 10" 18-1	49" x 10" 18-1	48" x 10" 18-1	47" x 10" 18-1	
DEAD LOAD DEFLECTION	3"	2 1/2"	2 1/2"	2 1/2"	1 1/2"	1 1/2"	1 1/2"	1"	1"	3/4"	1/2"	1/2"	1/2"	1/2"	
DIA. OF SPIRAL BARS															
MEAN DIA. OF SPIRAL															
SPIRAL PITCH 0'-10" FROM BCG.	4"	4"	4"	4"	4"	4"	4"	4"	4"	4"	4"	4"	4"	4"	
" " 10'-20" OR E SPAN	4"	5"	5"	5"	5"	5"	5"	6"	6"	6"	6"	7"	8"	8"	
" " 20'-30" " " "	6"	6"	7"	7"	7"	7"	8"	8"	9"	10"	11"	13"	8"	8"	
" " 30'-40" " " "	9"	9"	10"	10"	11"	13"	15"	15"	16"						
" " 40' & SPAN	14"	15"	15"	16"											
LENGTH OF #4 STUDS		6" LONG UNLESS OTHERWISE SPECIFIED ON THE PLANS													
TOT STRUCT. STEEL (1 SPAN)	269,750	237,600	218,700	172,600	138,400	115,925	97,125	82,550	68,275	59,425	53,000	46,575	32,850	25,700	
REINFORCING BARS - 31-A	183	174	164	155	146	137	127	118	109	100	91	81	72	63	
" " 31-B	183	174	164	155	146	137	127	118	109	100	91	81	72	63	
" " 31-C	183	174	164	155	146	137	127	118	109	100	91	81	72	63	
" " 31-D	183	174	164	155	146	137	127	118	109	100	91	81	72	63	
" " 32	252	252	252	252	252	252	252	252	168	168	168	168	168	168	
" " 33	42	42	42	42	42	42	42	28	28	28	28	28	28	14	
" " 34	128	122	114	108	102	94	88	82	74	68	62	54	48	42	
" " 35	32	32	32	32	32	32	32	32	32	32	32	32	32	32	
" " 36A	76	76	76	76	76	76	76	76	76	76	76	76	76	76	
" " 37	62	62	62	62	62	62	62	62	62	62	62	62	62	62	
TOT WEIGHT REINF BARS	28,290	26,970	25,570	24,235	22,920	21,610	20,175	18,680	17,330	16,015	14,700	13,275	11,935	10,430	
APPROX. WT. SPIRAL REINF	2395	2215	2110	1930	1935	1780	1690	1505	1475	1285	1100	1010	915	810	
TOTAL C.Y. CONC. CLASS B	151.0	144.0	137.3	130.6	123.7	116.8	110.1	103.3	95.4	88.6	82.0	75.2	67.0	59.0	
TOT. WT. BIT CONC. PAINT (TONS)	60	57	54	51	48	45	42	39	36	33	30	27	24	21	

REINFORCING STEEL SCHEDULE

31-A #5 17'3" STRAIGHT	31-B #5 31'3" STRAIGHT
31-C #5 20'9" STRAIGHT	31-D #5 27'9" STRAIGHT
32 #4 STRAIGHT	36A #4 STRAIGHT
33 #4 STRAIGHT	37 #4 STRAIGHT
34 #4 STRAIGHT	35 #4 STRAIGHT
35 #4 STRAIGHT	36 #4 STRAIGHT
36 #4 STRAIGHT	37 #4 STRAIGHT
99 #4 STRAIGHT	100 #4 STRAIGHT

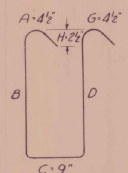


REFERENCE STANDARD FOR VERNON - ROCKINGHAM IR-91(2) SHEET 29 OF 32

REVISIONS & CORRECTIONS  
 STRUCTURAL STEEL REV. FOR 84' SPAN 2/26/56


DESIGNED BY: RTB, NOV 1956  
 TRACED BY: RTB, NOV 1956  
 CHECKED BY: H.V.S. DEC 1956  
 CORRECT -- 12/17/56  
 APPROVED -- 12/18/56  
 BRIDGE ENGINEER  
 CHIEF ENGINEER

TABLES TO BE USED IN CONNECTION WITH SCB-42-56


DEPARTMENT OF HIGHWAYS STANDARD STRUCTURES  
**SCB-42-56**

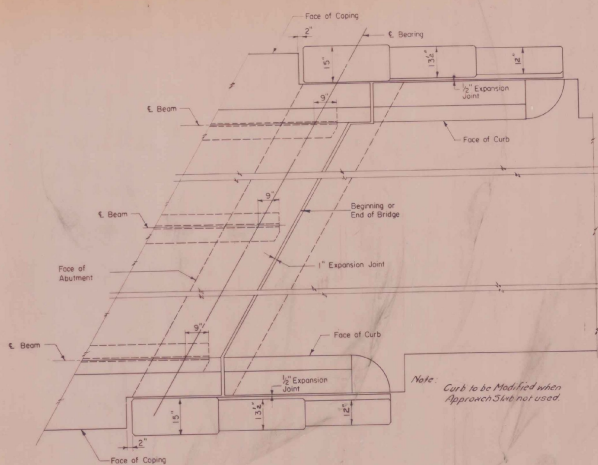


PLAN AT ABUTMENT  
Scale: 1/2" = 1'-0"

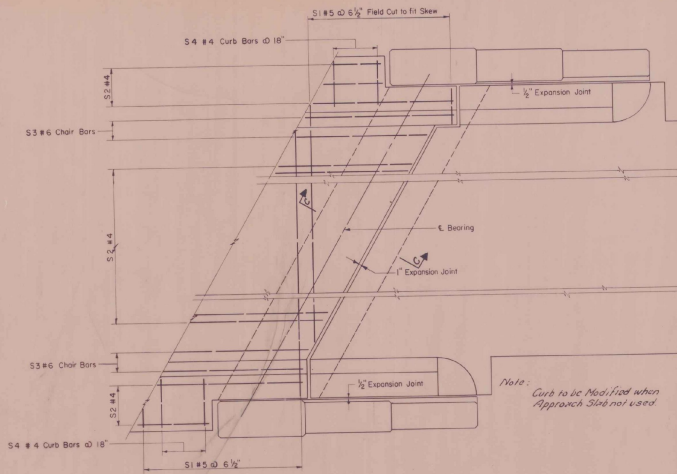


REINFORCEMENT LAYOUT AT ABUTMENT  
Scale: 1/2" = 1'-0"

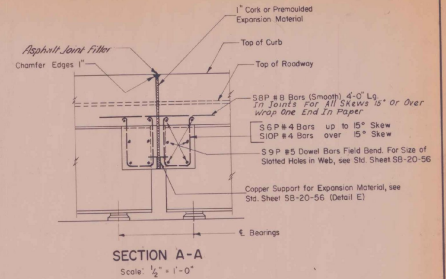


SECTION A-A  
Scale: 1/2" = 1'-0"

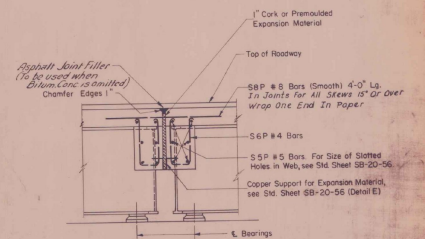


SECTION B-B  
Scale: 1/2" = 1'-0"

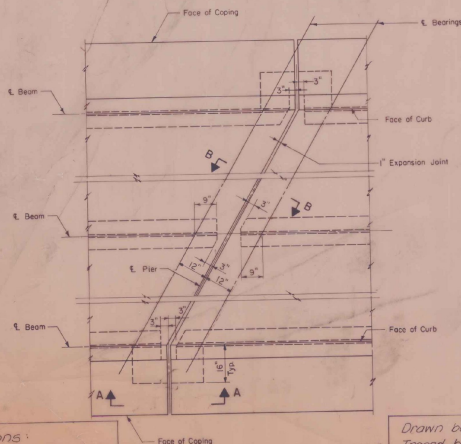

PLAN AT PIER  
Scale: 1/2" = 1'-0"

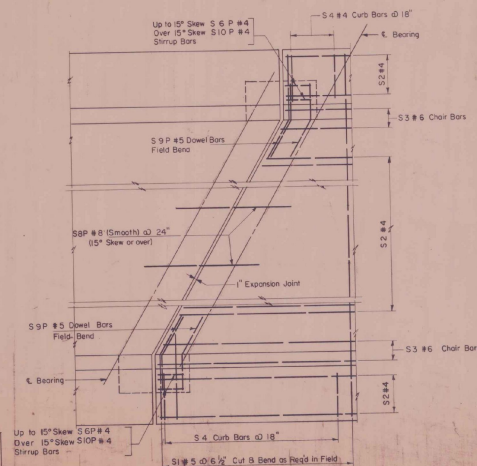

REINFORCEMENT LAYOUT AT PIER  
Scale: 1/2" = 1'-0"

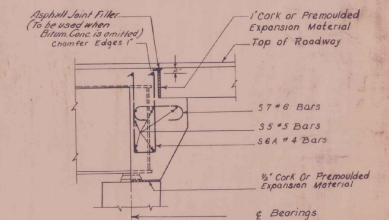

SECTION C-C  
Scale: 1/2" = 1'-0"

REFERENCE STANDARD FOR  
VERNON-ROCKINGHAM IR-91-1(3)  
SHEET 31 OF 32

Devisions & Corrections:  
Changed Doured Rubber to Asphalt Joint Filler 9/17/58

Drawn by  
Traced by  
Checked by  
Clarkson Engineering Co.


Correct  
A.S.B. by 9/22/58  
Bridge Engineer  
Approved 5/23/58  
C.S.E. by  
Civil Engineer

DETAIL OF EXPANSION JOINT OVER PIERS AND AT ABUTMENTS


DEPARTMENT OF HIGHWAYS  
STANDARD STRUCTURES

SB-22-58


GENERAL NOTES

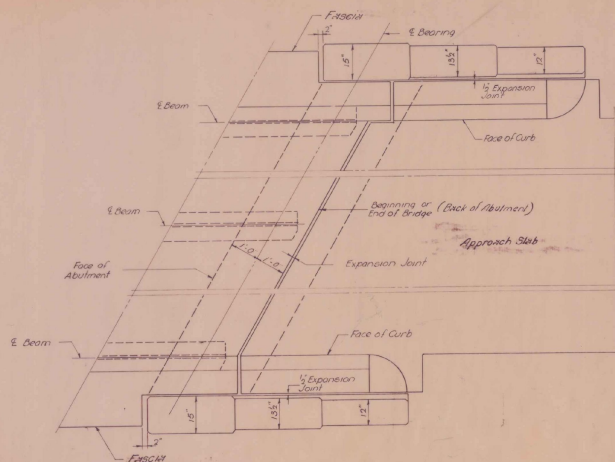


PLAN AT ABUTMENT  
Scale 1/2" = 1'-0"

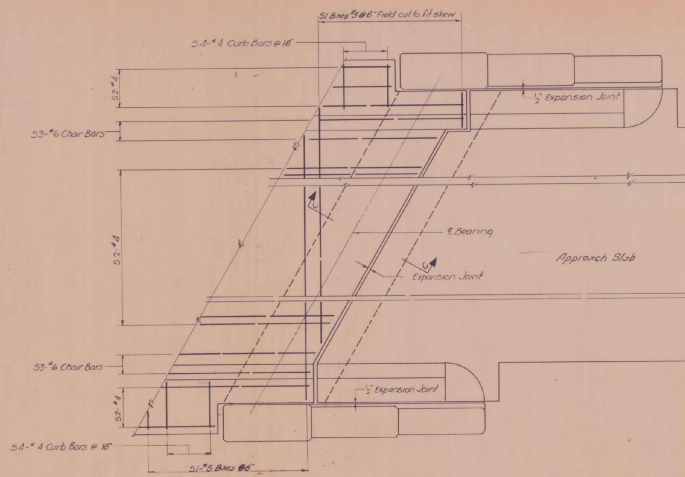


REINFORCEMENT LAYOUT AT ABUTMENT  
Scale 1/2" = 1'-0"

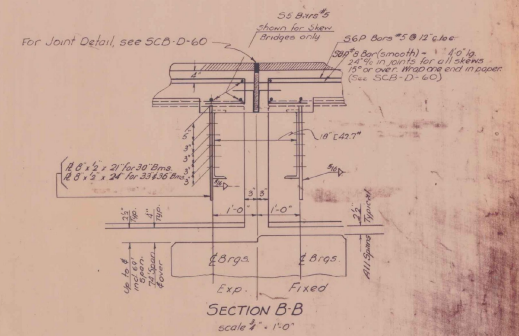


SECTION B-B  
Scale 1/2" = 1'-0"

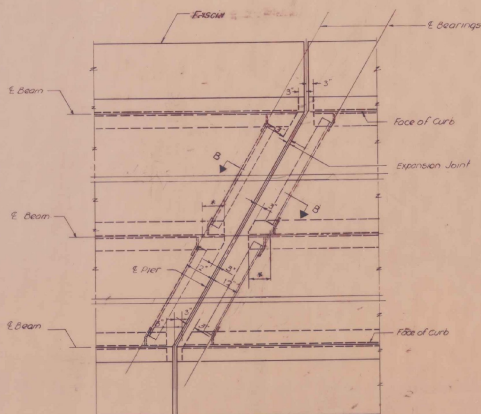

PLAN AT PIER  
Scale 1/2" = 1'-0"

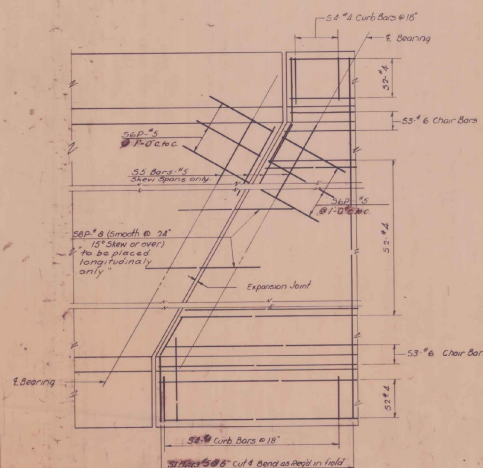

REINFORCEMENT LAYOUT AT PIER  
Scale 1/2" = 1'-0"

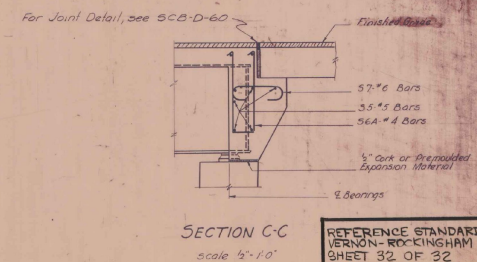

SECTION C-C  
Scale 1/2" = 1'-0"

REFERENCE STANDARD FOR  
VERNON-ROCKINGHAM IR-91-1(3)  
SHEET 32 OF 32

DETAIL OF EXPANSION JOINT OVER PIERS AND AT ABUTMENTS



DEPARTMENT OF HIGHWAYS  
STANDARD STRUCTURES

SB-22-60

Revisions & Corrections:  
Remove #4 Bar 5c BB 7/26/60  
Added General Note 8/16/60  
Corrected Joint Detail 12-2-60  
Added note to 5/8 bars 3-2-61

Drawn by: H.W.S. June 1960  
Traced by: H.W.S. June 1960  
Checked by: R.S.H. & R.T.B. June 1960  
Corrected: 13 July 1960  
Approved: 13 July 1960  
Other Engineers:



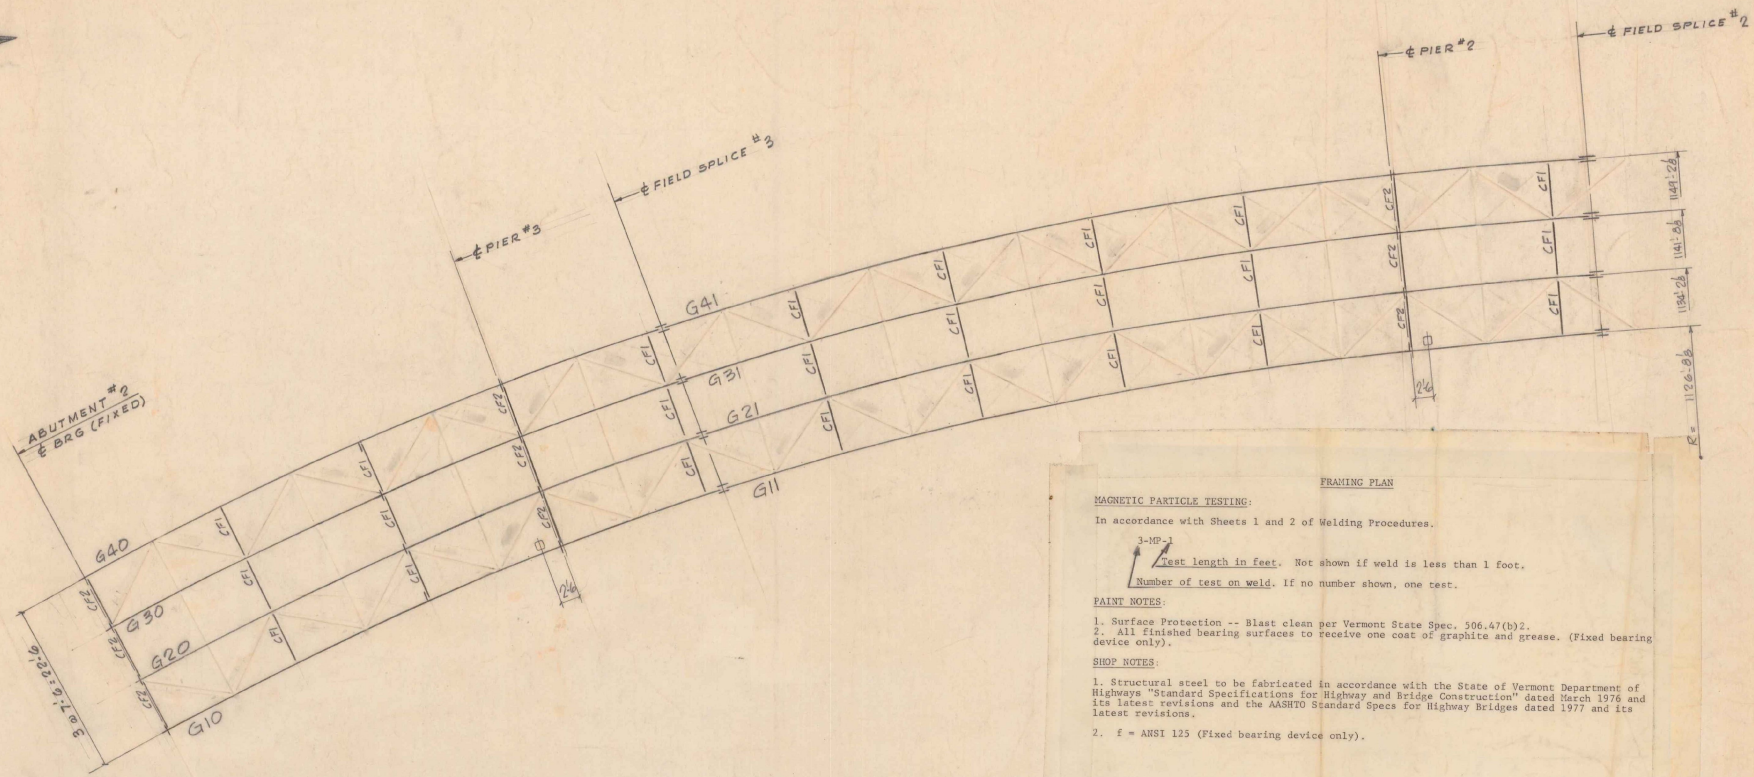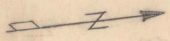

**FRAMING PLAN**

**MAGNETIC PARTICLE TESTING:**  
 In accordance with Sheets 1 and 2 of Welding Procedures.  
 3-HP-1  
 Test length in feet. Not shown if weld is less than 1 foot.  
 Number of test on weld. If no number shown, one test.

**PAINT NOTES:**  
 1. Surface Protection -- Blast clean per Vermont State Spec. 506.47(b)2.  
 2. All finished bearing surfaces to receive one coat of graphite and grease. (Fixed bearing device only).

**SHOP NOTES:**  
 1. Structural steel to be fabricated in accordance with the State of Vermont Department of Highways "Standard Specifications for Highway and Bridge Construction" dated March 1976 and its latest revisions and the AASHTO Standard Specs for Highway Bridges dated 1977 and its latest revisions.  
 2. F = ANSI 125 (Fixed bearing device only).

SEE E4 FOR SLUPPER AND DRAIN DETAIL.

FIELD CONNECTIONS  $\frac{3}{8}$ " A325F (TYPE 3) BOLTS, ONE WASHER

ABUTMENT AND PIER CROSSFRAMES ~ 720 x 2 $\frac{1}{2}$   
 INTERMEDIATE CROSSFRAMES ~ 2304 x 2 $\frac{1}{4}$

SPLICE WEB ~ 1192 x 3  
 SPLICE #1 FLANGE ~ 416 x 4 $\frac{1}{2}$   
 SPLICE #2 FLANGE ~ 416 x 4  
 SPLICE #3 FLANGE ~ 416 x  $\frac{3}{2}$

DELY. SEP.	PCS.	MARK	END OF BEAM AT TRAILER END					
DELY. SEP.	PCS.	MARKS	DELY. SEP.	PCS.	MARKS	DELY. SEP.	PCS.	MARKS
1	G10	5	G11	9	G12	13	G13	
2	G20	6	G21	10	G22	14	G23	
3	G30	7	G31	11	G32	15	G33	
4	G40	8	G41	12	G42	16	G43	

SHOULD BE G23  
 SHOULD BE G13

2

**FRAMING PLAN**

MCB B-4-B1 REV DEW SEM AS PER A BEIC ✓


VERMONT STRUCTURAL STEEL CORPORATION

Remove Horiz. Barring  $\frac{1}{2}$ " BURLINGTON Vt. FAP 193-1(3)9/3

PROJECT RAMP WIDS OVER I91 N.B. & S.B.  
 LOCATION WATERFORD, VT.  
 CUSTOMER BECK & BELLUCCI

DRAWN BY	VTU	DATE	3/81	NO.	FOR	DATE
CHKD BY	CG			5	APP	5-6
				3	IN PD	5-7
				3	SHOP	6-1
				5	APP	6-13
				4	APP	6-14

ARCHITECT S.O.V. A.O.T.  
 JOB NO. 80-3591 SHEET NO. E1


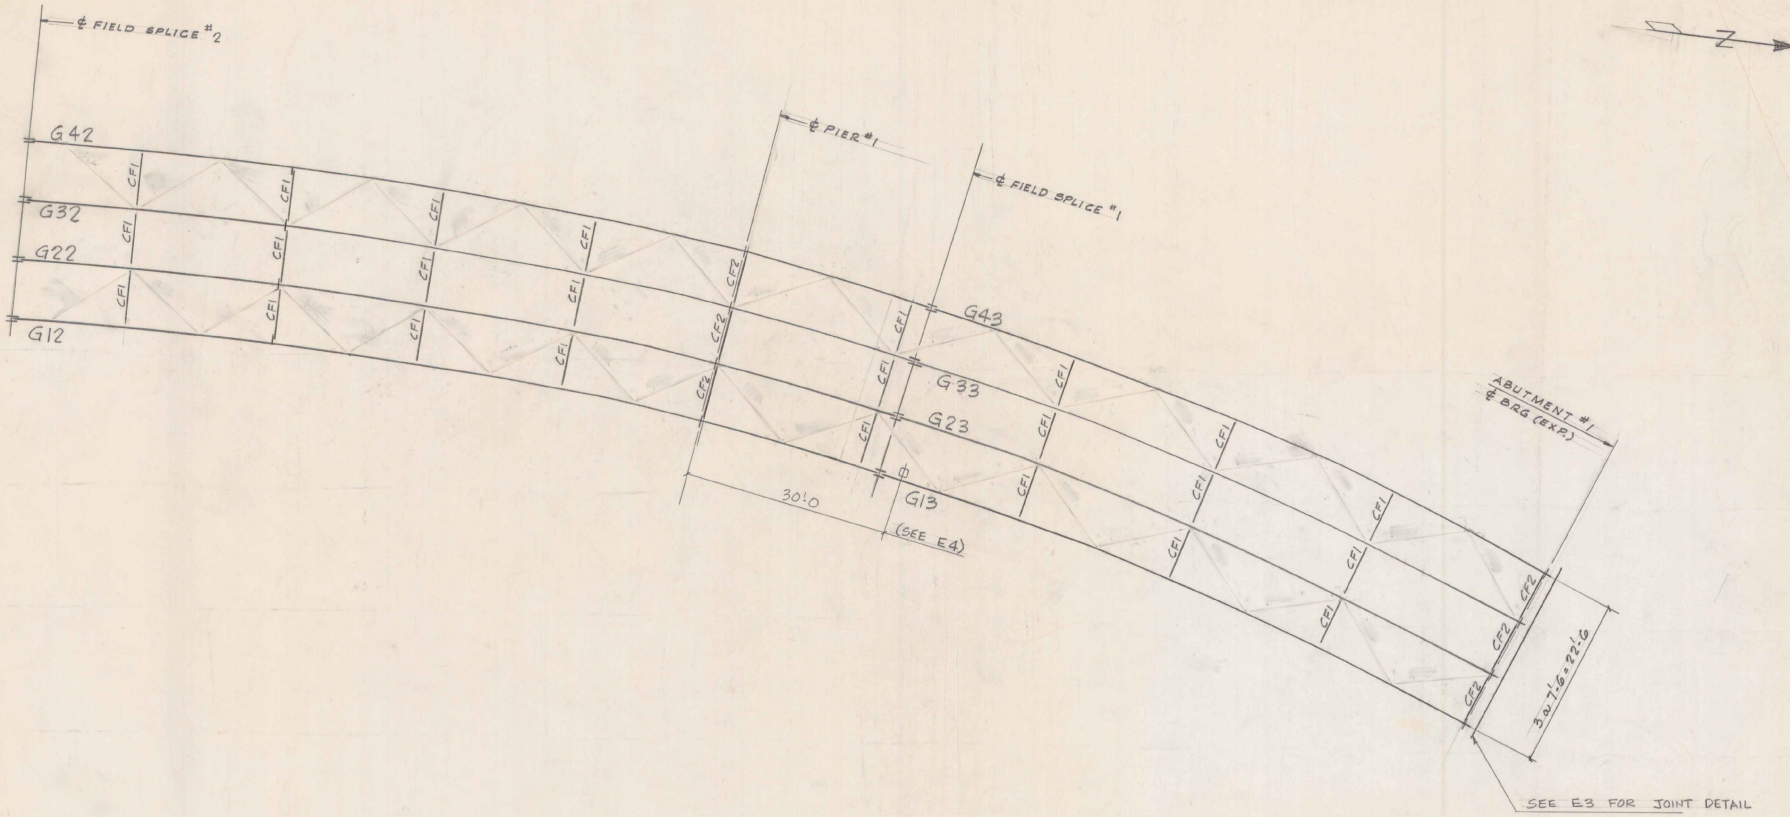


FOR SHOP NOTES  
SEE DWG. E 1

FRAMING PLAN

DRAWN BY		DATE	PROJECT		PRINT RECORD	
VTU			RAMP W/TOS OVER I91 N.B. & S.B.		NO.	FOR DATE
CKD BY	OB		WATERFORD, VT.		5	APP 5-6
			CUSTOMER BECK & BELLUCCI		3	REV 5-7
			ARCHITECT S.O.V. A.O.T.		3	5/10 6-1
			JOB NO. 80-3591 SHEET NO. E2		5	APP 6-23
					4	SHOP 6-24


N/C 2 STAFF 9/8/81

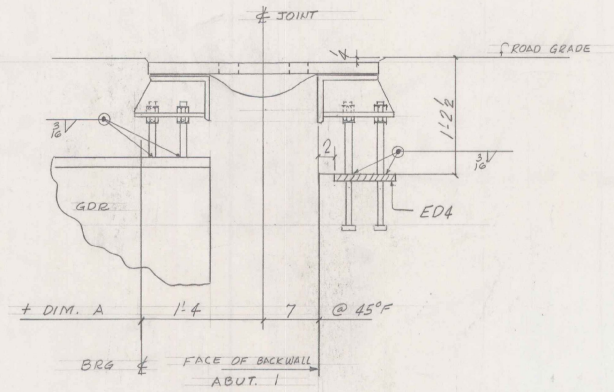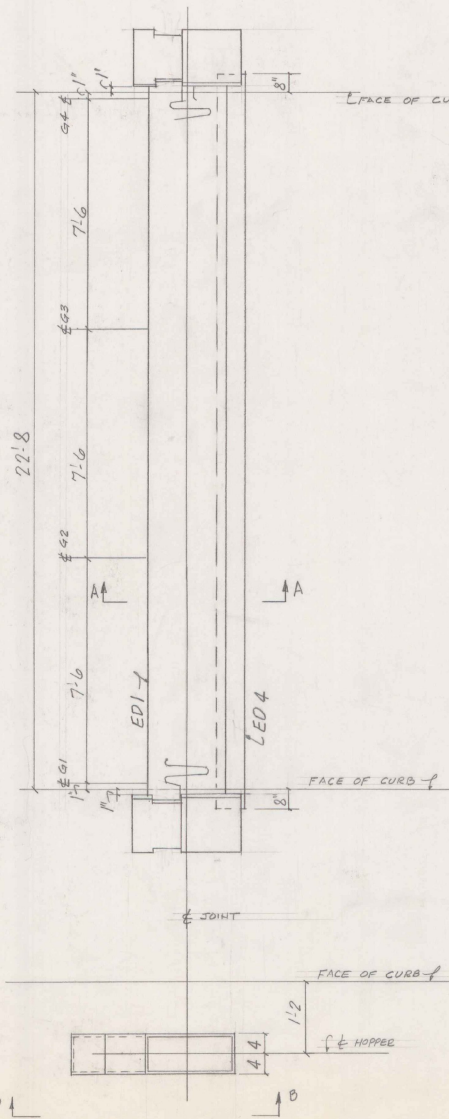


SECT. A-A

EXPANSION (DIM. A)

TEMP.	DIM. A
0°	+1 1/2"
15°	+1"
30°	+1 1/2"
45°	0
60°	-1/2"
75°	-1"
90°	-1 1/2"
105°	-2"

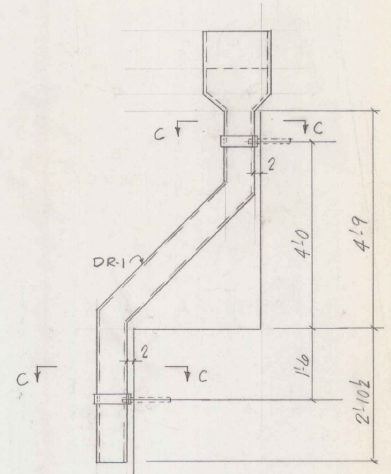

SECT. B-B

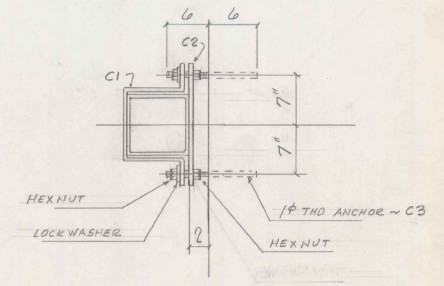





SECT. C-C

FOR SHOP NOTES  
SEE DWG. E 1

N.C.

VERMONT STRUCTURAL STEEL CORPORATION BURLINGTON, VT. FAP I 93-1(2) C/B				PRINT RECORD	
DRAWN BY	CB	DATE	3/6	PROJECT	RAMP W/T'S OVER I 91
CHKD BY	SWD			LOCATION	WATERFORD, VT.
				CUSTOMER	BECK & BELLUCCI
				NO.	5
				FOR	APP
				DATE	5-C
HOLS				ARCHITECT	S.O.V.A.O.T.
BOLTS				JOB NO.	80-3591
PAINT				SHEET NO.	E 3
				NO.	5
				FOR	APP
				DATE	6-12
				BY	SWD
				FILED	6-28
				SHOP	7/23/80
				DATE	9/1/84

N.C.

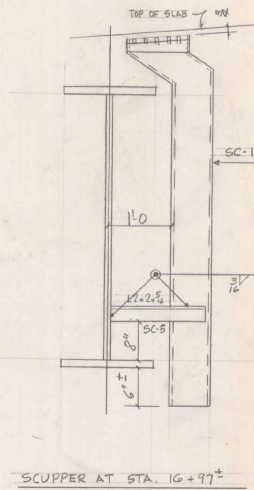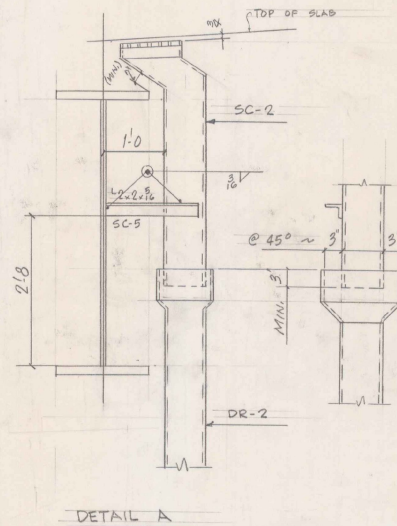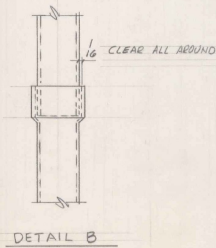
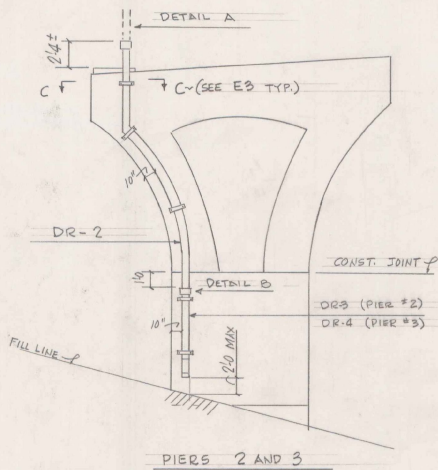


FOR SHOP NOTES  
SEE DWG. E1

FAP I 93-1(3) 6/3

VERMONT STRUCTURAL STEEL CORPORATION BURLINGTON, VT.		PROJECT	RAMP W/T'S OVER I 91	PRINT RECORD	
DRAWN BY	DATE	LOCATION	NO.	FOR	DATE
CB	3/8	WATERFORD, VT.	5	APP	5-6
CHK'D BY	SJS	CUSTOMER	5	APP	6-23
		BESK & BELLUCCI	4	APP	6-23
		ARCHITECT	2	STATE	7/1/91
		S.O.V.A.O.T.			
		JOB NO. 80-3591			
		SHEET NO. E4			

NC.

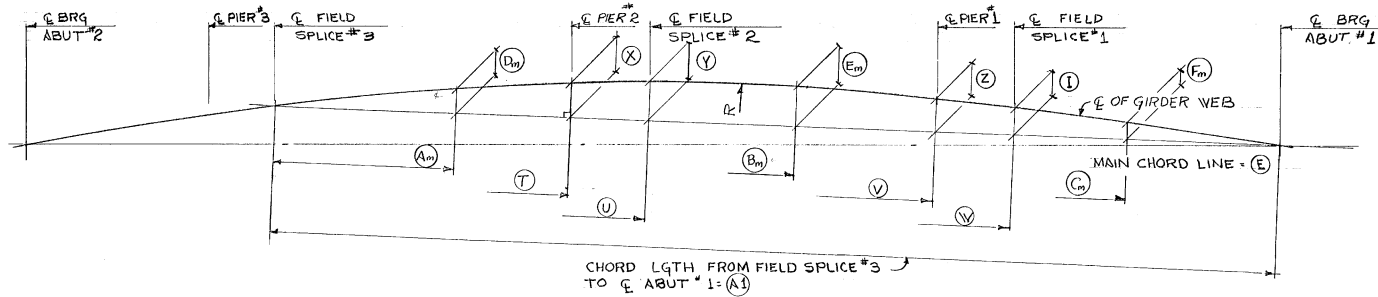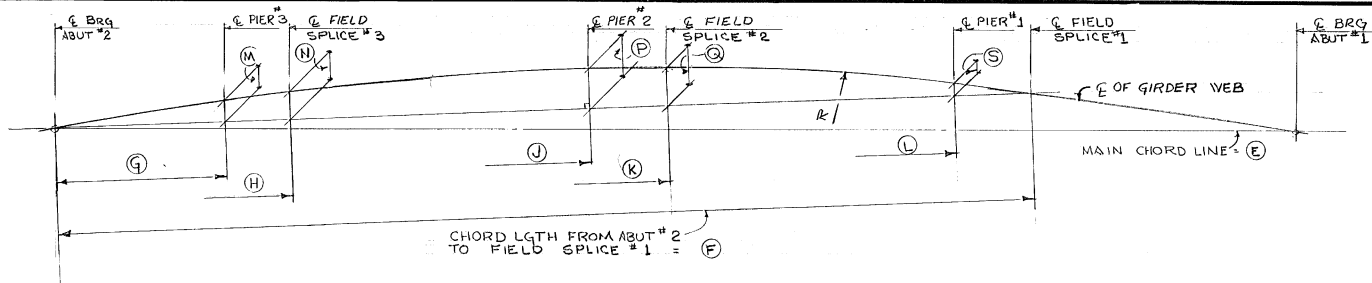

ABUT. # 2 To FIELD SPLICE # 1


	E	F	G	H	J	K	L	M	N	P	Q	R	
LINE 1	402-10 <sup>3</sup> / <sub>8</sub>	318-2 <sup>3</sup> / <sub>8</sub>	58-7 <sup>1</sup> / <sub>8</sub>	80-4 <sup>1</sup> / <sub>2</sub>	116-5 <sup>5</sup> / <sub>8</sub>	201-3 <sup>3</sup> / <sub>8</sub>	293-11 <sup>3</sup> / <sub>8</sub>	6-9 <sup>3</sup> / <sub>8</sub>	8-6 <sup>1</sup> / <sub>2</sub>	11-2	10-6 <sup>7</sup> / <sub>8</sub>	3-2 <sup>1</sup> / <sub>2</sub>	1126-8 <sup>1</sup> / <sub>8</sub>
LINE 2	405-7	320-4 <sup>1</sup> / <sub>4</sub>	58-11 <sup>1</sup> / <sub>8</sub>	80-10 <sup>15</sup> / <sub>16</sub>	117-10 <sup>4</sup> / <sub>8</sub>	202-7 <sup>1</sup> / <sub>8</sub>	296-0 <sup>3</sup> / <sub>8</sub>	6-10 <sup>1</sup> / <sub>8</sub>	8-7 <sup>1</sup> / <sub>8</sub>	11-2 <sup>1</sup> / <sub>8</sub>	10-6 <sup>9</sup> / <sub>8</sub>	3-2 <sup>3</sup> / <sub>8</sub>	1134-2 <sup>1</sup> / <sub>8</sub>
LINE 3	408-3 <sup>3</sup> / <sub>8</sub>	322-3 <sup>3</sup> / <sub>8</sub>	59-5 <sup>1</sup> / <sub>8</sub>	81-4 <sup>1</sup> / <sub>4</sub>	118-10 <sup>3</sup> / <sub>8</sub>	203-9 <sup>1</sup> / <sub>8</sub>	298-0 <sup>1</sup> / <sub>4</sub>	6-10 <sup>1</sup> / <sub>8</sub>	8-7 <sup>3</sup> / <sub>8</sub>	11-3 <sup>1</sup> / <sub>2</sub>	10-7 <sup>3</sup> / <sub>8</sub>	3-2 <sup>3</sup> / <sub>8</sub>	1141-8 <sup>1</sup> / <sub>8</sub>
LINE 4	410-11 <sup>1</sup> / <sub>8</sub>	324-3 <sup>1</sup> / <sub>8</sub>	59-8 <sup>3</sup> / <sub>8</sub>	81-8	119-11 <sup>3</sup> / <sub>8</sub>	204-1 <sup>1</sup> / <sub>8</sub>	300-0	6-11 <sup>1</sup> / <sub>8</sub>	8-8 <sup>3</sup> / <sub>8</sub>	11-4 <sup>3</sup> / <sub>8</sub>	10-8 <sup>1</sup> / <sub>8</sub>	3-2 <sup>3</sup> / <sub>8</sub>	1149-2 <sup>3</sup> / <sub>8</sub>

FIELD SPLICE # 3 To ABUT # 1

	E	A1	T	U	V	W	X	Y	Z	I	Am	Bm	Cm	Dm	Em	Fm
LINE 1	402-10 <sup>3</sup> / <sub>8</sub>	323-1 <sup>3</sup> / <sub>8</sub>	95-7 <sup>5</sup> / <sub>8</sub>	120-5	213-7 <sup>1</sup> / <sub>8</sub>	237-10 <sup>3</sup> / <sub>8</sub>	9-9 <sup>1</sup> / <sub>8</sub>	10-10 <sup>5</sup> / <sub>8</sub>	10-6 <sup>1</sup> / <sub>8</sub>	9-0 <sup>3</sup> / <sub>8</sub>	47-9 <sup>1</sup> / <sub>4</sub>	167-0 <sup>3</sup> / <sub>8</sub>	280-7 <sup>1</sup> / <sub>8</sub>	5-10 <sup>1</sup> / <sub>8</sub>	11-7 <sup>1</sup> / <sub>2</sub>	5-3 <sup>1</sup> / <sub>8</sub>
LINE 2	405-7	325-3 <sup>3</sup> / <sub>8</sub>	96-2 <sup>1</sup> / <sub>8</sub>	121-2 <sup>3</sup> / <sub>8</sub>	214-11 <sup>1</sup> / <sub>2</sub>	239-5 <sup>1</sup> / <sub>8</sub>	9-9 <sup>3</sup> / <sub>8</sub>	10-11 <sup>3</sup> / <sub>8</sub>	10-6 <sup>3</sup> / <sub>8</sub>	9-1 <sup>1</sup> / <sub>8</sub>	48-0 <sup>1</sup> / <sub>4</sub>	168-1 <sup>1</sup> / <sub>8</sub>	282-5 <sup>3</sup> / <sub>8</sub>	5-11 <sup>1</sup> / <sub>8</sub>	11-8 <sup>1</sup> / <sub>2</sub>	5-4 <sup>1</sup> / <sub>2</sub>
LINE 3	408-3 <sup>3</sup> / <sub>8</sub>	327-6 <sup>3</sup> / <sub>8</sub>	97-0 <sup>3</sup> / <sub>8</sub>	121-1 <sup>3</sup> / <sub>8</sub>	216-5 <sup>1</sup> / <sub>8</sub>	240-11 <sup>1</sup> / <sub>4</sub>	9-10 <sup>1</sup> / <sub>16</sub>	11-0 <sup>9</sup> / <sub>16</sub>	10-11 <sup>1</sup> / <sub>8</sub>	9-2 <sup>3</sup> / <sub>8</sub>	48-5 <sup>1</sup> / <sub>8</sub>	169-2 <sup>1</sup> / <sub>8</sub>	284-3 <sup>1</sup> / <sub>8</sub>	5-11 <sup>1</sup> / <sub>8</sub>	11-9 <sup>1</sup> / <sub>8</sub>	5-5 <sup>1</sup> / <sub>8</sub>
LINE 4	410-11 <sup>1</sup> / <sub>8</sub>	329-10 <sup>1</sup> / <sub>8</sub>	97-9 <sup>1</sup> / <sub>8</sub>	122-9 <sup>1</sup> / <sub>8</sub>	218-1 <sup>3</sup> / <sub>8</sub>	242-7 <sup>1</sup> / <sub>8</sub>	9-11 <sup>1</sup> / <sub>8</sub>	11-1 <sup>1</sup> / <sub>2</sub>	10-8	9-3 <sup>1</sup> / <sub>4</sub>	48-9 <sup>1</sup> / <sub>8</sub>	170-5 <sup>3</sup> / <sub>8</sub>	286-3 <sup>1</sup> / <sub>8</sub>	6-0 <sup>1</sup> / <sub>8</sub>	11-10 <sup>1</sup> / <sub>8</sub>	5-5 <sup>3</sup> / <sub>8</sub>

8-27-81 MCB ✓ Located ADDN POINTS  
SEE SUT CIB FOR ADDL INFO.

VERMONT STRUCTURAL STEEL CORPORATION BURLINGTON, VT.				PRINT RECORD		
DRAWN BY	DATE	PROJECT	RAMP V TOS OVER I91	NO.	JOB	DATE
CKD BY	MCB 7-6-8	LOCATION	WATERFORD VT	3	SHP	7-16
		CUSTOMER	Beck & BELLUCCI	3	SHP	8-27
HOLES		ARCHITECT	S.O.V.A.O.T			
BOHS		JOB NO.	30-3591	SHEET NO.	CIA	
PAIN						

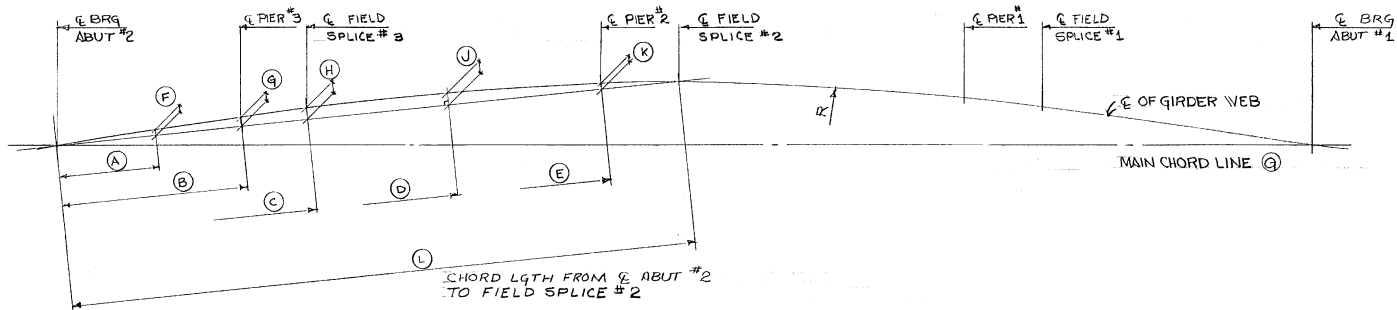


~ ABUT #2 To FIELD SPLICE #2 ~

	(A)	(B)	(C)	(D)	(E)	(F)	(G)	(H)	(J)	(K)	(L)	(Q)	(R)
LINE 1	29-4 <sup>15</sup> / <sub>16</sub>	58-10 <sup>7</sup> / <sub>16</sub>	80-8 <sup>5</sup> / <sub>16</sub>	128-0 <sup>5</sup> / <sub>16</sub>	176-9 <sup>7</sup> / <sub>16</sub>	2-3 <sup>1</sup> / <sub>16</sub>	3-8 <sup>13</sup> / <sub>16</sub>	4-4 <sup>1</sup> / <sub>16</sub>	4-2	1-11 <sup>3</sup> / <sub>16</sub>	201-6 <sup>1</sup> / <sub>2</sub>	402-10 <sup>13</sup> / <sub>16</sub>	1126-8 <sup>1</sup> / <sub>8</sub>
LINE 2	27-1 <sup>1</sup> / <sub>4</sub>	54-3 <sup>3</sup> / <sub>8</sub>	81-3	129-7 <sup>1</sup> / <sub>16</sub>	177-11 <sup>1</sup> / <sub>16</sub>	2-3 <sup>1</sup> / <sub>4</sub>	3-9 <sup>3</sup> / <sub>8</sub>	4-4 <sup>3</sup> / <sub>8</sub>	4-2 <sup>5</sup> / <sub>16</sub>	1-11 <sup>1</sup> / <sub>16</sub>	202-10 <sup>5</sup> / <sub>16</sub>	405-7 <sup>1</sup> / <sub>16</sub>	1134-2 <sup>3</sup> / <sub>8</sub>
LINE 3	29-9 <sup>7</sup> / <sub>16</sub>	57-8 <sup>7</sup> / <sub>16</sub>	81-8 <sup>5</sup> / <sub>16</sub>	130-5 <sup>5</sup> / <sub>16</sub>	179-2 <sup>5</sup> / <sub>16</sub>	2-3 <sup>3</sup> / <sub>8</sub>	3-9 <sup>3</sup> / <sub>8</sub>	4-4 <sup>5</sup> / <sub>8</sub>	4-2 <sup>7</sup> / <sub>16</sub>	1-11 <sup>1</sup> / <sub>2</sub>	204-0 <sup>3</sup> / <sub>16</sub>	408-3 <sup>1</sup> / <sub>16</sub>	1141-8 <sup>1</sup> / <sub>8</sub>
LINE 4	30-0	60-0 <sup>1</sup> / <sub>4</sub>	82-0 <sup>1</sup> / <sub>8</sub>	131-2 <sup>1</sup> / <sub>8</sub>	180-3 <sup>1</sup> / <sub>16</sub>	2-3 <sup>1</sup> / <sub>2</sub>	3-9 <sup>5</sup> / <sub>8</sub>	4-4 <sup>7</sup> / <sub>8</sub>	4-2 <sup>3</sup> / <sub>4</sub>	1-11 <sup>7</sup> / <sub>16</sub>	205-2 <sup>1</sup> / <sub>16</sub>	410-11 <sup>1</sup> / <sub>16</sub>	1149-2 <sup>1</sup> / <sub>8</sub>

SEE SH1 C1A FOR ADD'L INFO.

VERMONT STRUCTURAL STEEL CORPORATION BURLINGTON, VT.				PROJECT RAMP WTS OVER I91		PRINT RECORD	
DRAWN BY	MACS	DATE	8-24-81	LOCATION	WATERFORD VT	NO.	JOB
CHKD BY				CUSTOMER	BECK & BELLUCCI	3	SHOP
HOLS				ARCHITECT	S.O.V. A.O.T.		DATE
BOLTS				JOB NO.	80-3591		
PAINT				SHEET NO.	C1B		

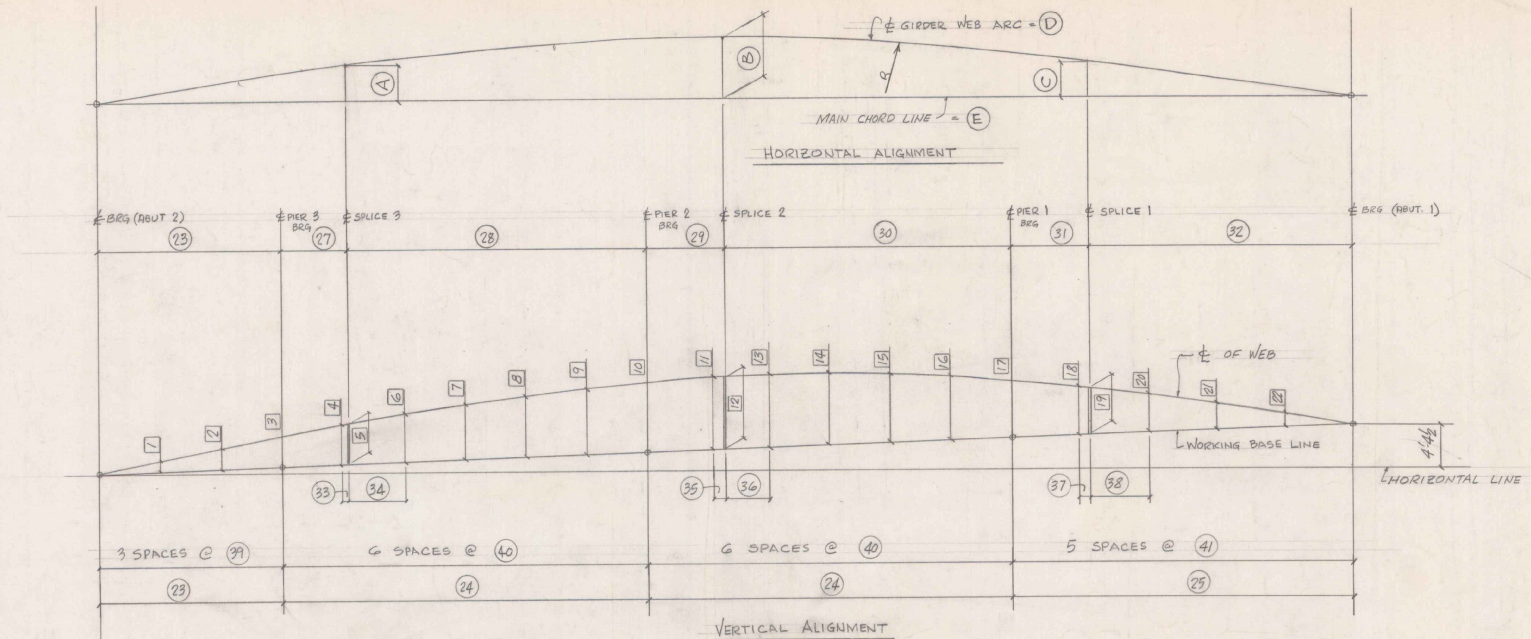

1	2	3	4	5	6	7	8	9	10	11	12	13	14	15	16	17	18	19	20	21	22
2 1/2"	4 7/8"	6 3/8"	8 3/4"	9"	11"	11 1/2"	1' 1"	1' 0 1/8"	1' 0 5/8"	1' 0 13/16"	1' 0 15/16"	1' 1"	1' 0 13/16"	11 1/8"	10 3/4"	9 1/2"	8 3/4"	8 5/8"	8"	6 3/8"	3 3/4"



(23)	(24)	(25)	(26)	(27)	(28)	(29)	(30)	(31)	(32)	(33)	(34)	(35)	(36)	(37)	(38)	(39)	(40)	(41)	(R)
58'-11 1/8"	117'-11 1/8"	110'-11 1/8"		22'-0"	98'-11 1/8"	25'-0"	92'-11 1/8"	24'-6"	85'-7 1/8"	2'-4"	17'-4"	5'-4"	14'-4"	2'-5 1/8"	19'-6 5/8"	19'-8"	19'-8"	22'-6 1/8"	1126'-5 1/8"
59'-4 5/8"	118'-9 1/4"	110'-10 1/2"		22'-0"	96'-9 1/4"	25'-0"	93'-9 1/4"	24'-6"	86'-4 1/8"	2'-2 1/8"	17'-7 1/8"	5'-2 7/8"	14'-7 1/8"	2'-3 1/8"	19'-10 1/8"	19'-9 7/8"	19'-9 7/8"	22'-2 1/8"	1134'-2 1/8"
59'-9 1/16"	119'-6 1/16"	111'-7"		22'-0"	97'-6 1/16"	25'-0"	94'-6 1/16"	24'-6"	87'-1"	2'-0 7/8"	17'-10 1/4"	5'-0 7/8"	14'-10 1/4"	2'-2 1/8"	20'-1 5/8"	19'-11 1/8"	19'-11 1/8"	22'-5 3/8"	1141'-8 1/8"
60'-2 1/16"	120'-4 1/16"	112'-5 3/16"		22'-0"	98'-4 1/16"	25'-0"	95'-4 1/16"	24'-6"	87'-9 13/16"	1'-11 1/16"	18'-1 3/8"	4'-11 1/8"	15'-1 3/8"	2'-0 7/8"	20'-5 1/8"	20'-0 1/16"	20'-0 1/16"	22'-5 3/8"	1149'-4 1/8"

	(A)	(B)	(C)	(D)	(E)	
LINE 1	11'-7 1/4"	18'-1 1/8"	12'-1 1/8"	405'-0 1/8"	402'-10 1/8"	20.5717°
LINE 2	11'-7 1/8"	18'-3 3/8"	12'-2 1/8"	407'-9 1/8"	405'-7"	20.5798°
LINE 3	11'-8 1/16"	18'-4 1/4"	12'-3 1/8"	410'-5 1/8"	408'-5 1/8"	20.5799°
LINE 4	11'-9 1/8"	18'-6 1/4"	12'-4 1/8"	413'-2"	410'-1 1/8"	20.5797°

FOR SHOP NOTES  
SEE DWG. E 1



VERMONT STRUCTURAL STEEL CORPORATION BURLINGTON, VT. FAX I 93-1(3) 9/3			
DATE	PROJECT	RAMP W/T'S OVER I 91	PRINT RECORD
DRAWN BY: CB	LOCATION	WATERFORD, VT.	NO. FOR DATE
CHK BY: SW/S	CUSTOMER	BECK & BELLUCCI	5 800 6-6
HOURS	ARCHITECT	S.O.V. A.O.T	6 800 6-12
PAINT	JOB NO.	80-3571	6 800 6-24
	SHEET NO.	C1	

N.C.

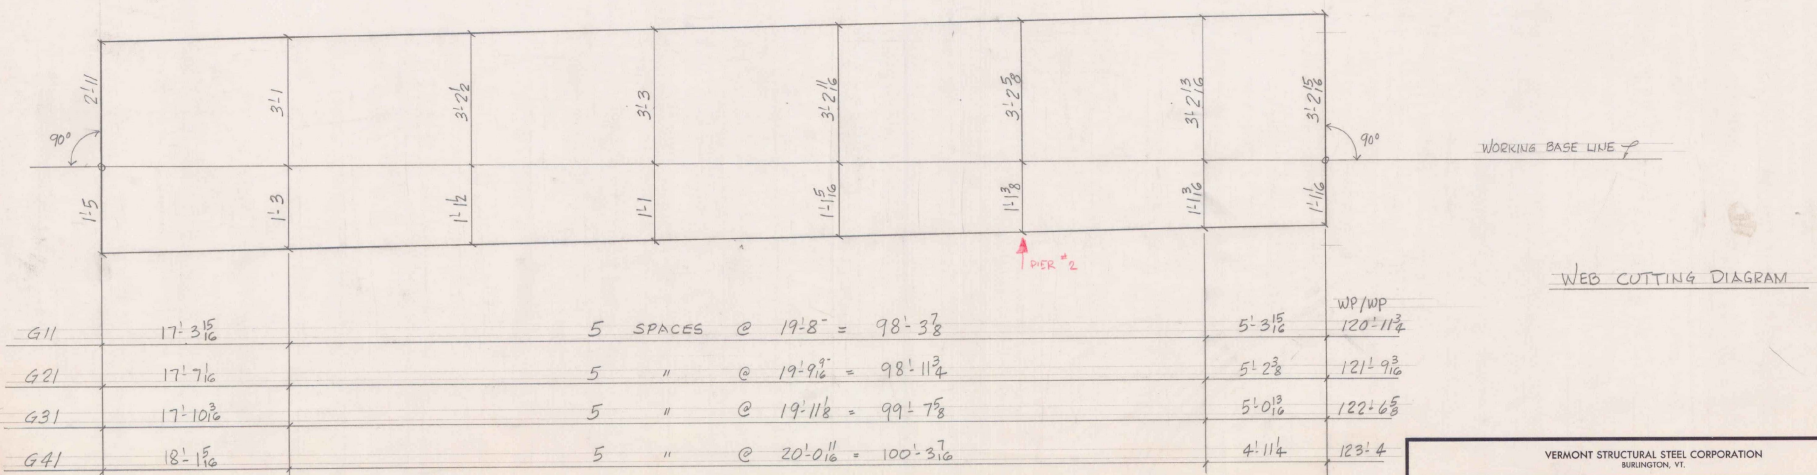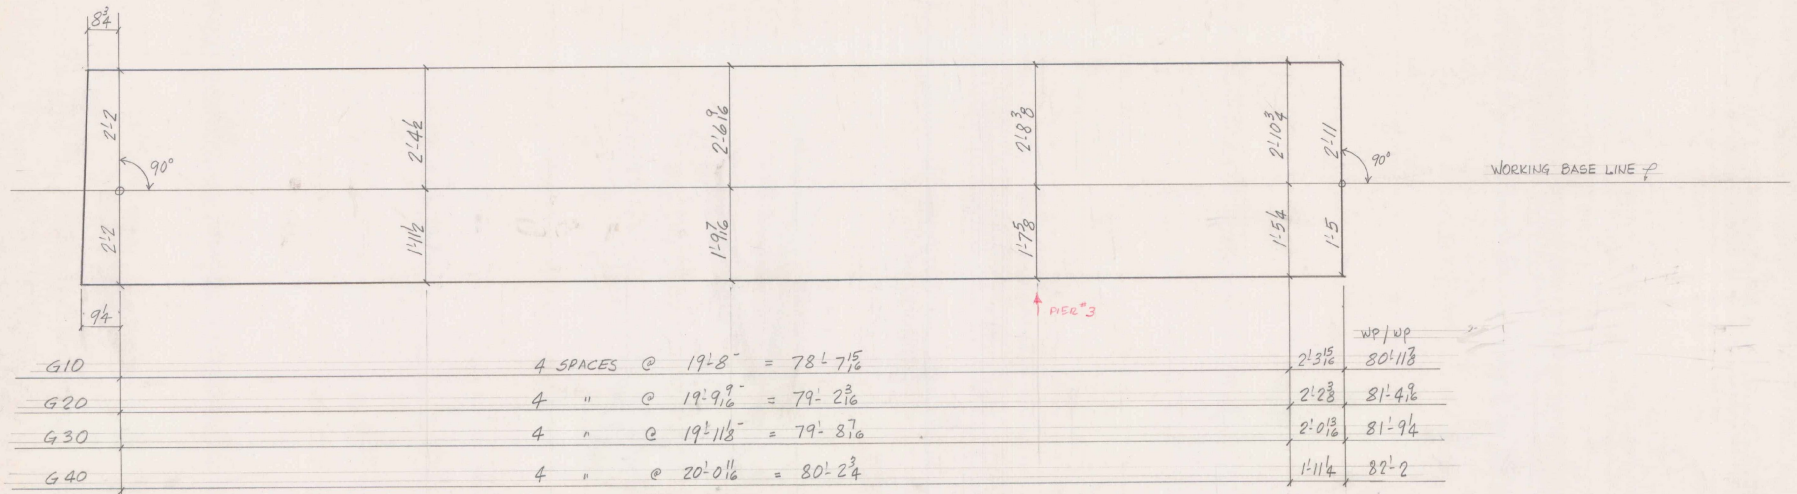

WEB CUTTING DIAGRAM



VERMONT STRUCTURAL STEEL CORPORATION BURLINGTON, VT.			
PROJECT	RAMP W/TS OVER I-91	NO.	PRINT RECORD
LOCATION	WATERFOOD, VT.	FOR	DATE
CUSTOMER	BECK & BELLUCCI	5	6-23
ARCHITECT	S.O.V.A.D.T.	6	6-24
JOB NO.	80-3591	3	32P 7-16
SHEET NO.	C2		

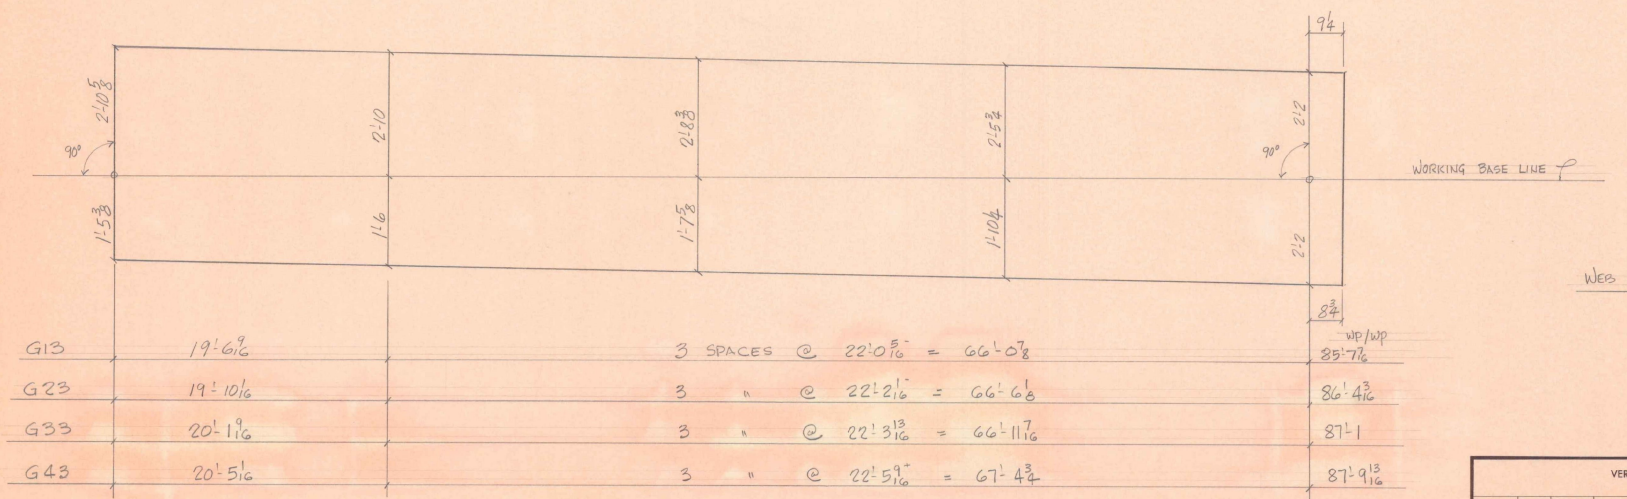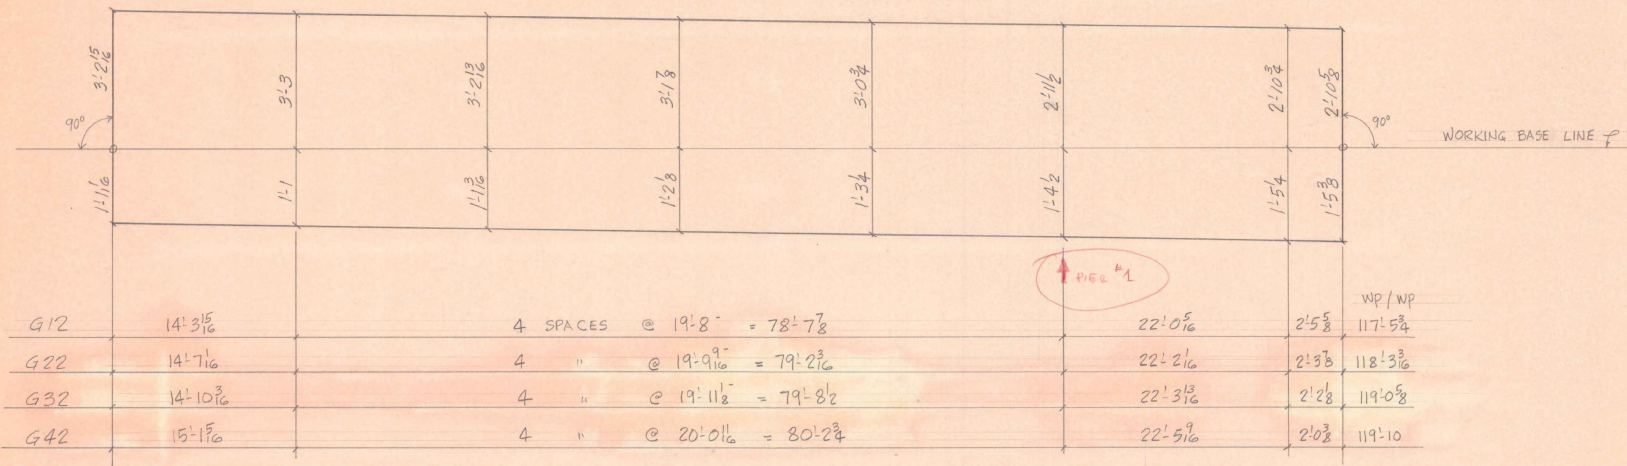

VERMONT STRUCTURAL STEEL CORPORATION  
BURLINGTON, VT

PROJECT	RAMP W/DS OVER I91	DATE	
LOCATION	WATERFORD, VT.	NO.	
CUSTOMER	BECK & BELLUCCI	FOR	
ARCHITECT	S.O.V.A.C.T.	DATE	
JOB NO.	80-3591	SHEET NO.	C3

NO.	FOR	DATE
5	APP	6-23
6	SHOP	6-24
3	SHOP	6-17

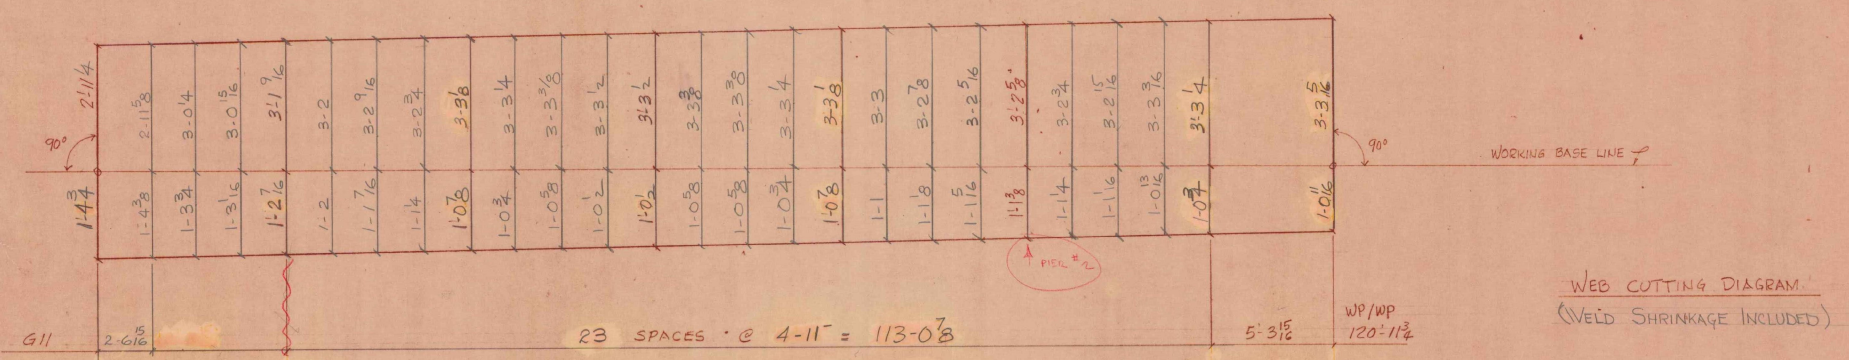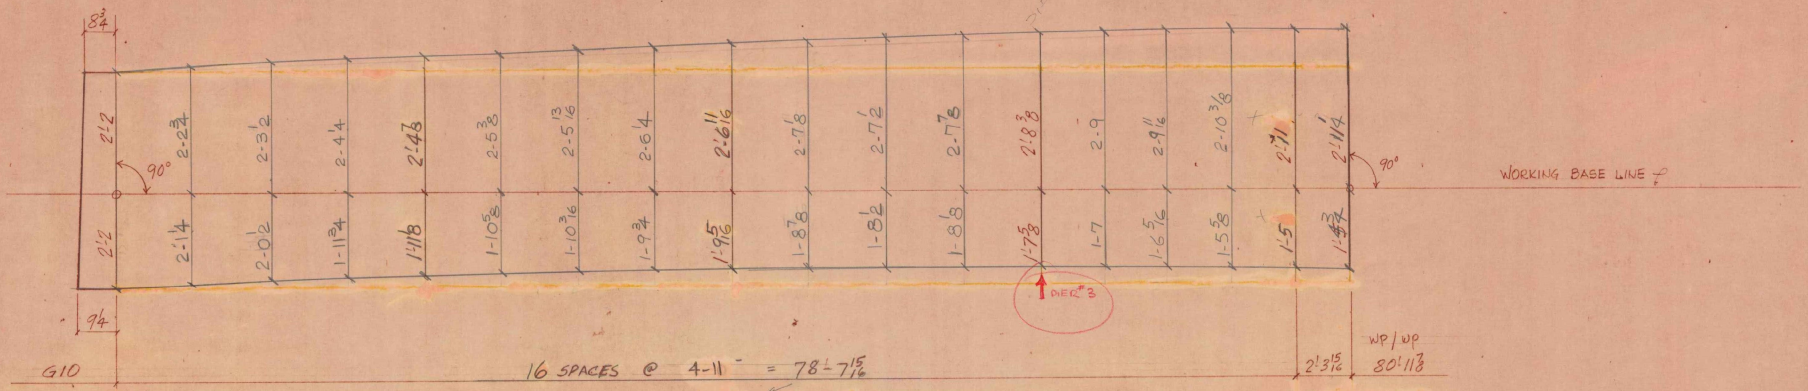

LINE 1

DRAWN BY		DATE	PROJECT	PRINT RECORD
CHECK BY			LOCATION	NO.
			CUSTOMER	FOR
				DATE
HOLD		ARCHITECT		
NOTE		JOB NO.	SHEET NO.	
PAINT				

VERMONT STRUCTURAL STEEL CORPORATION  
BURLINGTON, VT.

PROJECT RAMP WTS OVER I91

LOCATION WATERFORD, VT.



CUSTOMER BECK & BELLUCCI

ARCHITECT S.O.V.A.O.T.

JOB NO. 80-3591 SHEET NO. CA



3 6/28 77



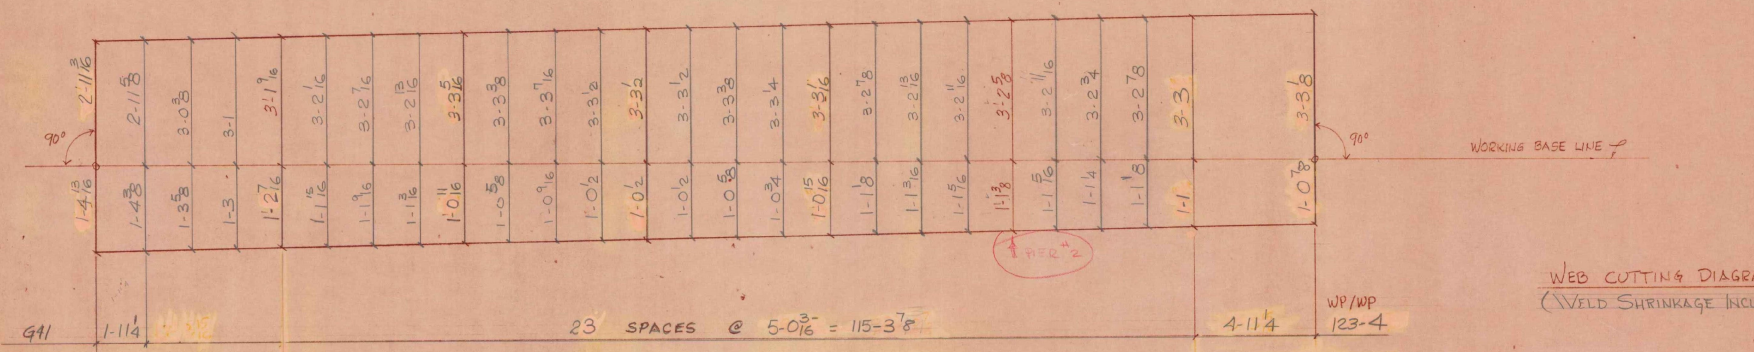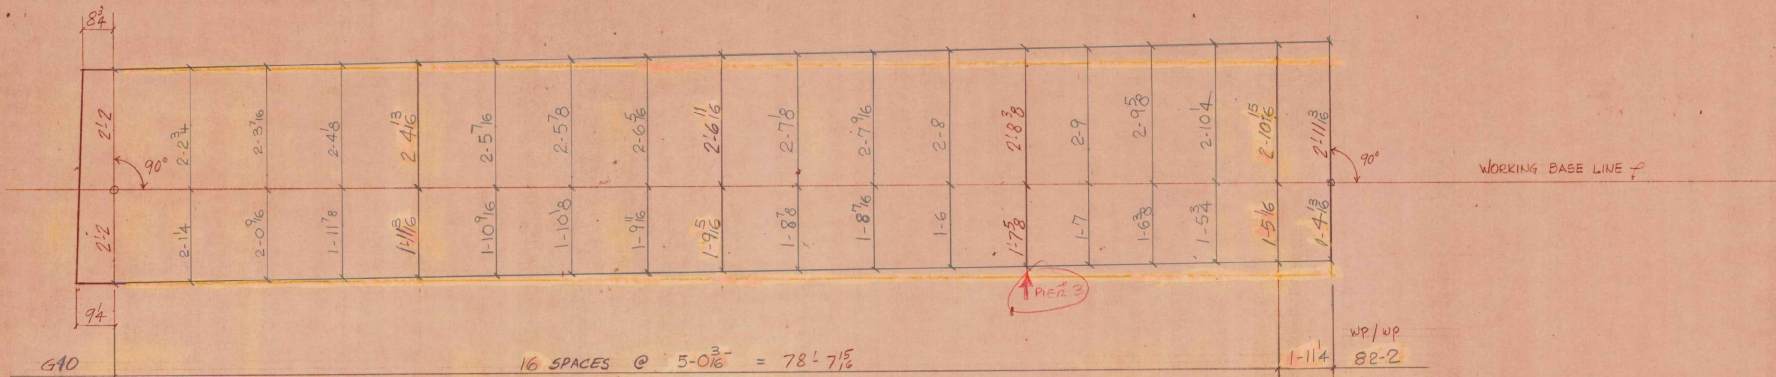

LINE 4

VERMONT STRUCTURAL STEEL CORPORATION BURLINGTON, VT.				PRINT RECORD	
DRAWN BY	DATE	PROJECT	NO.	FOR	DATE
C.B.		RAMP W TO S OVER I91	3	5/20/76	
CHK'D BY		LOCATION			
		WATERFORD, VT.			
		CUSTOMER			
		BECK & BELLUCCI			
HOLES		ARCHITECT			
		S.O.V.A.O.T.	C6		
BOLTS		JOB NO.	80-3591	SHEET NO.	25
PAINT					

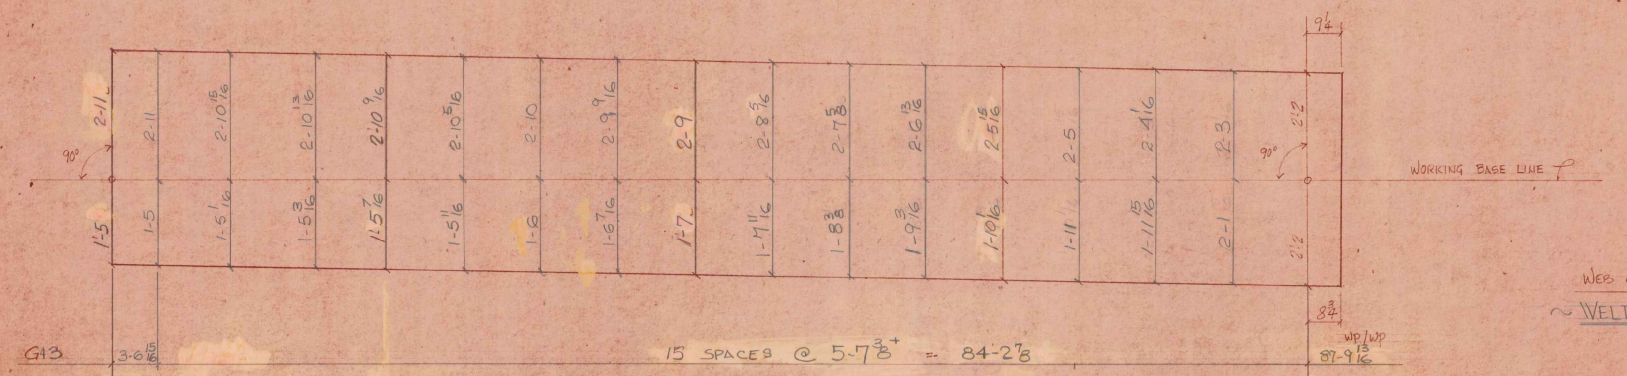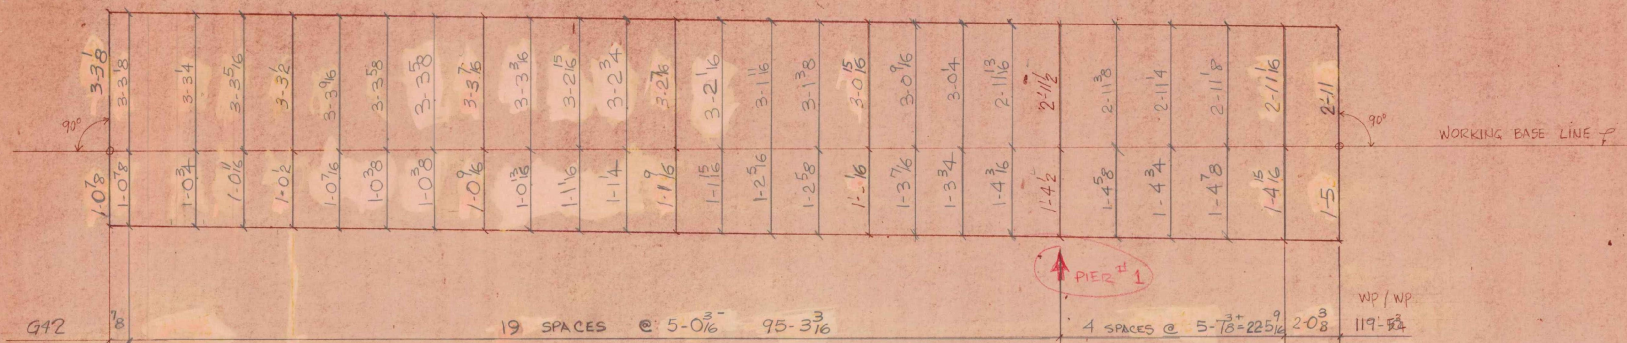

LINE 4

WEB CUTTING DIAGRAM  
 ~ WELD SHRINKAGE INCLUDED ~

VERMONT STRUCTURAL STEEL CORPORATION BURLINGTON, VT.			
PROJECT	CAMP WTPS OVER I91	NO.	105
LOCATION	WATERFORD, VT.	REV.	1
CUSTOMER	BEEL & BELLUCCI	DATE	3/20/72
ARCHITECT	SOV. A.O.T.	SHEET NO.	26
JOB NO.	80-3911		

















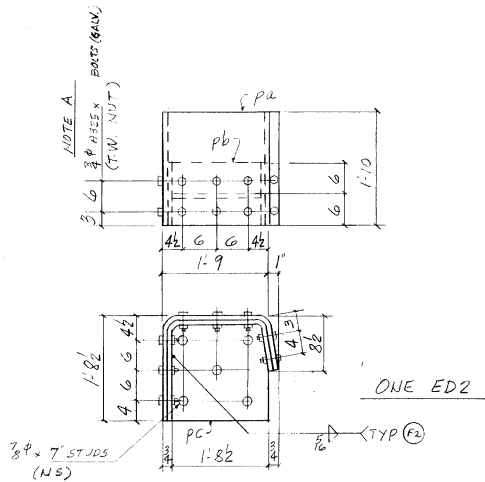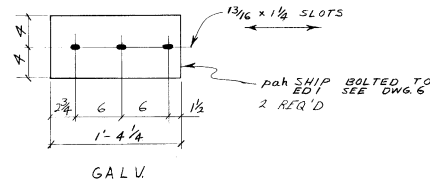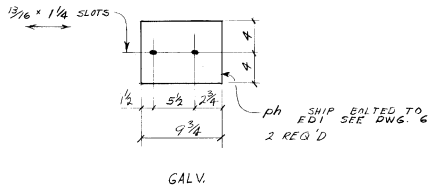

ONE ED3

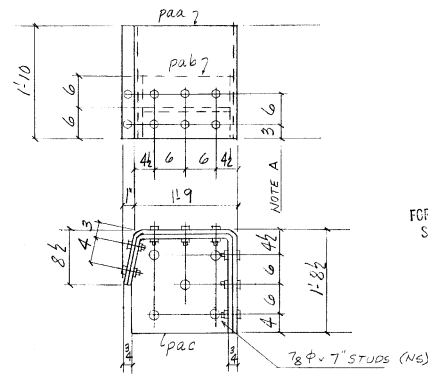

NOTE  
HOT DIP GALVANIZE AFTER FABRICATION  
PER ASTM-A123.  
SEE SMT B 1/2 → PAINT GRAY (FED. COLOR 26413)  
FOR SAMP.  
SHOP ASSEMBLE TO JOINT ED1, SMT 7

WORK WITH DWG. 627

ASTM-A36		BILL OF MATERIAL			
NO. REQ'D	MARK	DESCRIPTION	LENGTH		WEIGHT
			FT	IN.	
1	ED3				
1	pa	12 3/8 x 22	4	3	(119)
1	pb	12 3/8 x 12	4	12	(63)
1	pc	12 3/8 x 19 3/4	1	8 1/2	(43)
5		7/8\"/>			
16		3/4\"/>			
2	ph	12 3/8 x 8 GALV	0	9 3/4	(7)
2	pah	12 3/8 x 8 GALV	1	4 1/2	(44)
					(241)
					(285)

ASTM-A36		BILL OF MATERIAL			
NO. REQ'D	MARK	DESCRIPTION	LENGTH		WEIGHT
			FT	IN.	
1	ED2				
1	pa	12 3/8 x 22	4	3	(119)
1	pb	12 3/8 x 12	4	12	(63)
1	pc	12 3/8 x 19 3/4	1	8 1/2	(43)
5		7/8\"/>			
16		3/4\"/>			
					(7)
					(9)
					(241)

REVISION RECORD			
DATE	REV. #	BY	REVISION
6-9-81	A	LIB	ED2A & ED3A REMOVED SEE SMT B 9/6

VERMONT STRUCTURAL STEEL CORPORATION			
BURLINGTON, VERMONT		FAP I 93-1(3) 9/3	
DATE	3/81	PROJECT	RAMP N to S OVER I 91
DRAWN BY	CJB	LOCATION	WATERFORD, VT
CHECKED BY	SUD	CUSTOMER	BECK & BELLUCCI
SCALE		ARCHITECT	S.O.V.A.O.T.
PART	GALV PL	JOB NO.	80-3591-63
NOTE		SHEET NO.	8/6

PRINT RECORD		
NO.	FOR	DATE
5	APP	5-1
30	SHP	6-1
50	APP	6-23
30	SHP	6-29
3	Shop	7/23/81









































Vermont Agency of  
Transportation  
PHASE 1-INTERSTATE  
#122302-01  
INITIALS   
HANGER 374 ONE

BR1 BR5MS BR6,7,8,17,11,12  
13,14,15,16,17,18,19,20,22  
23  
\* 1979

Vernon ~ Rockingham  
IR-91-1 (3)