


# PROJECT DESCRIPTION AND LOCATION

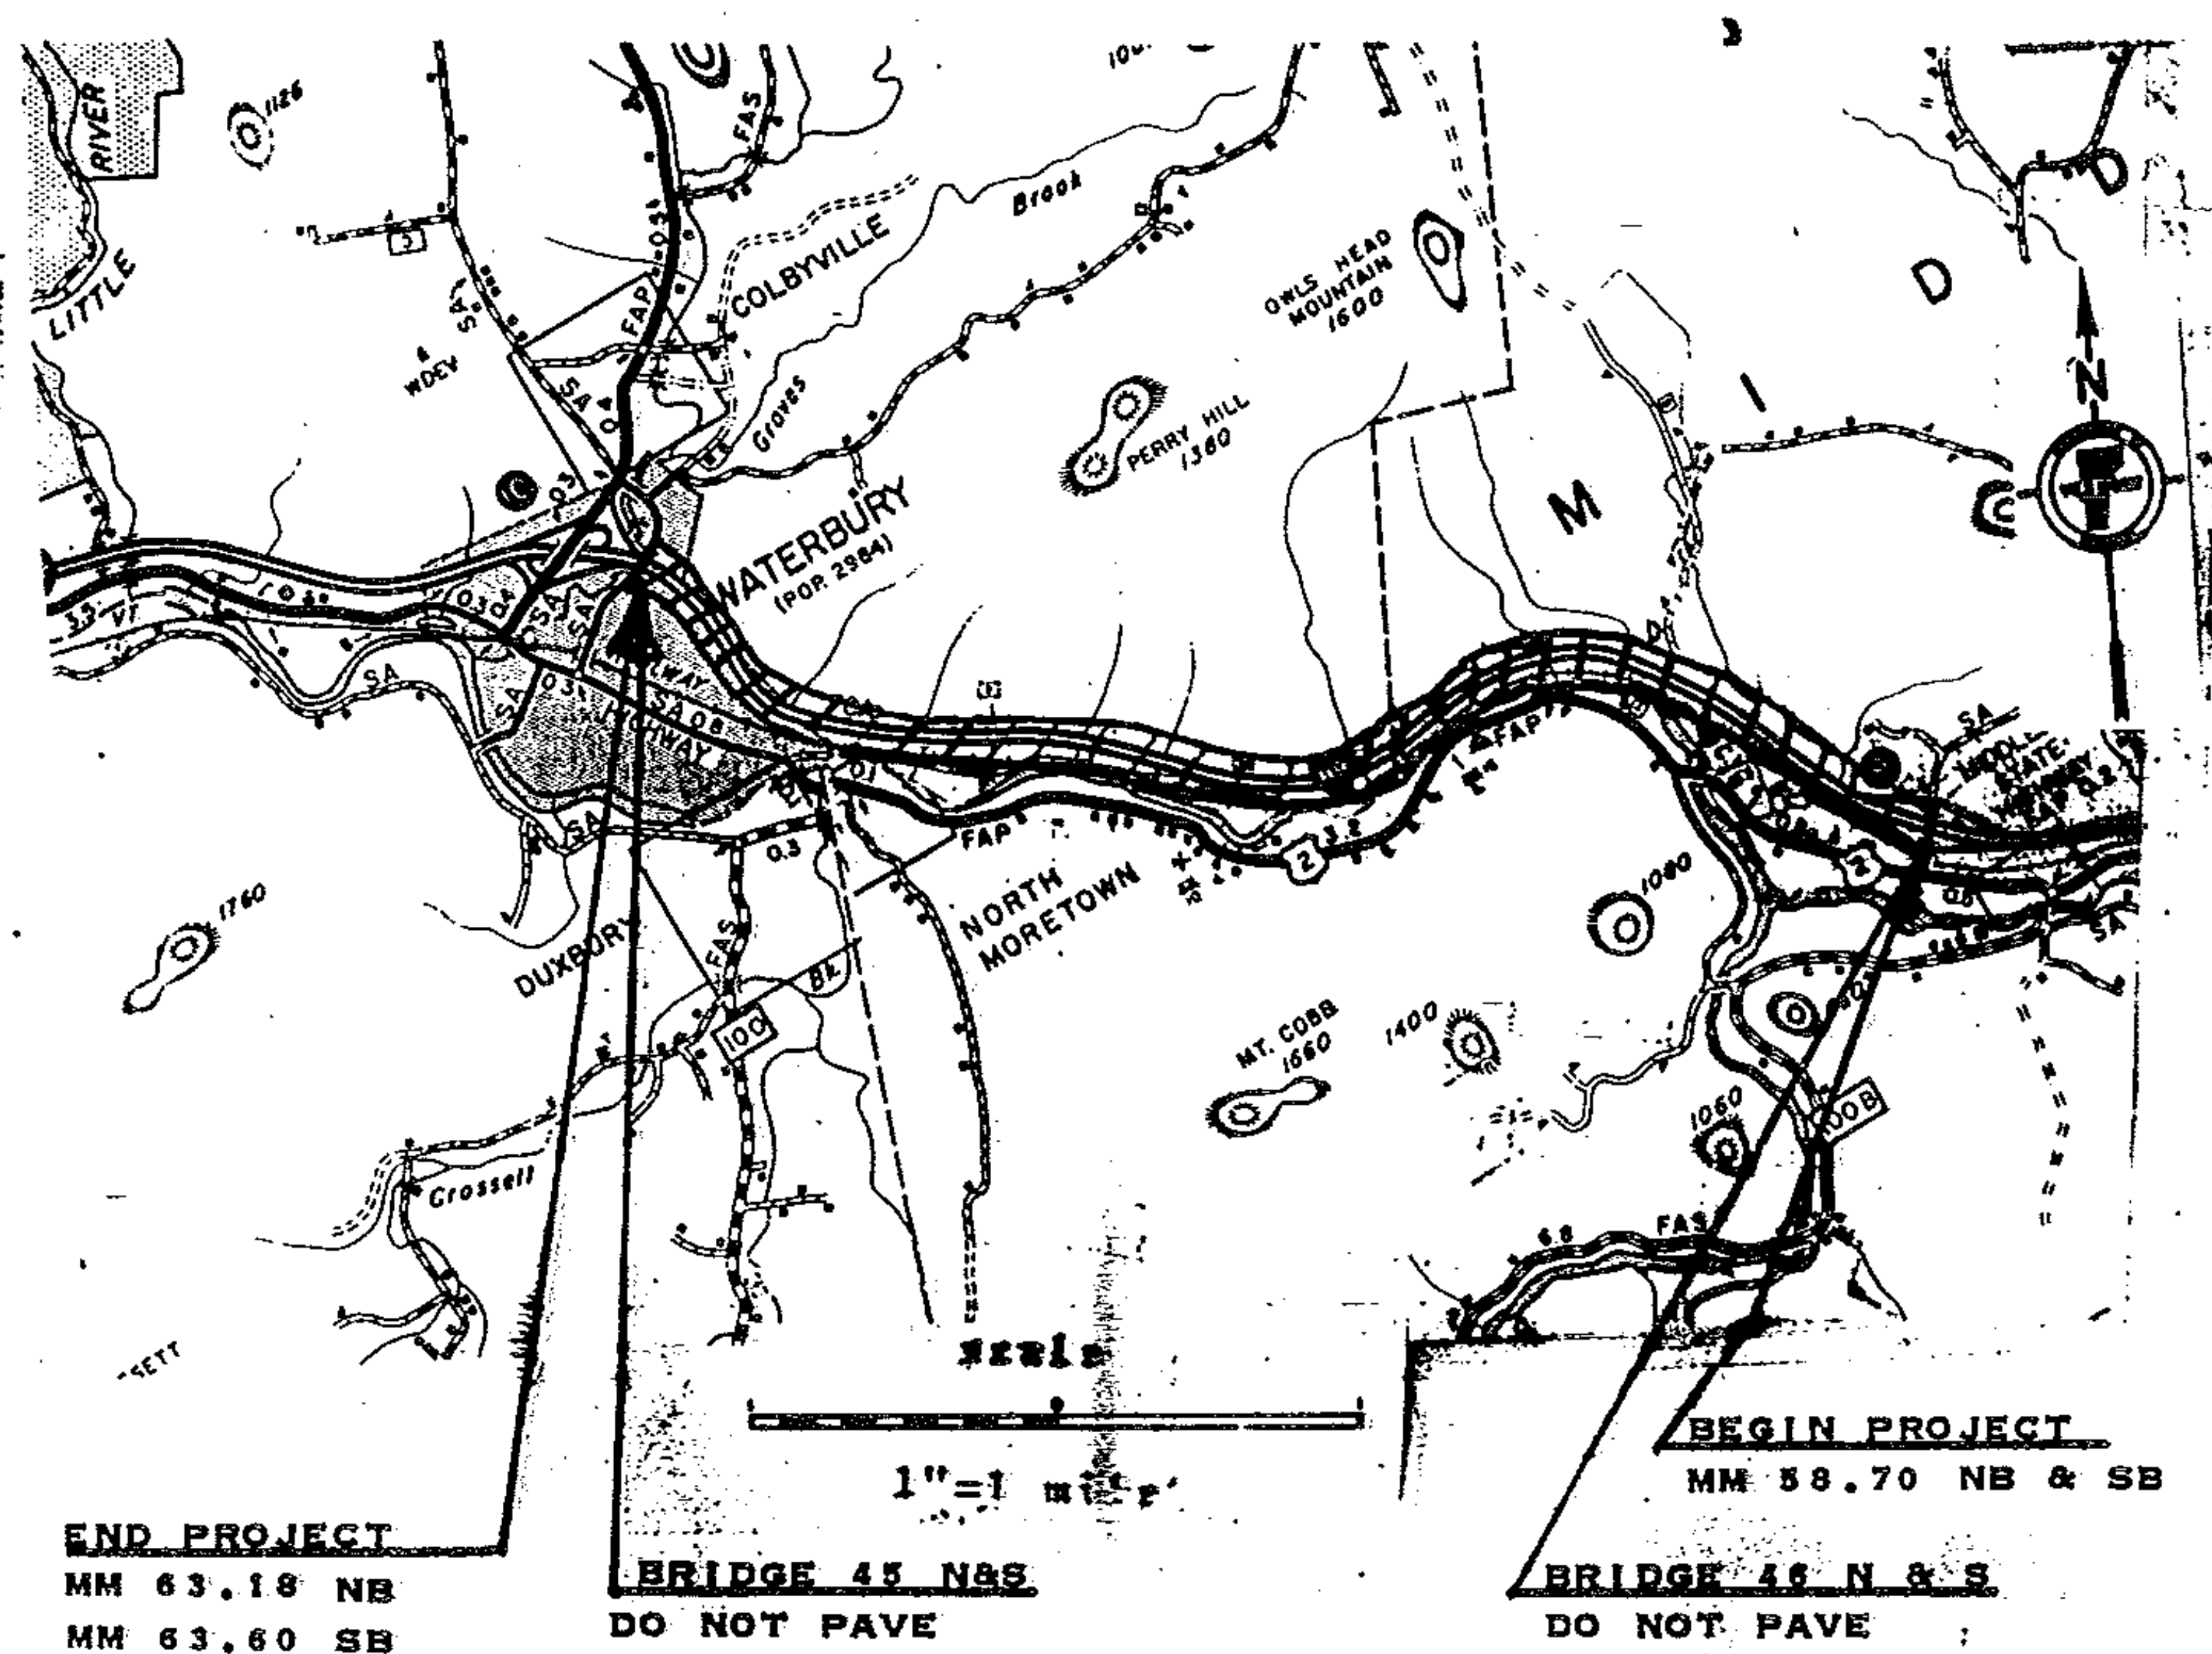

I 89 NORTHBOUND BEGINNING IN THE TOWN OF MIDDLESEX AT THE MIDDLESEX INTERCHANGE AT MM 58.70 AND EXTENDING 4.48 MILES TO MM 63.18 IN THE TOWN OF WATERBURY.

SOUTHBOUND BEGINNING IN THE TOWN OF MIDDLESEX AT THE MIDDLESEX INTERCHANGE AT MM 58.70 AND EXTENDING 4.90 MILES TO MM 63.60 IN THE TOWN OF WATERBURY.

ALSO RAMPS C AND D AT INTERCHANGE #9 AND PAVE ALL U-TURNS.

LENGTH OF PROJECT  
NORTHBOUND 4.48 MILES = 23654 FEET  
SOUTHBOUND 4.90 MILES = 25872 FEET

PROJECT MIDDLESEX-WATERBURY

NO. IR 089-2(6)

SHEET 3 OF 24 SHEETS