


TYPICAL SECTIONS & DESIGN DATA

AS DIRECTED BY THE ENGINEER
ITEM 406.25 BITUMINOUS CONCRETE PAVEMENT
1/2" LEVELING COURSE TYPE III OR IV
1 1/2" WEARING COURSE ($\pm 1/4"$) TYPE III

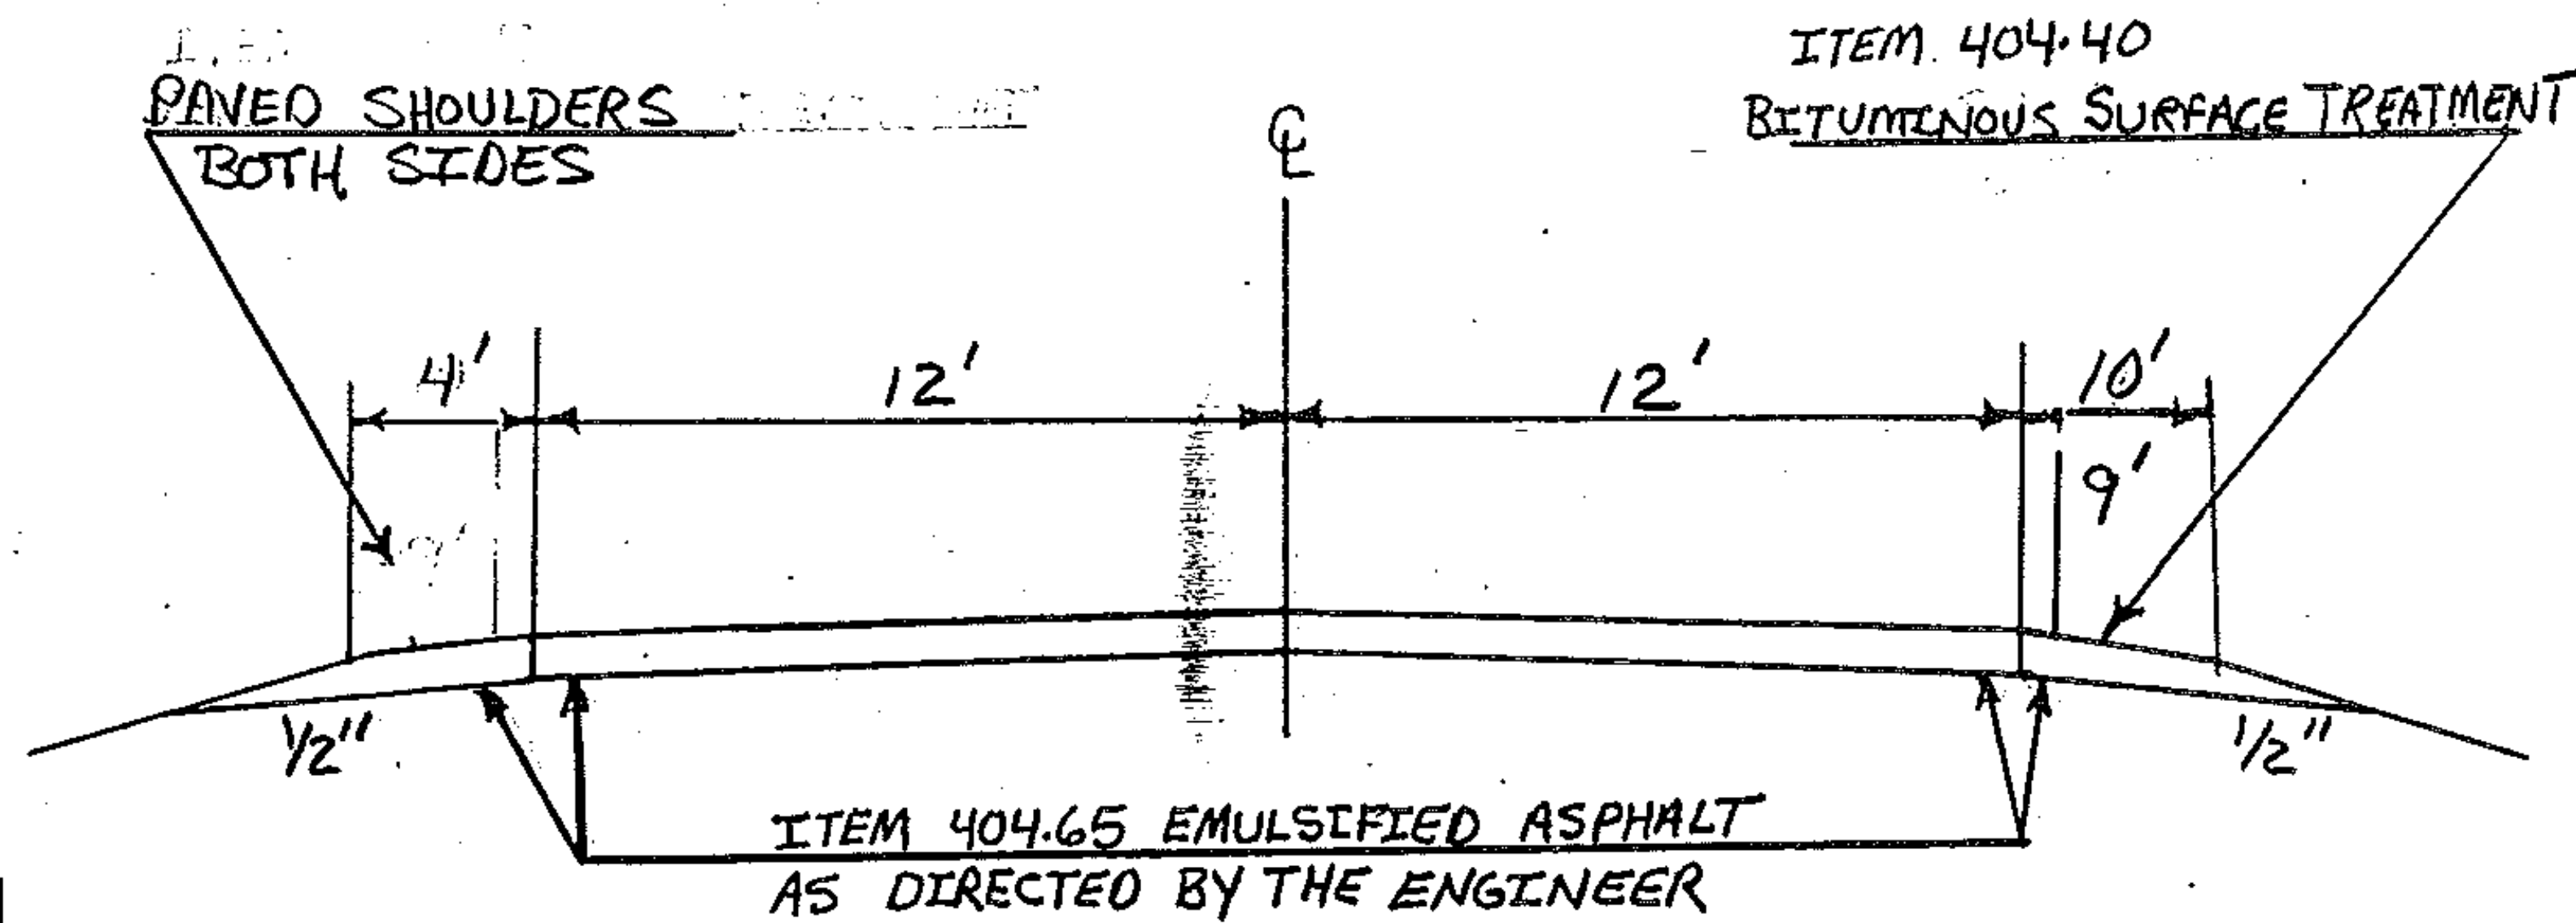

NORTHBOUND MM 58.70 ~ MM 61.5.0

1984 ADT 11300
V = 55

Note: Topsoil, Item 653.10 to be applied as directed by the Engineer.

PROJECT MIDDLESEX-WATERBURY

NO. IR 089-2(6)
SHEET 4 OF 34