


SECTION E - E  
SCALE 1/4"=1'-0"

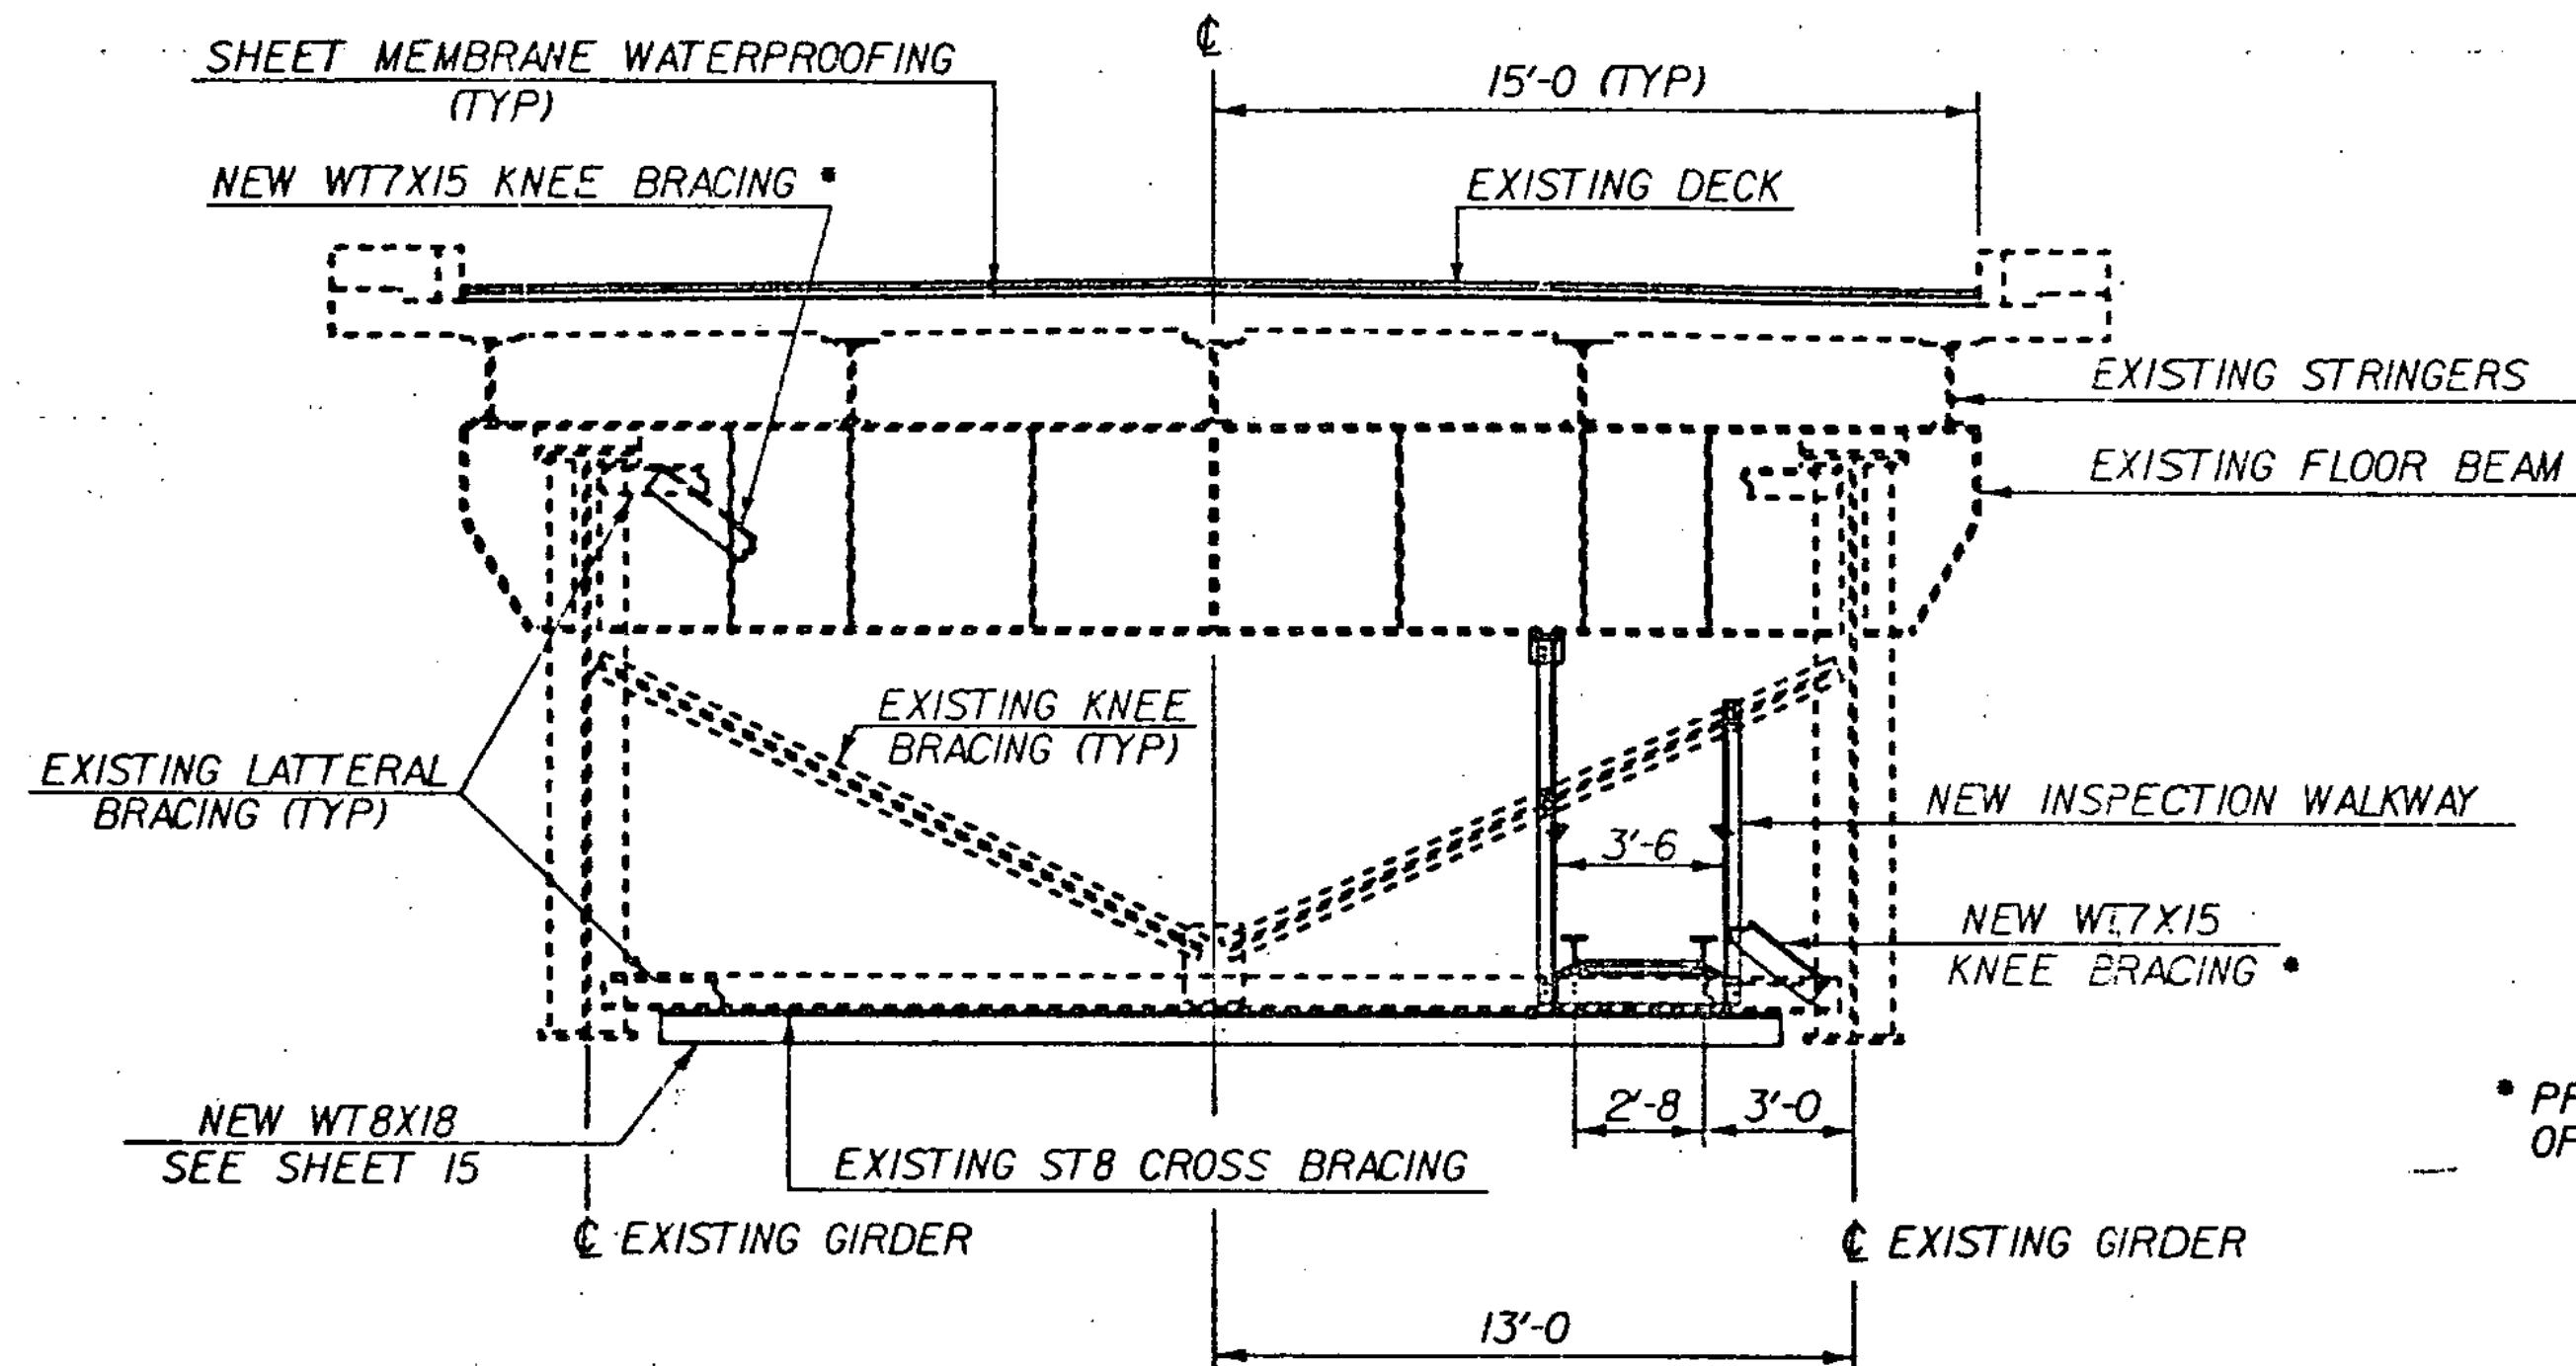


SECTION F - F  
SCALE 1/4"=1'-0"

\* PRECEEDING FLOOR BEAM SIMILAR EXCEPT OPPOSITE HAND FOR KNEE BRACING ONLY.


THESE SECTIONS TYPICAL FROM F.B.\*21-45 FOR THE INSPECTION WALKWAY.  
THESE SECTIONS TYPICAL FROM F.B.\*20-46 FOR THE NEW KNEE BRACING.

NOTES

1. SEE SHEET 4 FOR LOCATION OF SECTIONS.
2. FOR INSPECTION WALKWAY DETAILS SEE SHEETS 11-15.
3. FOR KNEE BRACING DETAILS SEE SHEETS 16-18.

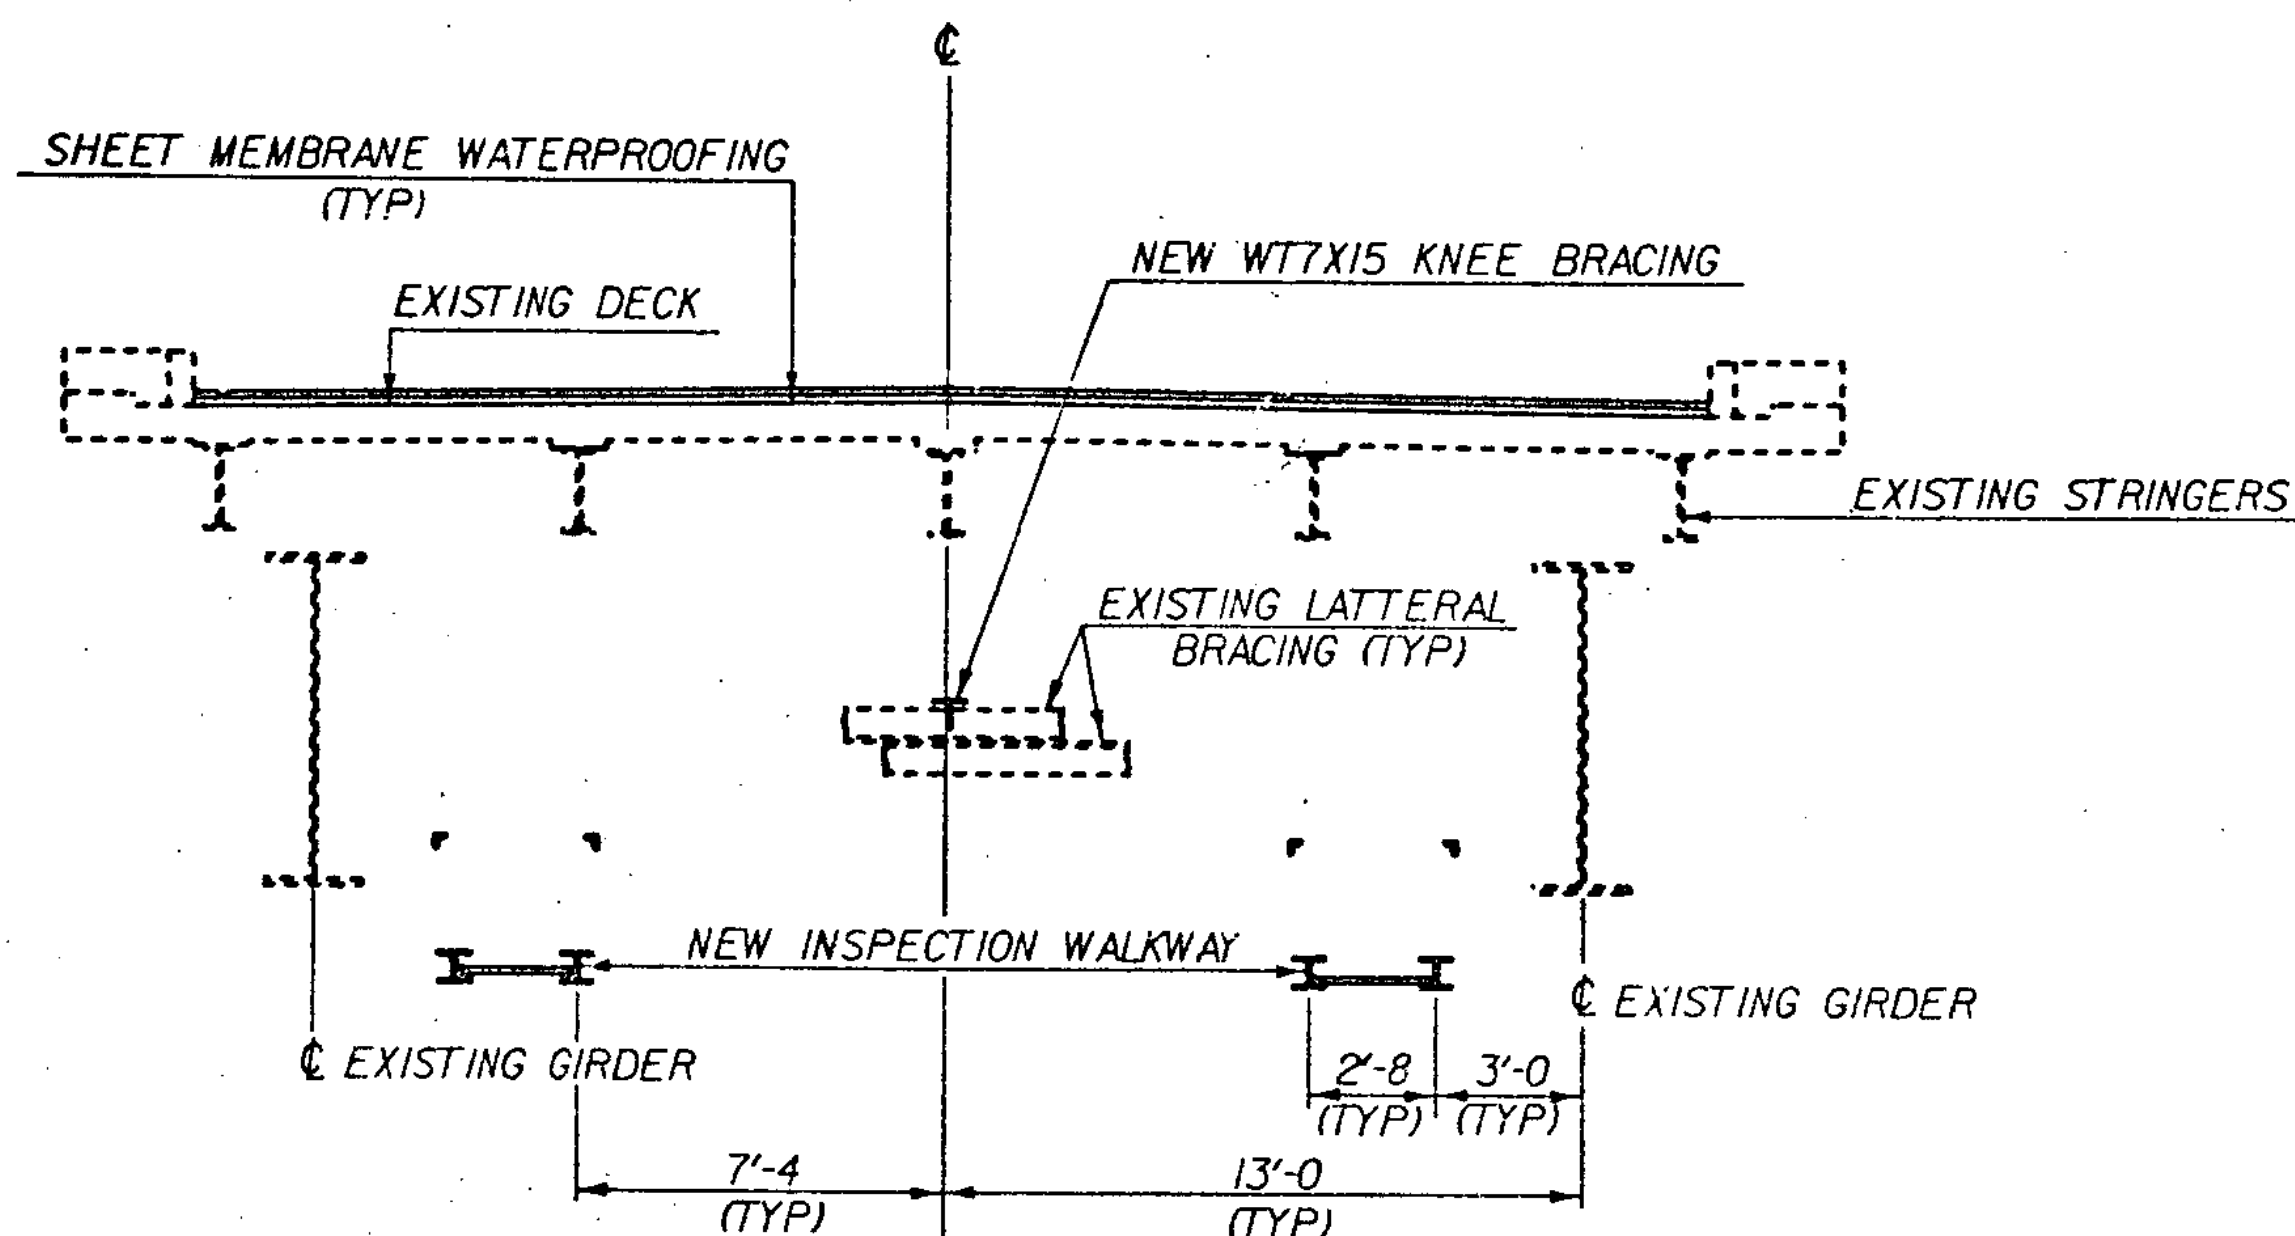

SECTION G - G  
SCALE 1/4"=1'-0"

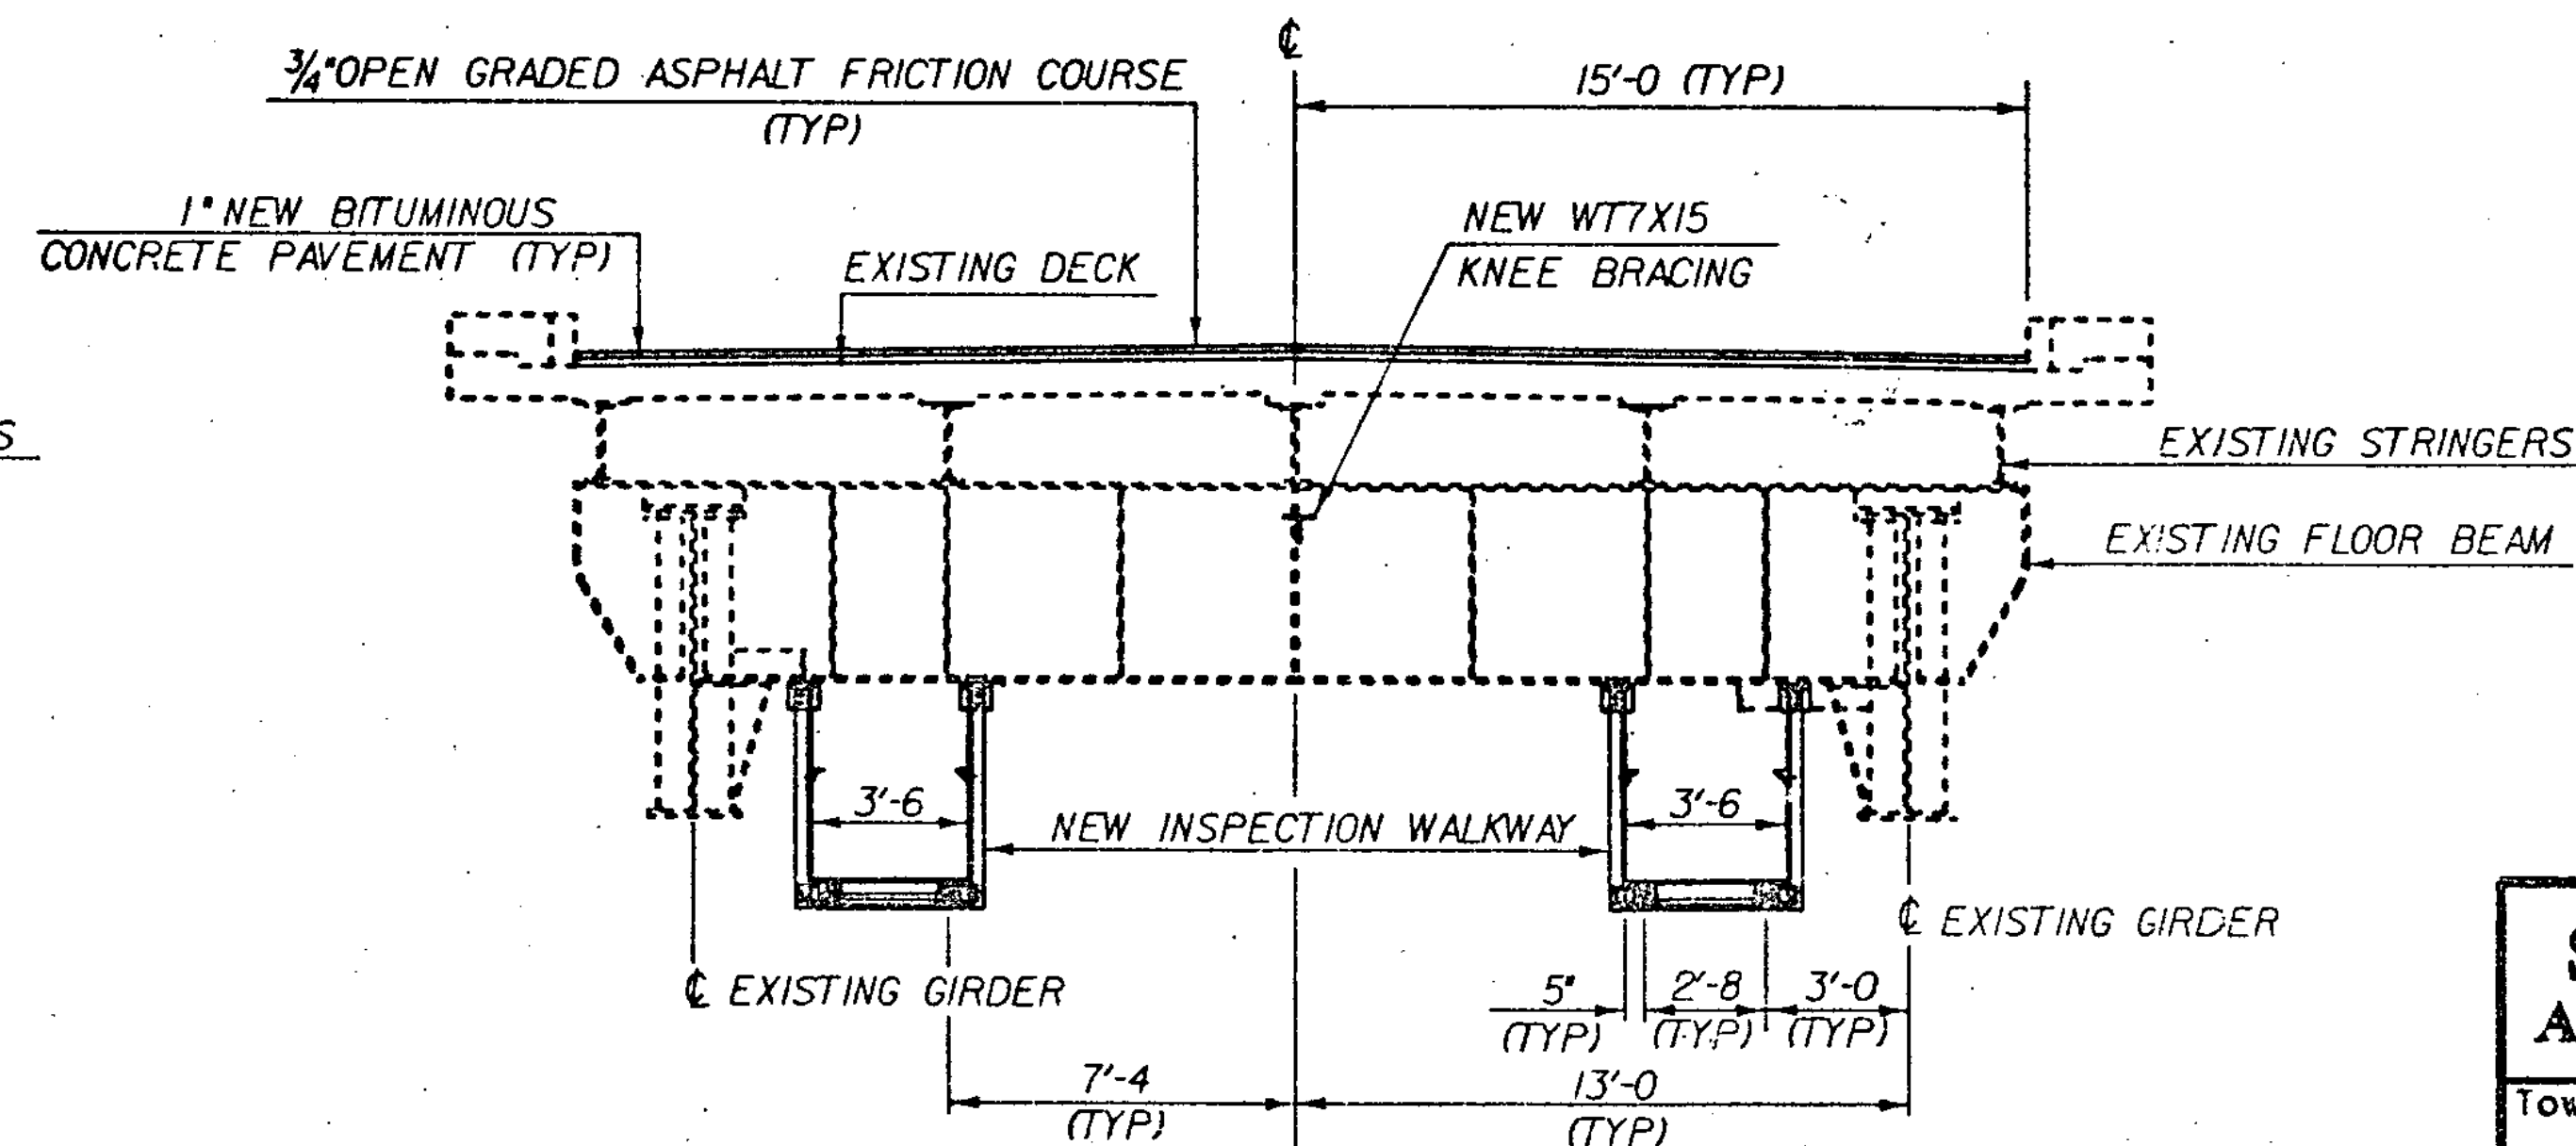

SECTION H - H  
SCALE 1/4"=1'-0"

STATE OF VERMONT  
AGENCY OF TRANSPORTATION

Town Of	HARTFORD	Bridge No.	44 N&S
Highway No.	191	Log Sta.	
		Surv. Sta.	
TYPICAL SECTIONS			
191 OVER THE WHITE RIVER, U.S. RTE. 4 AND VT. RTE. 14			
Designed By	A. ELWOOD	Drawn By	D. C. WILLEY
Checked By	A. ELWOOD	Date	7-27-84
		Bridge Design Supervisor	R. S. HAUPT Date 7-84
PROJECT	HARTFORD	PROJECT NO.	1R-91-2 (1)
I.G.C. Info.	QSAI13025382A15F.P.DGN		
Bridge Sheet No.		Sheet	6 of 30