



SECTION D - D

SCALE 1/2" = 1'-0"

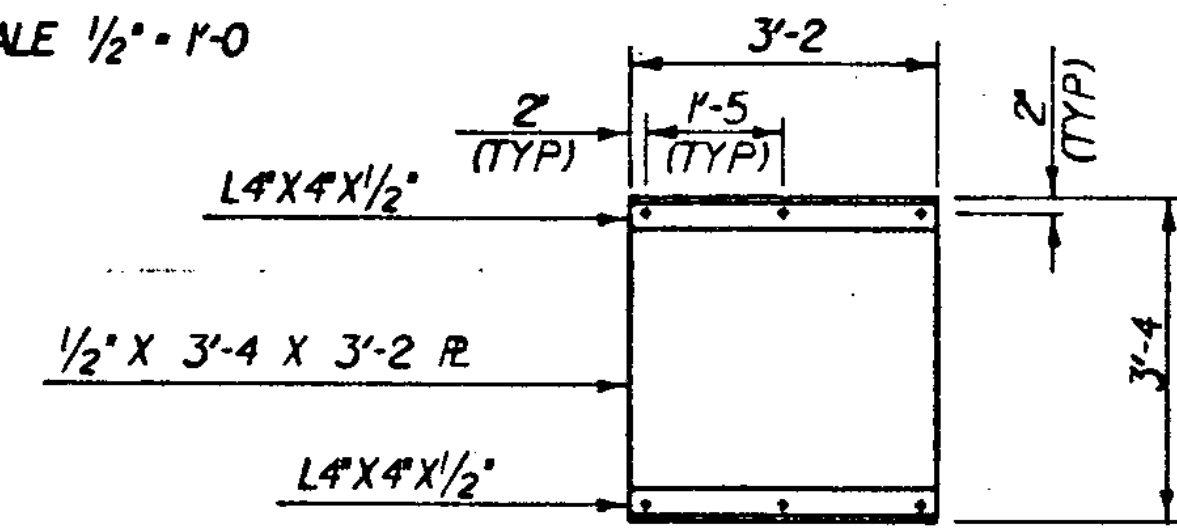


FLOOR PLATE DETAIL

SCALE 1/2" = 1'-0"

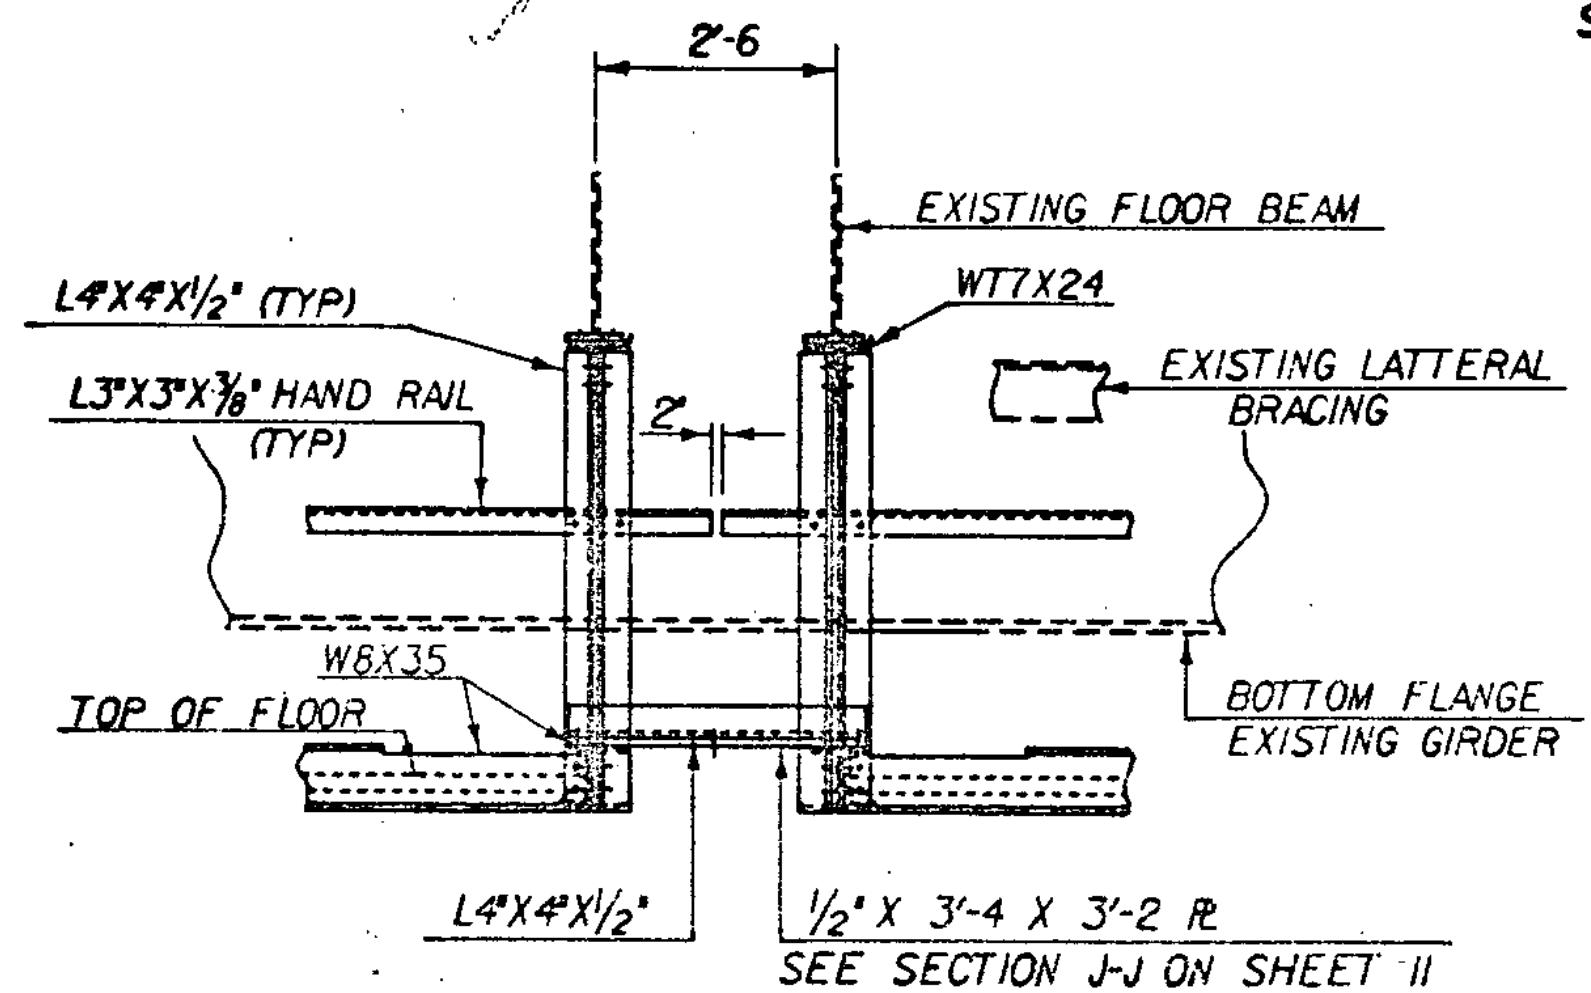


SECTION P - P

SCALE 1/2" = 1'-0"

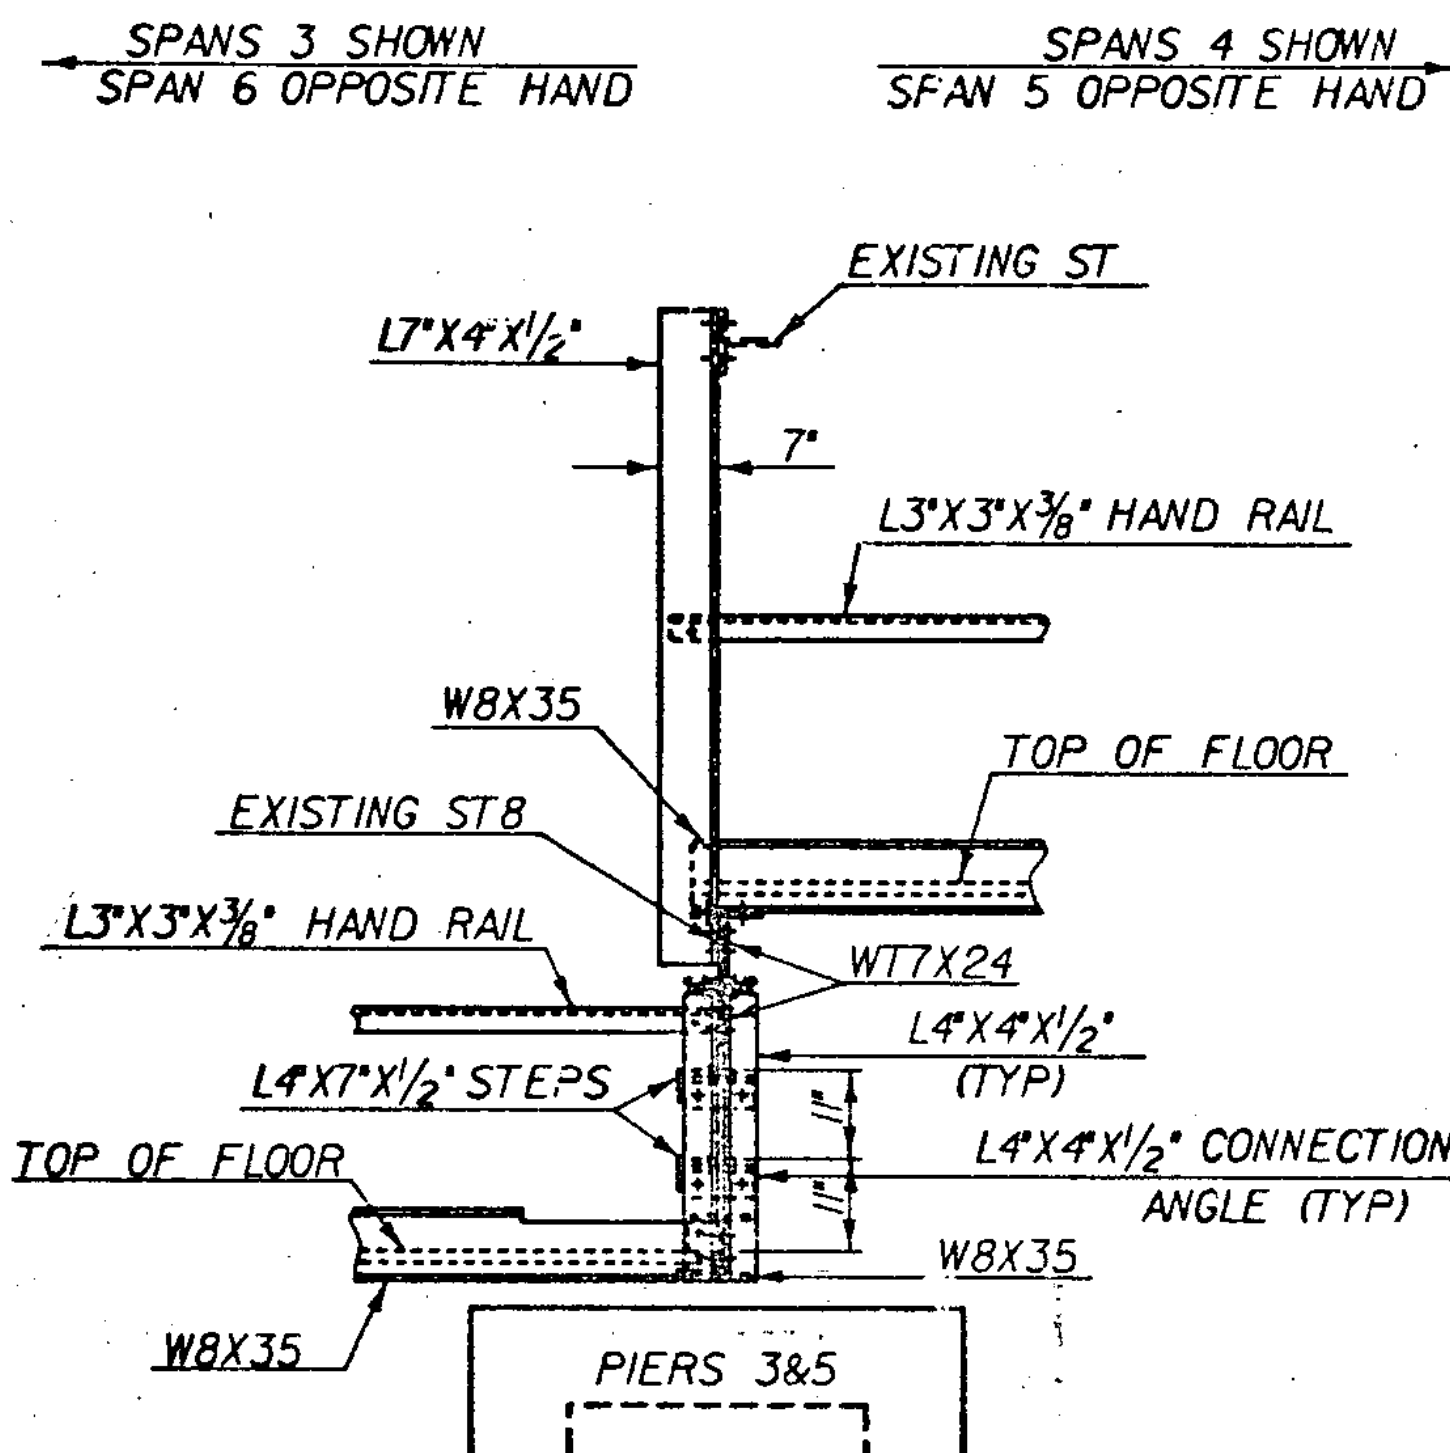

SECTION E - E

SCALE 1/2" = 1'-0"

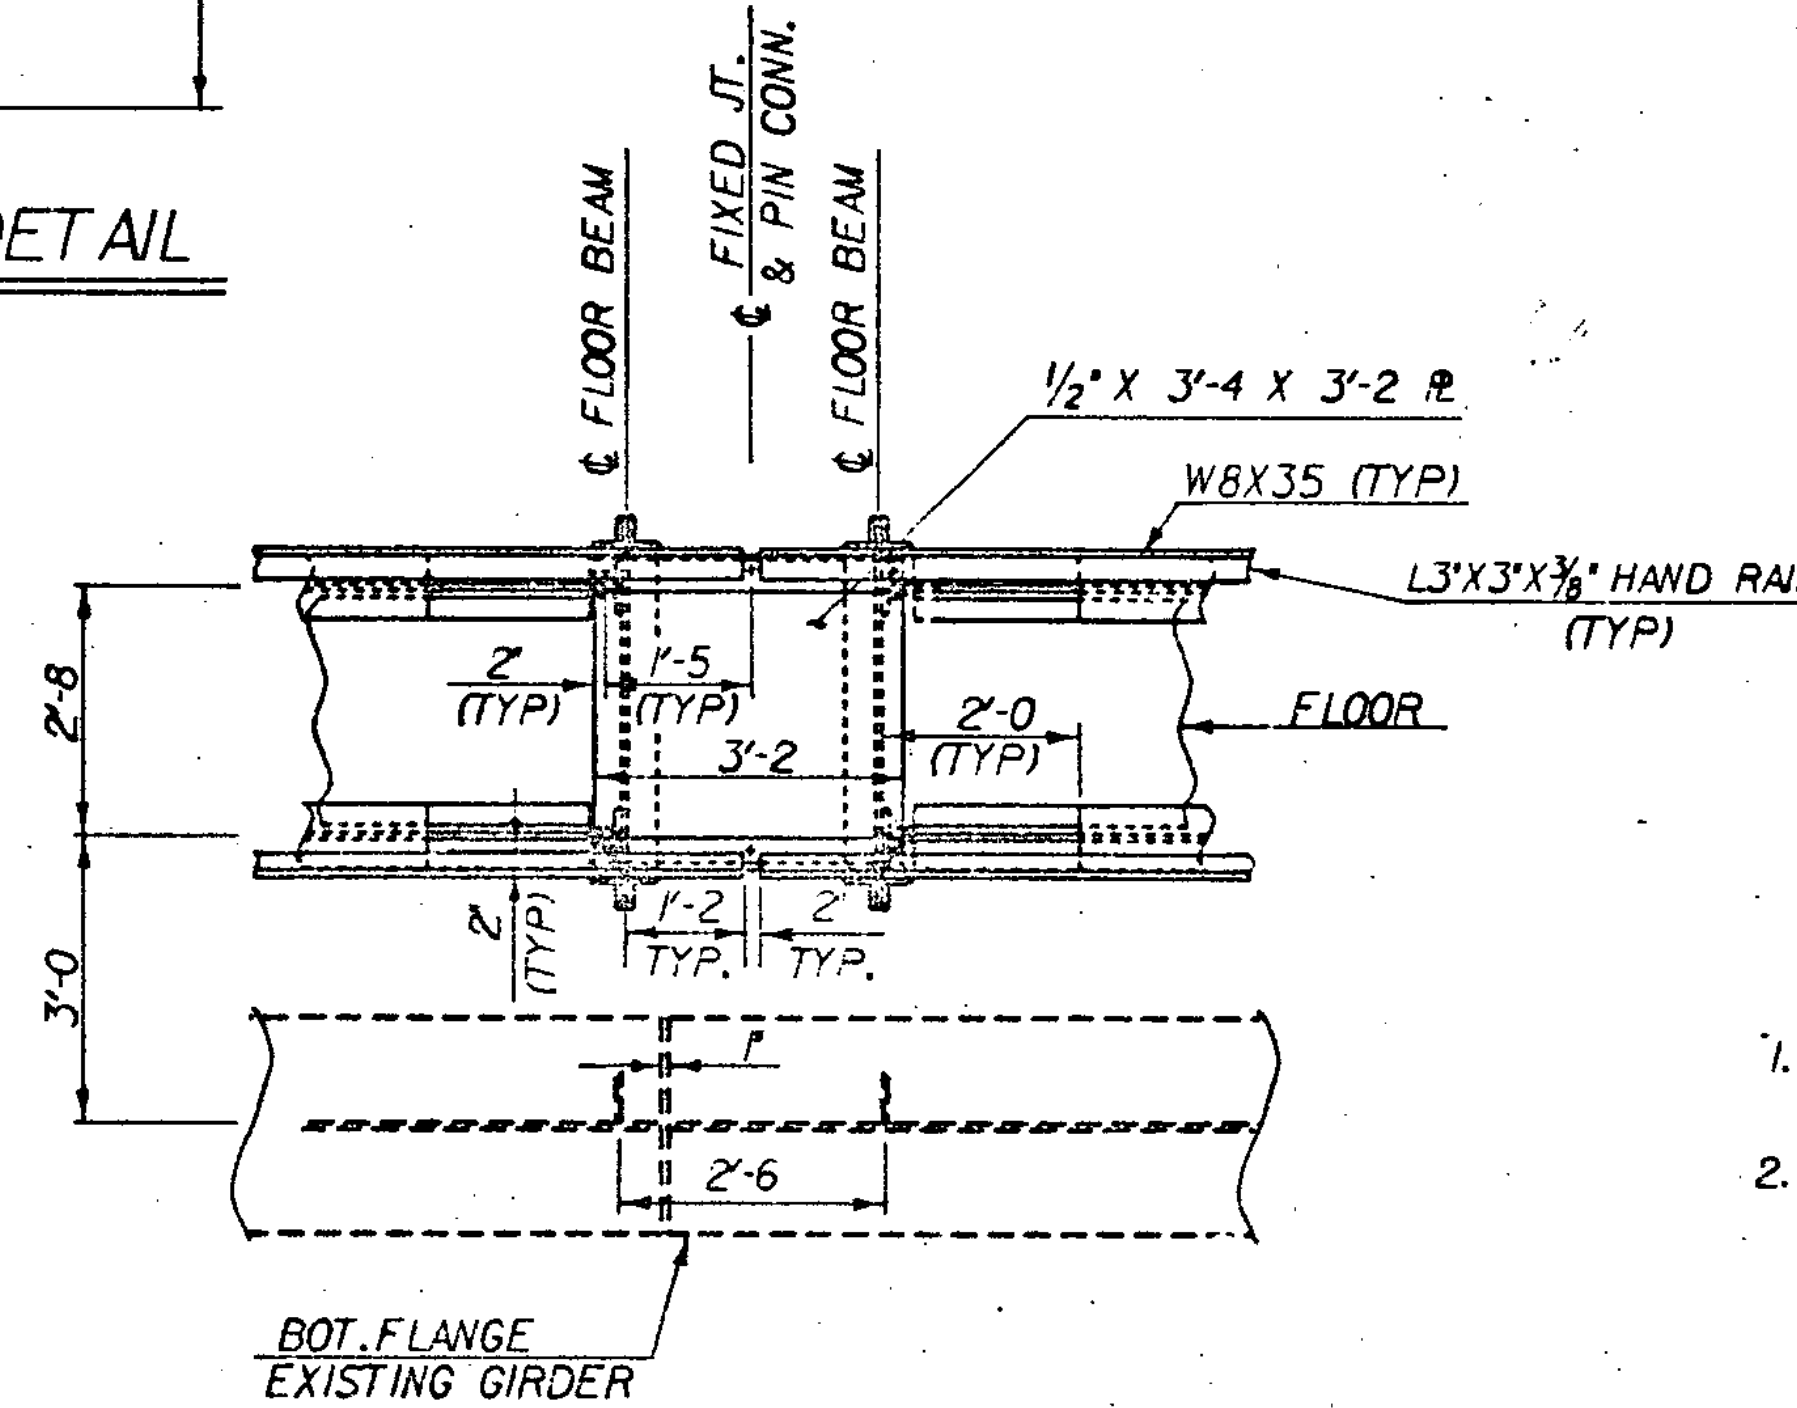

DETAIL P

SCALE 1/2" = 1'-0"

NORTH BOUND LOCATION	DIMENSION H *	EXISTING FLOOR BEAM SPACING	SOUTH BOUND LOCATION	DIMENSION H *	EXISTING FLOOR BEAM SPACING
F.B.*1	NO WALKWAY		F.B.*1	NO WALKWAY	
F.B.*2	2'-0	22'-4	F.B.*2	2'-0	22'-4
F.B.*3	2'-0	22'-4	F.B.*3	2'-0	22'-4
F.B.*4	2'-0	22'-4	F.B.*4	2'-0	22'-4
F.B.*5	2'-0 1/8	12'-9 Δ	F.B.*5	2'-0 1/8	12'-9 Δ
F.B.*5A	2'-0 1/8	2'-6 Δ	F.B.*5A	2'-1 1/8	2'-6 Δ
F.B.*6	2'-2	2'-8 1/8	F.B.*6	2'-2 1/2	22'-3 1/16
F.B.*7	2'-3 1/8	2'-8 1/8	F.B.*7	2'-4	22'-3 1/16
F.B.*8	2'-4 1/4	2'-8 1/8	**		
F.B.*9	2'-5 1/2	2'-8 1/8	F.B.*9	2'-5 1/2	22'-3 1/16
F.B.*9A	2'-6	3'-7 @ 45° Δ	F.B.*9A	2'-6	3'-7 @ 45° Δ
F.B.*10	2'-9	18'-2 1/2 Δ	F.B.*10	2'-9	18'-2 1/2 Δ
F.B.*11	3'-0	20'-0 Δ	F.B.*11	3'-0	20'-0 Δ
F.B.*12	3'-6	20'-0	F.B.*12	3'-6	20'-0
F.B.*13	3'-6	20'-0	F.B.*13	3'-6	20'-0
F.B.*14	3'-6	20'-0	F.B.*14	3'-6	20'-0
F.B.*15	3'-6	20'-0	F.B.*15	3'-6	20'-0
F.B.*16	3'-6	20'-0	F.B.*16	3'-6	20'-0
F.B.*17	3'-6	20'-0	F.B.*17	3'-6	20'-0
F.B.*18	3'-6	20'-0	F.B.*18	3'-6	20'-0
F.B.*19	3'-6	20'-0	F.B.*19	3'-6	20'-0
F.B.*20	3'-6	20'-0	F.B.*20	3'-6	20'-0
F.B.*21	2'-0	20'-0	F.B.*21	2'-0	20'-0
F.B.*21-45 WALKWAY STRINGERS ON TOP OF EXISTING STB.		24 SPACES @ 20'-0 = 480'-0	F.B.*21-45 WALKWAY STRINGERS ON TOP OF EXISTING STB.		24 SPACES @ 20'-0 = 480'-0
F.B.*45	2'-0	20'-0	F.B.*45	2'-0	20'-0
F.B.*46	3'-6	20'-0	F.B.*46	3'-6	20'-0
F.B.*47	3'-6	20'-0	F.B.*47	3'-6	20'-0
F.B.*48	3'-6	20'-0	F.B.*48	3'-6	20'-0
F.B.*49	3'-6	20'-0	F.B.*49	3'-6	20'-0
F.B.*50	3'-6	20'-0	F.B.*50	3'-6	20'-0
F.B.*51	3'-6	20'-0	F.B.*51	3'-6	20'-0
F.B.*52	3'-6	20'-0	F.B.*52	3'-6	20'-0
F.B.*53	3'-6	20'-0	F.B.*53	3'-6	20'-0
F.B.*54	3'-6	20'-0	F.B.*54	3'-0 1/2	20'-0
F.B.*55	3'-0	20'-0	F.B.*55	3'-0	20'-0
F.B.*56	2'-11	18'-2 1/2 Δ	F.B.*56	2'-11	18'-2 1/2 Δ
F.B.*57	2'-10 1/8	18'-2 1/2	F.B.*57	2'-10 1/8	18'-2 1/2
F.B.*57A	2'-9 5/8	3'-7 @ 45° Δ	F.B.*57A	2'-9 5/8	3'-7 @ 45° Δ
F.B.*58	2'-3 3/8	18'-2 1/2	F.B.*58	2'-3 3/8	18'-2 1/2
F.B.*59	1'-8 3/8	20'-0	F.B.*59	1'-8 3/8	20'-0
F.B.*60	NO WALKWAY	20'-0	F.B.*60	NO WALKWAY	20'-0

NOTE: THE INSPECTION WALKWAYS SHALL BE INSTALLED THE FULL LENGTH OF BOTH BRIDGES ON THE RIGHT (EAST) SIDE AND SHALL BE INSTALLED WHERE INDICATED BY A Δ ON THE LEFT (WEST) SIDE.

* DIMENSION H IS THE VERTICAL DISTANCE FROM THE TOP OF THE EXISTING GIRDERS BOTTOM FLANGE TO THE BOTTOM OF THE NEW W8X35 WALKWAY STRINGERS.
** THERE IS NO FLOOR BEAM *8 ON THE SOUTH BOUND BRIDGE.

NOTES

- FOR LOCATION OF SECTIONS D-D, E-E, P-P AND DETAIL P, SEE SHEET II.
- ALL DIMENSIONS SHOWN ON THESE PLANS ARE HORIZONTAL OR VERTICAL, AND ARE GIVEN AT 68°, UNLESS OTHERWISE NOTED. BOTH THE NORTHBOUND AND SOUTHBOUND BRIDGES ARE ON A -1.325% GRADE.

STATE OF VERMONT AGENCY OF TRANSPORTATION

Town of **HARTFORD** Bridge No. 44 N & S
 Highway No. **191** Leg Sta. _____
 Surv. Sta. _____

INSPECTION WALKWAY DETAILS

191 OVER THE WHITE RIVER, U.S. RTE. 4, AND VT. RTE. 14

Designed By **A. ELWOOD** Drawn By **D. C. WILLEY**
 Checked By **A. ELWOOD** Date **5-84** Bridge Design Supervisor **R. S. HAUP** Date **5-84**

PROJECT **HARTFORD** PROJECT NO. **IR-91-2 (1)**
 I.G.C. Info. **QSA1(30,25)82A115WLK.DGN**
 Bridge Sheet No. _____ Sheet **13** of **30**