




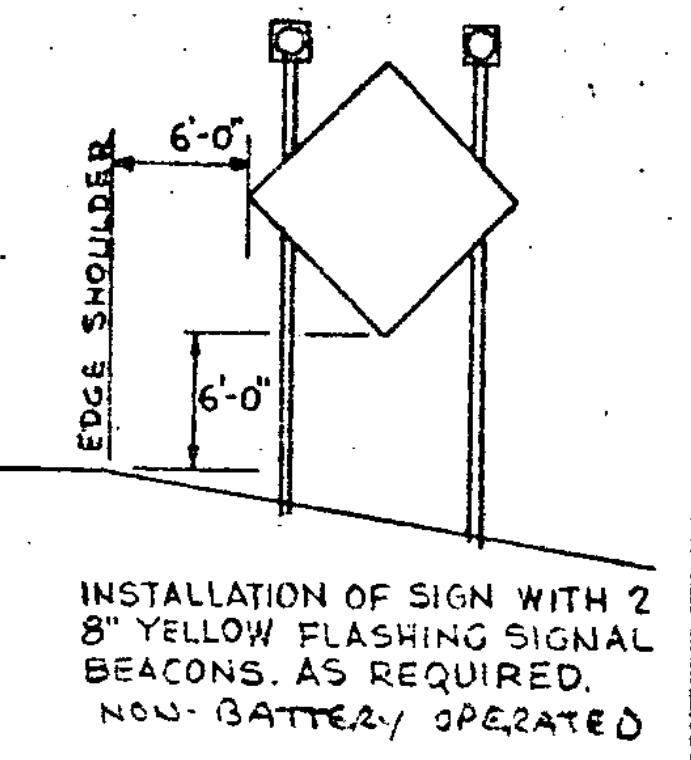
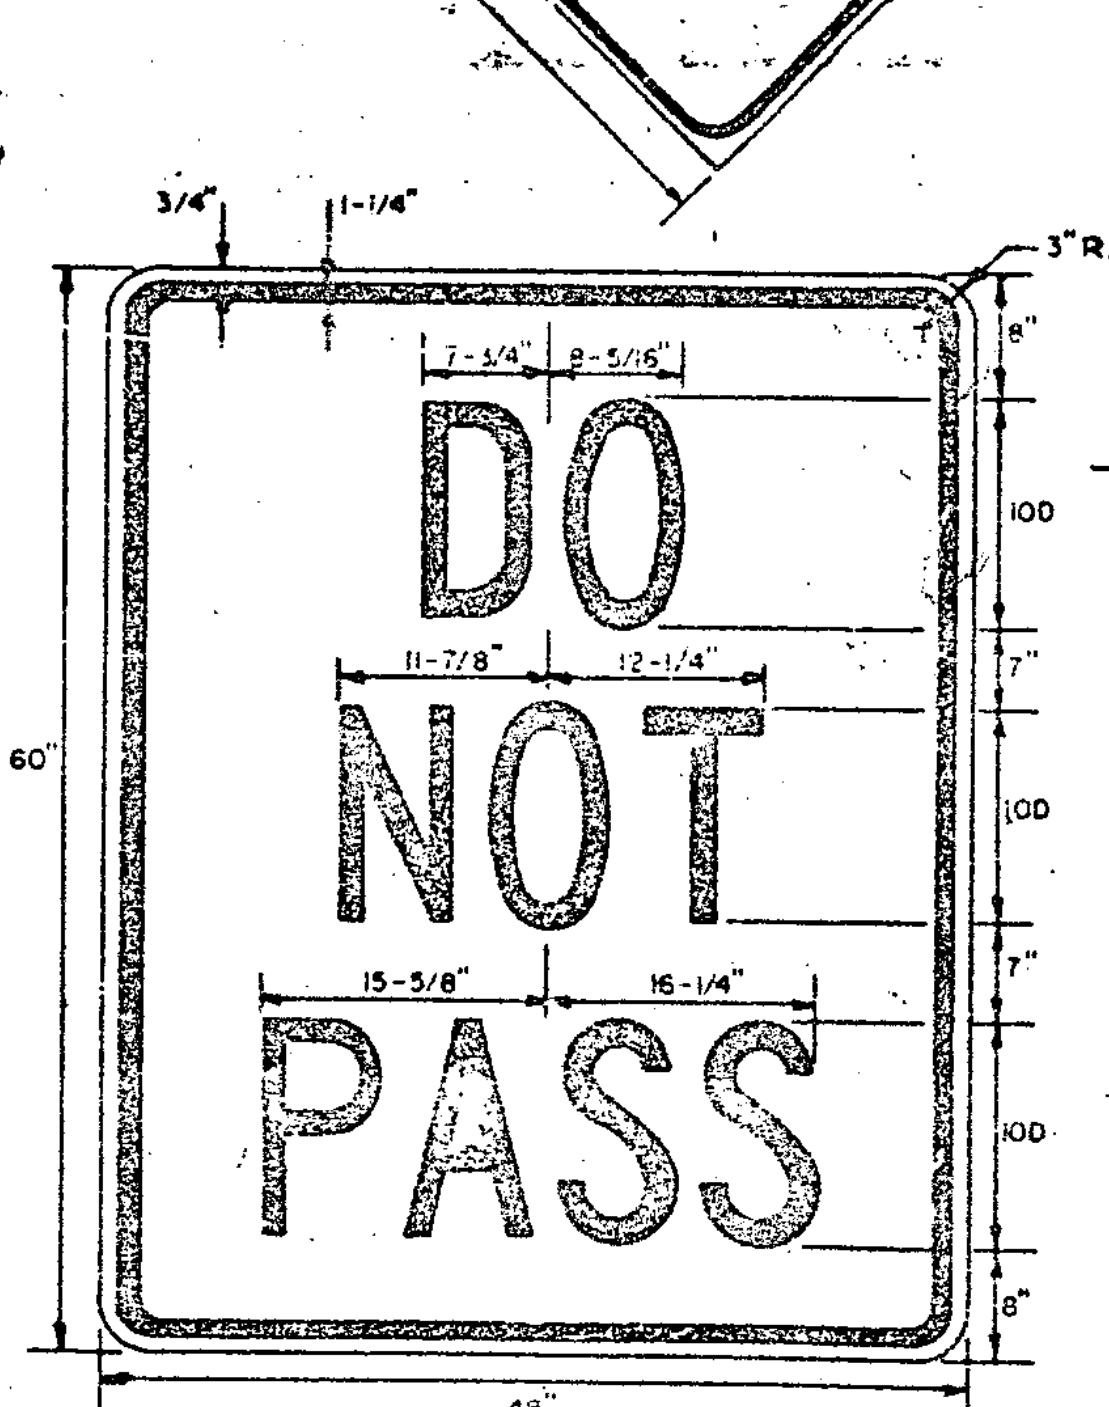
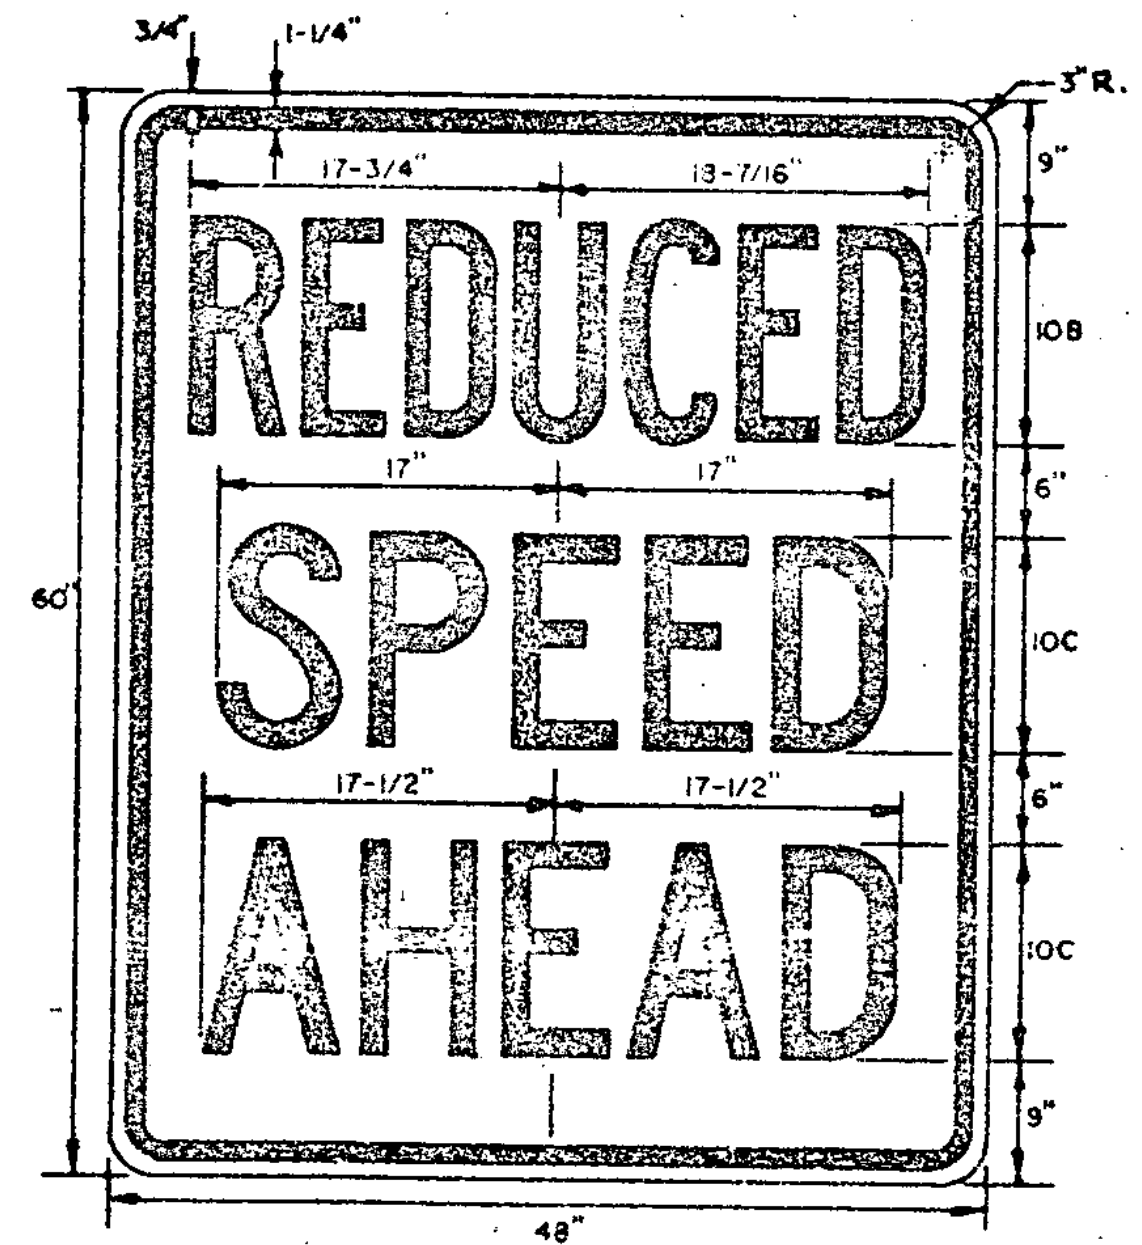
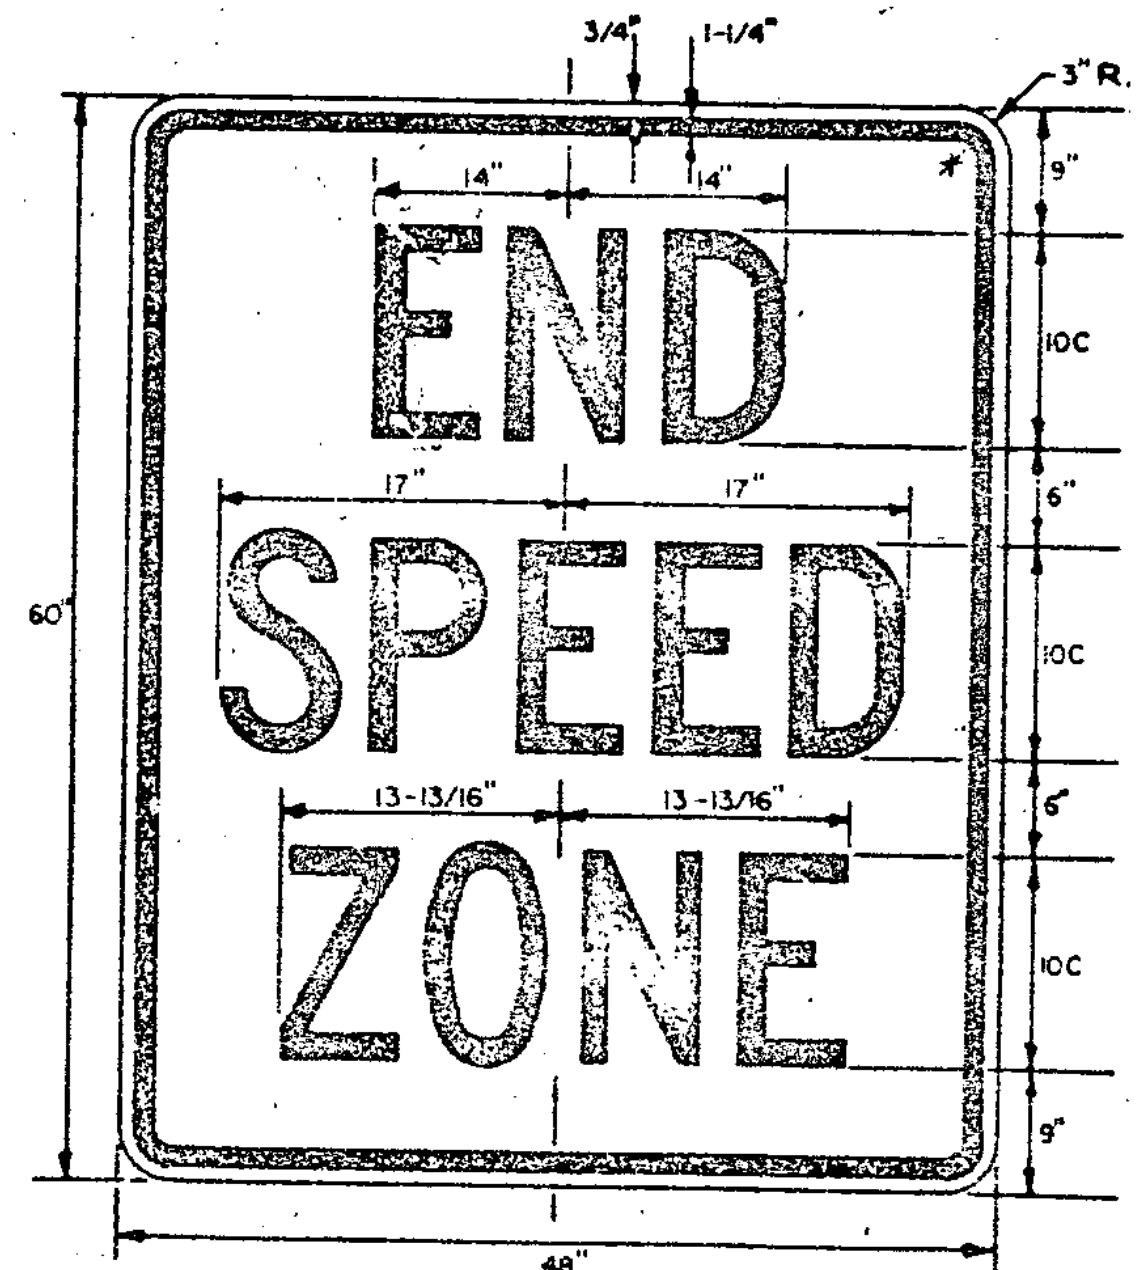
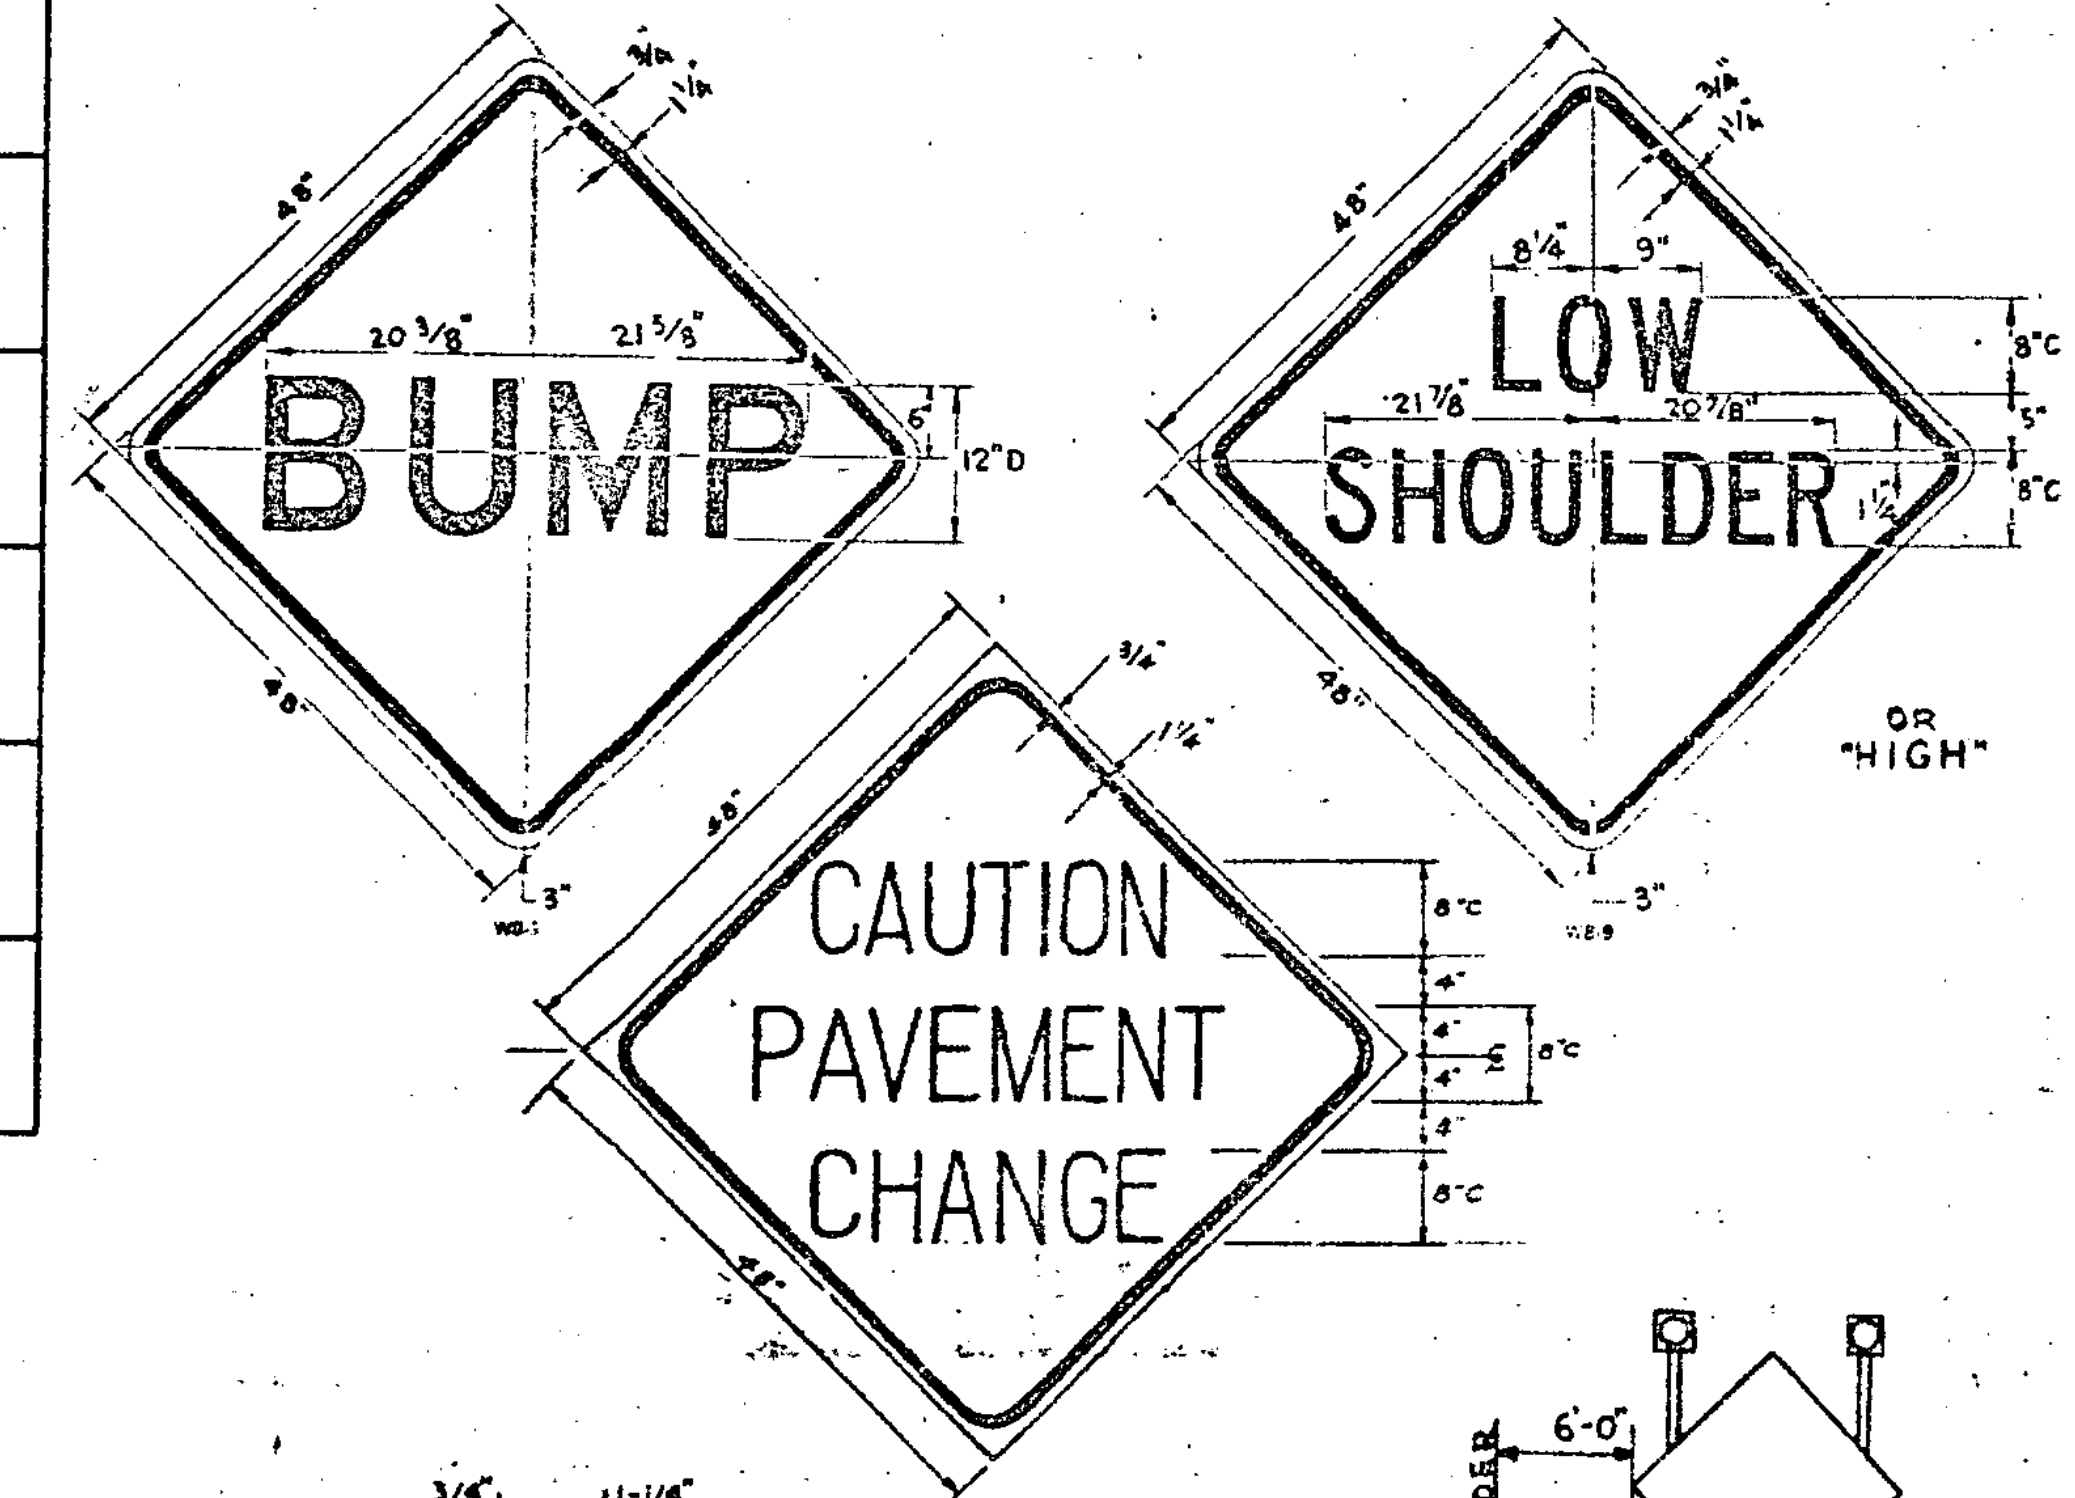
# SECTION 641 TRAFFIC SIGNS SUMMARY SHEET

MAINLINE PAVING

IDENTIFICATION	NUMBER OF SIGNS	SIZE		TEXT	FOR SIGN DETAIL SEE STANDARD OR SHEET NUMBER
		WIDTH	HEIGHT		
		18" <i>OR AS REQUIRED</i>	8"	RIGHT	E-8
	2 (4)	4	4	LEFT LANE CLOSED 1/2 MILE	E-8
	2	4	5	REDUCED SPEED AHEAD	
	(4) 2 <i>OR AS REQUIRED</i>	4	4	LEFT LANE CLOSED 1500 FEET	E-8
	2	4	4		E-8
	2	4	4		E-8
	AS REQUIRED	4	5	DO NOT PASS	
	AS REQUIRED	4	5	SPEED LIMIT 40	E-16B
	1 (2)	4	5	END SPEED ZONE	
	AS REQUIRED	4	4	CAUTION PAVEMENT CHANGE	SEE E-6 FOR MATERIALS, ETC.
	AS REQUIRED	4	4	BUMP	SEE E-6 FOR MATERIALS, ETC.
	2 (4)	4	4	ROAD CONSTRUCTION 1 MILE	E-2
	2	24	18	TRUCKS USE LOWER GRASS	
	AS REQUIRED	4	4		E-6
	AS REQUIRED	4	4	HIGH OR LOW SHOULDER	" " " "

IDENTIFICATION	NUMBER OF SIGNS	SIZE		TEXT	FOR SIGN DETAIL SEE STANDARD OR SHEET NUMBER
		WIDTH	HEIGHT		

SIGN NOTES: TRAFFIC SIGNS SHOWN ON THIS SHEET ARE TO BE SUBSIDIARY TO ITEM 641, TRAFFIC CONTROL. ADDITIONAL SIGNS, IF REQUIRED, THAT ARE NOT DETAILED WILL BE PAID AS ITEM 675.20 OR 675.25 AS DIRECTED BY THE ENGINEER.  
PROJECT SIGNS AS PER STANDARD E-2 AND E-6 WILL BE REQUIRED TO ESTABLISH PROJECT LIMITS AND AS RAMP SIGNING.  
SIGNS MAY BE ERECTED ON FLANGED CHANNEL STEEL POSTS\* OR BREAKAWAY WOODEN POSTS.  
\* SIZE = 3 LBS/FT - MAXIMUM



COLORS: LEGEND - BLACK (NON-REFLECTORIZED)  
BACKGROUND - WHITE (REFLECTORIZED)  
(SEE STANDARD SHEET E-58 FOR MATERIAL SPECIFICATIONS)

( ) INDICATE SIGNS REQUIRED CLOSING NB & SB LANE

SECTION 641 TRAFFIC SIGN SUMMARY SHEET MAINLINE TRAFFIC CONTROL PLAN	SURVEYED BY _____ DATE _____ DRAWN BY RFR DATE 2-82 TRACED BY LCG DATE 6-82
HARTFORD PROJ. 1R NO. 91-2(1) SHEET 27 OF 30	

REV. 3/27/84