


DETAILS

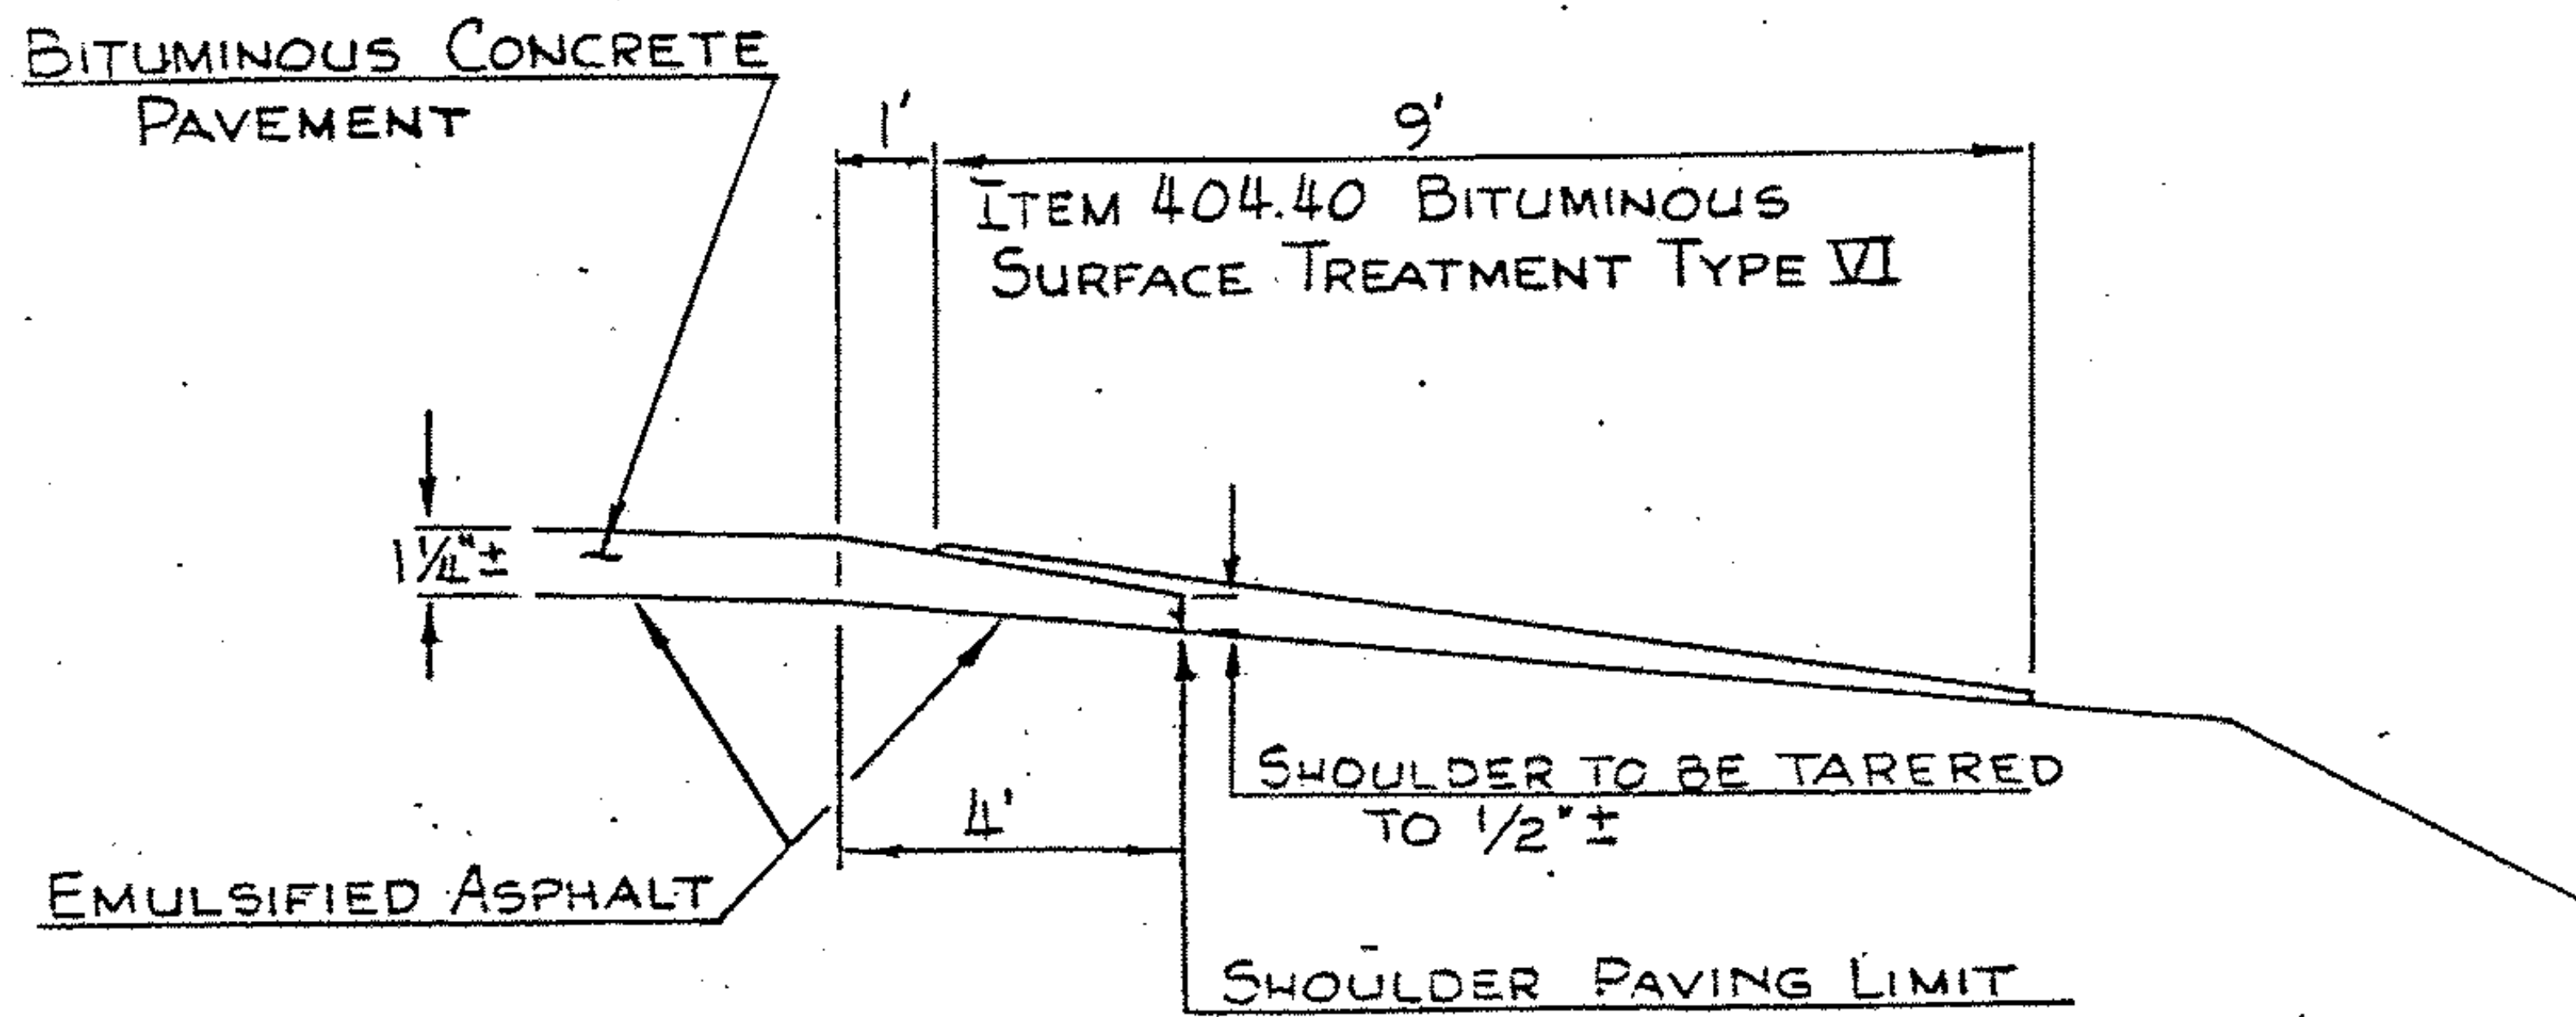

10 FT. SHOULDER DETAIL

NOTE: BLEEDERS WILL BE CONSTRUCTED THROUGH THE SHOULDERS AT THE BOTTOM OF SAG VERTICAL CURVES AND ANY LOW AREA WHERE WATER MIGHT POUND. BLEEDERS WILL BE PAVED WITH OPEN GRADED ASPHALT FRICTION COURSE, ITEM 409.25 SUBSIDIARY TO ITEM 210. COLD PLANING.