


DETAILS

CENTER LINE DETAIL

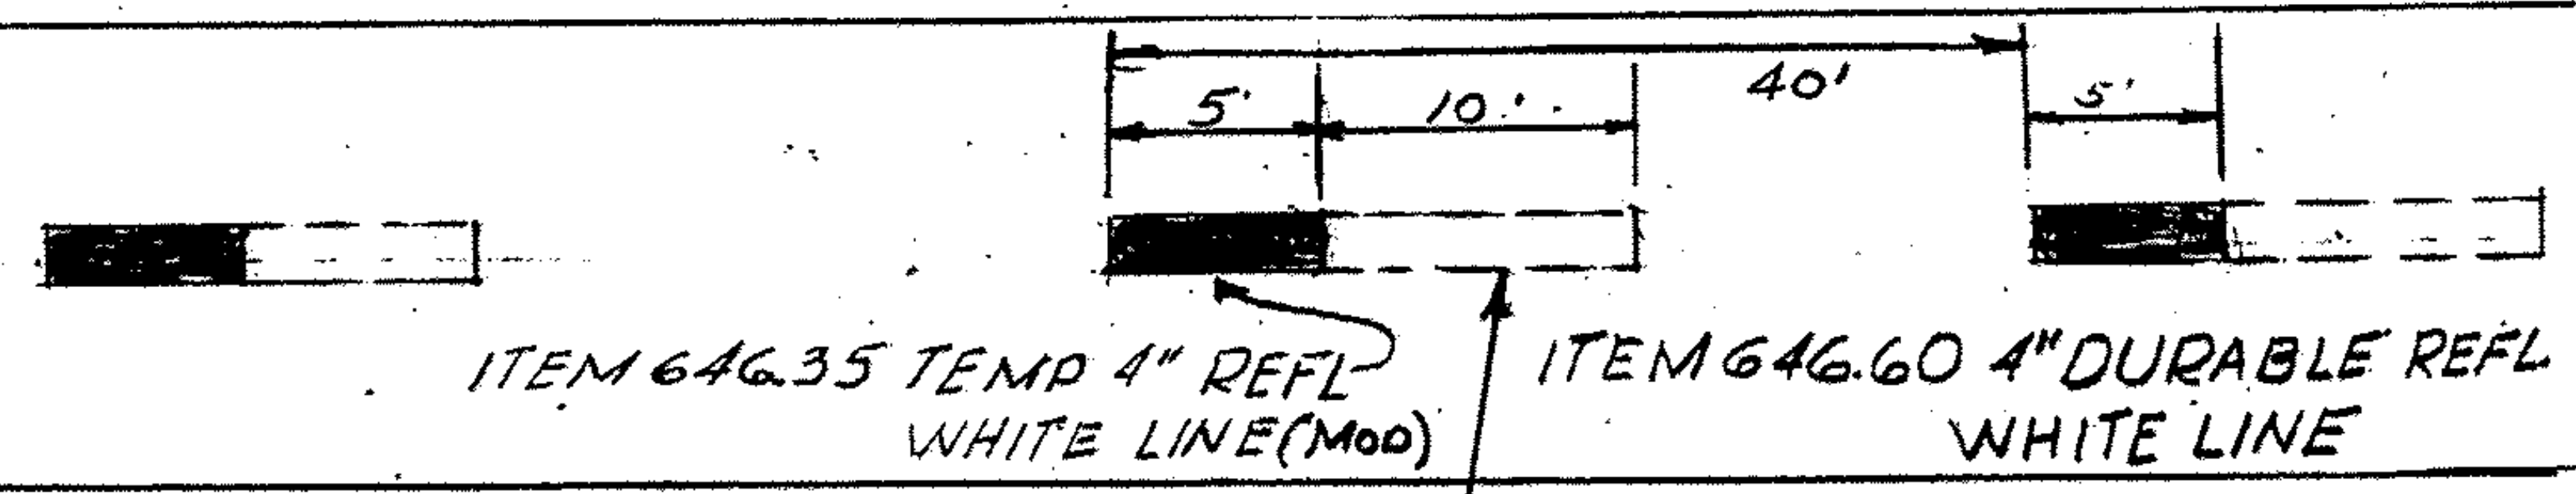

NOT PART OF THIS CONTRACT

NOTE: CENTER LINE ON BINDER COURSE WILL BE STANDARD 10 FT LINE - 30 FT SPACE