

NOTES:

All signs will be placed before any work is done or equipment is used on the highway. The set of entrance signs, advance warning signs, and controlling traffic lane closure signs shall be installed on entrance ramps. Exit ramps shall have traffic cones delineated, with 28" cones to indicate closed vehicle path. Tower lights shall be at least 300 feet. Cone spacing shall be 40 feet. Tower lights shall be spaced at 1000 foot intervals. Standard E-2, A1, A2, A3, A999, A1000.

* During non-rush hours, visibility, steady, back-slowly, lights mounted on Type III Barricade (head) will be used in place of cones.

All signs will be placed before any work is done or equipment is used on the highway.

Contractor shall have barricades set up for all side-curb and right side-curb areas before starting construction.


Work crews, private vehicles will not be parked in or around working area. Contractor will provide parking for work crews.

Uniformed Traffic Officers will mark on shoulder away from traffic.

Existing speed limit signs in reduced speed area will be covered during construction.

Channelizing devices other than cones or Type III Barricades shall be used to delineate work area.

To the MUTCD and are approved for use by the Resident Engineer.

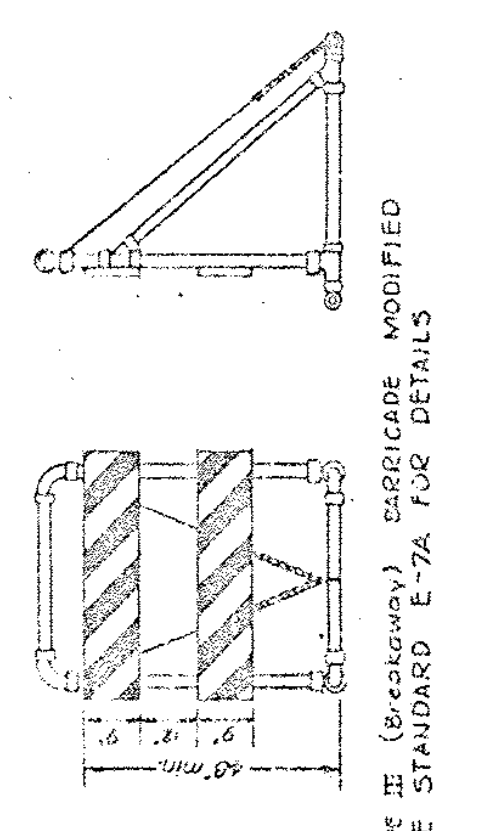

Flashing Arrow Board (8' x 56" minimum size) to be placed on a 2" x 2" x 500' taper. The flashing arrow board to be mounted on a breakaway or yielding system. The generator shall be secured from the arrow board and be located off the roadway shoulder. SEE SPECIAL PROVISIONS.

Taper to be delineated by BARRICADES - See Special Provisions

This area to remain free of obstructions

NO TYPICAL

NO TYPICAL

NOT TO SCALE

SPEED LIMIT 40 TO BE INSTALLED AT 1/2 MILE INCREMENTS AND AT THE END OF THE WORK AREA. DO NOT PASS SIGNS WILL BE INSTALLED AT THE BEGINNING OF THE WORK AREA, HALFWAY BETWEEN ADJACENT SPEED LIMIT SIGNS.

Refer to the Special Provisions for speed zone devices Manual for Towers not in the speed zone.

DO NOT PASS SIGNS SHALL BE INSTALLED AT THE BEGINNING OF THE WORK AREA AND AT THE END OF THE WORK AREA.

THE SPEED LIMIT 40, DO NOT PASS AND END SPEED ZONE SIGNS SHALL BE INSTALLED AT THE BEGINNING OF THE WORK AREA AND AT THE END OF THE WORK AREA.

THE SPEED LIMIT 40, DO NOT PASS AND OTHER RELATED SIGNS SHALL BE REMOVED OR COVERED WHEN WORK IS NOT IN PROGRESS.

TRAFFIC CONTROL PLAN
MAINLINE

DATE: _____
DRAWN BY: _____
CHECKED BY: _____
PROJECT: _____
SHEET NO. OF _____

DATE: _____
DRAWN BY: _____
CHECKED BY: _____
PROJECT: _____
SHEET NO. OF _____