

# SECTION 641 TRAFFIC SIGNS SUMMARY SHEET







MAINLINE PAVING

RAMP PAVING

| IDENTIFICATION | NUMBER OF SIGNS            | SIZE<br>WIDTH HEIGHT | TEXT                             | FOR SIGN STANDARD OR SHEET NUMBER |
|----------------|----------------------------|----------------------|----------------------------------|-----------------------------------|
|                | 2                          | 4 4                  | LEFT LANE CLOSED 1 MILE          | E-8                               |
|                | 6<br><i>OR AS REQUIRED</i> | 18" 8"               | RIGHT                            | E-8                               |
|                | 2                          | 4 4                  | LEFT LANE CLOSED 1/2 MILE        | E-8                               |
|                | 2                          | 4 5                  | REDUCED SPEED AHEAD              | E-6                               |
|                | 2<br><i>OR AS REQUIRED</i> | 4 4                  | LEFT LANE CLOSED 1000 FEET       | E-8                               |
|                | 2                          | 4 4                  |                                  | E-8                               |
|                | 2                          | 4 4                  |                                  | E-8                               |
|                | AS REQUIRED                | 4 5                  | DO NOT PASS                      |                                   |
|                | AS REQUIRED                | 4 5                  | SPEED LIMIT 40                   | E-16                              |
|                | 1                          | 4 5                  | END SPEED ZONE                   |                                   |
|                | AS REQUIRED                | 4 4                  | CAUTION PAVEMENT CHANGE          | SEE E-6 FOR MATERIALS, ETC.       |
|                | AS REQUIRED                | 4 4                  | BUMP                             |                                   |
|                | 2                          | 4 4                  | ROAD CONSTRUCTION AHEAD          | E-2                               |
|                | 2 5 3                      | 3                    | ROAD CONSTRUCTION NEXT --- MILES | E-2                               |
|                | 1 4 4                      | 4                    |                                  | E-6                               |
|                | AS REQUIRED                | 4 4                  | HIGH OR LOW SHOULDER             |                                   |

| IDENTIFICATION | NUMBER OF SIGNS | SIZE<br>WIDTH HEIGHT | TEXT                   | FOR SIGN STANDARD OR SHEET NUMBER |
|----------------|-----------------|----------------------|------------------------|-----------------------------------|
|                | AS REQUIRED     | 4 4                  | LEFT LANE CLOSED AHEAD | E-8                               |
|                | AS REQUIRED     | 18" 6"               | RIGHT                  | E-8                               |
|                | AS REQUIRED     | 4 4                  |                        | E-6                               |

SIGN NOTES: TRAFFIC SIGNS SHOWN ON THIS SHEET ARE TO BE SUBSIDIARY TO ITEM 641, TRAFFIC CONTROL. ALL SIGNS SHOWN ON THIS SHEET ARE NOT DETAILED WILL BE PAID AS ITEM 674.50 OR 674.25 AS DIRECTED BY THE ENGINEER. PROJECT SIGNS AS PER STANDARD E-2 AND E-6 WILL BE REQUIRED TO ESTABLISH PROJECT LIMITS AND AS RAMP SIGNS. SIGNS MAY BE ERECTED ON FLANGED CHANNEL STEEL POSTS OR BREAKAWAY WOODEN POSTS. \* SIZE = 3 LBS/FT - MAXIMUM

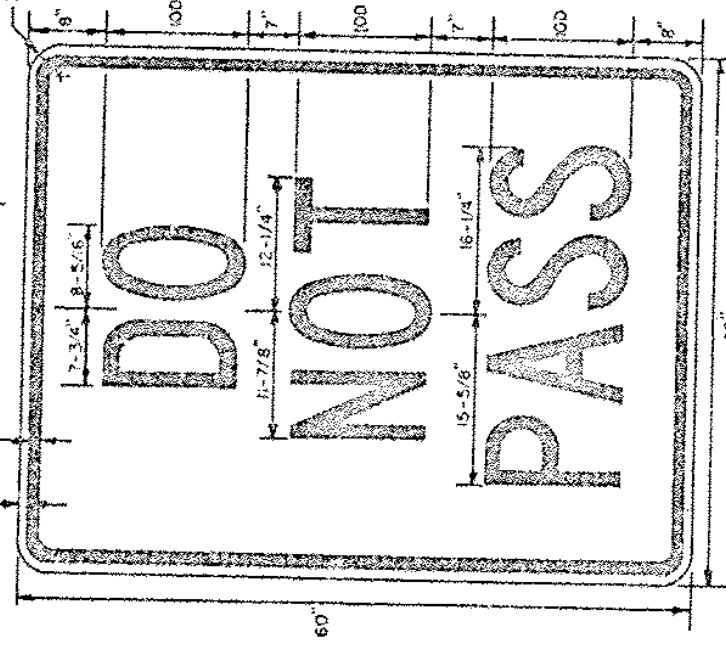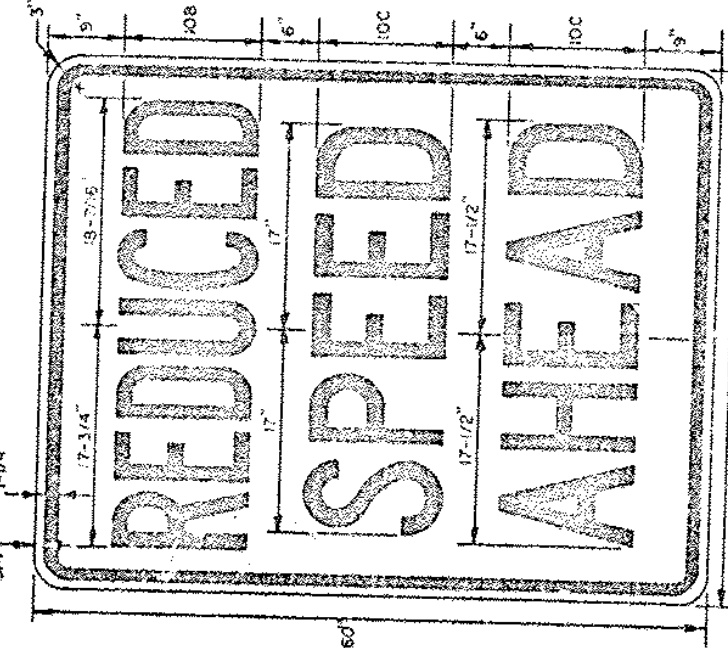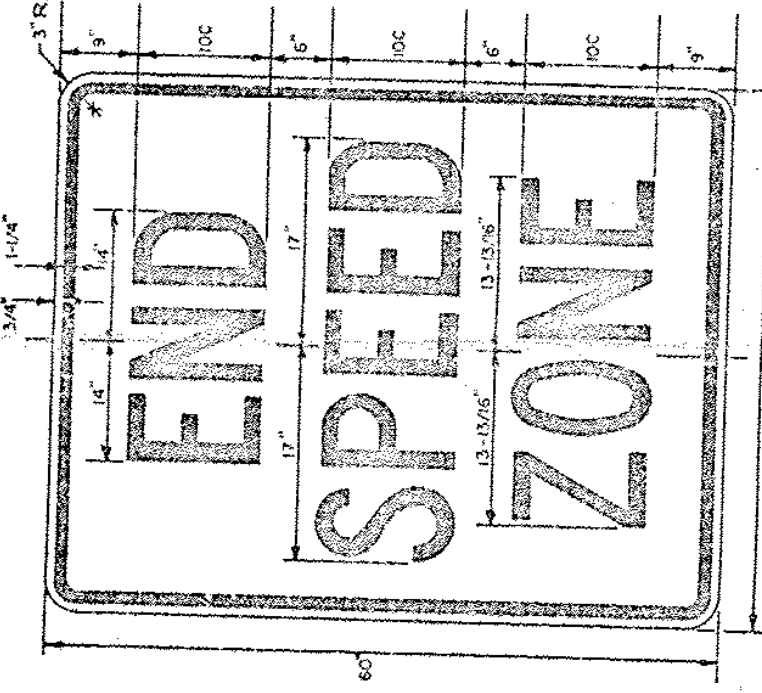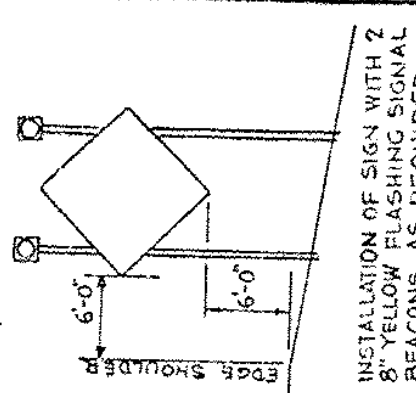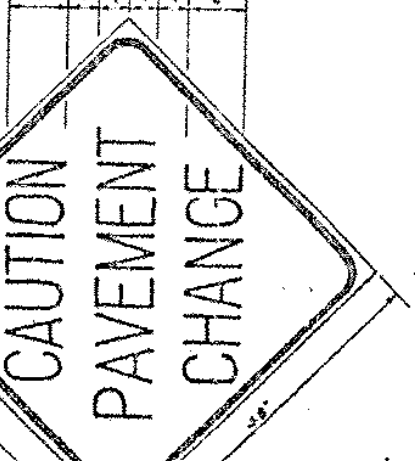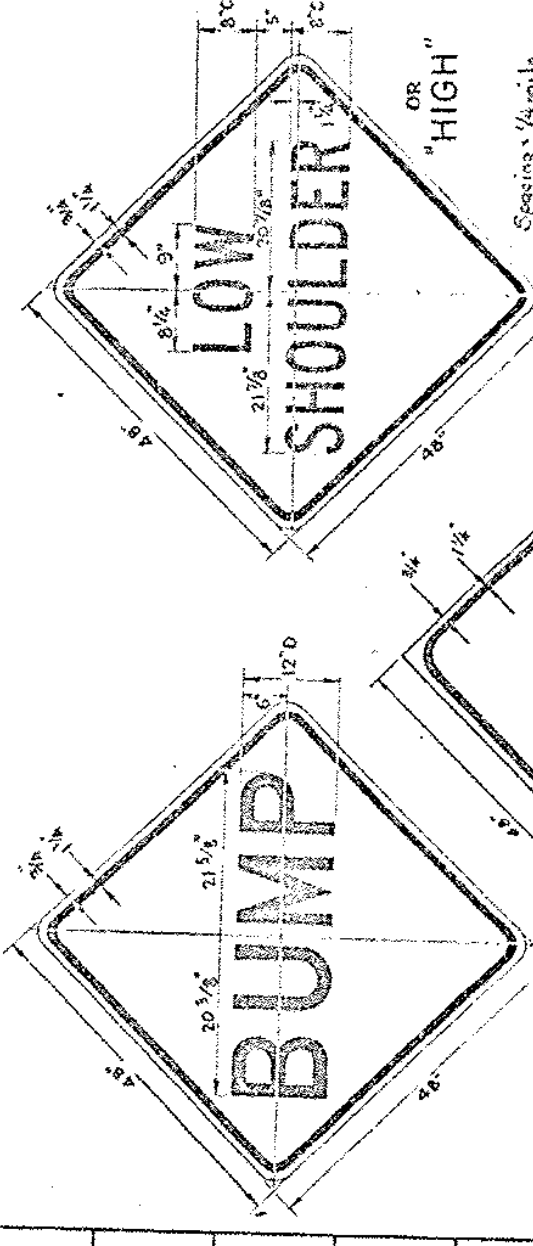

COLORS: LETTERS IN RED (NON-REFLECTORIZED) BACKGROUND IN WHITE (SEE STANDARD SHEET E-16 FOR MATERIAL SPECIFICATIONS)

SECTION 641  
TRAFFIC SIGN  
SUMMARY SHEET  
MAINLINE  
TRAFFIC CONTROL  
PLAN

DESIGNED BY: \_\_\_\_\_ DATE: 2-12-82  
DRAWN BY: \_\_\_\_\_ DATE: 2-12-82  
CHECKED BY: \_\_\_\_\_ DATE: 5-12-82  
PROJECT: MONTPELIER - MIDDLESEX  
PROJECT IR NO. 089-2(4)  
SHEET 11 OF 27