


AHEAD

NOTE:  
SEE STANDARD E-50  
FOR LETTERING DETAIL.

STOP

WORD MARKING LAYOUT DETAIL

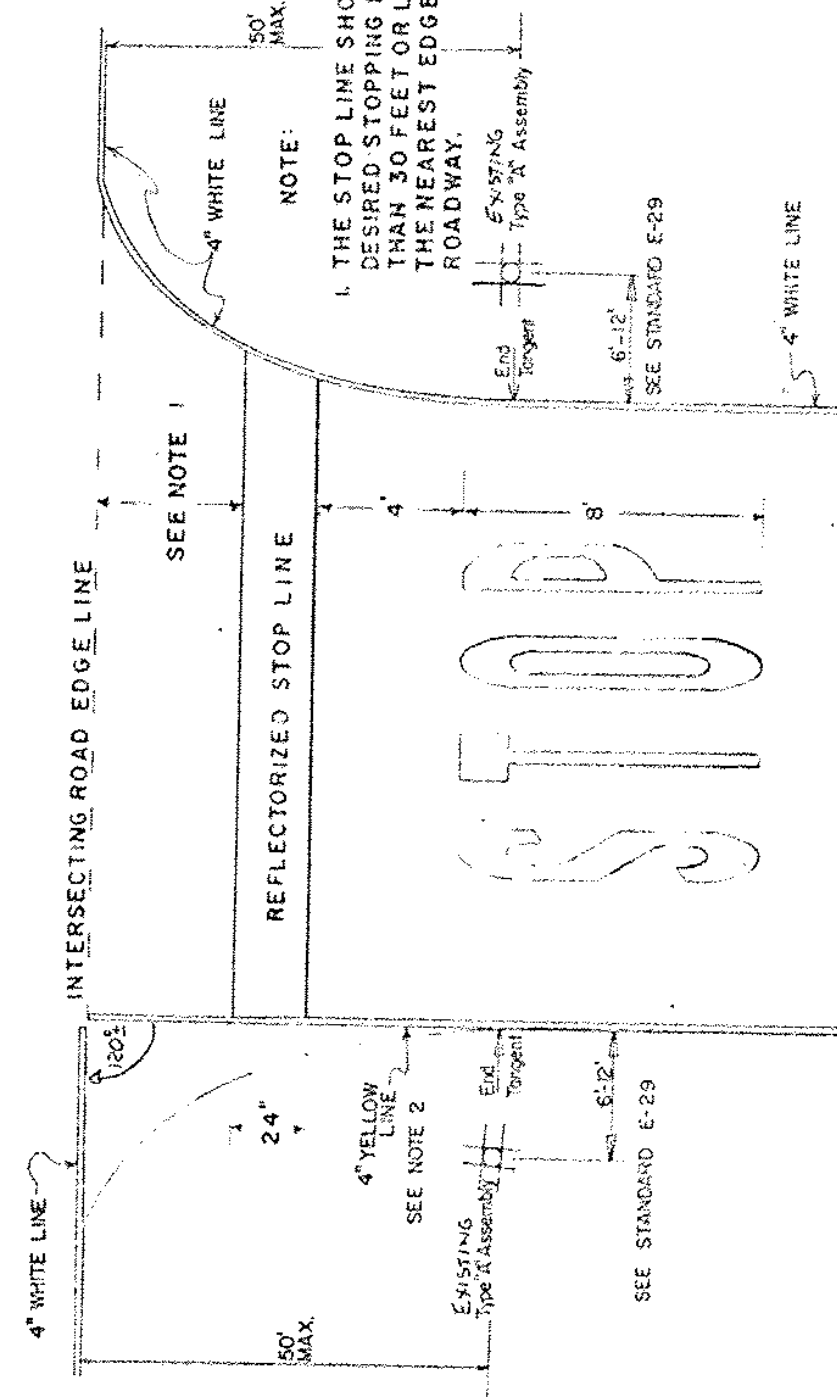

NOTE 2: THE 4" YELLOW LINE IS TO BE ON THE ROADWAY EDGE AT THE RESULTING ANGLE. USE OF A REDUS AT THIS ANGLE, IF POSSIBLE, SHOULD BE REFERRED TO SEE SHEET 4.

NOTE:  
1. THE STOP LINE SHOULD BE PLACED AT THE DESIRED STOPPING POINT, IN NO CASE MORE THAN 30 FEET OR LESS THAN 4 FEET FROM THE NEAREST EDGE OF THE INTERSECTING ROADWAY.

PAVEMENT MARKING B. SIGN LOCATION DETAILS

GENERAL NOTES AND  
DETAILS SHEET

DRAWN BY: RJT DATE: 9-83  
 TRACED BY: DATE:  
 PROJECT: Montpelier - Phases 1 & 2  
 SHEET 16 OF 27