

INDEX OF SHEETS  
SEE SHEET 2

# STATE OF VERMONT AGENCY OF TRANSPORTATION




## PROPOSED IMPROVEMENT TOWNS OF LYNDON, WHEELOCK, SHEFFIELD, GLOVER, BARTON, IRASBURG, BROWNINGTON, COVENTRY & DERBY COUNTIES OF CALEDONIA & ORLEANS

### INTERSTATE 91 NB & SB IM IR 091-3(6) - SIGNS


PROJECT LOCATION: BEGINNING AT MM 140.000 IN THE TOWN OF LYNDON AND EXTENDING NORTHERLY 37.140 MILES, ENDING AT MM 177.140 IN THE TOWN OF DERBY.

PROJECT DESCRIPTION: WORK PERFORMED UNDER THIS PROJECT INCLUDES REMOVAL OF EXISTING SIGNS AND PLACEMENT OF NEW SIGNS AND ASSOCIATED ELEMENTS ALONG THE PROJECT LENGTH, RAMPS AND INTERCHANGES.


LENGTH OF ROADWAY 196,099 FEET = 37.140 MILES  
LENGTH OF PROJECT 196,099 FEET = 37.140 MILES

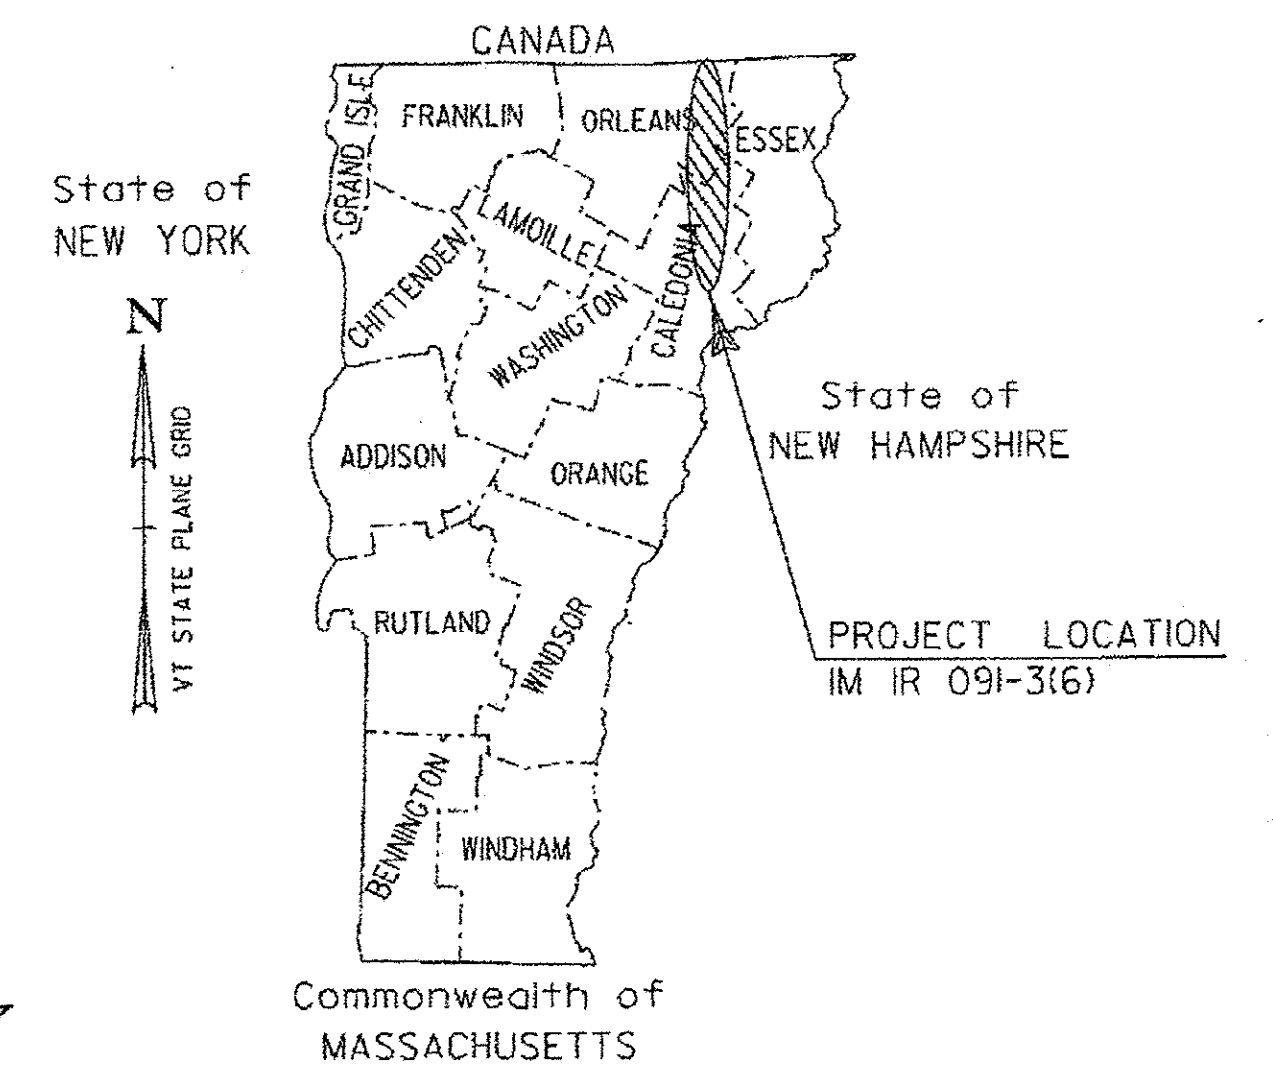


RECORD PLANS	
CONTRACTOR:	F. R. LAFAYETTE, INC.- ESSEX JUNCTION, VT
RESIDENT ENGINEER:	SETH HISMAN
CONSTRUCTION BEGAN:	SEPTEMBER 10, 2009
CONSTRUCTION COMPLETE:	JUNE 20, 2011
RECORD PLANS BY:	SETH HISMAN & JENNA HYDE
I HEREBY CERTIFY THAT ALL THE CONSTRUCTION REQUIRED BY THIS SET OF DRAWINGS HAS BEEN ACCOMPLISHED AS INDICATED HEREIN.	
BY:	<i>Seth Hisman</i> RESIDENT ENGINEER
DATE:	1/29/13
NOTE: Any further information concerning final quantities, amounts or other details relative to this project may be found at Central Files in the electronic archives.	

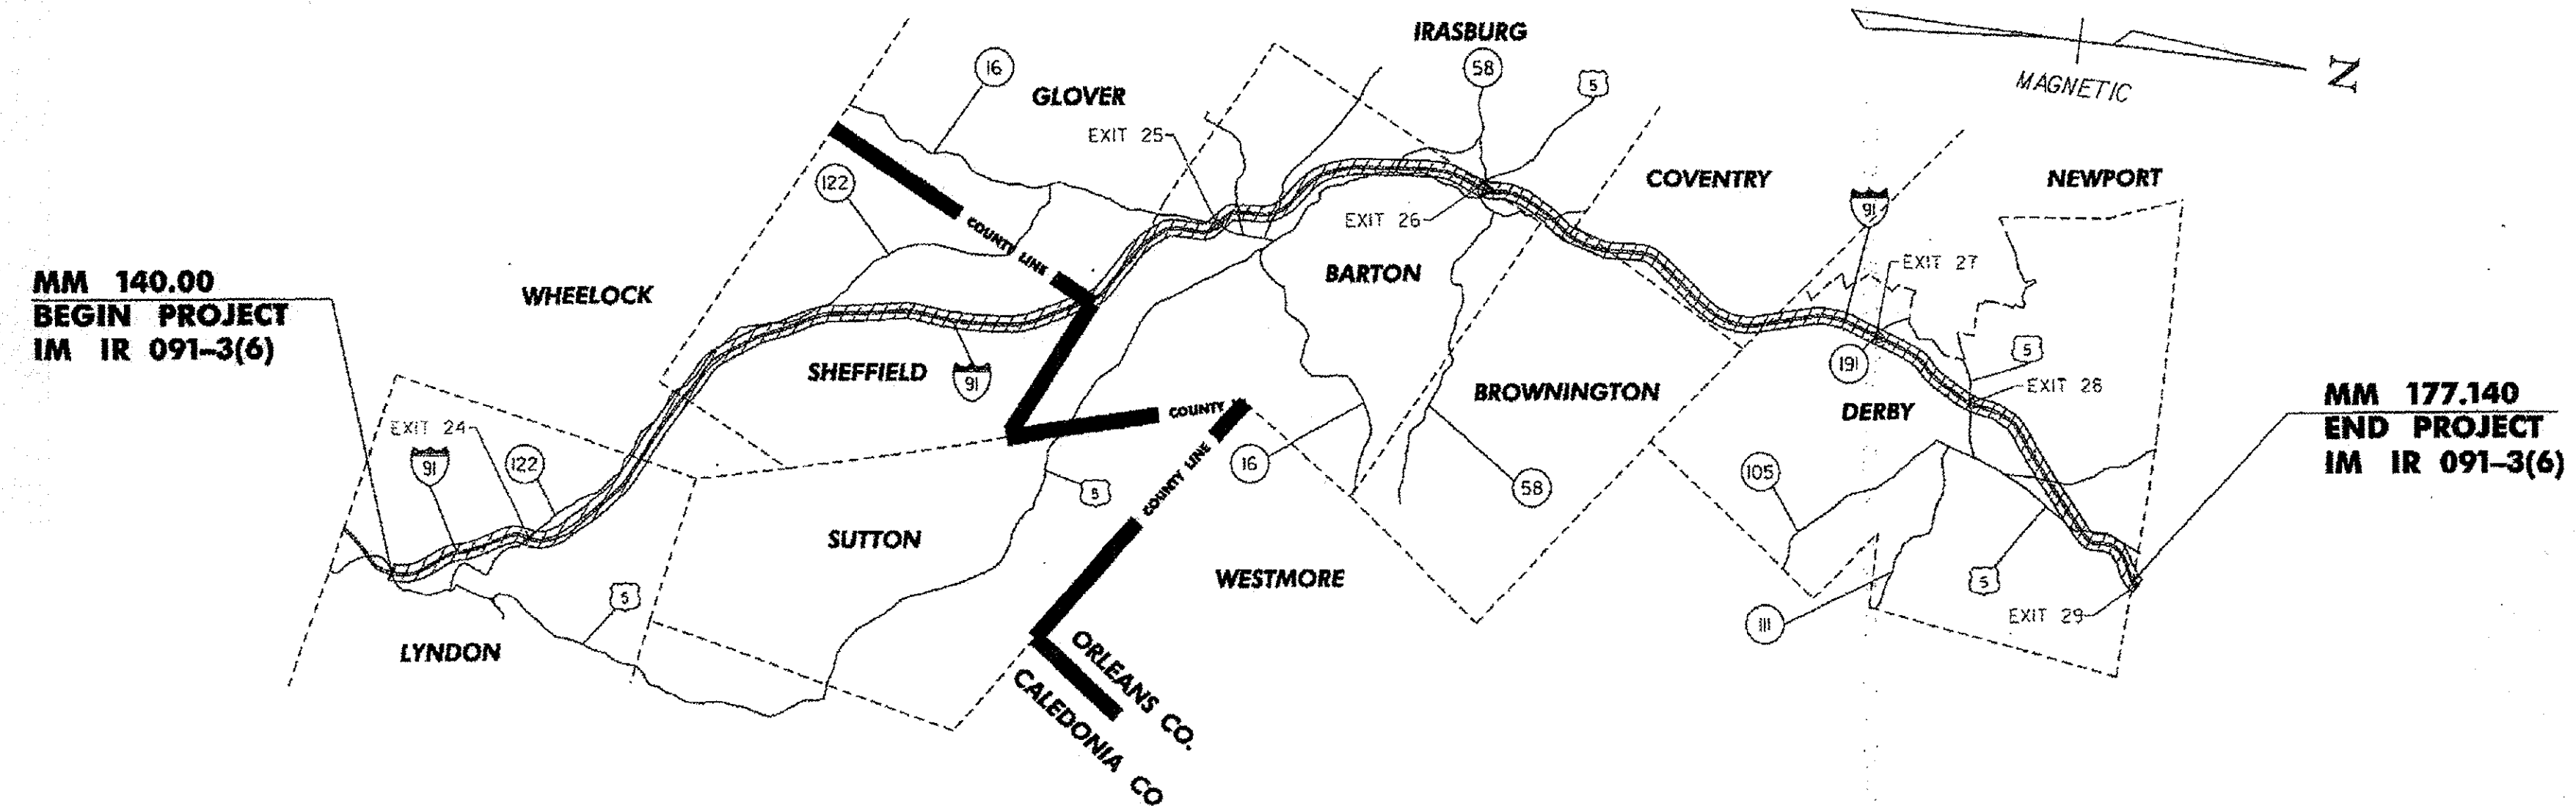

CONVENTIONAL SYMBOLS	
COUNTY LINE	
TOWN LINE	
LIMITS OF ACCESS	
POINT OF ACCESS	
FENCE LINE	
STONE WALL	
TRAVELED WAY	
RAILROAD	
SURVEY LINE	
CULVERT	
POWER POLE	
TELEPHONE POLE	
TREES	
CONTROL OF ACCESS	
PROPERTY LINE	
R.O.W. TAKING LINE	
SLOPE RIGHTS	
TOP OF CUT	
TOE OF SLOPE	

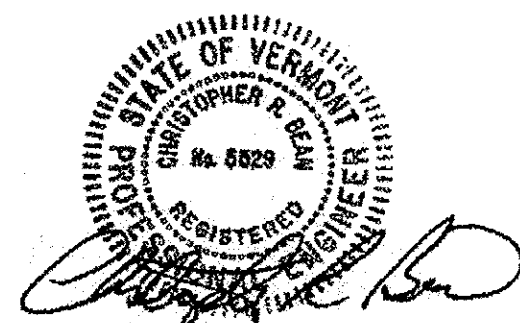

SURVEYED BY : N/A  
SURVEYED DATE : N/A  
DATUM  
VERTICAL N/A  
HORIZONTAL N/A

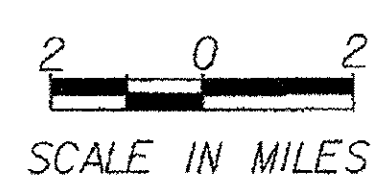

THESE PLANS ARE SUBJECT TO SUCH ENGINEERING CHANGES AS MAY BE REQUIRED BY THE FEDERAL HIGHWAY ADMINISTRATION OR THE DIRECTOR OF PROGRAM DEVELOPMENT.  
CONSTRUCTION IS TO BE CARRIED ON IN ACCORDANCE WITH THESE PLANS AND THE STANDARD SPECIFICATIONS FOR CONSTRUCTION DATED 2006, AS APPROVED BY THE FEDERAL HIGHWAY ADMINISTRATION ON JUNE 15, 2006 FOR USE ON THIS PROJECT, INCLUDING ALL SUBSEQUENT REVISIONS AND SUCH REVISED SPECIFICATIONS AND SPECIAL PROVISIONS AS ARE INCORPORATED IN THESE PLANS.

DIRECTOR OF PROGRAM DEVELOPMENT	APPROVED: <i>Joshua Schultz</i> DATE: 5-19-09
PROJECT MANAGER :	JOSHUA SCHULTZ
PROJECT NAME :	LYNDON - DERBY
PROJECT NUMBER :	IM IR 091-3 (6)
SHEET	1 OF 160 SHEETS