


REMOVING SIGNS  
 TYPE A: 14  
 TYPE B: 1  
 BRIDGE PLAQUE: 1

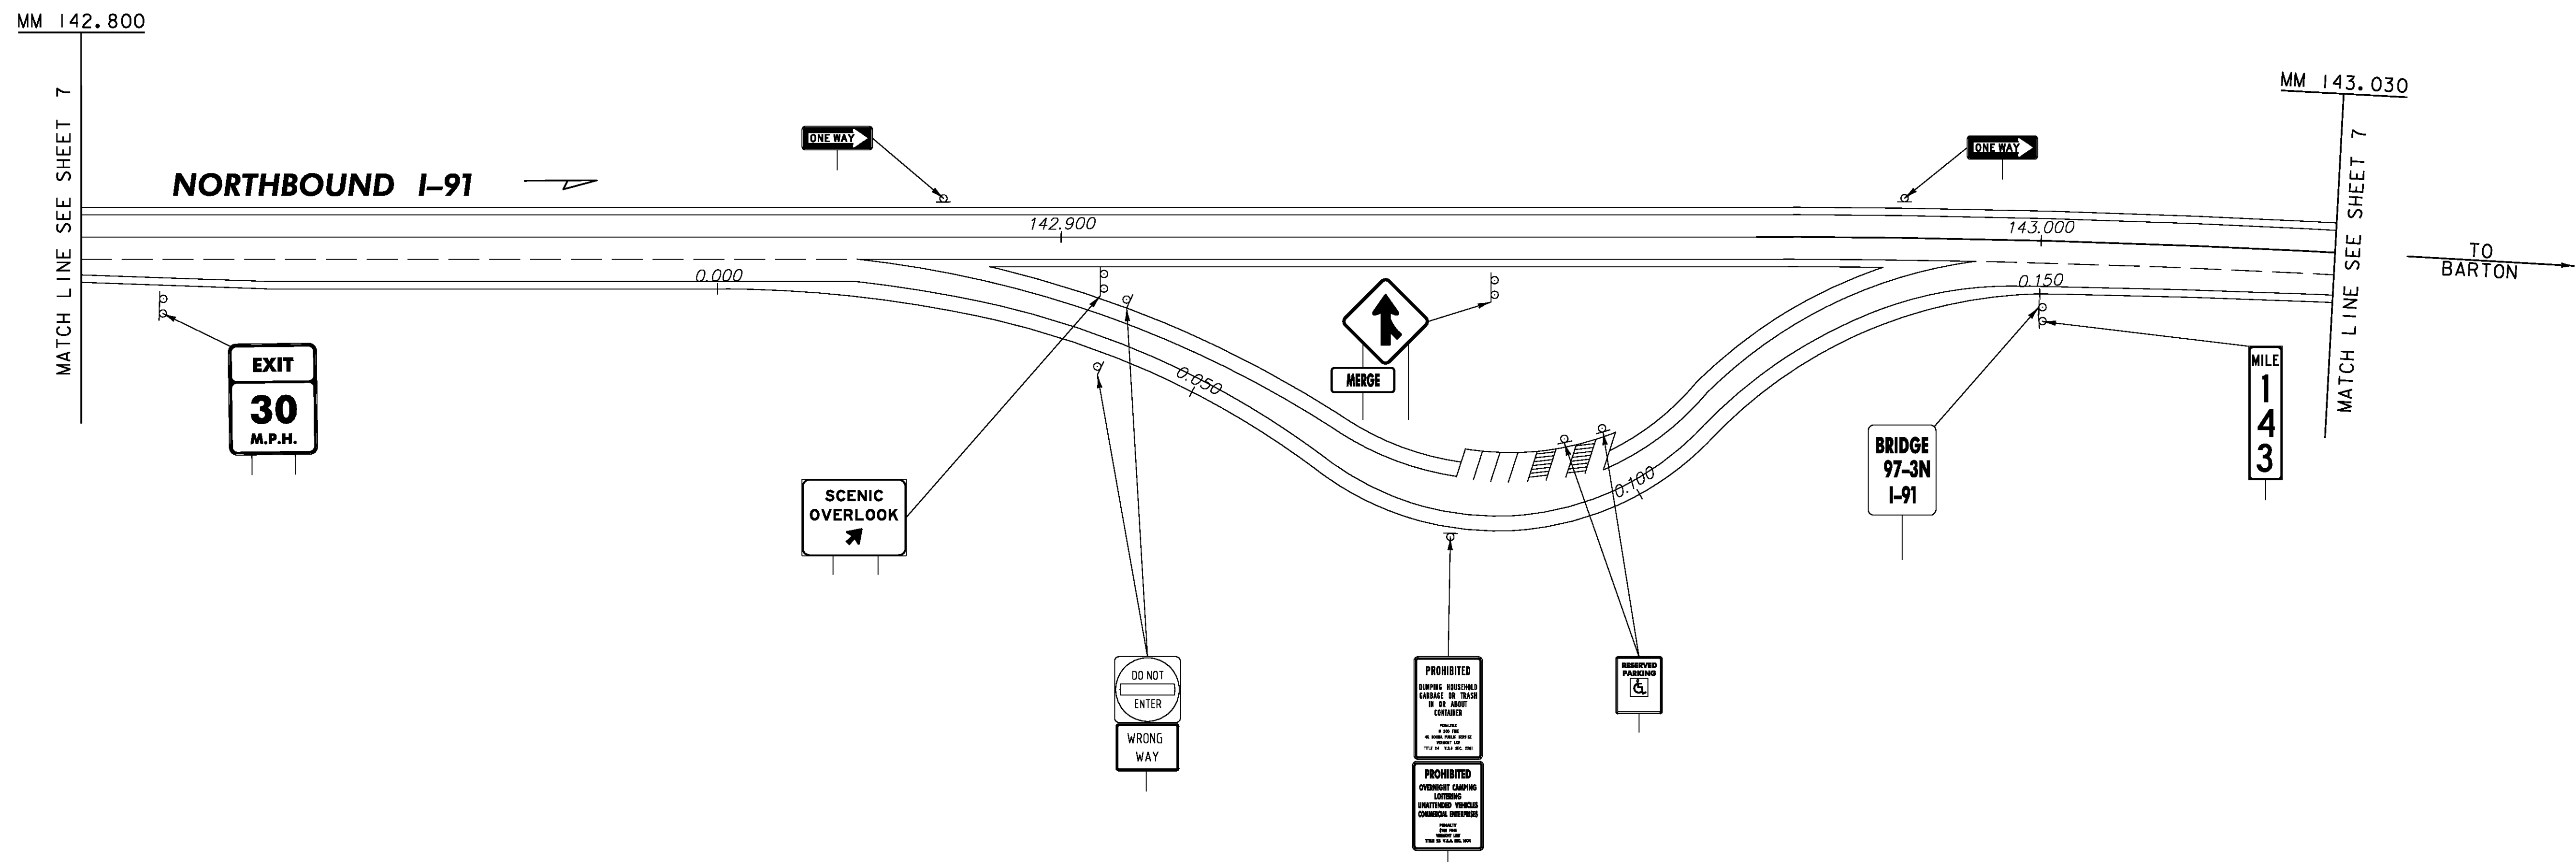

LEGEND  
 [RET] - RETAINED  
 [R&S] - REMOVE AND SALVAGE

ALL SIGNS AND POSTS WILL BE REMOVED UNLESS OTHERWISE NOTED

**EXISTING SIGNS  
 PARKING AREA  
 WHELOCK - NB  
 MM 142.890**

PROJECT NAME: LYNDON - DERBY

PROJECT NUMBER: IM IR 091-3(6)

FILE NAME: z87a022res+.dgn  
 PROJECT LEADER: CRB  
 DESIGNED BY: PTS  
 CLD REF. NO.: 08-0159

PLOT DATE: 5/7/2009  
 DRAWN BY: MRS  
 CHECKED BY: DAM  
 SHEET 18 OF 160