


REMOVING SIGNS
 TYPE A: 13
 TYPE B: 1

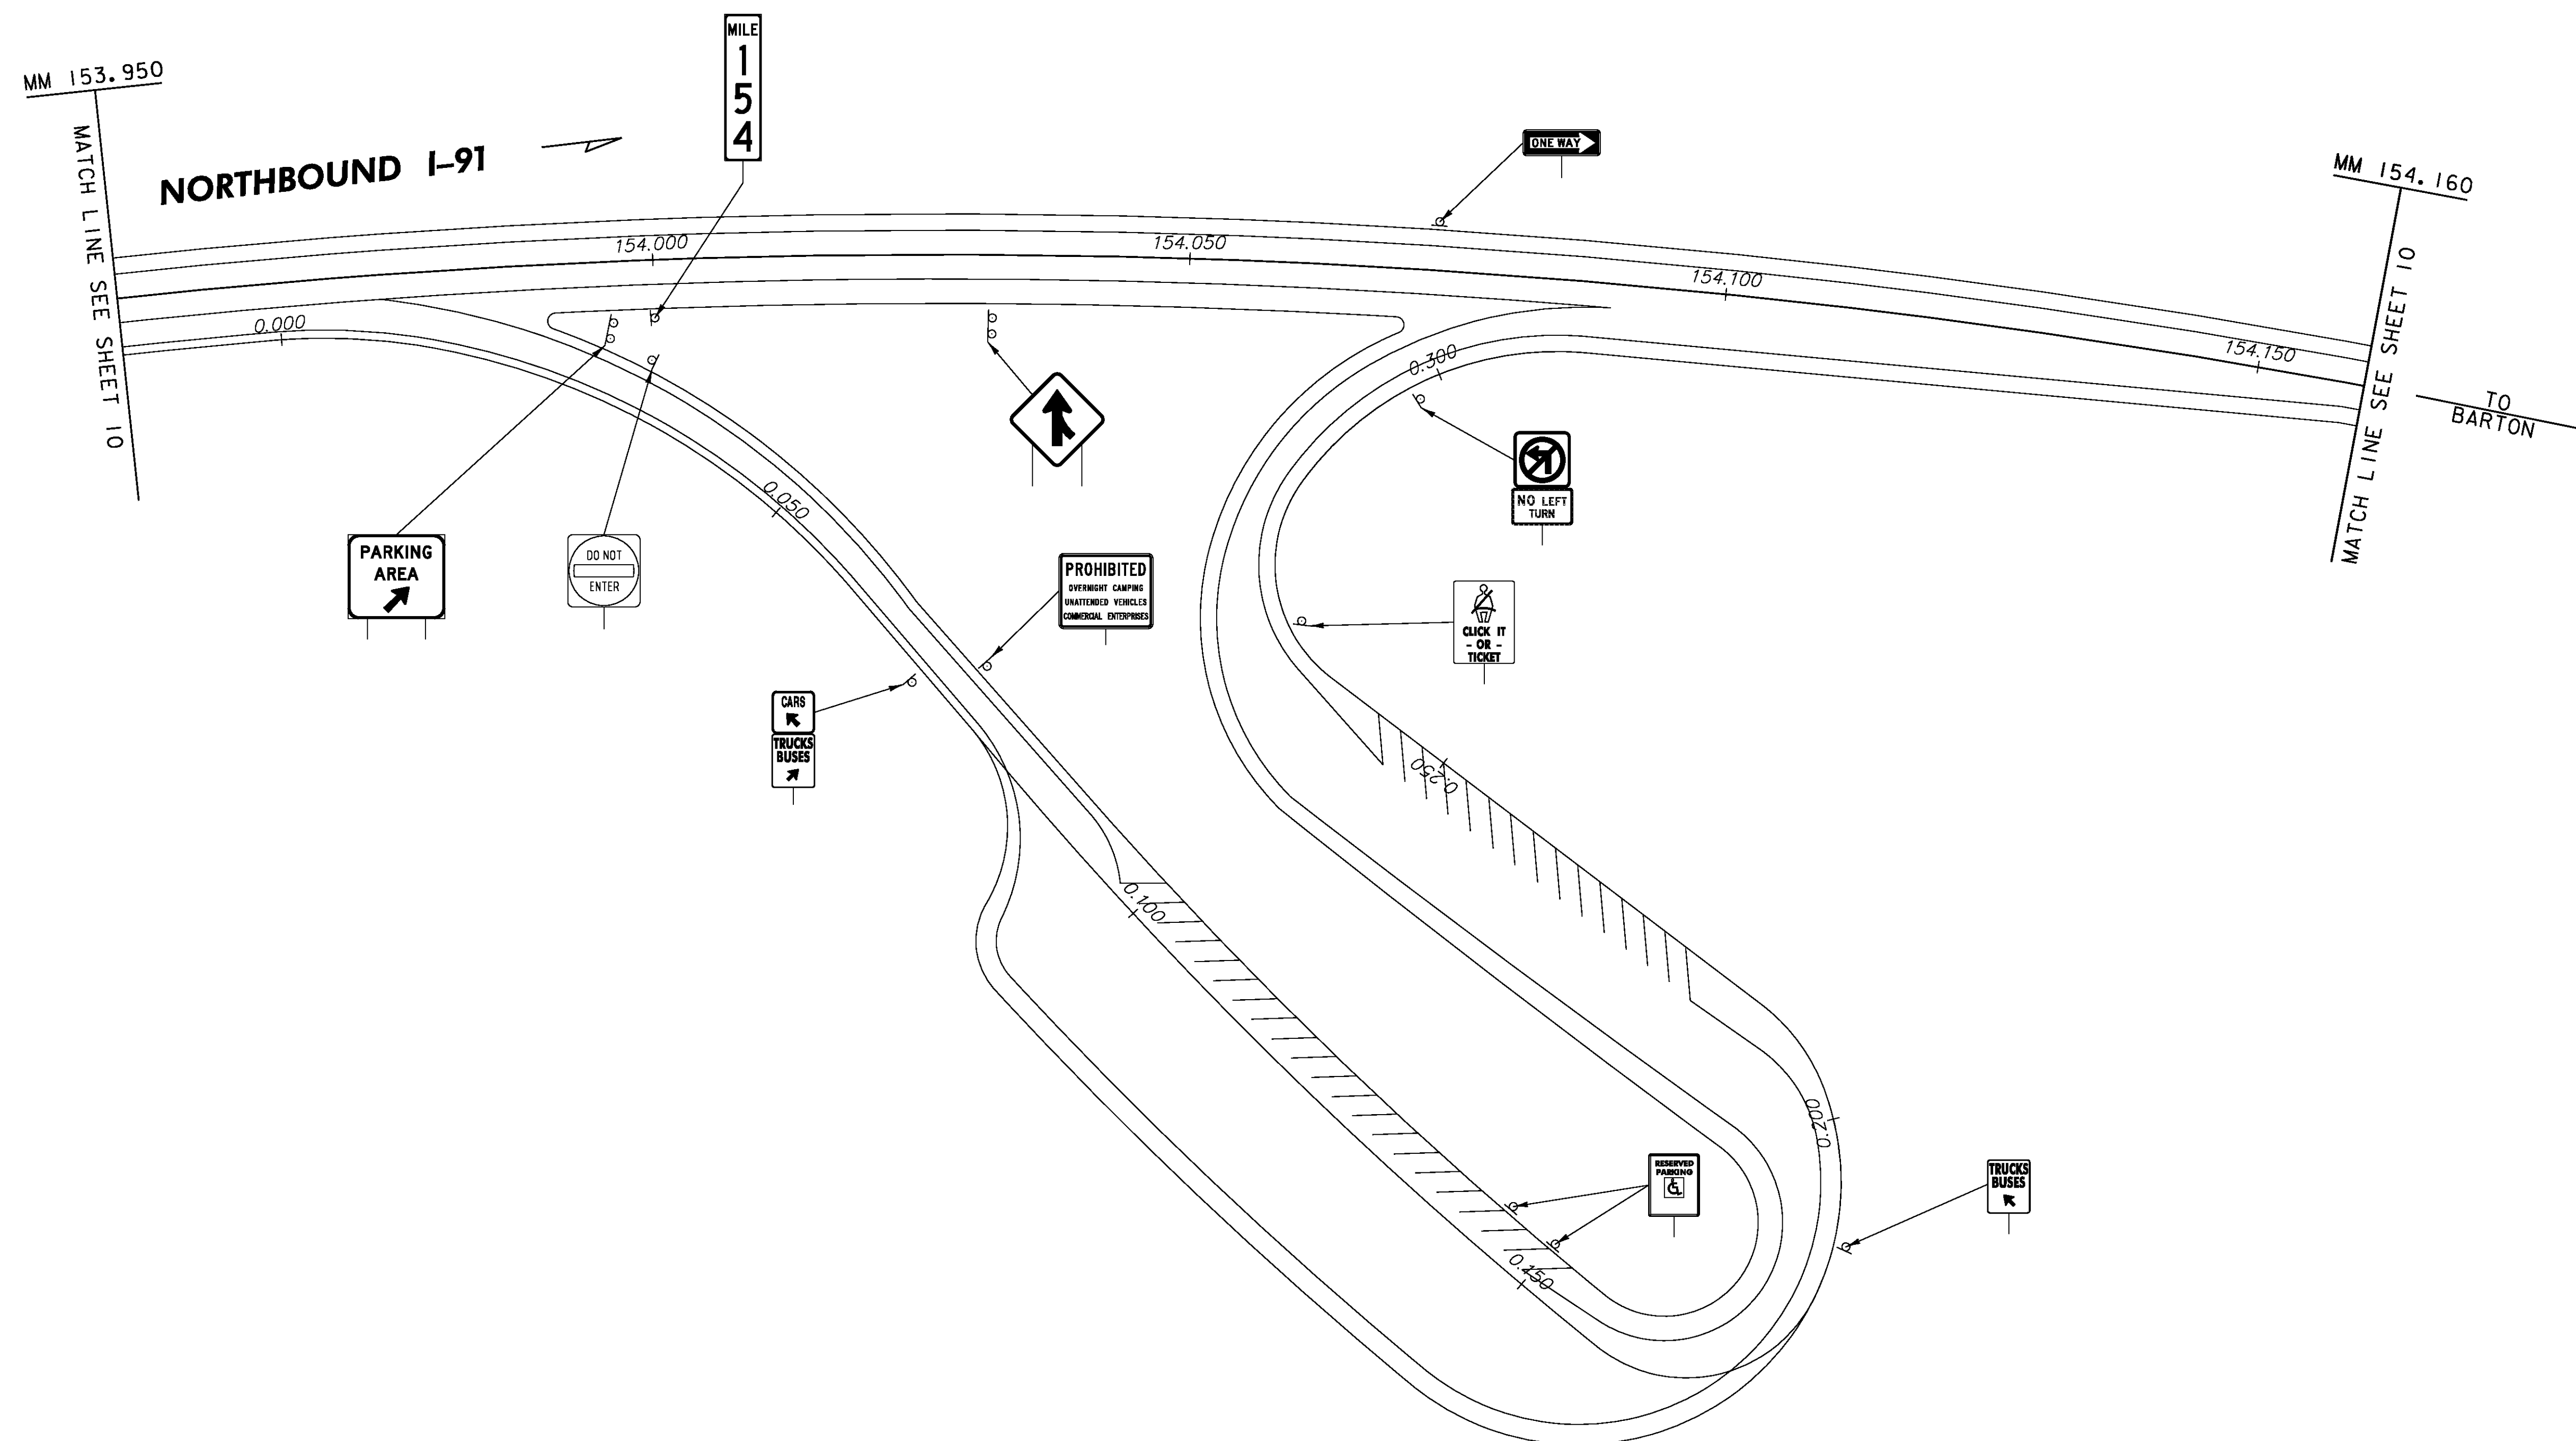

LEGEND
 [RET] - RETAINED
 [R&S] - REMOVE AND SALVAGE

ALL SIGNS AND POSTS WILL BE REMOVED UNLESS OTHERWISE NOTED

EXISTING SIGNS PARKING AREA GLOVER - NB MM 153.95	PROJECT NAME: LYNDON - DERBY	
	PROJECT NUMBER: IM IR 091-3(6)	
FILE NAME: z87a022res+.dgn	PROJECT LEADER: CRB	PLOT DATE: 5/7/2009
DESIGNED BY: PTS	CLD REF. NO.: 08-0159	DRAWN BY: MRS
		CHECKED BY: DAM
		SHEET 19 OF 160

MODEL: 03-Exist