


REMOVING SIGNS
 TYPE A: 22
 TYPE B: 1

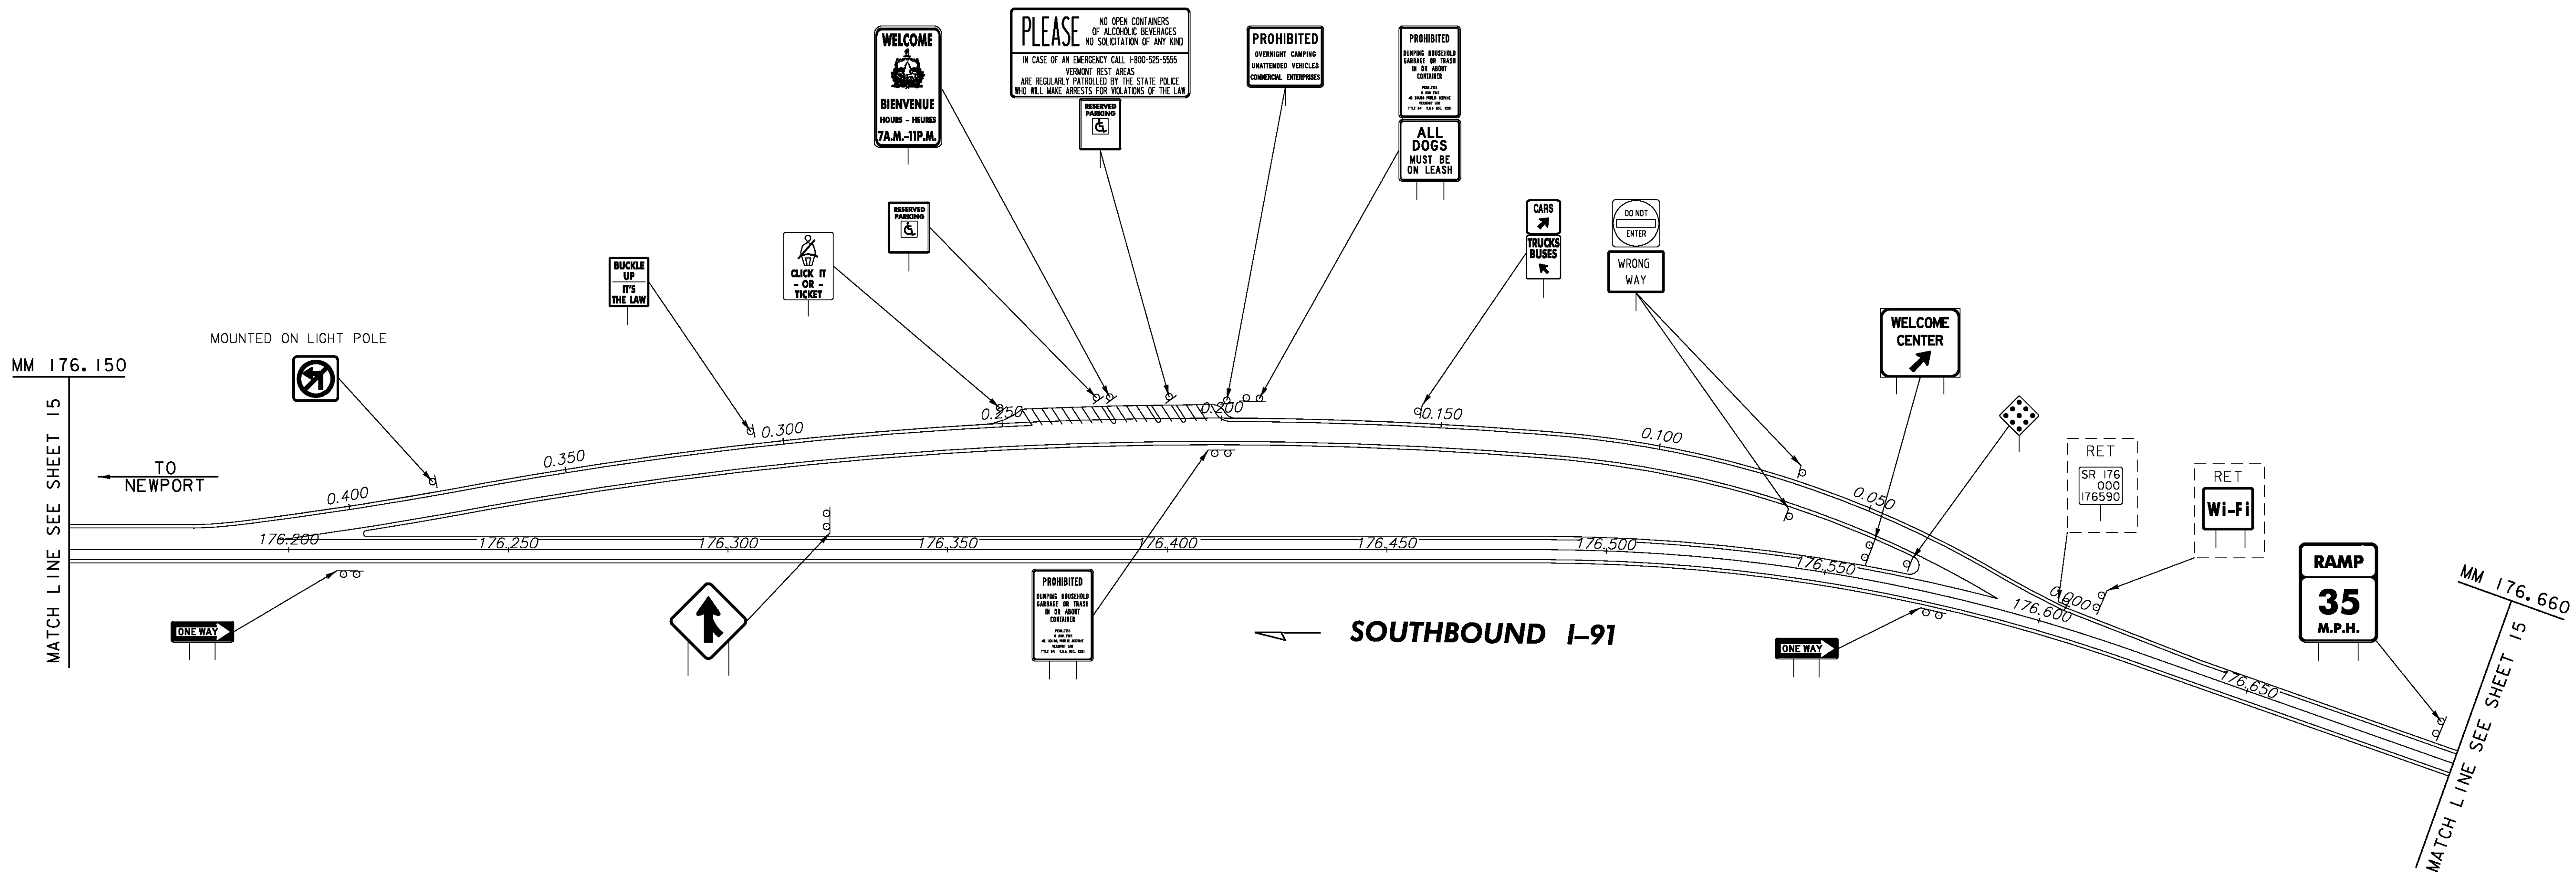

LEGEND
 [RET] - RETAINED
 [R&S] - REMOVE AND SALVAGE

ALL SIGNS AND POSTS WILL BE REMOVED UNLESS OTHERWISE NOTED

| | | |
|--|--------------------------------|---------------------|
| EXISTING SIGNS REST AREA DERBY - SB MM 176.344 | PROJECT NAME: LYNDON - DERBY | |
| | PROJECT NUMBER: IM IR 091-3(6) | |
| | FILE NAME: z87a022rest.dgn | PLOT DATE: 5/7/2009 |
| | PROJECT LEADER: CRB | DRAWN BY: MRS |
| DESIGNED BY: PTS | CHECKED BY: DAM | |
| CLD REF. NO.: 08-0159 | SHEET 26 OF 160 | |

MODEL: 06-Exist