
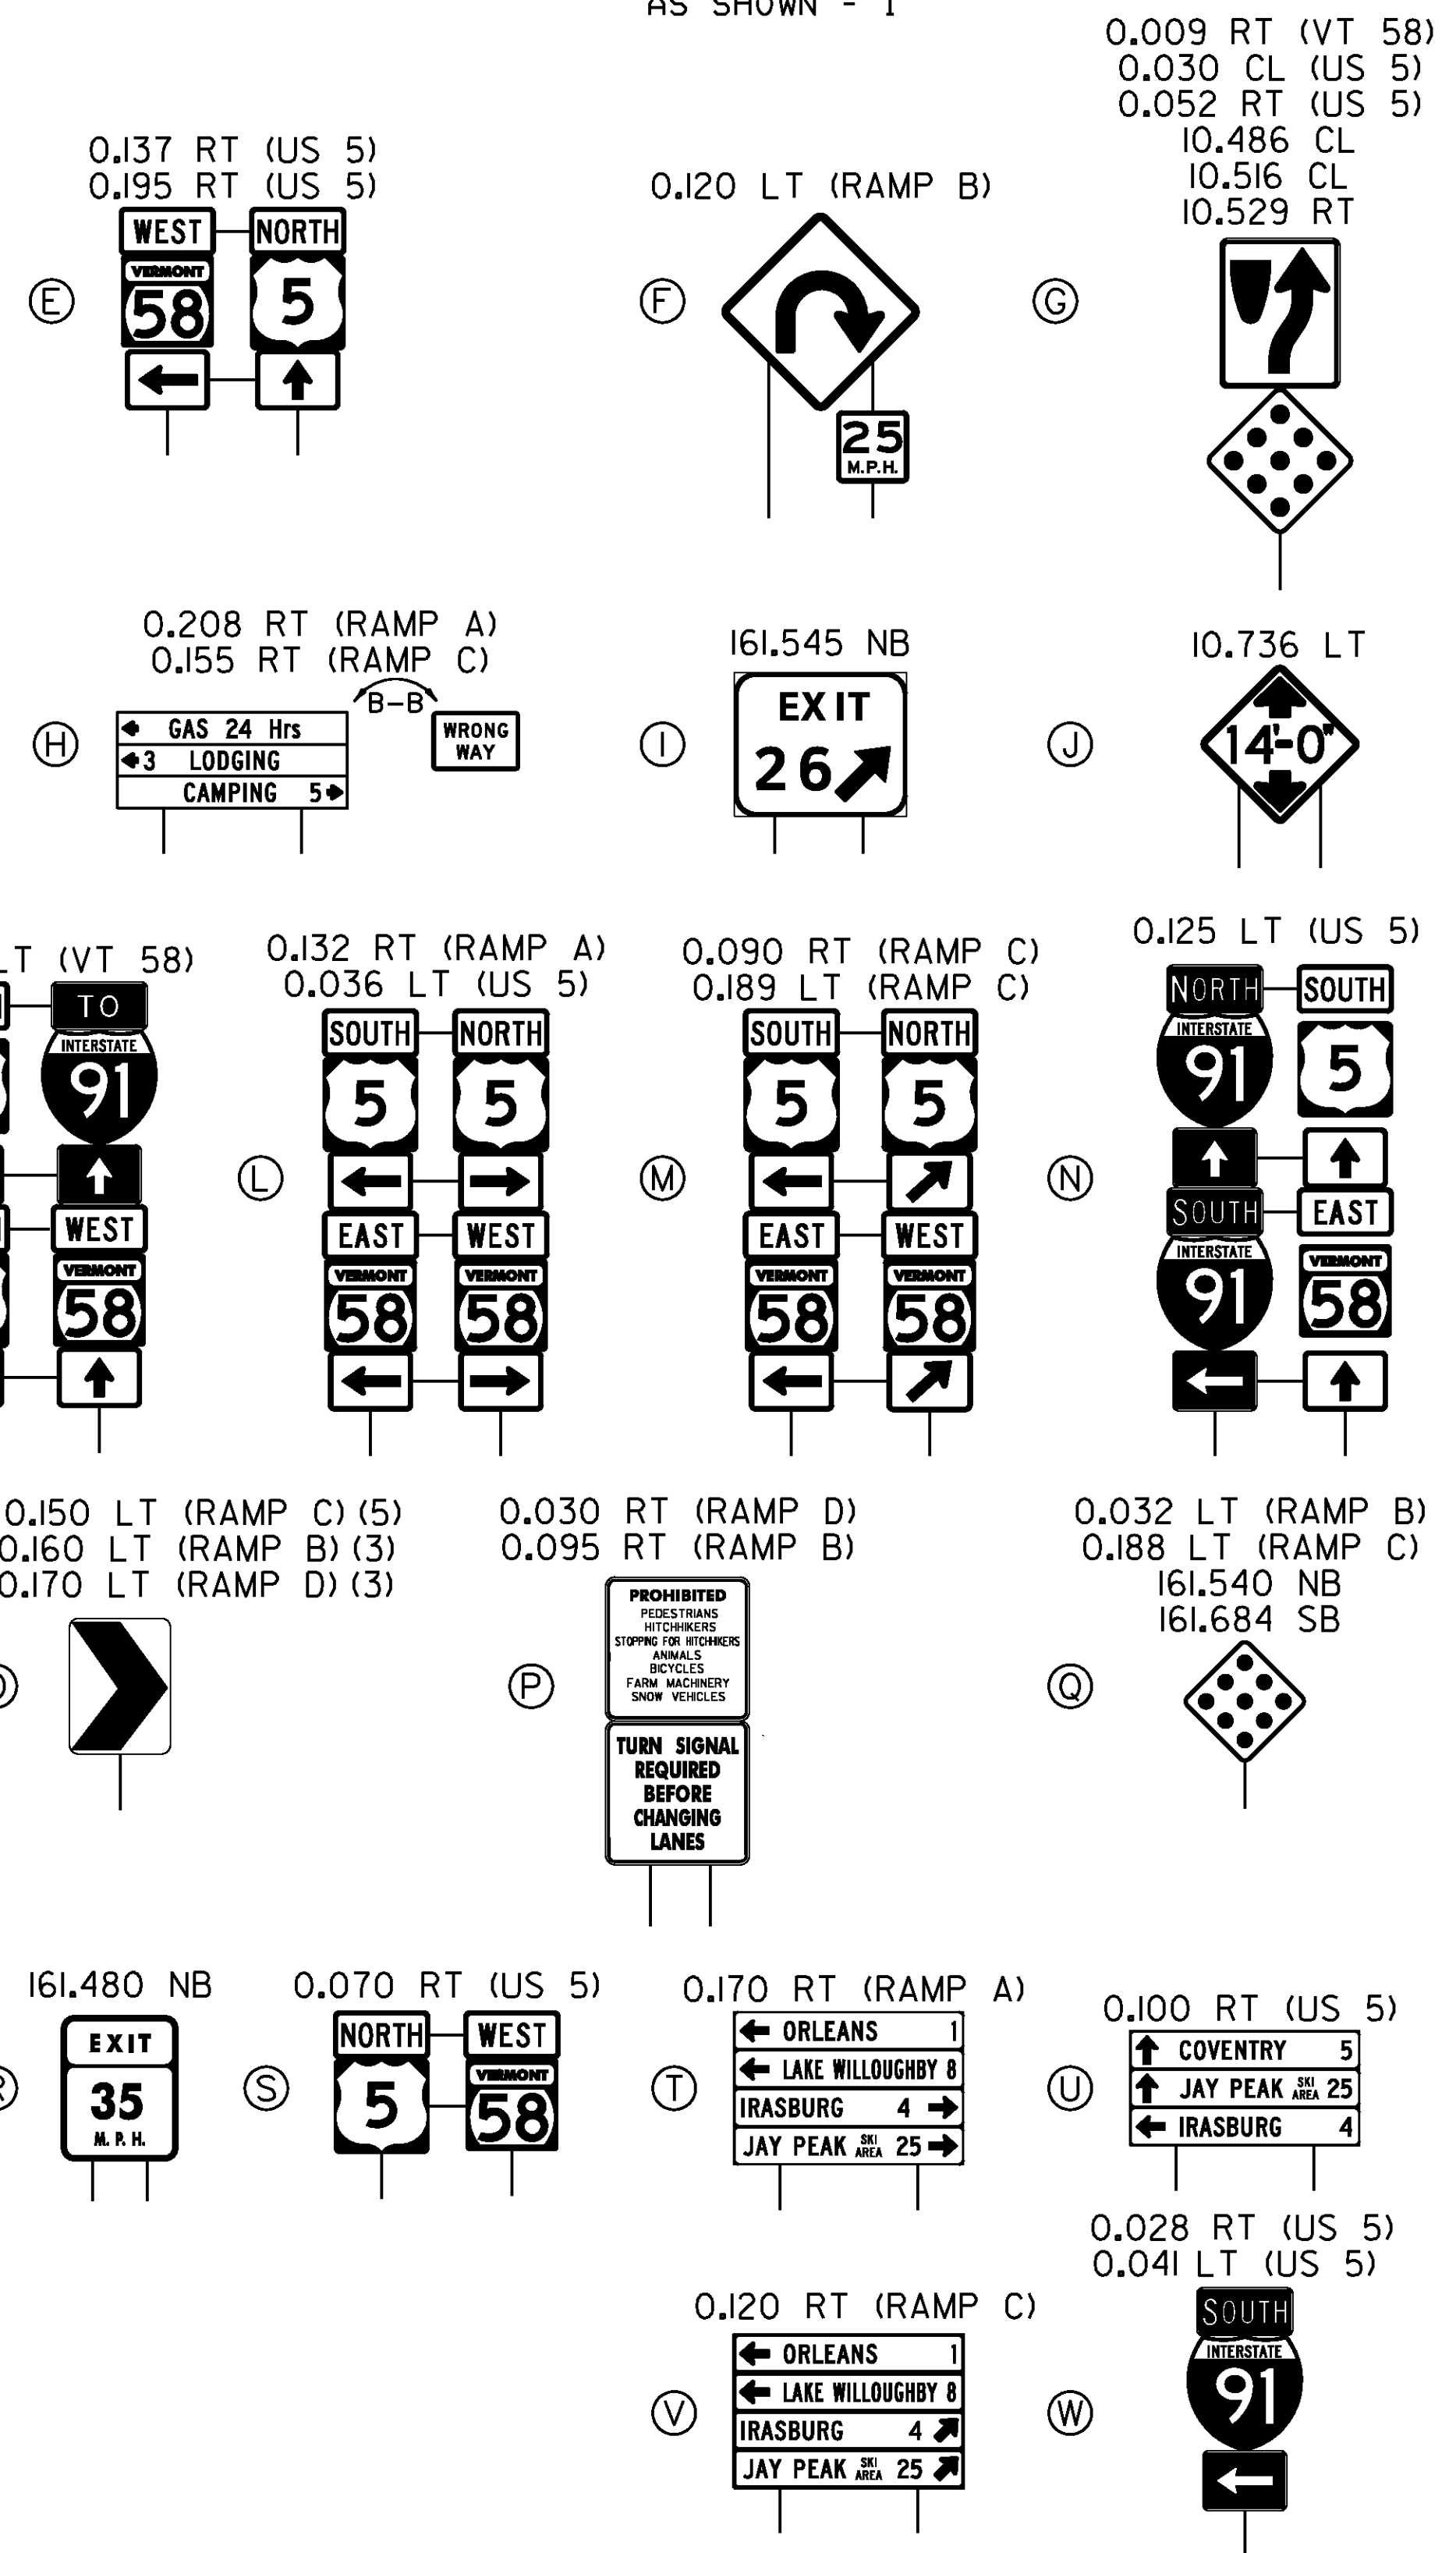


NOTE
 1. US 5 ALIGNMENT ESTABLISHED USING
 EXISTING MM PLAQUE 0050/1011/0000
 AND THE ROUTE LOGS FOR THE END OF
 US 5 IN BARTON.

ERECTING SALVAGED SIGNS
 AS SHOWN - 1

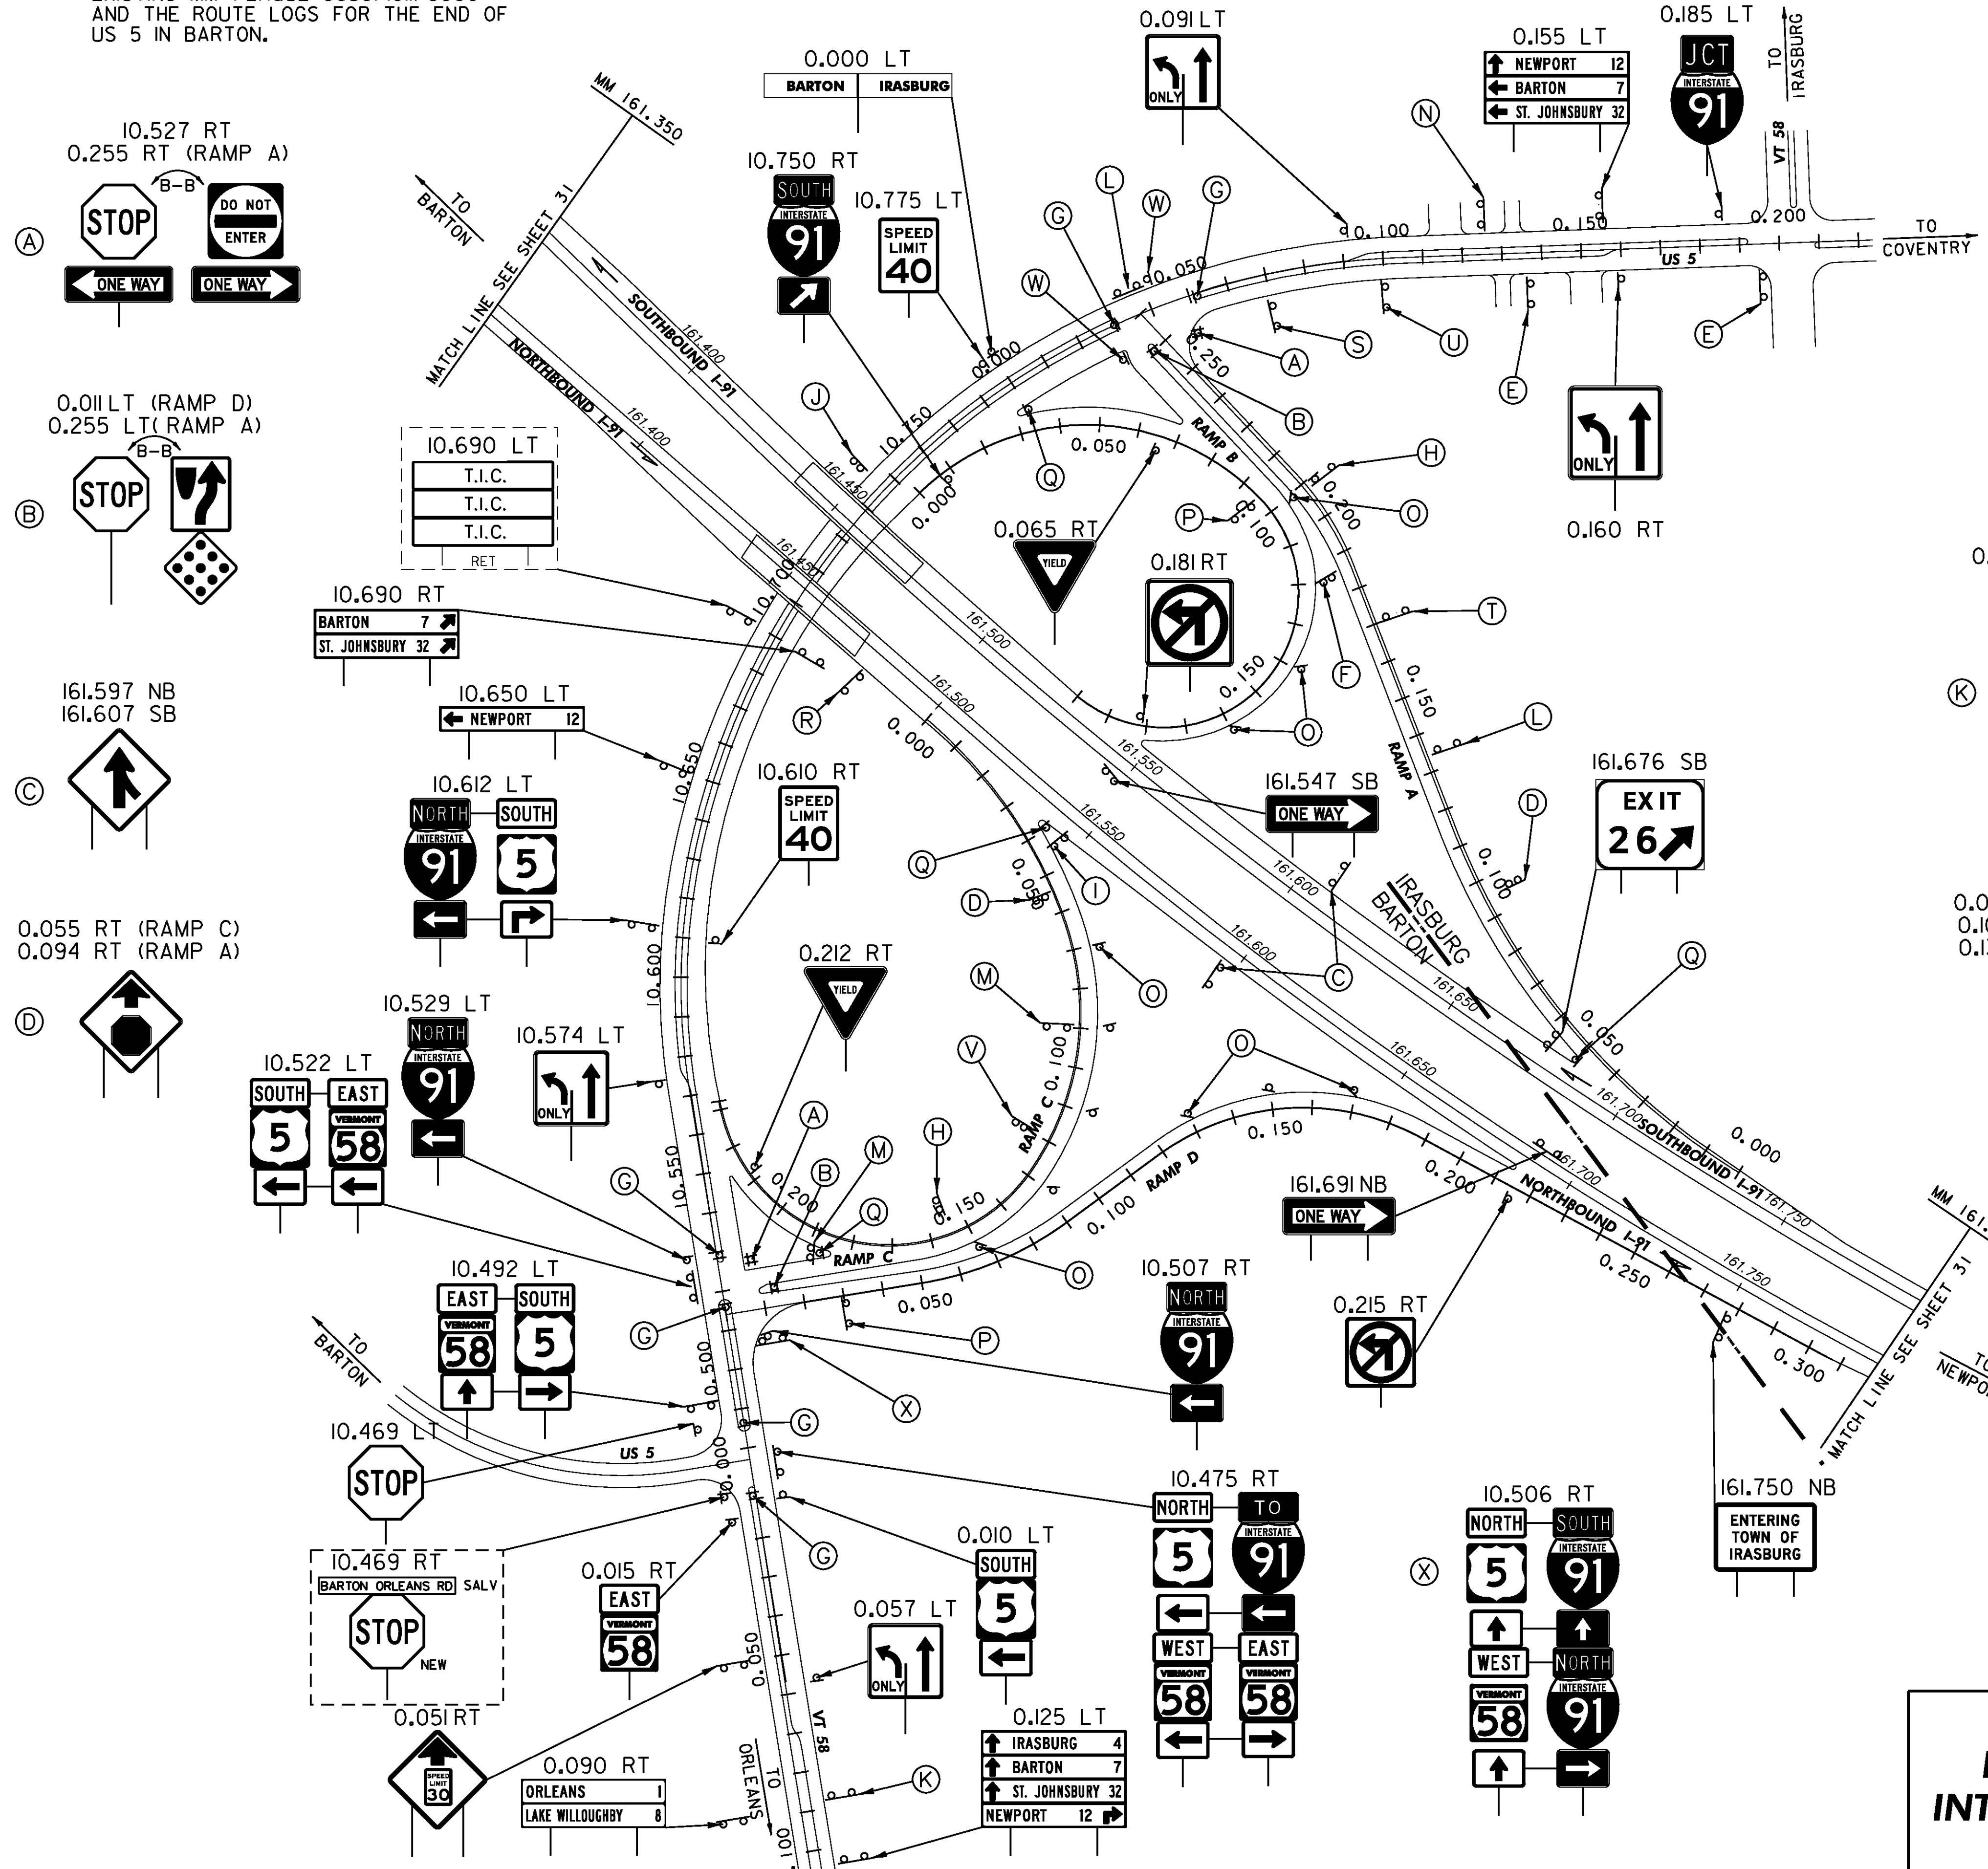

LEGEND
 RET - RETAINED
 SALV - SALVAGED

ALL SIGNS AND POSTS ARE NEW UNLESS OTHERWISE NOTED

<h3>NEW SIGNS INTERCHANGE 26</h3>	PROJECT NAME: LYNDON - DERBY
	PROJECT NUMBER: IM IR 091-3(6)
	FILE NAME: z87a022int26.dgn
	CLD REF. NO.: 08-0159
	PLOT DATE: 5/7/2009
	DRAWN BY: NLL
	CHECKED BY: PTS
	SHEET 41 OF 160

MODEL: New