


NOTE
 1. VT 191 ALIGNMENT ESTABLISHED USING EXISTING
 MM PLAQUE 1910/1007/0095.

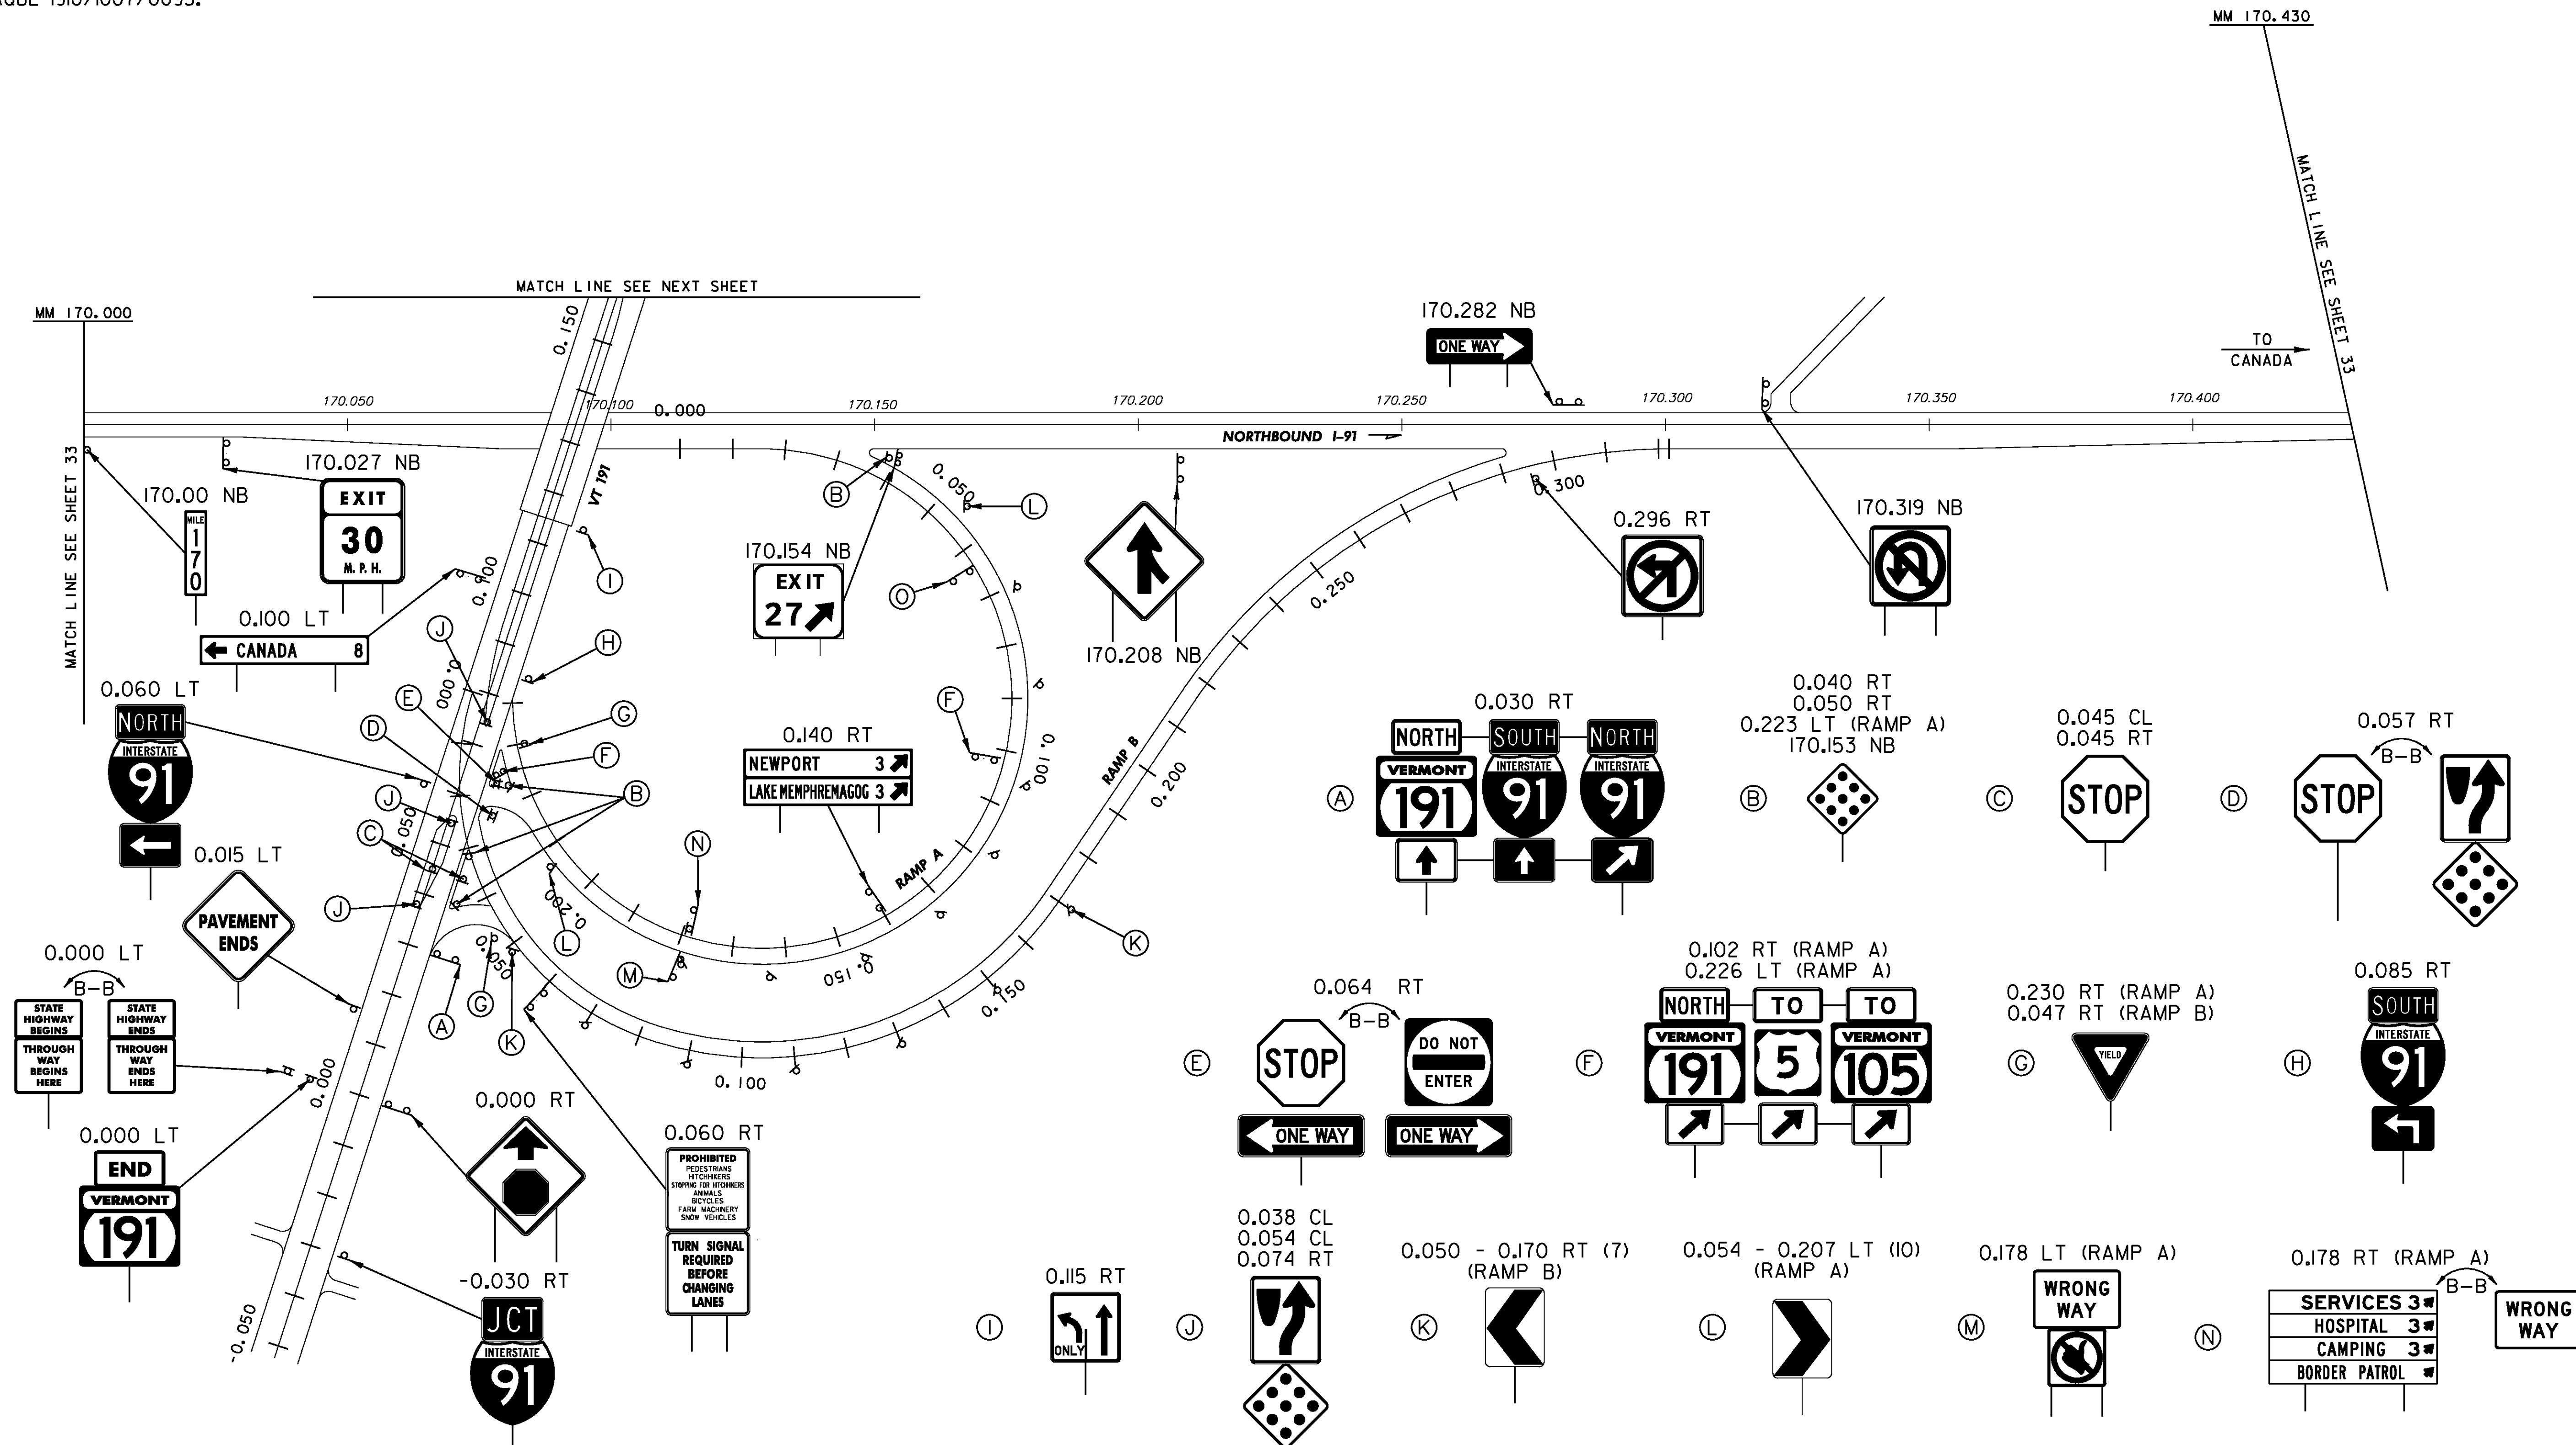

LEGEND
 [RET] - RETAINED

ALL SIGNS AND POSTS ARE NEW UNLESS OTHERWISE NOTED

NEW SIGNS INTERCHANGE 27 NB	PROJECT NAME: LYNDON - DERBY
	PROJECT NUMBER: IM IR 091-3(6)
	FILE NAME: z87a022in+27.dgn
	CLD REF. NO.: 08-0159
PROJECT LEADER: CRB	PLOT DATE: 5/7/2009
DESIGNED BY: DAM	DRAWN BY: NLL
	CHECKED BY: PTS
	SHEET 44 OF 160

MODEL: New 1