


NOTE
FOR TYPICAL PLACEMENT OF DELINEATORS
SEE STANDARD E-197 AND SHEET 4.

SB ACCEL LANE TAPER ENDS AT 140.609+/-
1030' FROM GORE
TOTAL TYPE II DELINEATORS FOR ACCEL LANE=11

SB DECEL LANE TAPER BEGINS AT 141.042+/-
550' FROM GORE
TOTAL TYPE II DELINEATORS FOR DECEL LANE=6

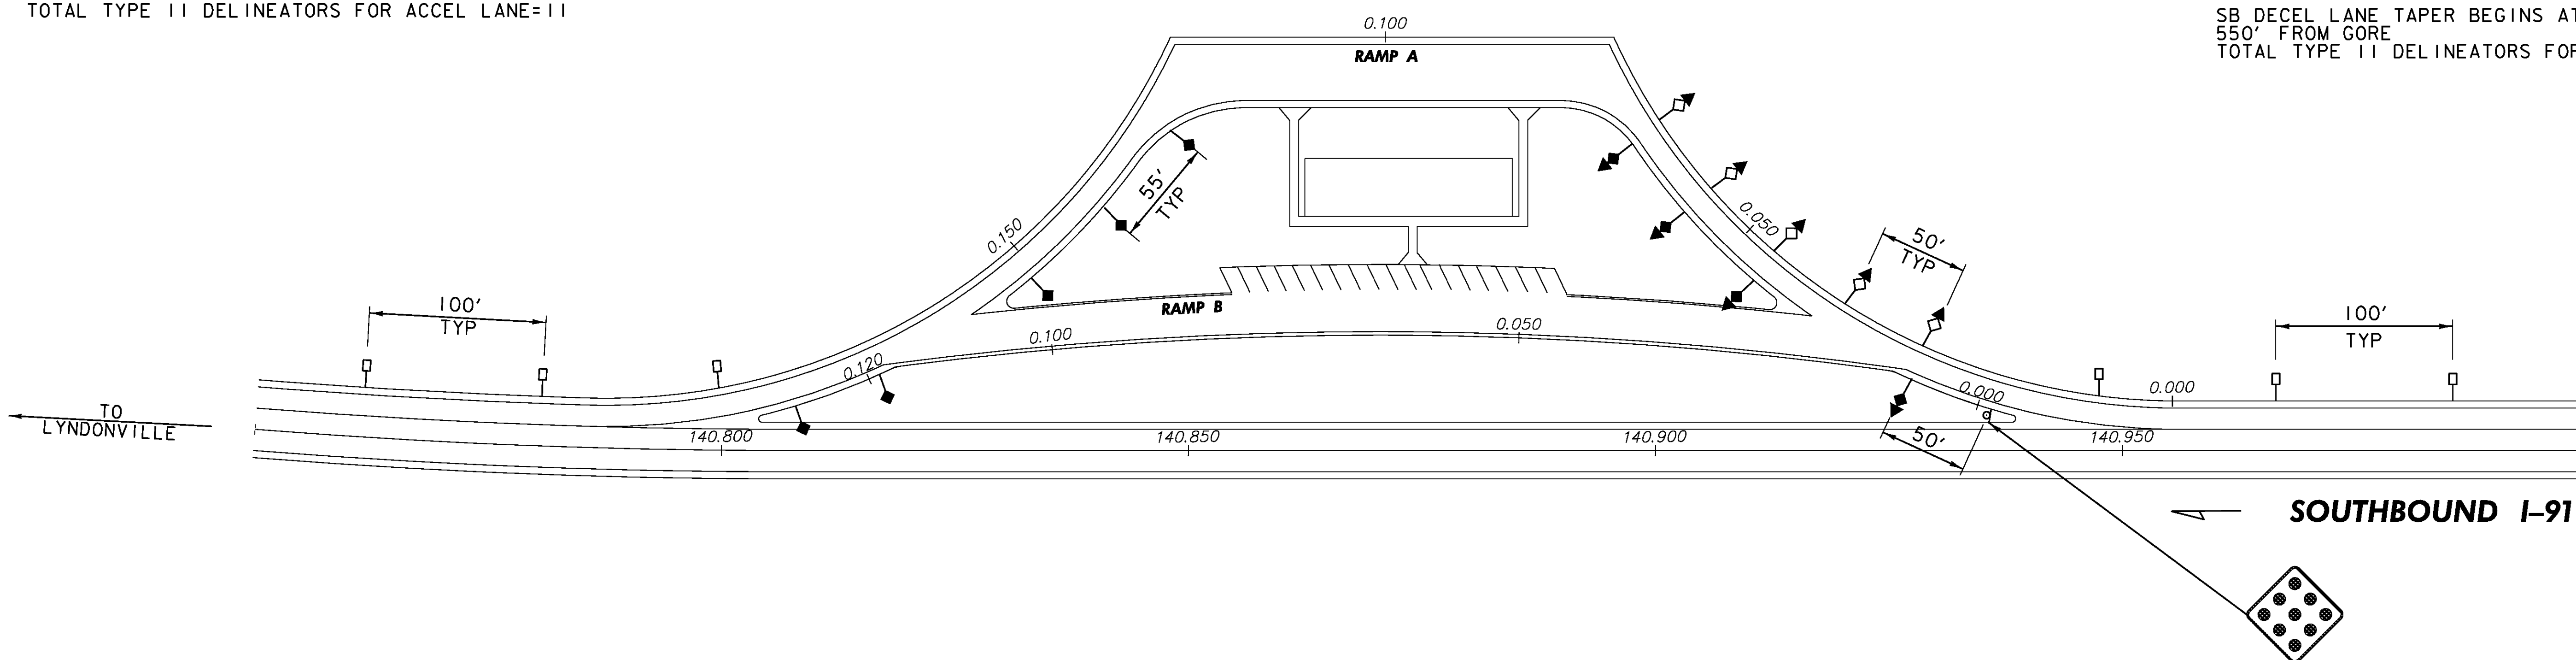

LEGEND

- ↑ TYPE I (YELLOW)
- ◇ TYPE I (WHITE)
- TYPE II (WHITE)
- ◆ TYPE III (YELLOW, RED ON BACK)
- ◇ TYPE III (WHITE, RED ON BACK)

**DELINEATOR
LAYOUT
REST AREA
LYNDON - SB
MM 140.833**

PROJECT NAME: LYNDON - DERBY

PROJECT NUMBER: IM IR 091-3(6)

FILE NAME: z87a022res+.dgn

PROJECT LEADER: CRB

DESIGNED BY: PTS

CLD REF. NO.: 08-0159

PLOT DATE: 5/7/2009

DRAWN BY: NLL

CHECKED BY: BDB

SHEET 50 OF 160