


NOTE
FOR TYPICAL PLACEMENT OF DELINEATORS
SEE STANDARD E-197 AND SHEET 4.

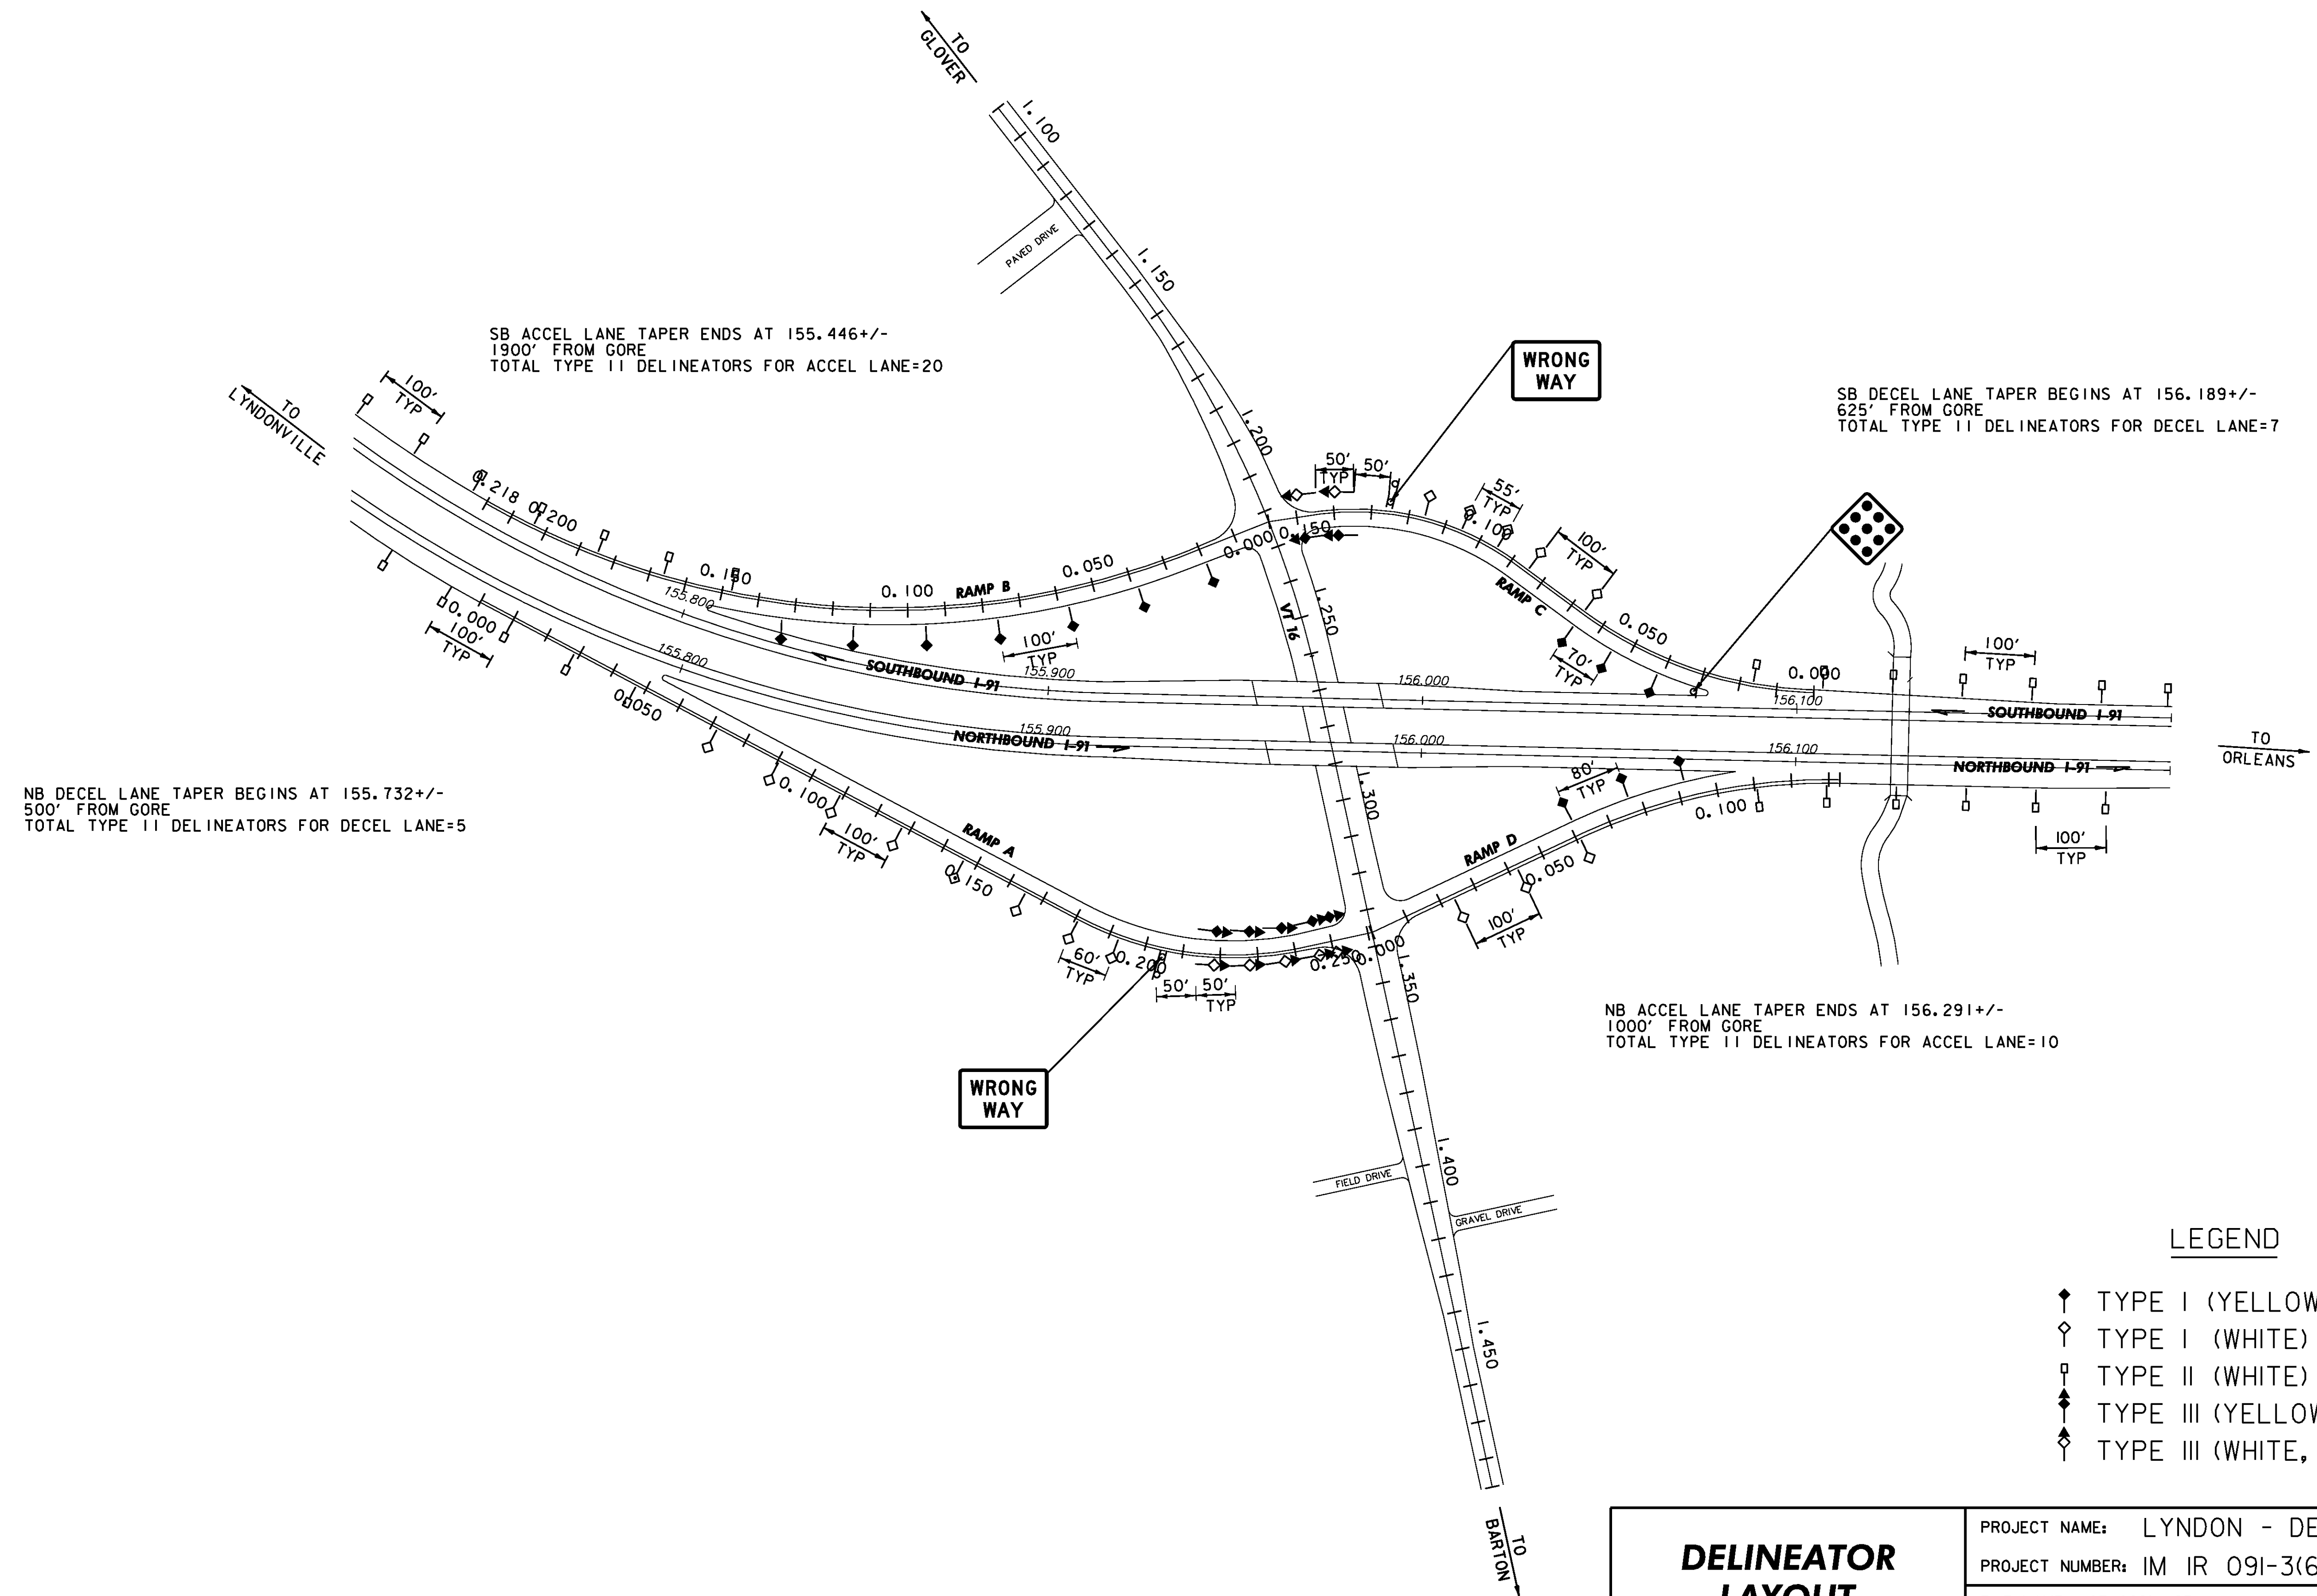

LEGEND

- ◆ TYPE I (YELLOW)
- ◇ TYPE I (WHITE)
- TYPE II (WHITE)
- ◆ TYPE III (YELLOW, RED ON BACK)
- ◇ TYPE III (WHITE, RED ON BACK)

DELINEATOR LAYOUT INTERCHANGE 25	PROJECT NAME: LYNDON - DERBY
	PROJECT NUMBER: IM IR 091-3(6)
FILE NAME: z87a022in+25.dgn	PLOT DATE: 5/7/2009
PROJECT LEADER: CRB	DRAWN BY: NLL
DESIGNED BY: PTS	CHECKED BY: BDB
CLD REF. NO.: 08-0159	SHEET 53 OF 160