


NOTE  
FOR TYPICAL PLACEMENT OF DELINEATORS  
SEE STANDARD E-197 AND SHEET 4.

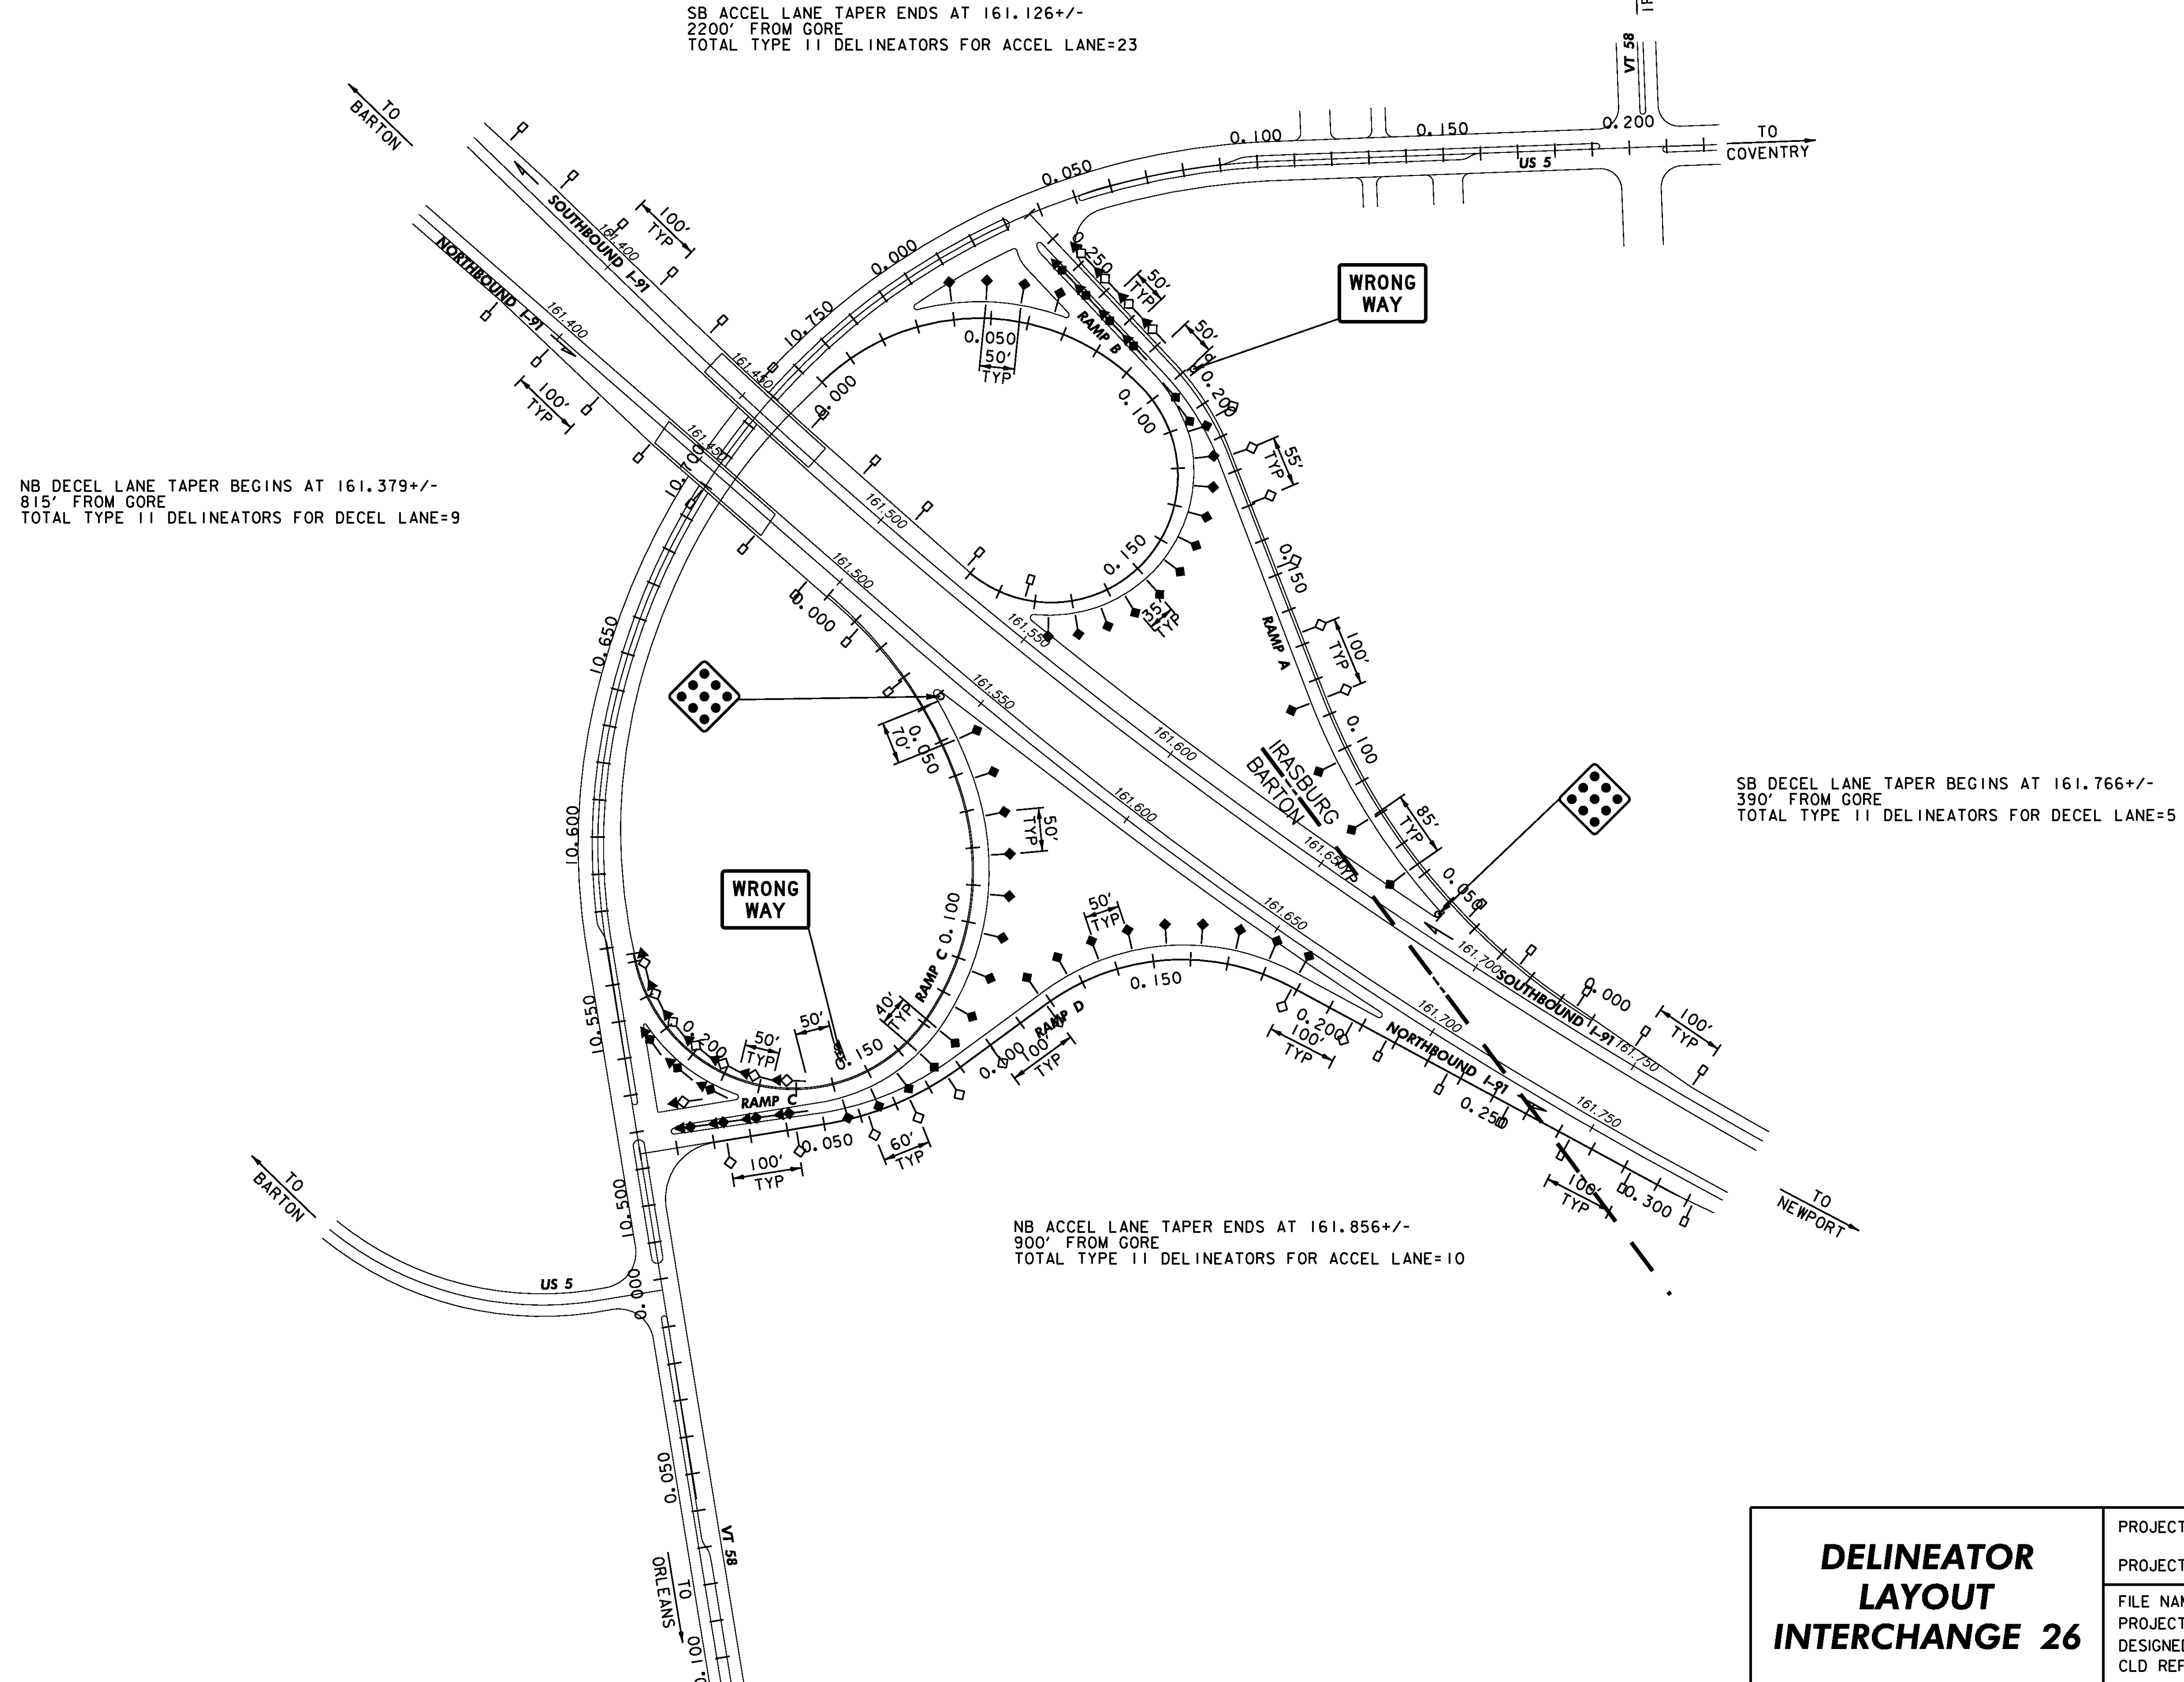

**LEGEND**

- ◆ TYPE I (YELLOW)
- ◇ TYPE I (WHITE)
- TYPE II (WHITE)
- ◆ TYPE III (YELLOW, RED ON BACK)
- ◇ TYPE III (WHITE, RED ON BACK)

<b>DELINEATOR LAYOUT INTERCHANGE 26</b>		PROJECT NAME: LYNDON - DERBY	
		PROJECT NUMBER: IM IR 09I-3(6)	
FILE NAME: z87a022in+26.dgn	PROJECT LEADER: CRB	PLOT DATE: 5/7/2009	DRAWN BY: NLL
DESIGNED BY: PTS	CLD REF. NO.: 08-0159	CHECKED BY: BDB	SHEET 54 OF 160